


ABUTMENT #1
SCALE: 1"=10'

4+93.2 behind


Checked by Judy Gilmore
Checked by Eric Foster
GRAN. BACKFILL FOR STRUCTURES: 12.26 sf ✓
STRUCTURE EXCAVATION: 51.90 sf ✓

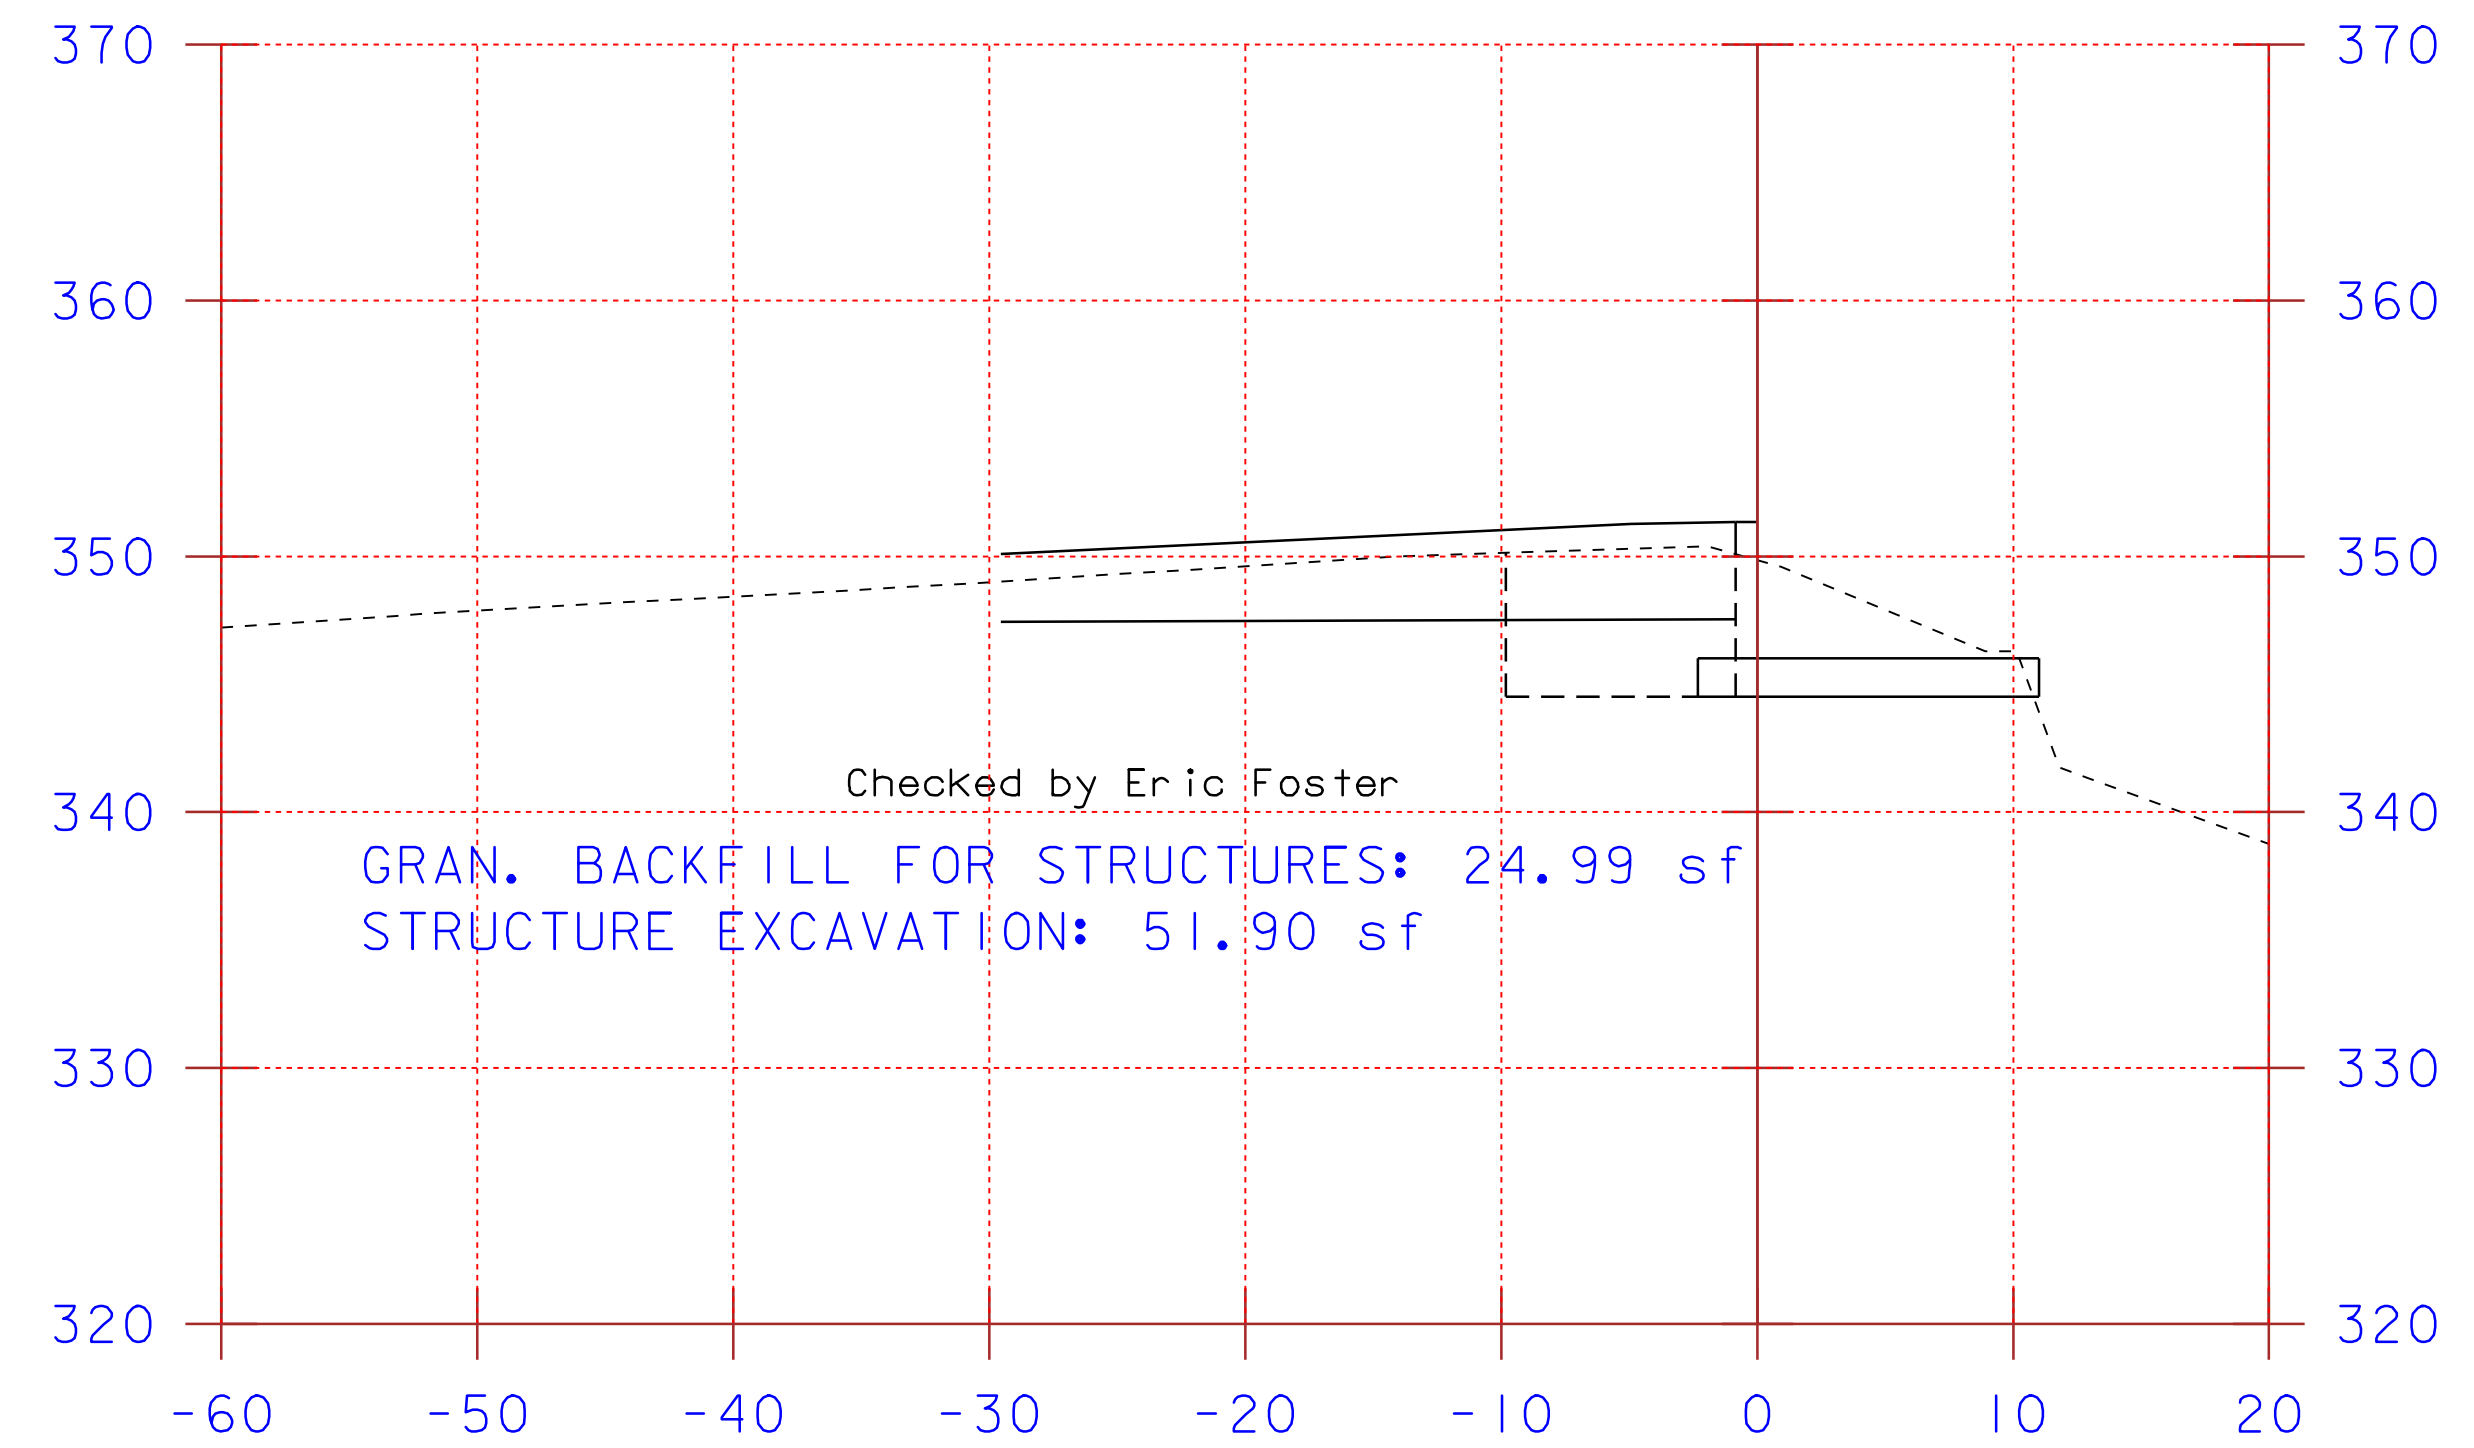

ABUTMENT #1
SCALE: 1"=10'

4+93.2 ahead


Checked by Eric Foster
GRAN. BACKFILL FOR STRUCTURES: 24.99 sf
STRUCTURE EXCAVATION: 51.90 sf

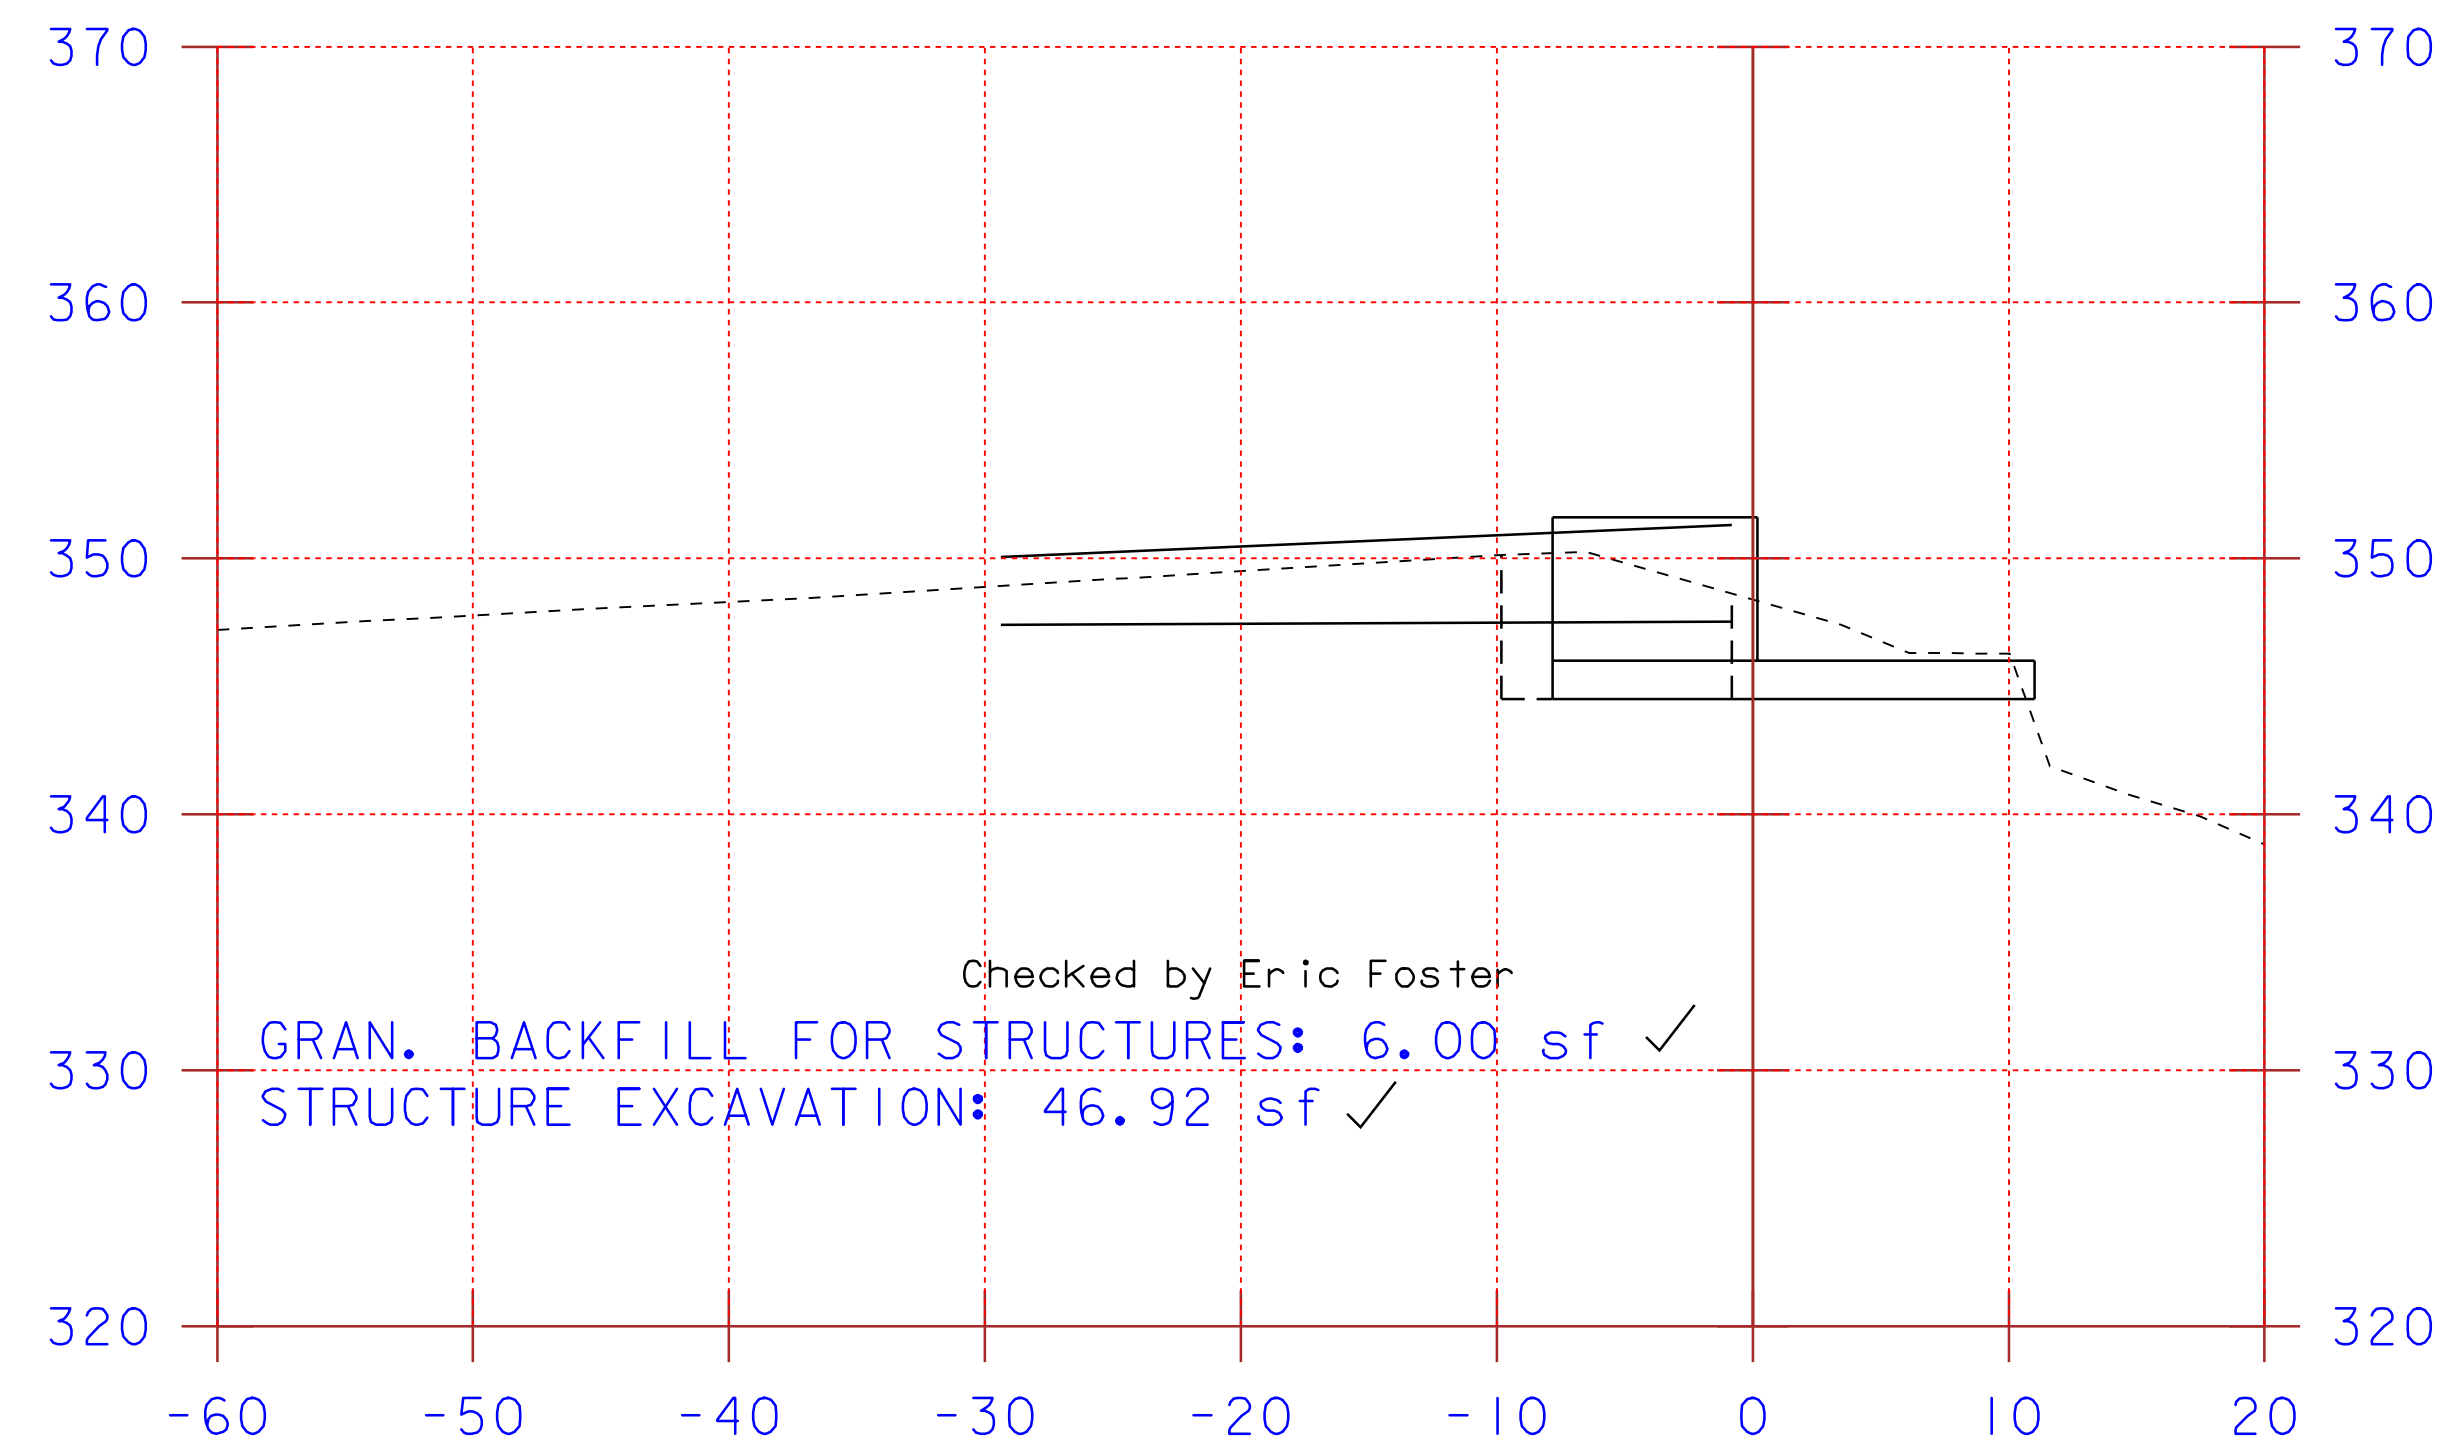

ABUTMENT #1
SCALE: 1"=10'

4+90.9 behind

Checked by Eric Foster
GRAN. BACKFILL FOR STRUCTURES: 6.00 sf ✓
STRUCTURE EXCAVATION: 46.92 sf ✓

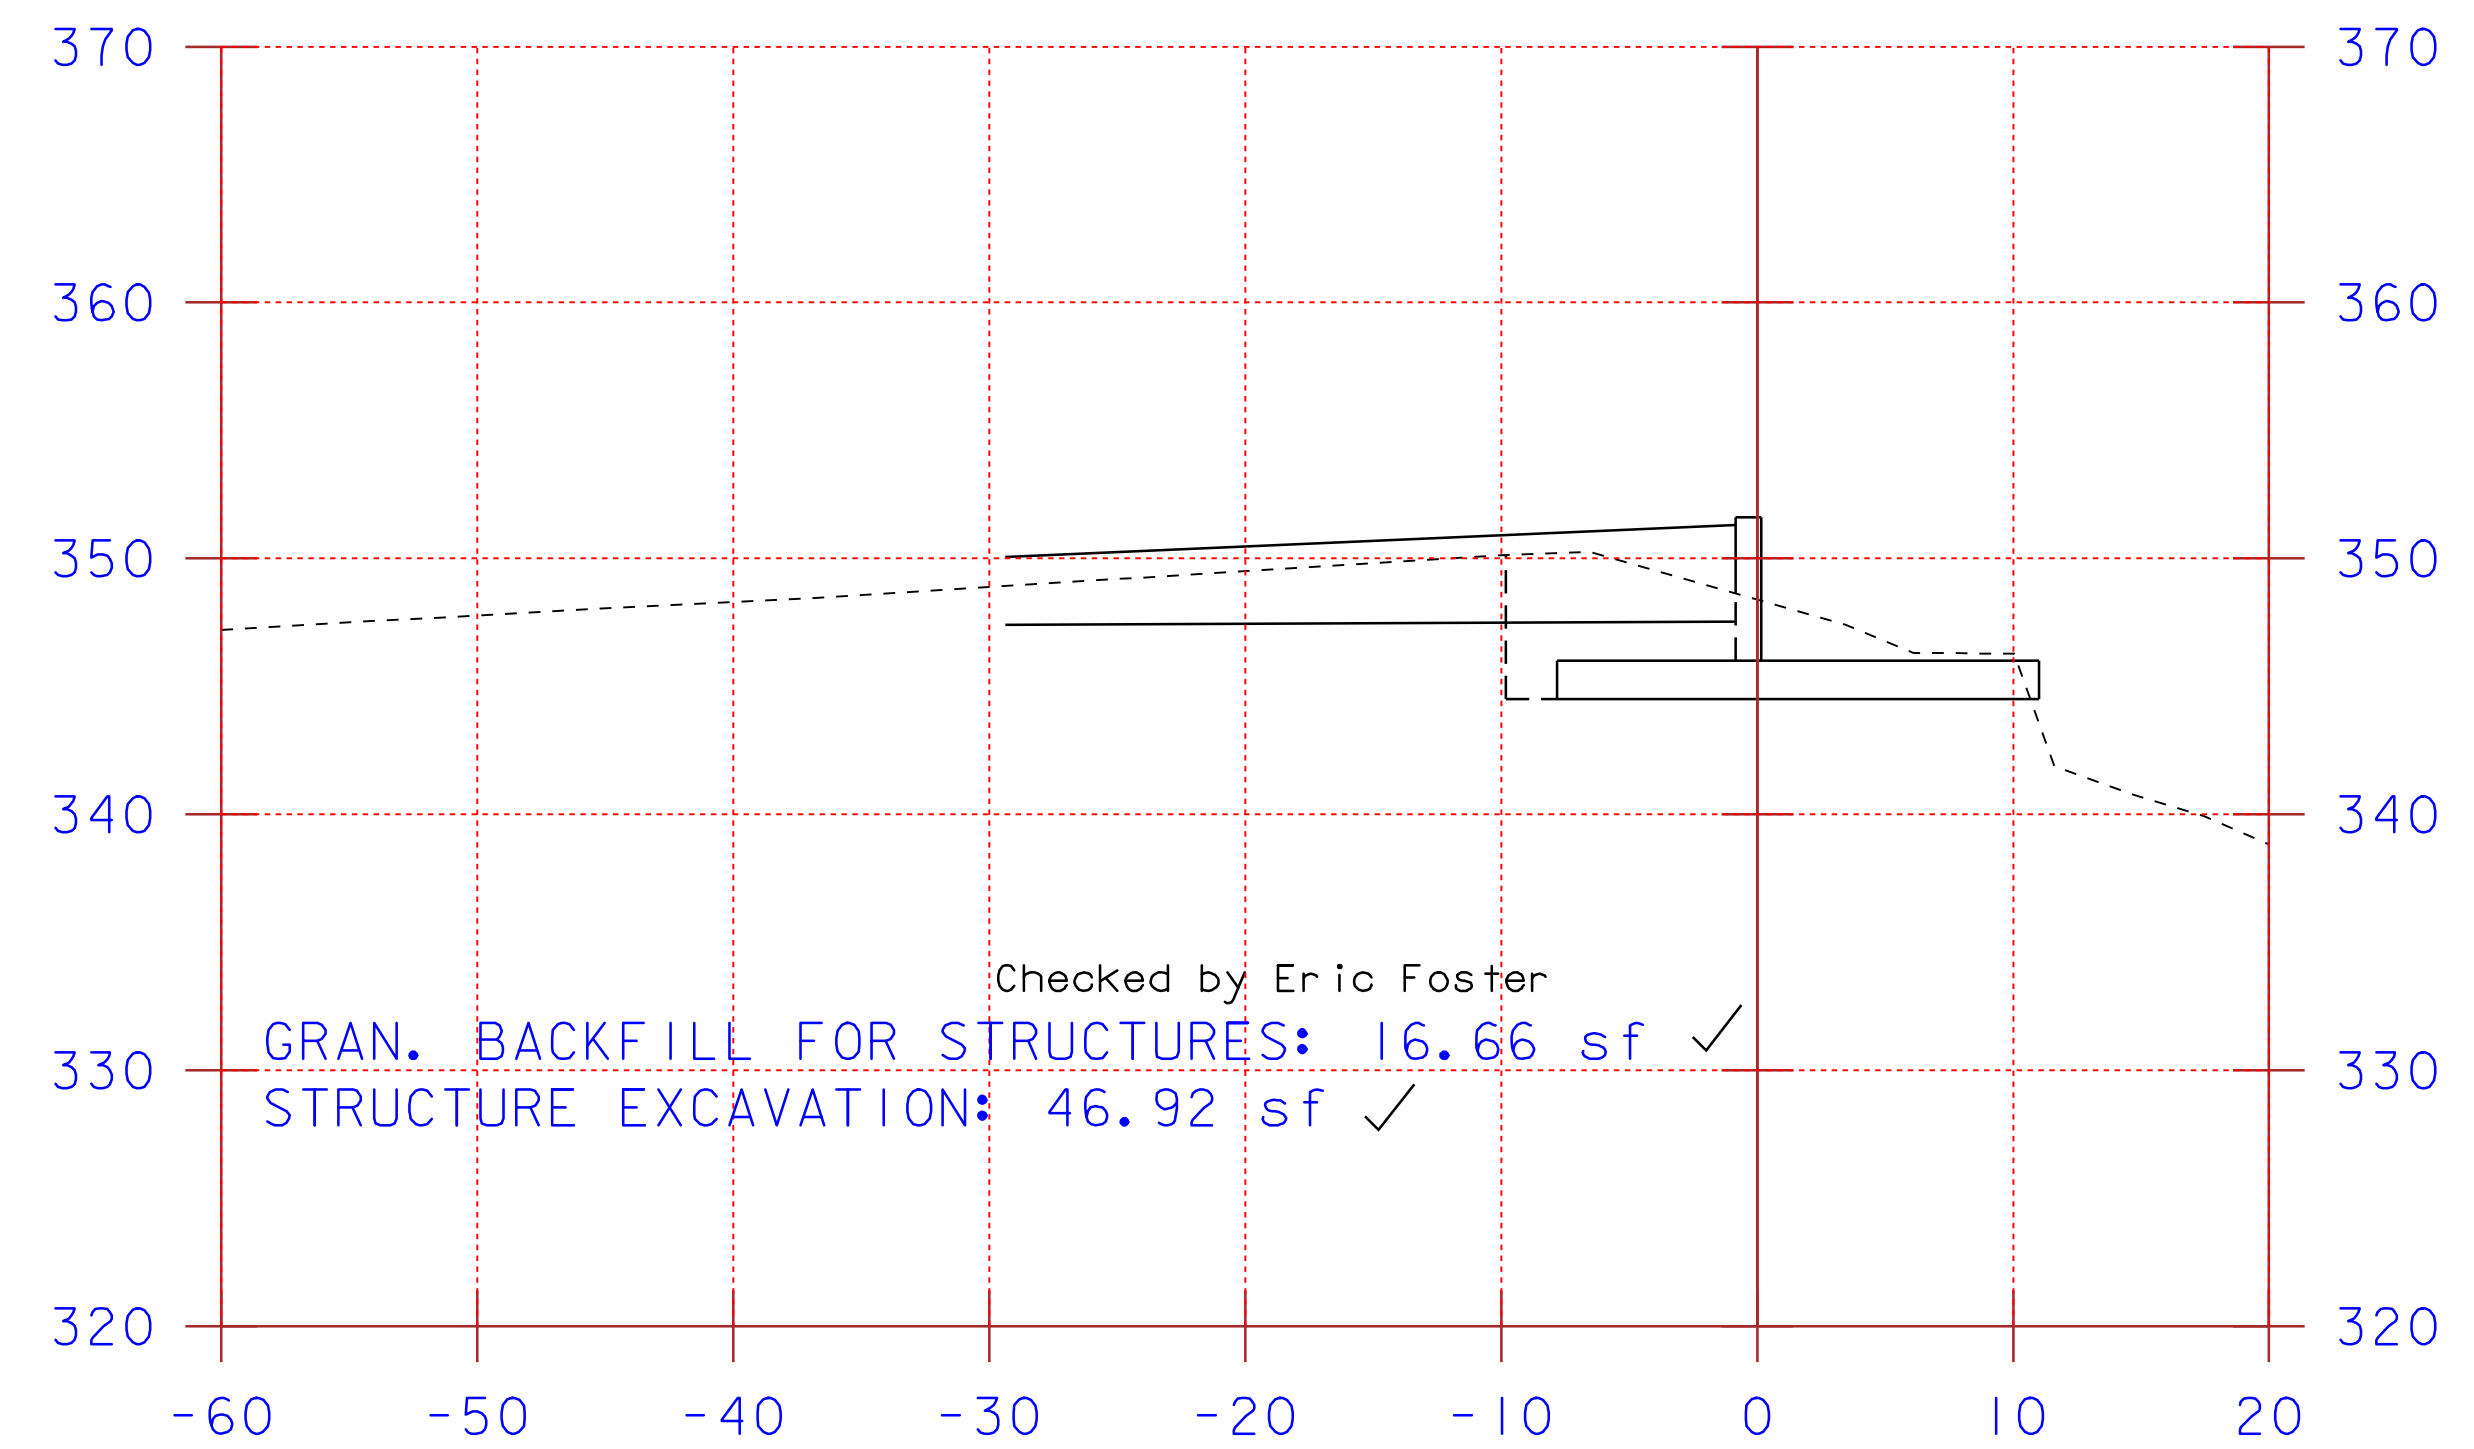

ABUTMENT #1
SCALE: 1"=10'

4+90.9 ahead

Checked by Eric Foster
GRAN. BACKFILL FOR STRUCTURES: 16.66 sf ✓
STRUCTURE EXCAVATION: 46.92 sf ✓

PROJECT NAME: SALISBURY - CORNWALL
PROJECT NUMBER: BHO 1445 (27)

FILE NAME: 96J268\Structures\sj268m01.i PLOT DATE: 19-OCT-2009 09:5
PROJECT MANAGER: R. R. WHITCOMB DRAWN BY: G. ROY
DESIGNED BY: G. ROY CHECKED BY: C. CARLSON
STA. 8+75 - STA. 9+50 SHEET 64 OF 60