



ABUTMENT #1
SCALE: 1"=10'

5+00

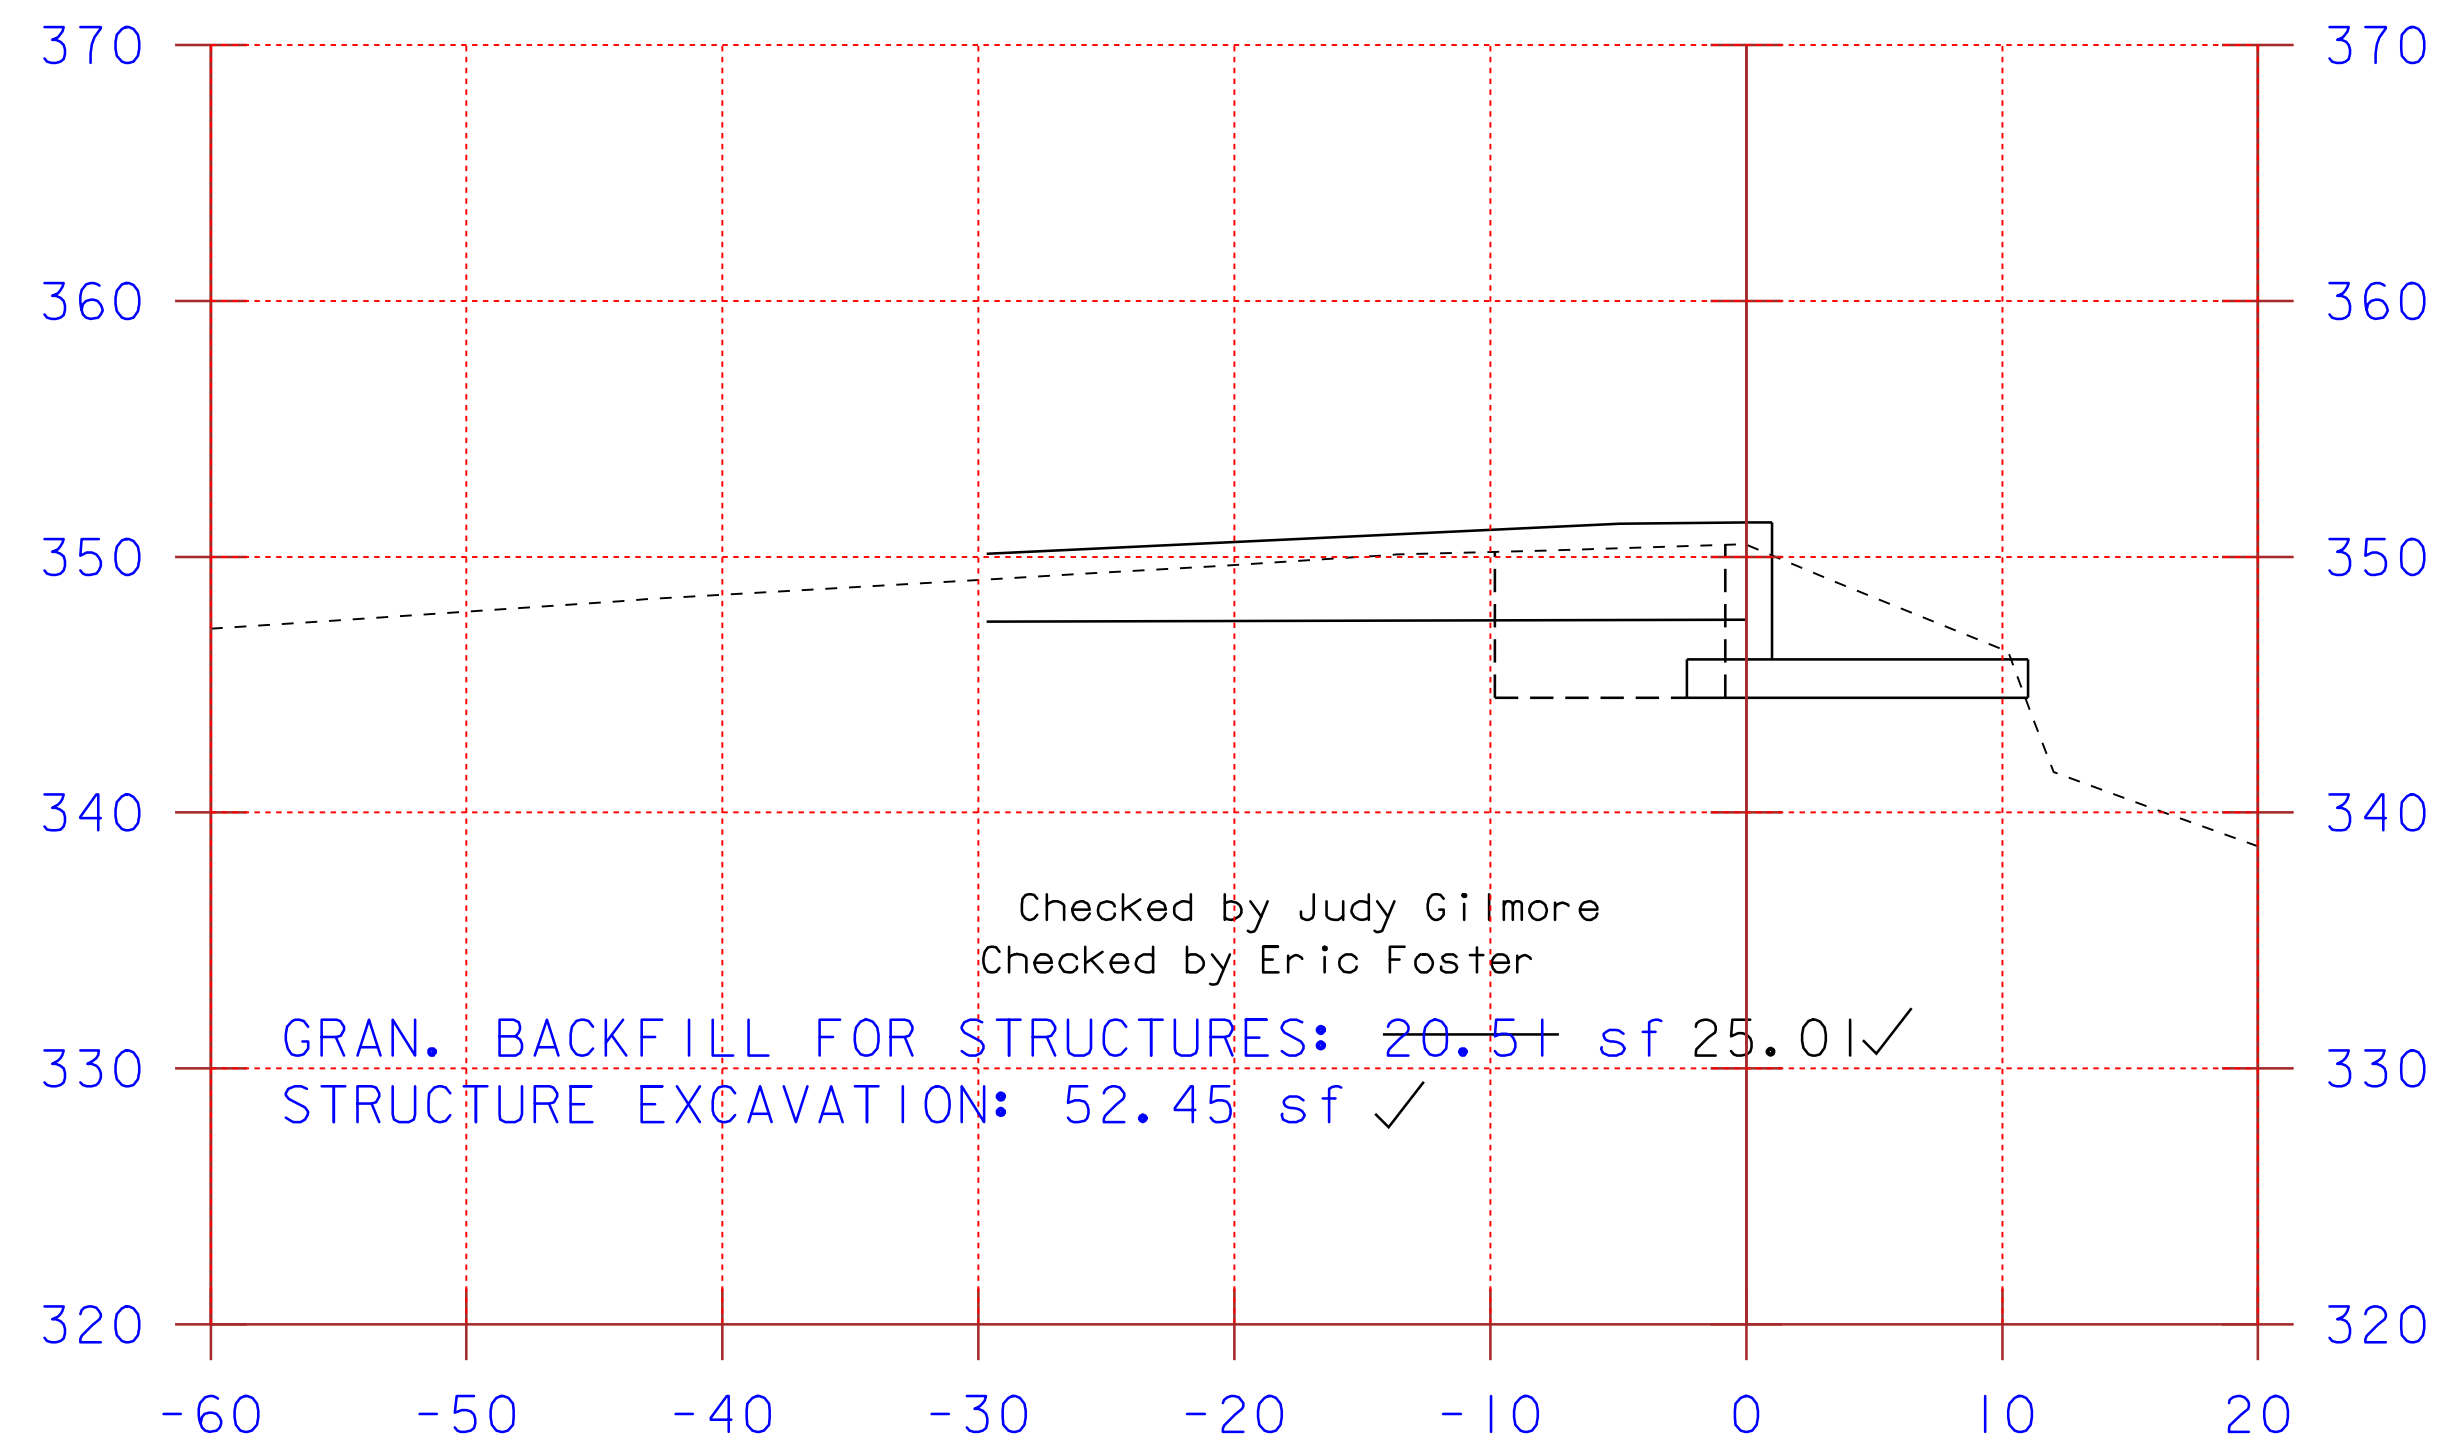

ABUTMENT #1
SCALE: 1"=10'

4+95.2 behind

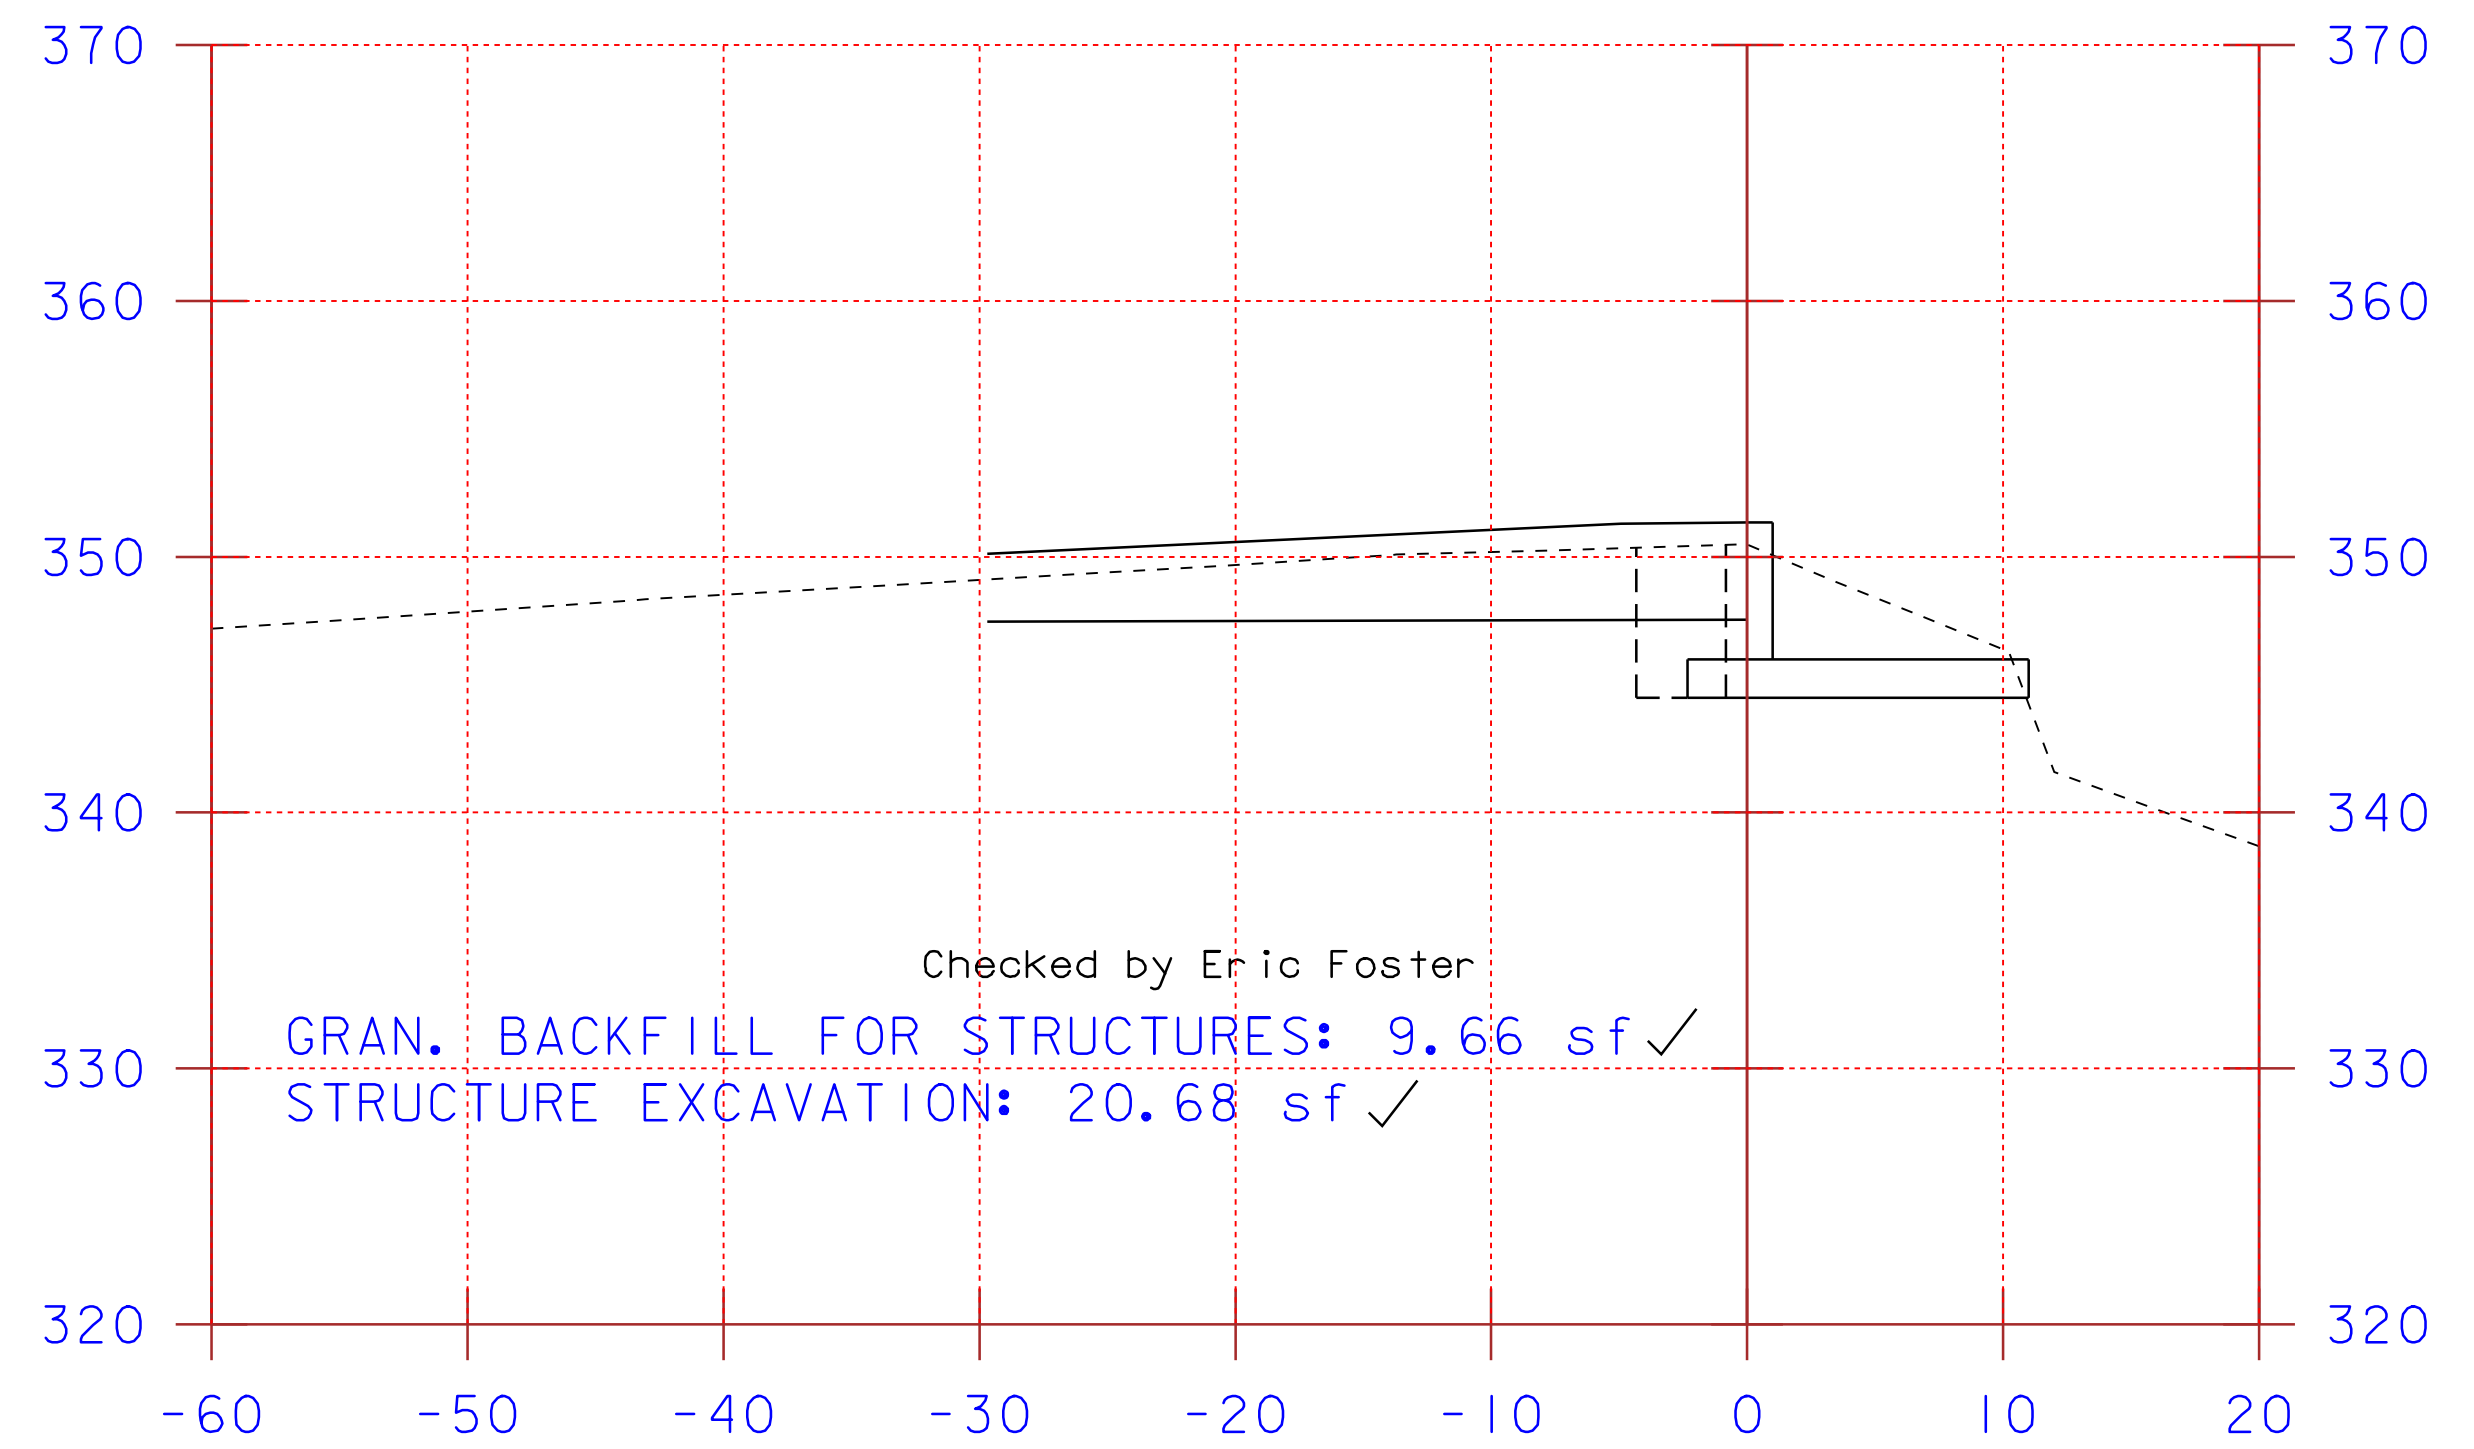

ABUTMENT #1
SCALE: 1"=10'

4+95.2 ahead

PROJECT NAME: SALISBURY - CORNWALL
PROJECT NUMBER: BHO 1445 (27)

FILE NAME: 96J268\Structures\sj268m01.I PLOT DATE: 19-OCT-2009 09:5
PROJECT MANAGER: R. R. WHITCOMB DRAWN BY: G. ROY
DESIGNED BY: G. ROY CHECKED BY: C. CARLSON
STA. 8+75 - STA. 9+50 SHEET 66 OF 60