



ABUTMENT #1
SCALE: 1"=10'

5+06.8 behind

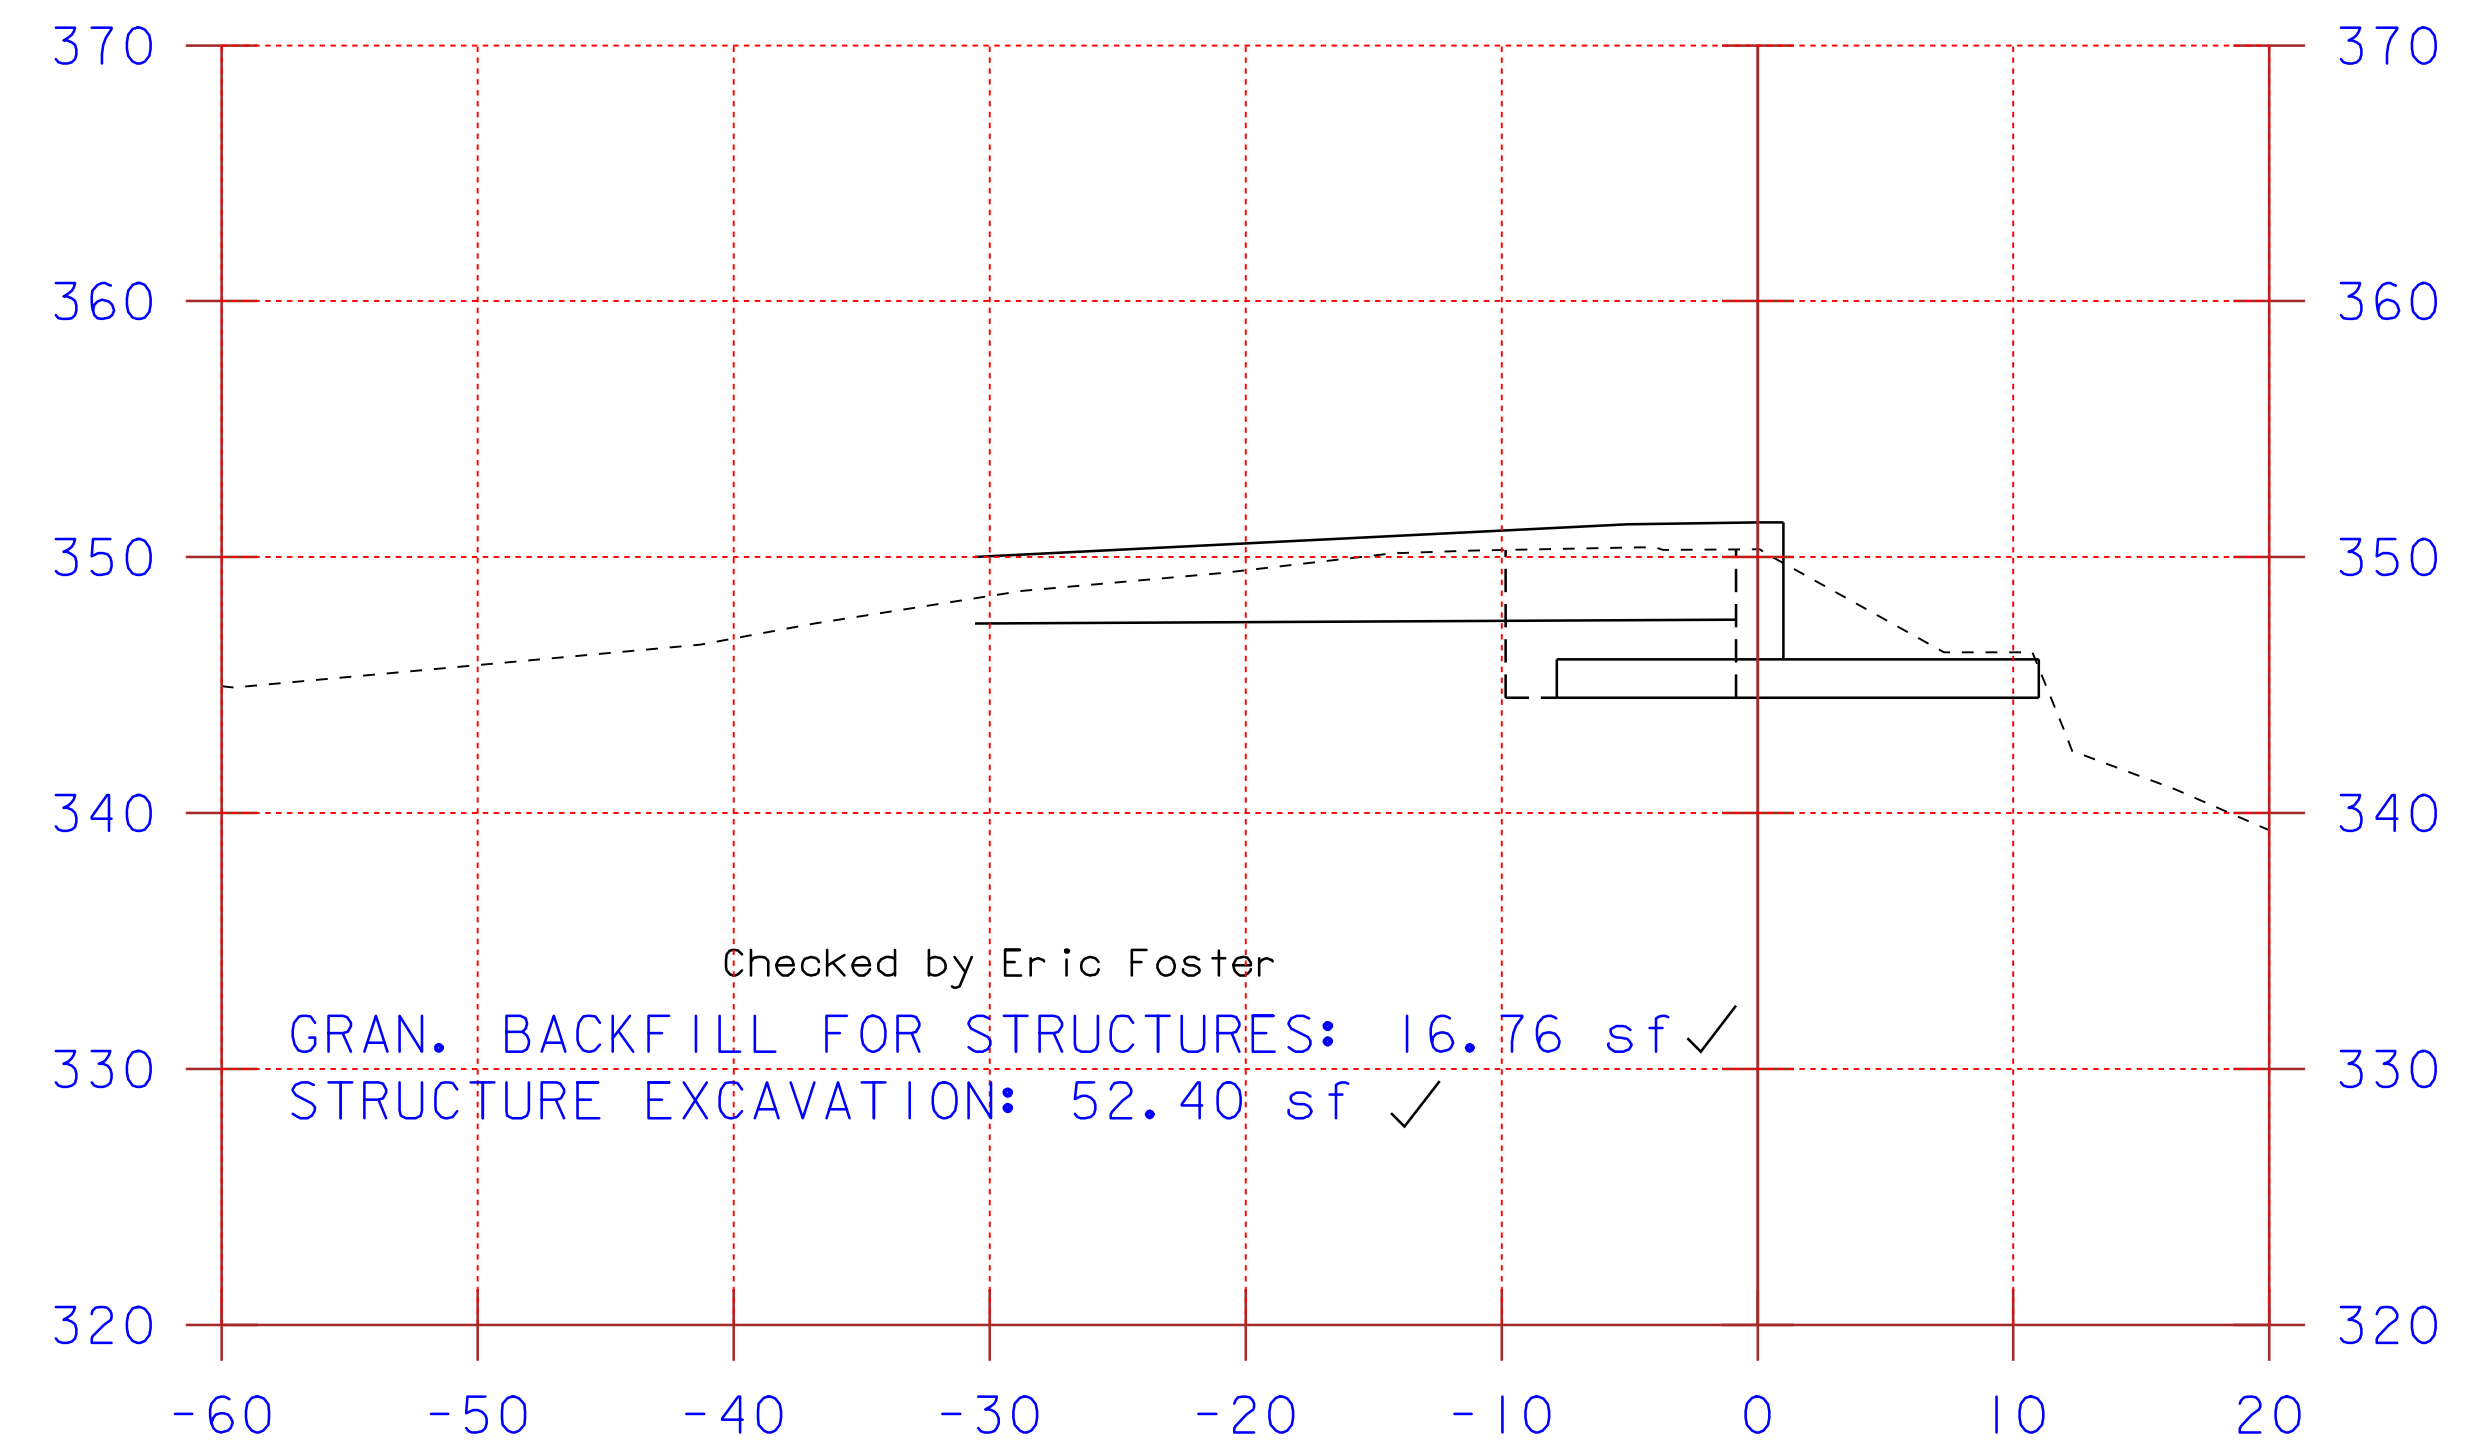


ABUTMENT #1
SCALE: 1"=10'

5+06.8 ahead

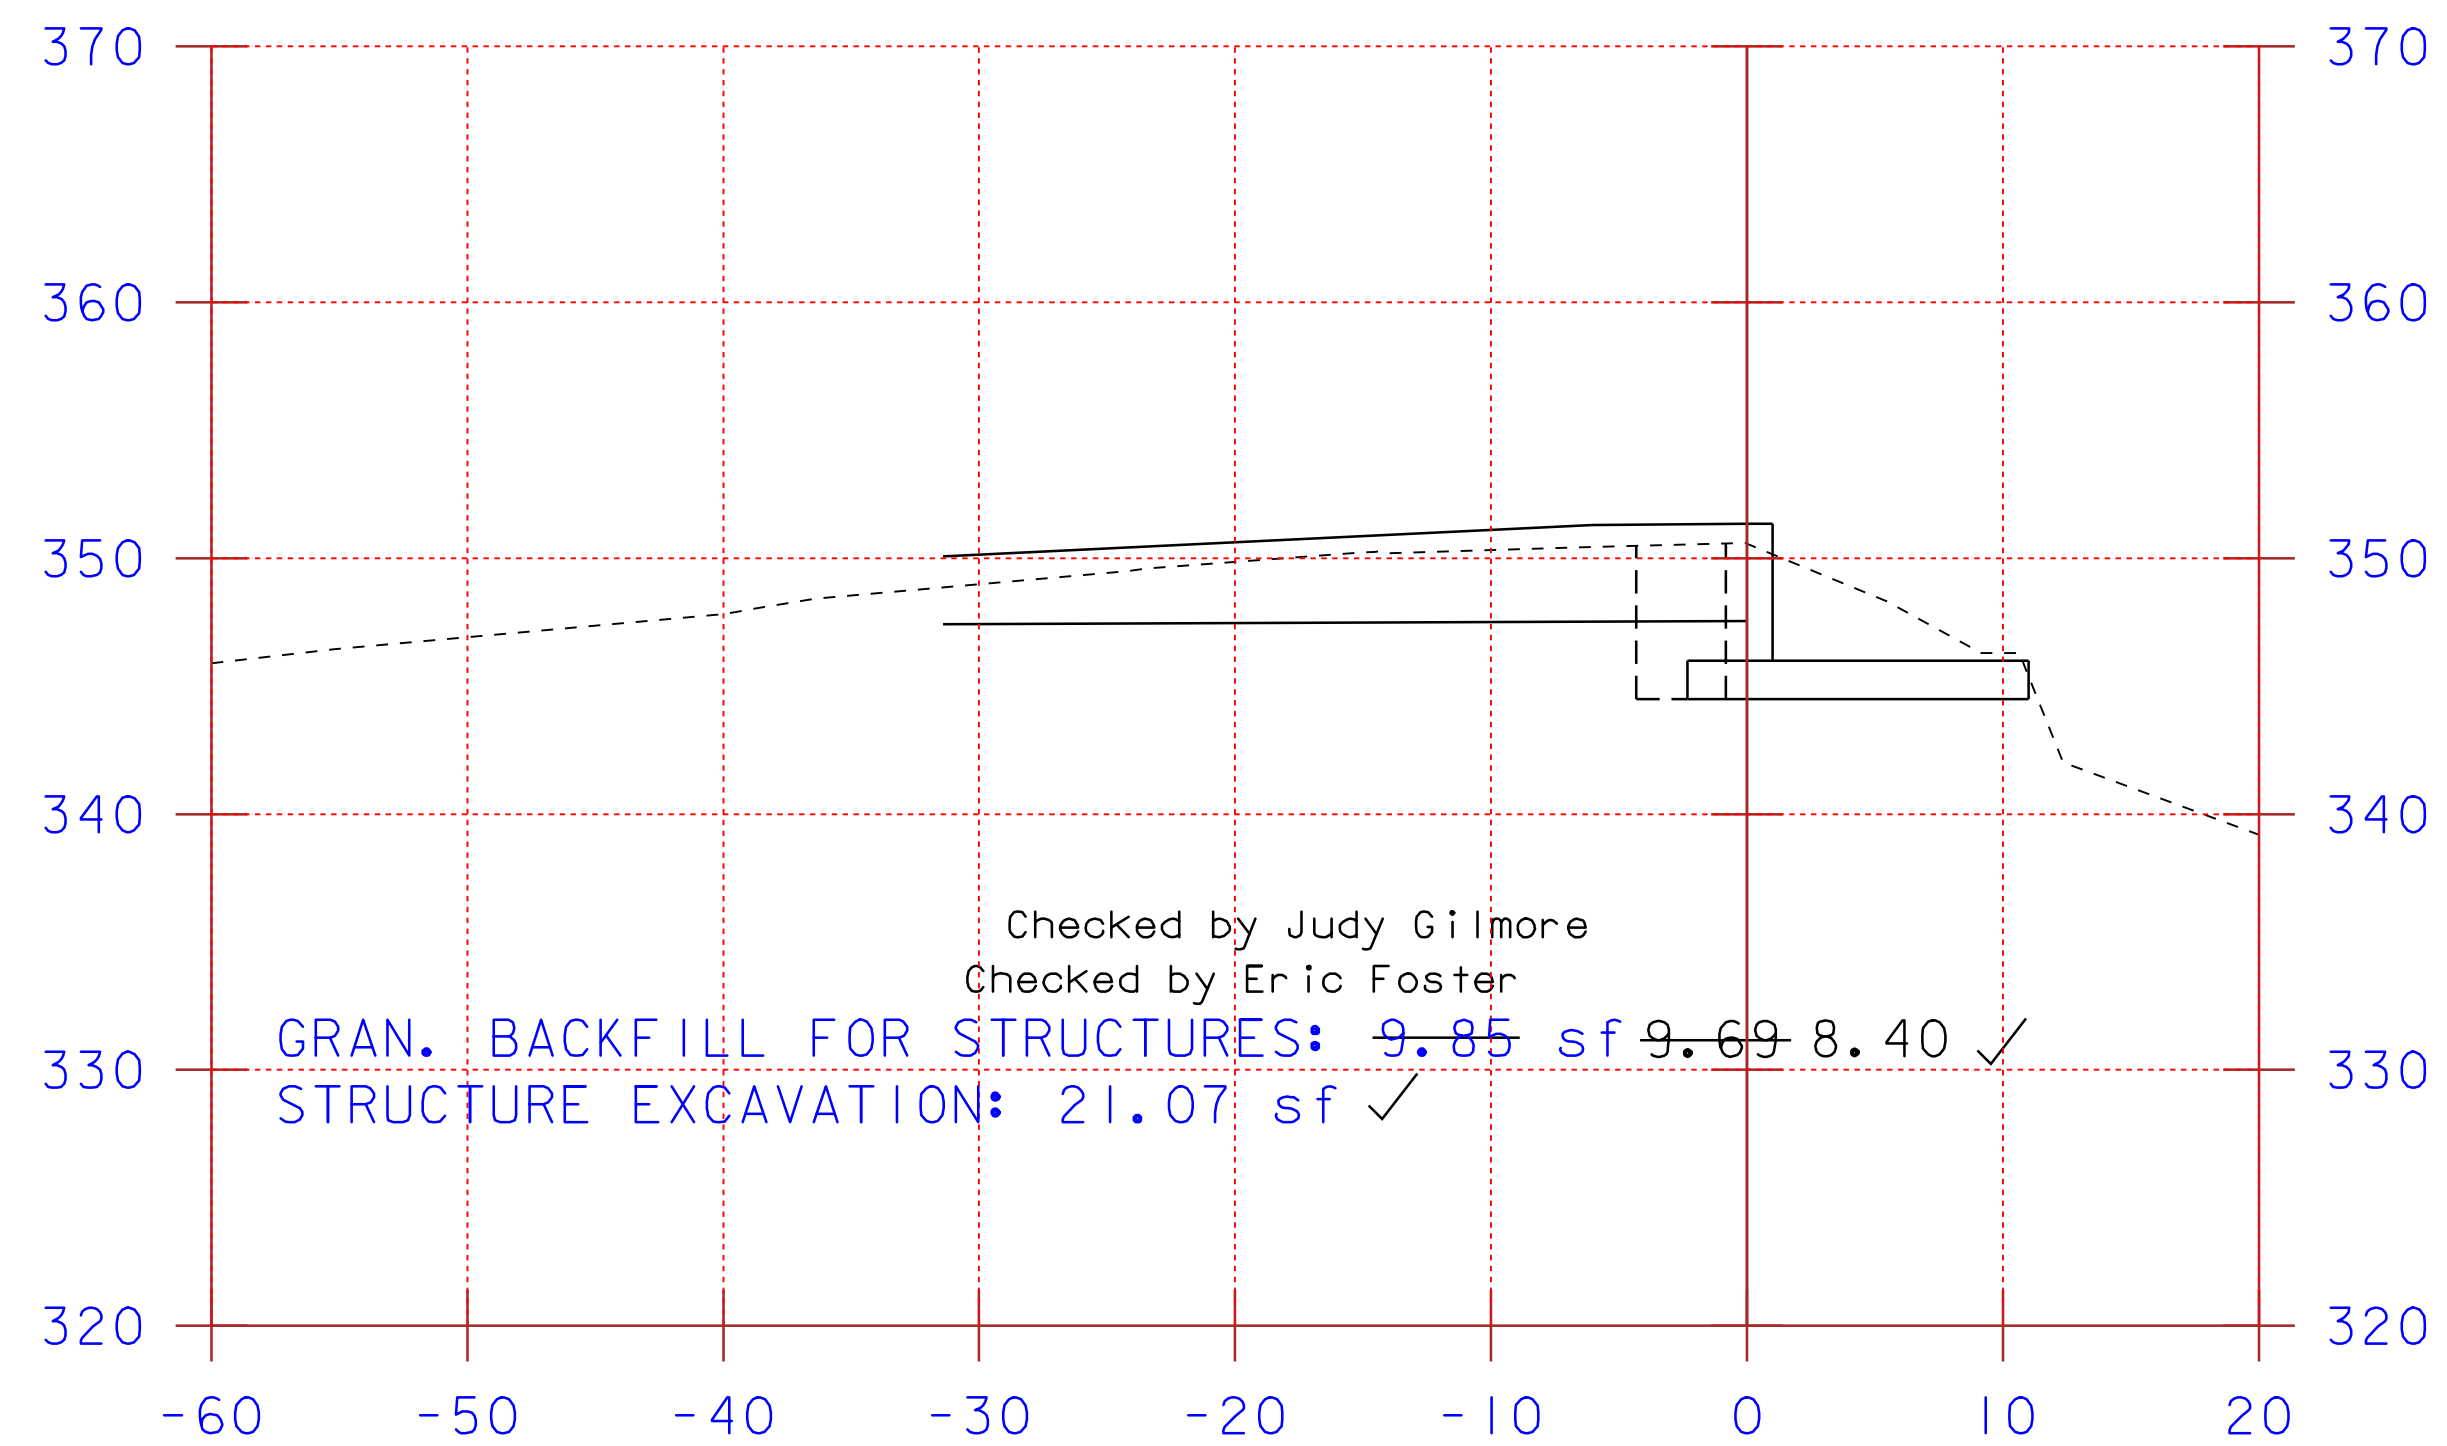

ABUTMENT #1
SCALE: 1"=10'

5+04.8 behind

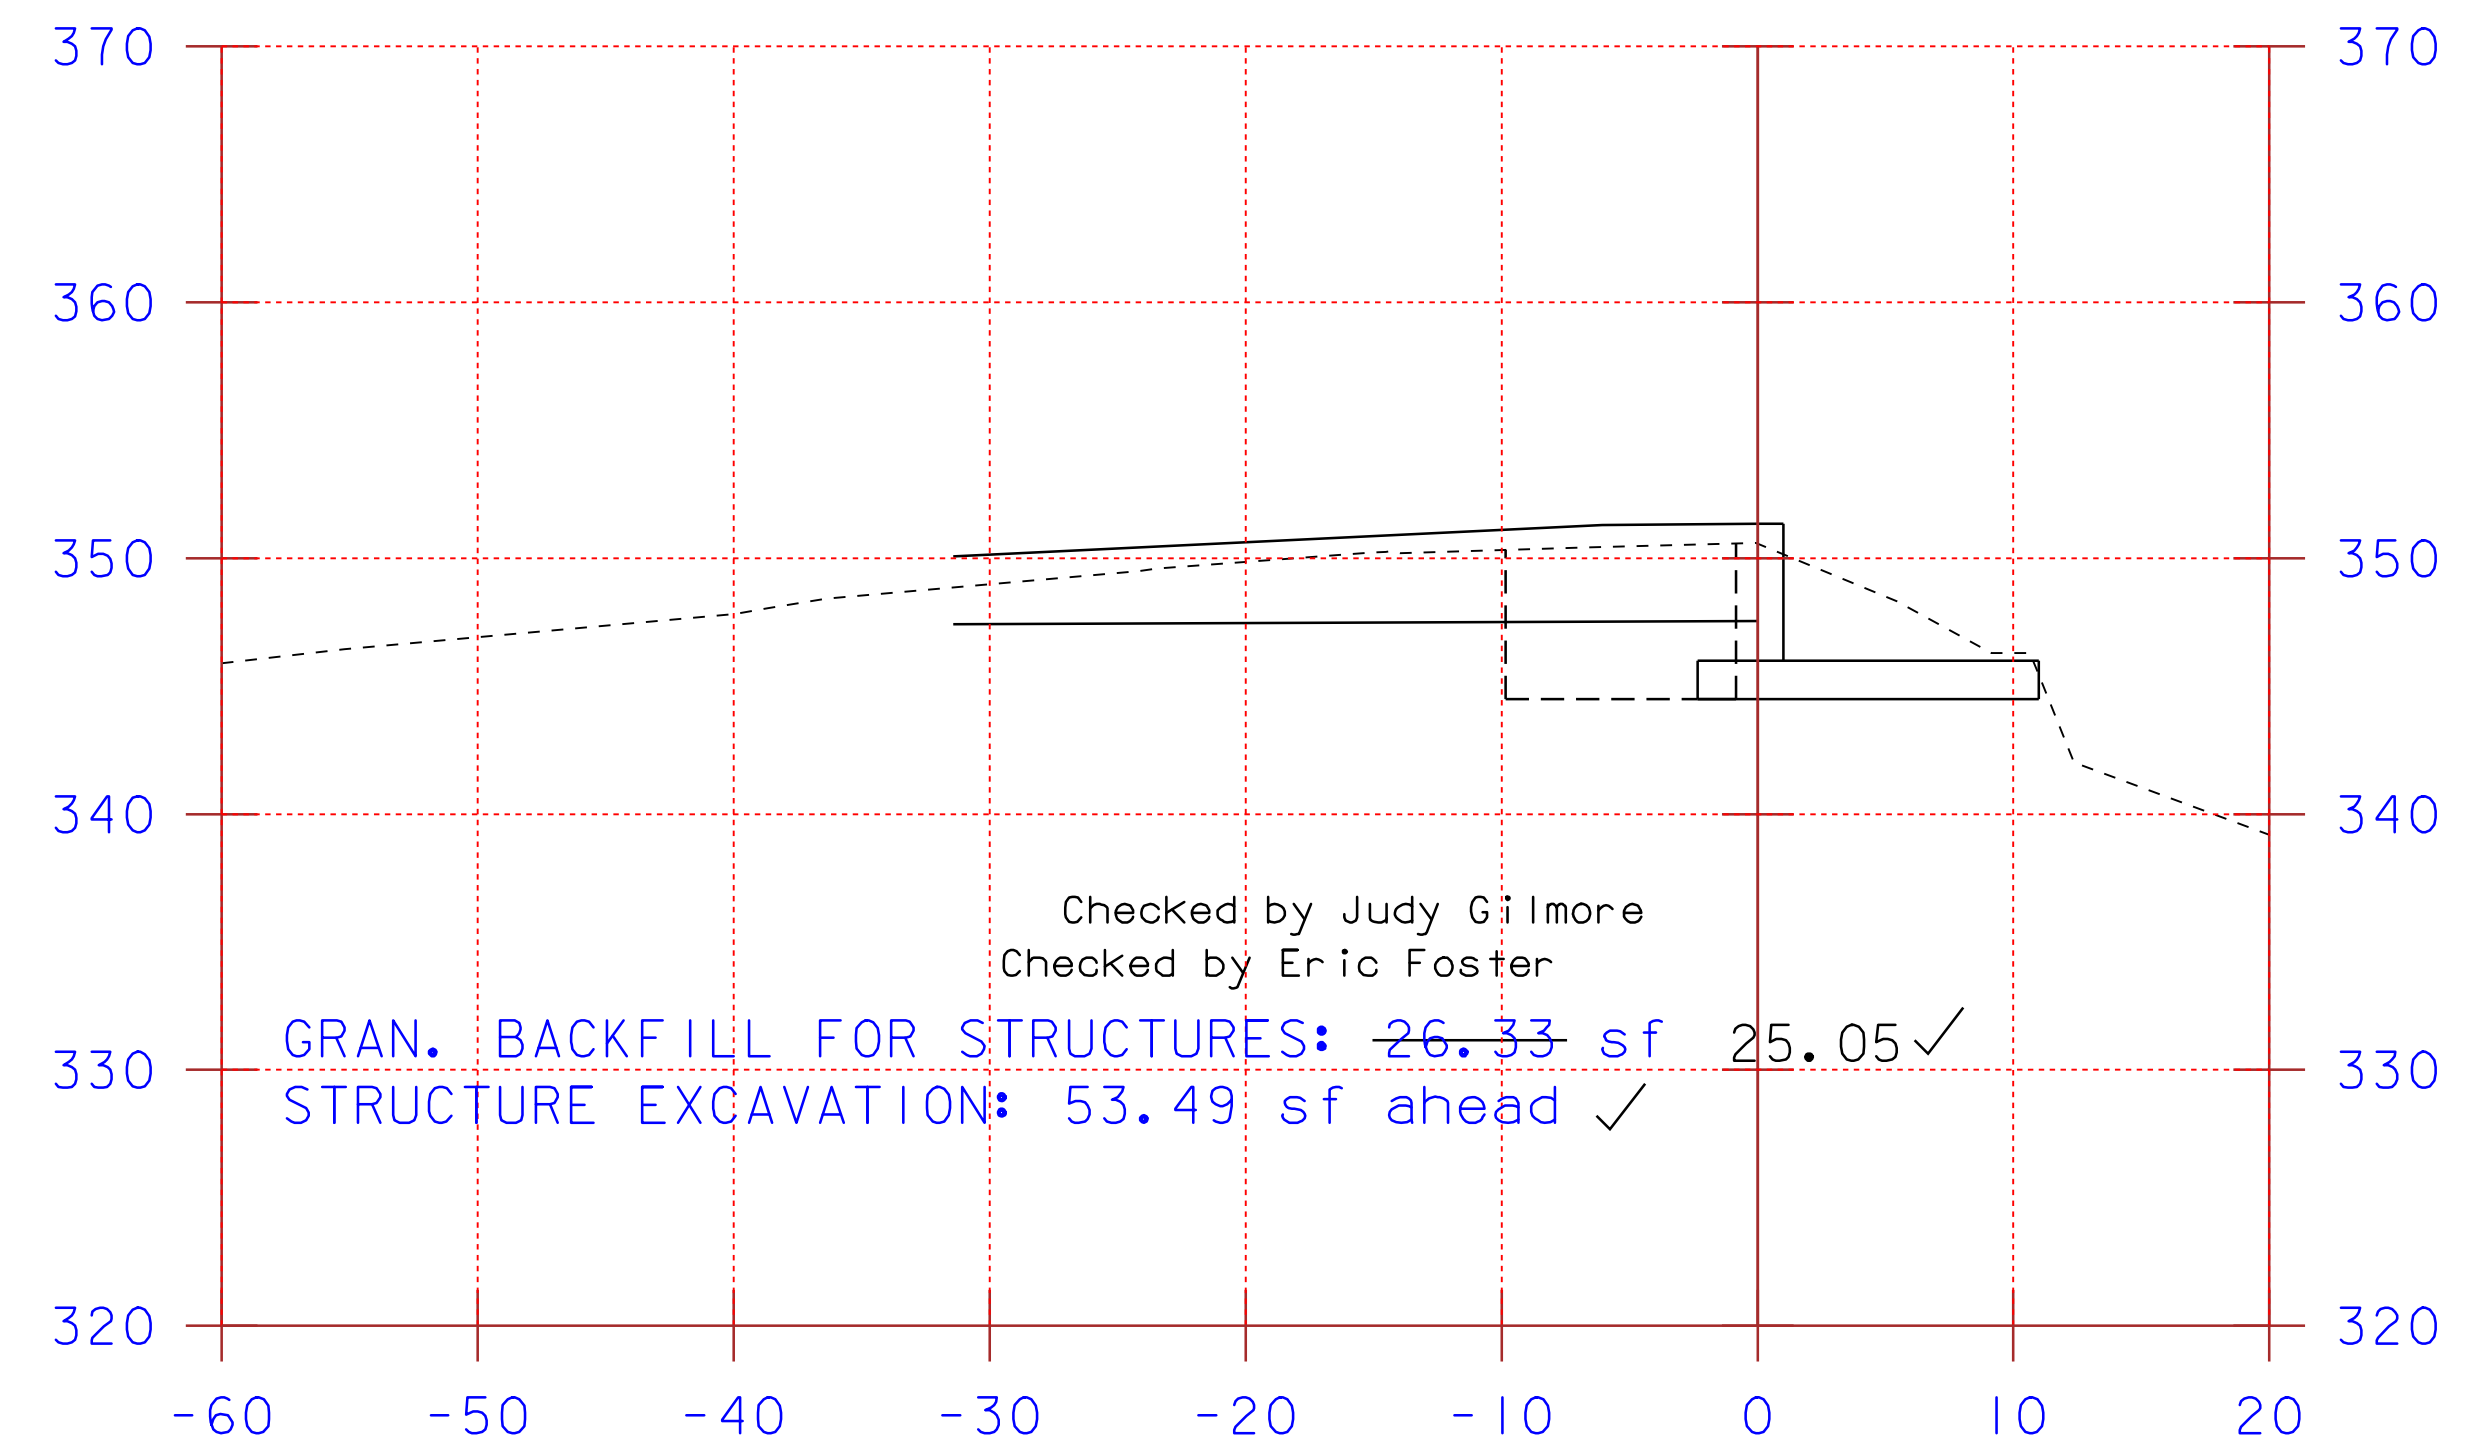

ABUTMENT #1
SCALE: 1"=10'

5+04.8 ahead

PROJECT NAME:	SALISBURY - CORNWALL		
PROJECT NUMBER:	BHO 1445 (27)		
FILE NAME:	96J268\Structures\sj268m01.l	PLOT DATE:	19-OCT-2009 09:5
PROJECT MANAGER:	R. R. WHITCOMB	DRAWN BY:	G. ROY
DESIGNED BY:	G. ROY	CHECKED BY:	C. CARLSON
STA. 8+75 - STA. 9+50		SHEET	67 OF 60