



ABUTMENT #1
 SCALE: 1"=10'

5+09.7 behind

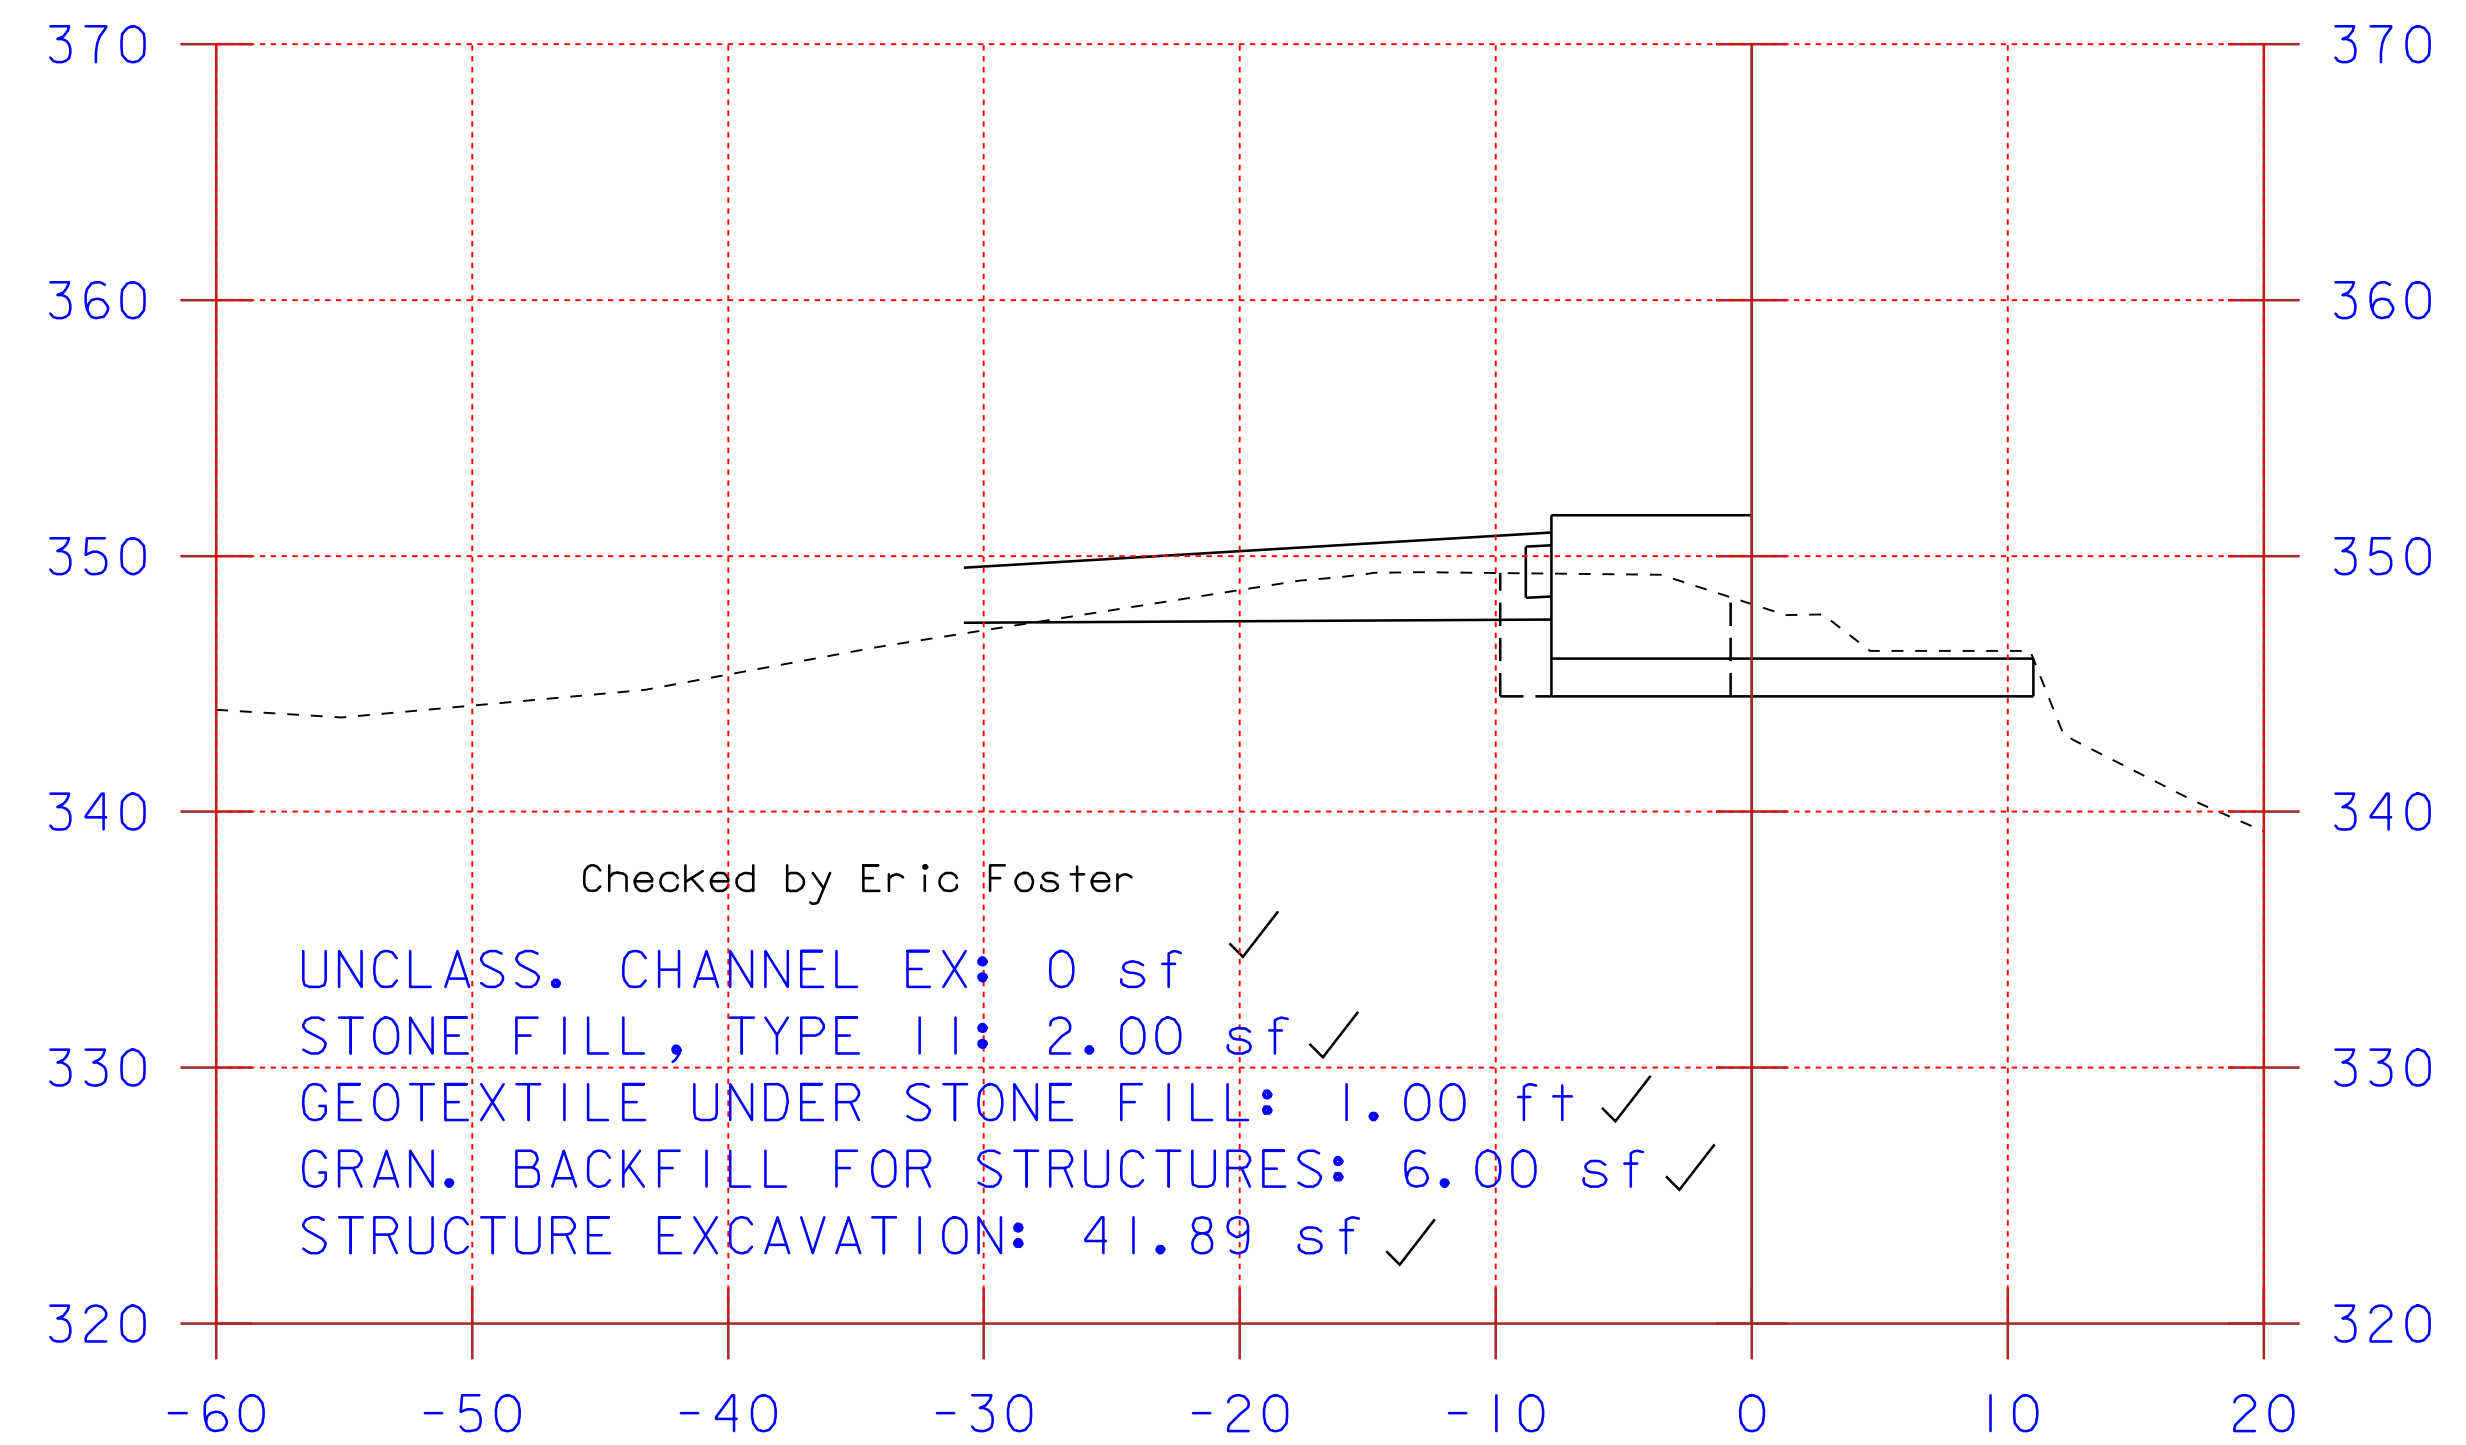


ABUTMENT #1
 SCALE: 1"=10'

5+09.7 ahead

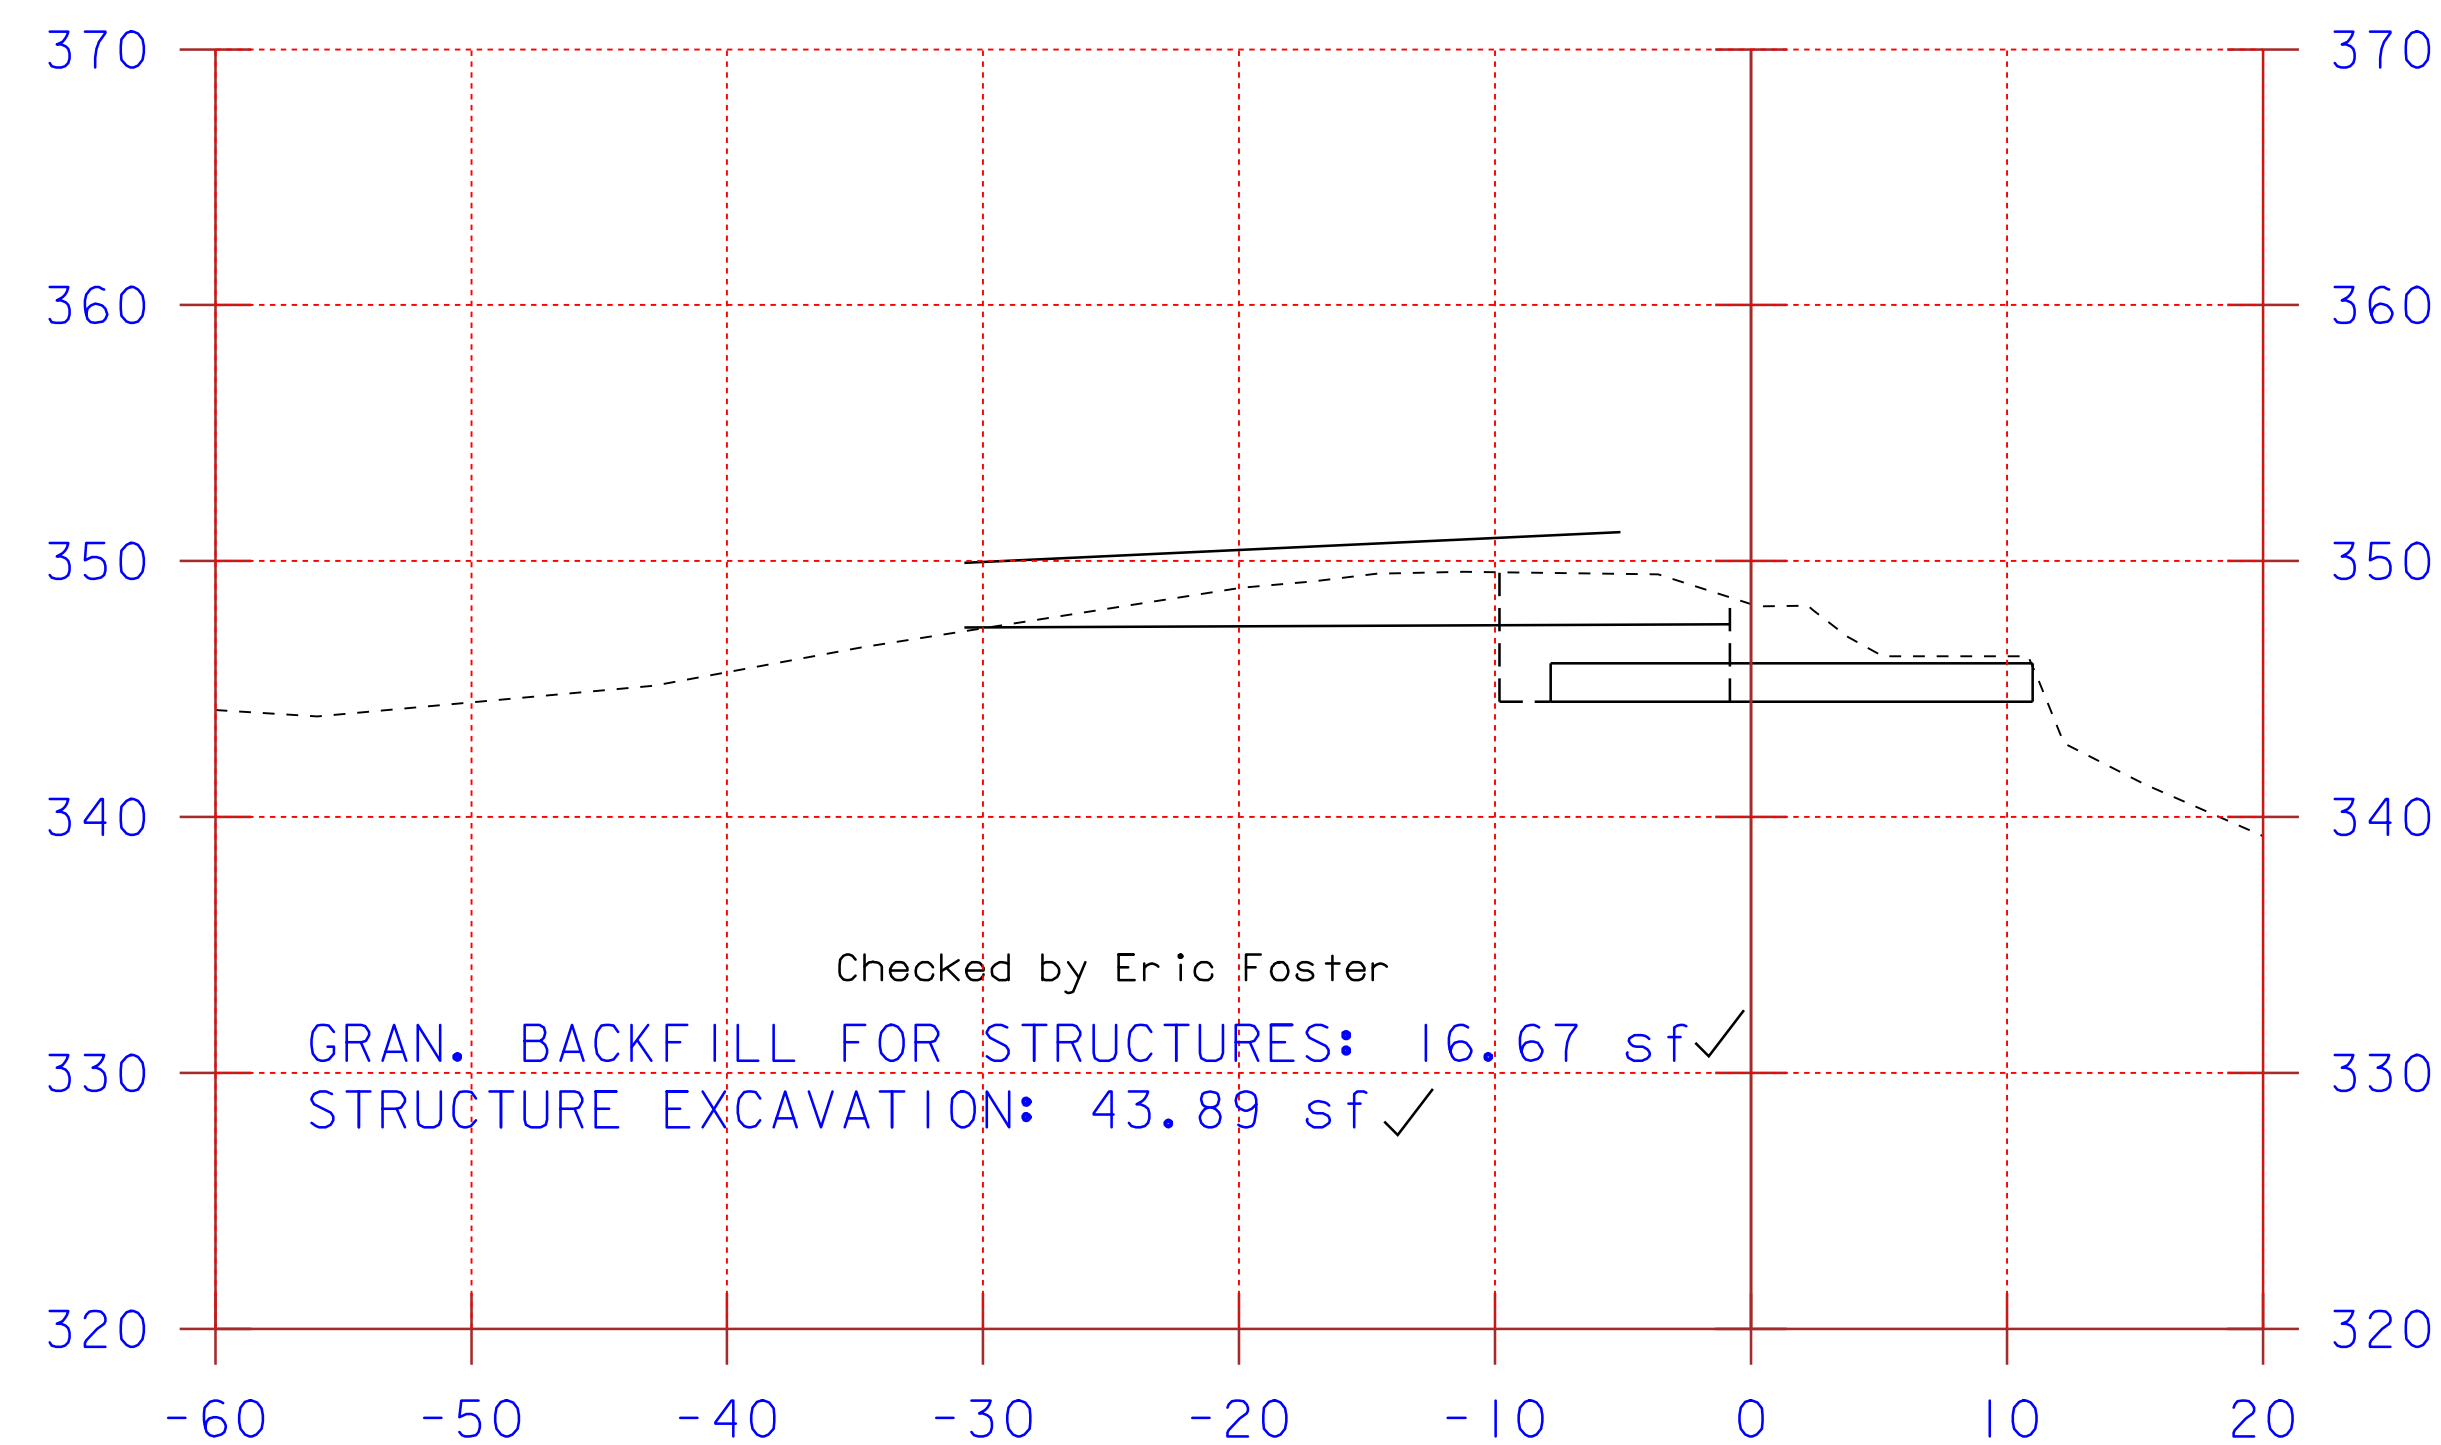

ABUTMENT #1
 SCALE: 1"=10'

5+09.1 behind

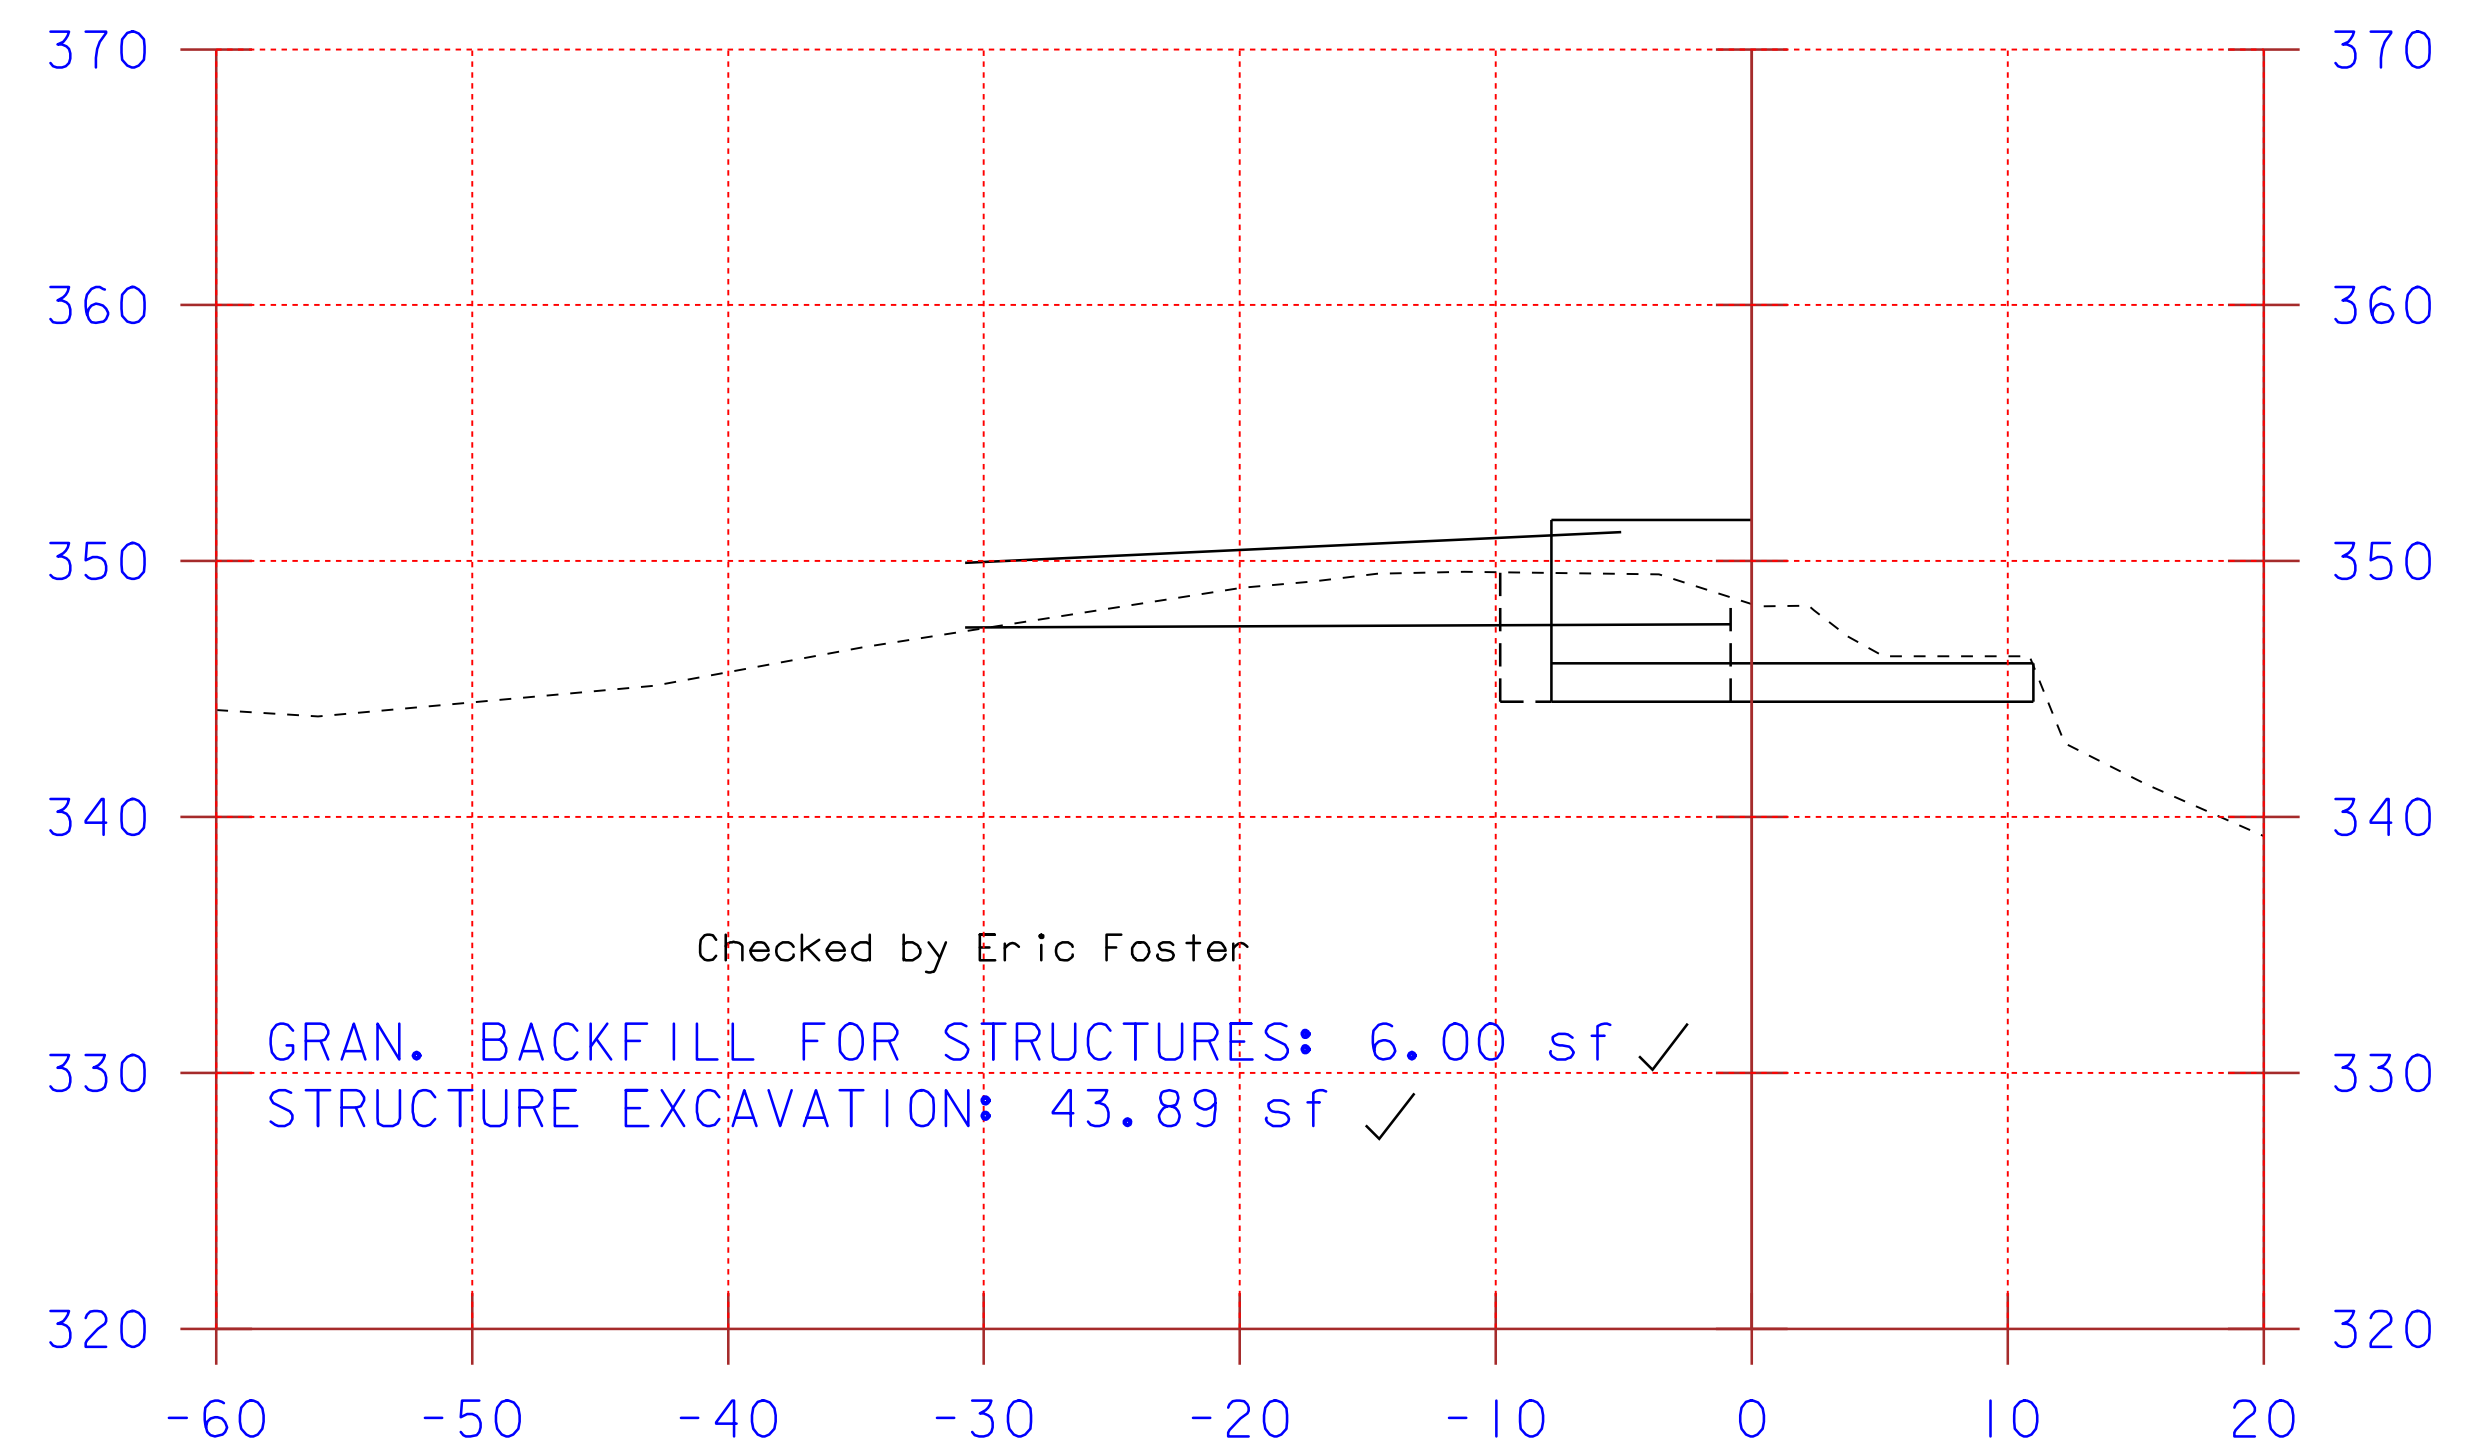

ABUTMENT #1
 SCALE: 1"=10'

5+09.1 ahead

PROJECT NAME: SALISBURY - CORNWALL
 PROJECT NUMBER: BHO 1445 (27)

FILE NAME: 96J268\Structures\sj268m01.i PLOT DATE: 19-OCT-2009 09:5
 PROJECT MANAGER: R. R. WHITCOMB DRAWN BY: G. ROY
 DESIGNED BY: G. ROY CHECKED BY: C. CARLSON
 STA. 8+75 - STA. 9+50 SHEET 68 OF 60