




ABUTMENT #1
SCALE: 1"=10' 5+10.1 ahead

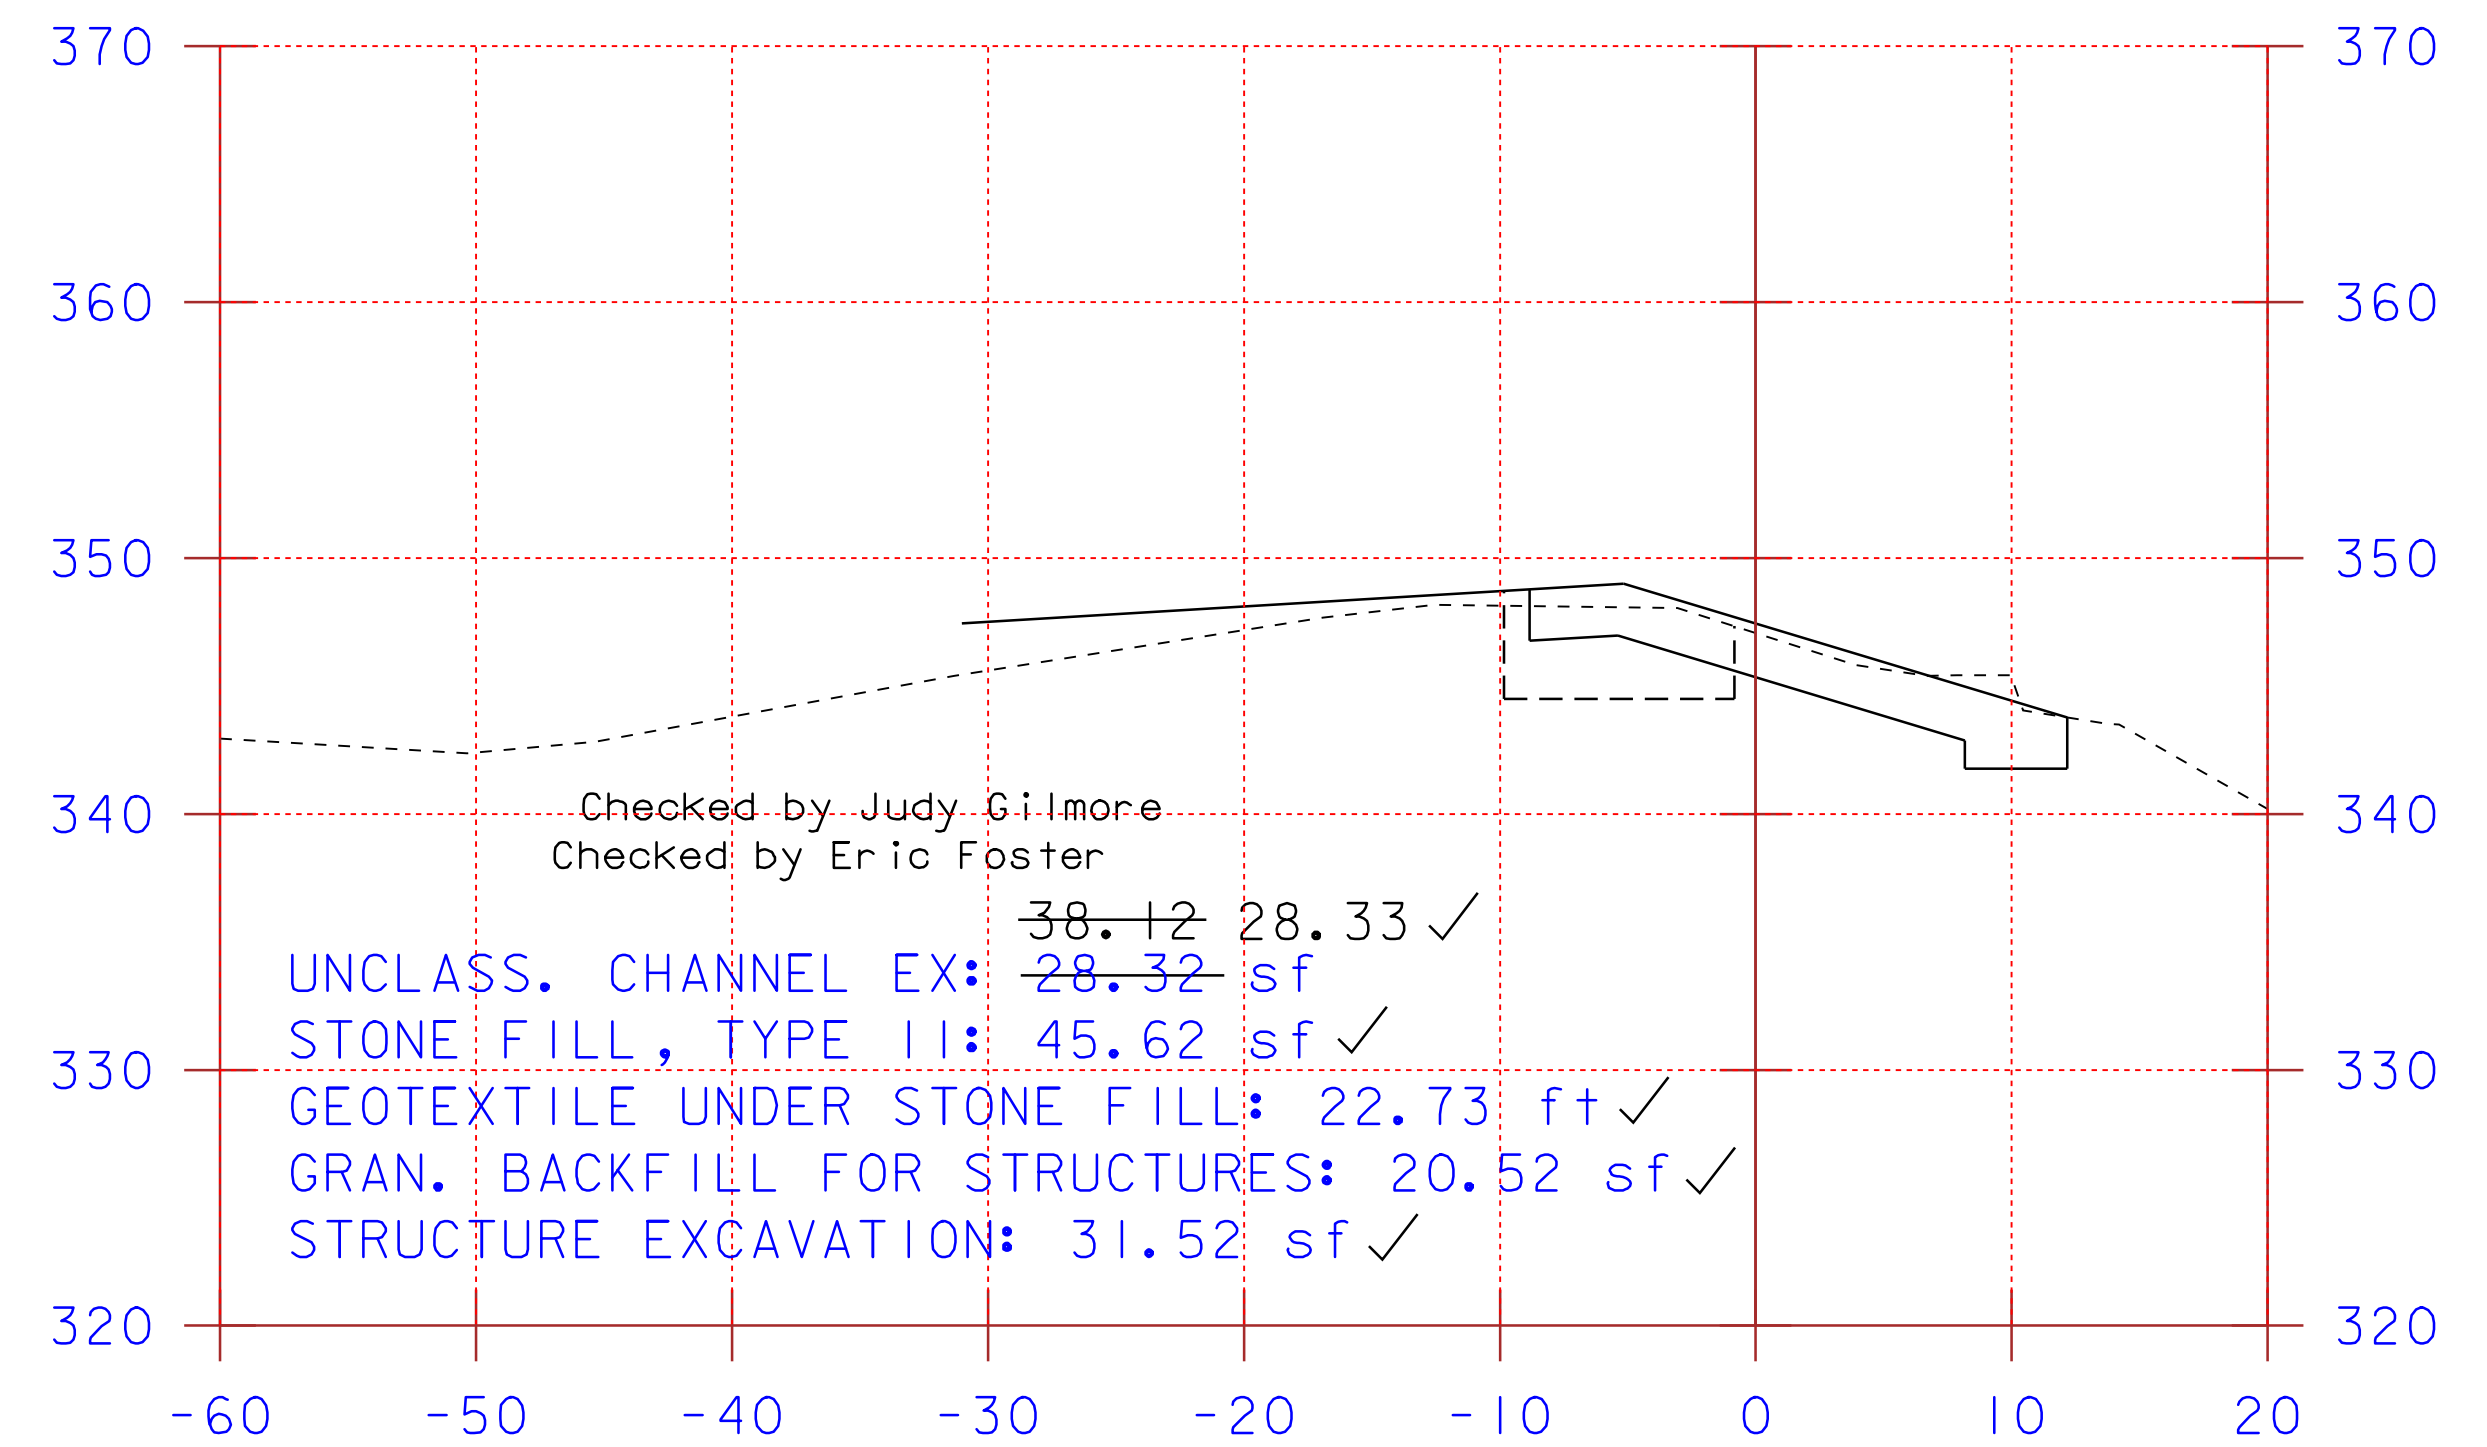

ABUTMENT #1
SCALE: 1"=10' 5+12.8 behind

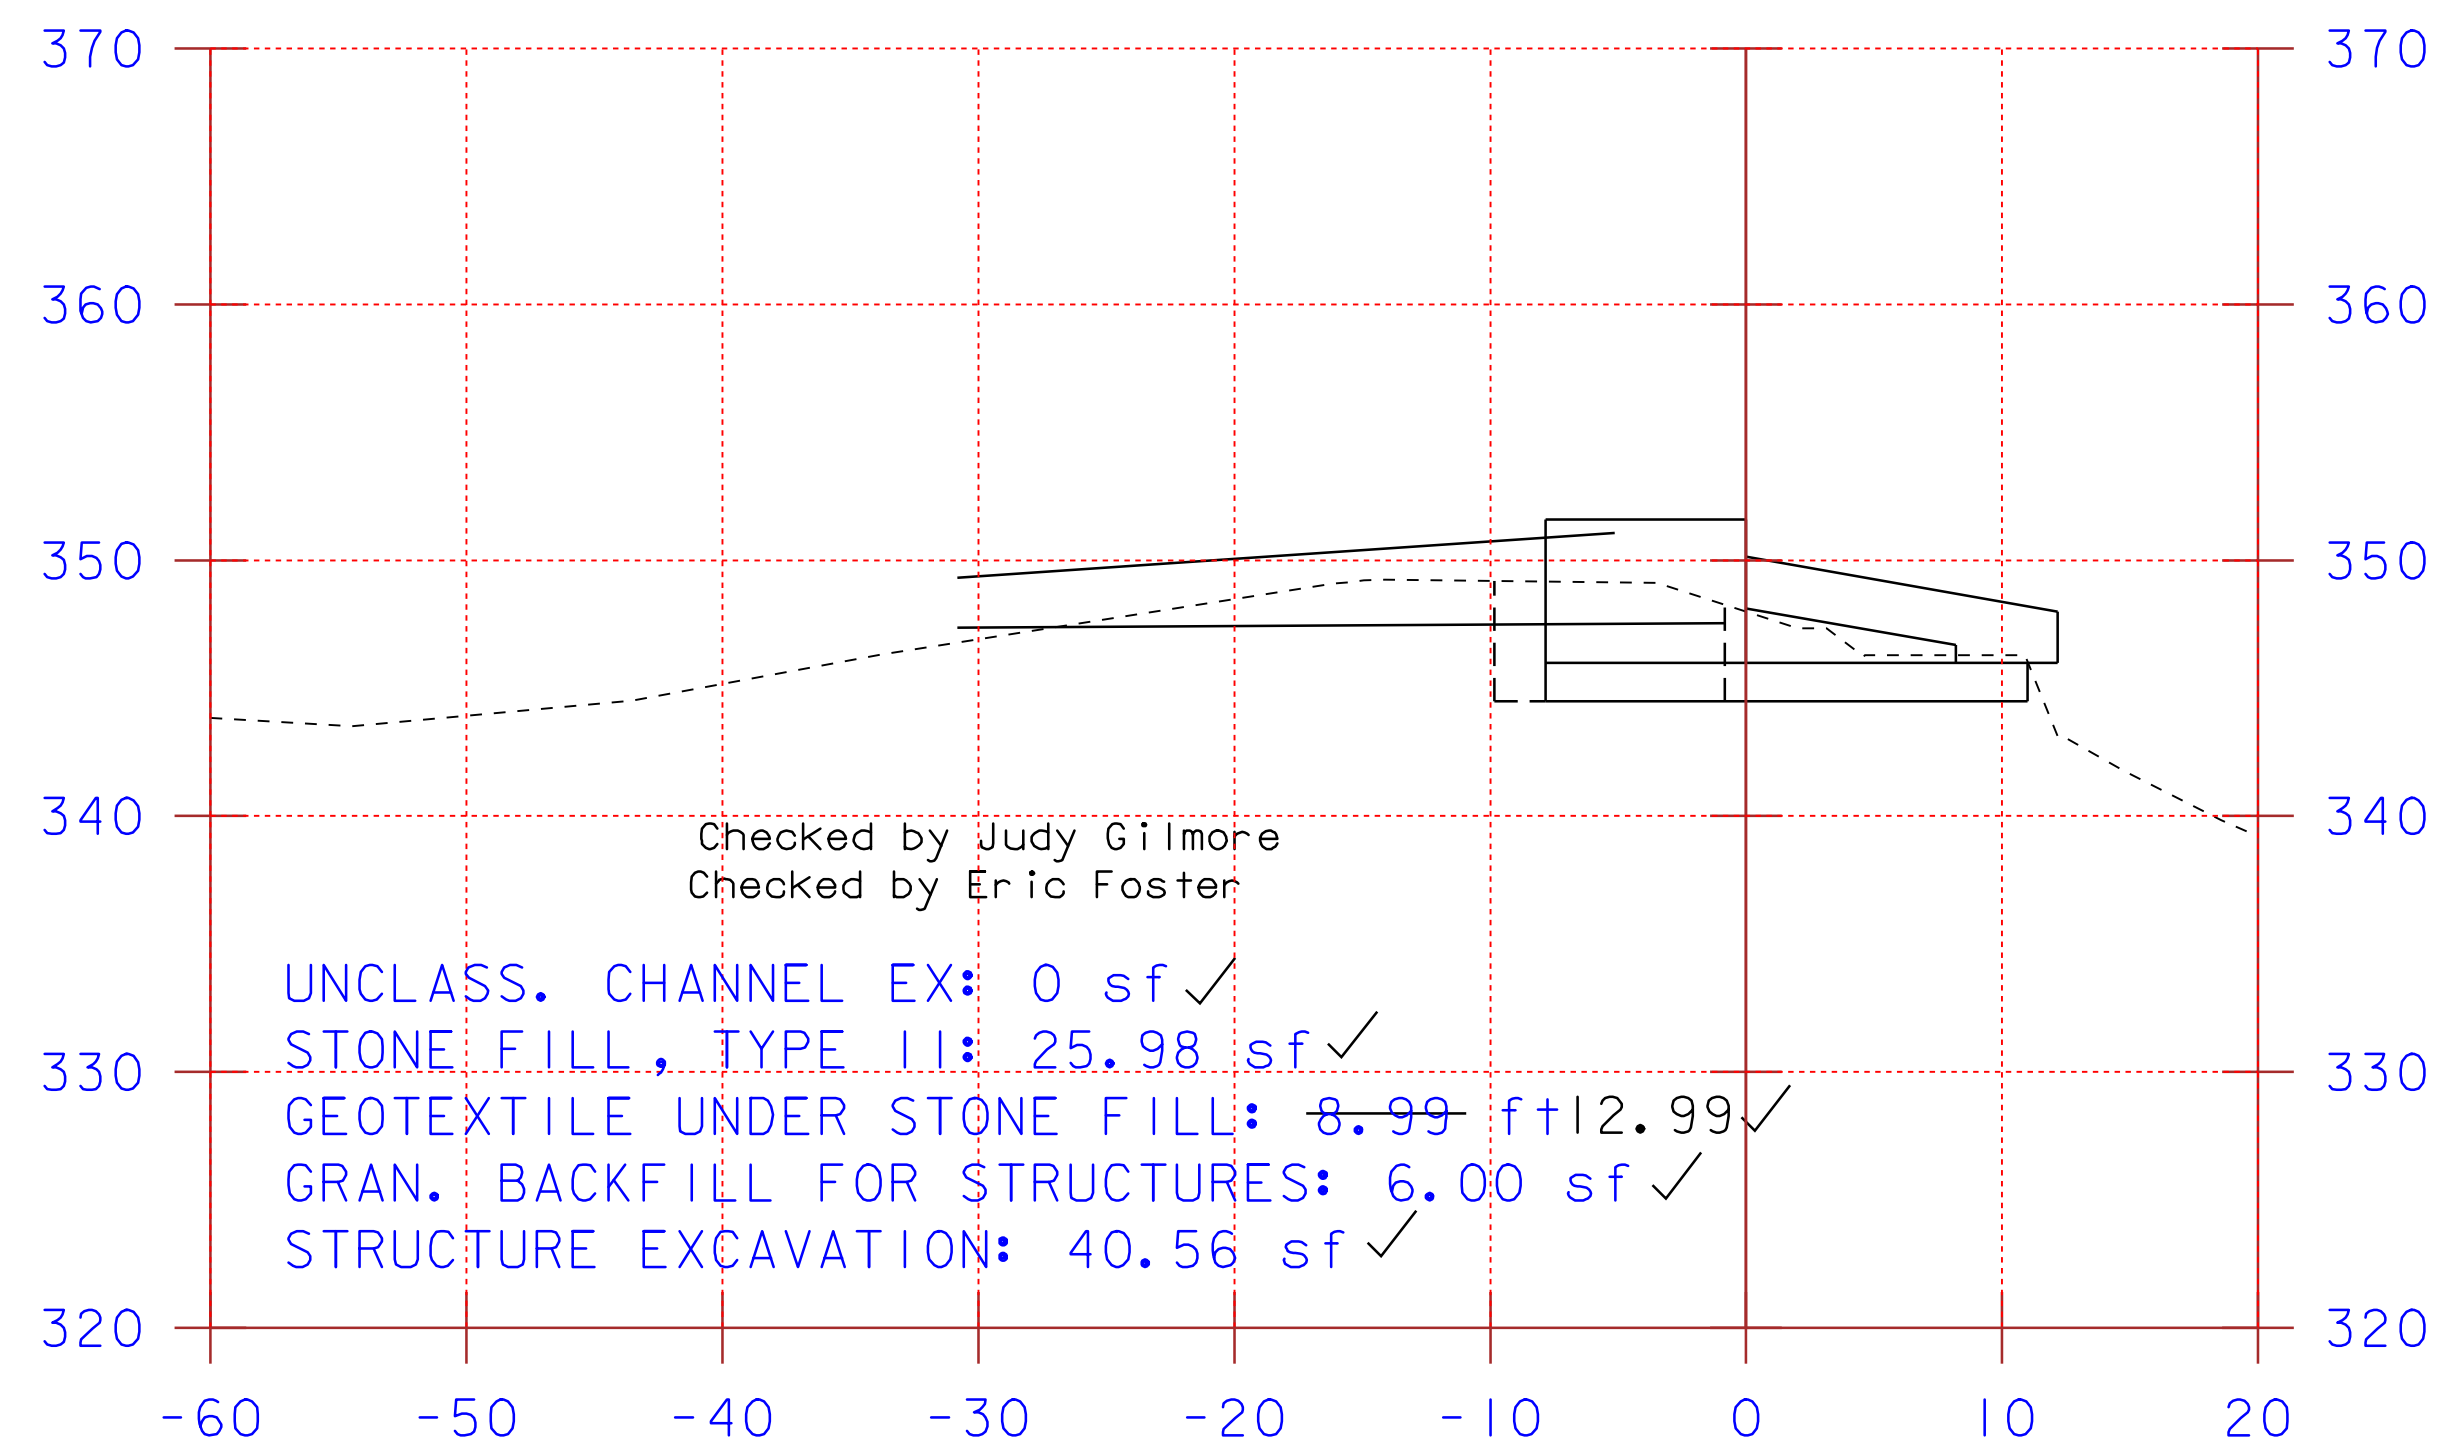

ABUTMENT #1
SCALE: 1"=10' 5+10.1 behind

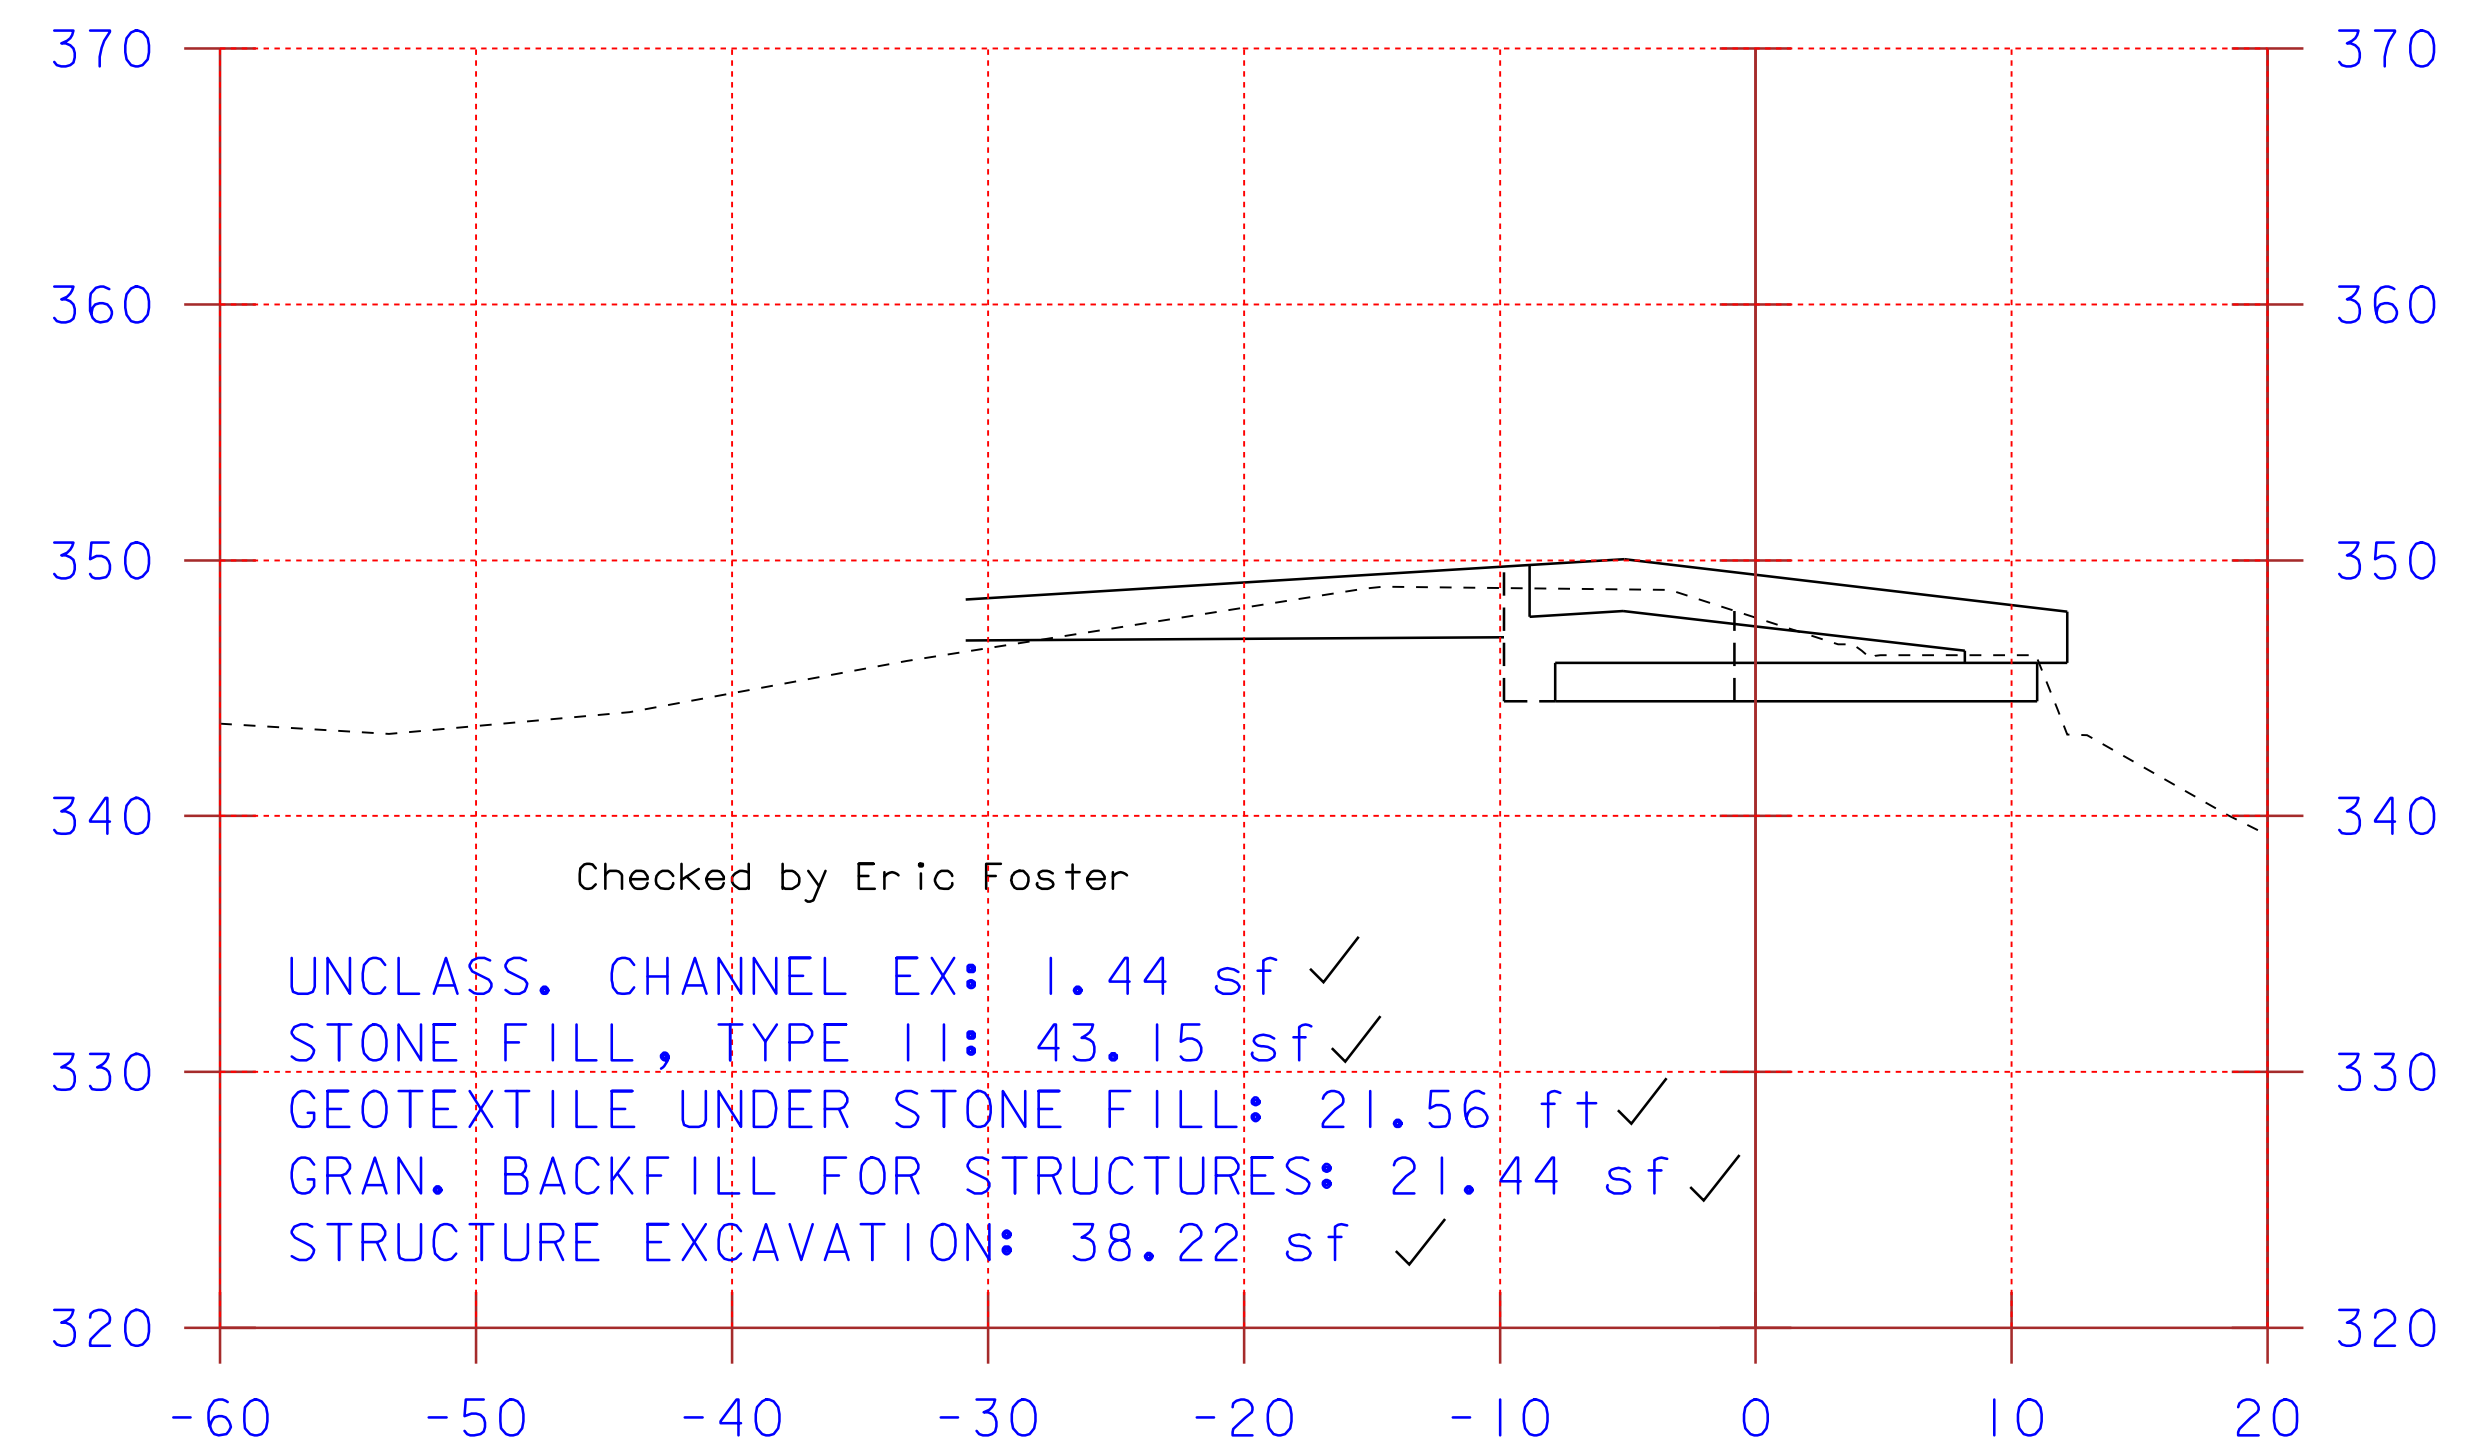

ABUTMENT #1
SCALE: 1"=10' 5+10.8 behind

PROJECT NAME: SALISBURY - CORNWALL	
PROJECT NUMBER: BHO 1445 (27)	
FILE NAME: 96J268\Structures\sj268m01.i	PLOT DATE: 19-OCT-2009 09:5
PROJECT MANAGER: R. R. WHITCOMB	DRAWN BY: G. ROY
DESIGNED BY: G. ROY	CHECKED BY: C. CARLSON
STA. 8+75 - STA. 9+50	SHEET 69 OF 60