


STATE OF VERMONT AGENCY OF TRANSPORTATION			
Town Of	WARREN	Bridge No.	7
Highway No.	TH 1	Log Sta.	
		Surv. Sta.	
BROOK ROAD OVER FREEMAN BROOK			
PLAN & ELEVATION			
Designed By	S. DELIA	Drawn By	S. MERKMAN
Checked By	R. JOY	Bridge Design Supervisor	R. ROONEY
Date	02/07	Date	02/07
PROJECT	WARREN	PROJECT NO.	BHF 0188(7)
I.G.C. Info. m:\549107-Warren\BRIDGE\Final\276pedgn			
Bridge Sheet No.		Sheet	17 of 36

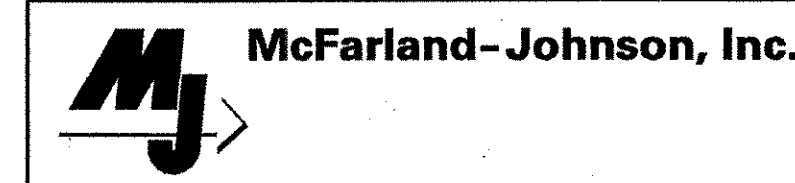

PLOTTED 02-MAR-2007