




100+50
MATCH EXISTING

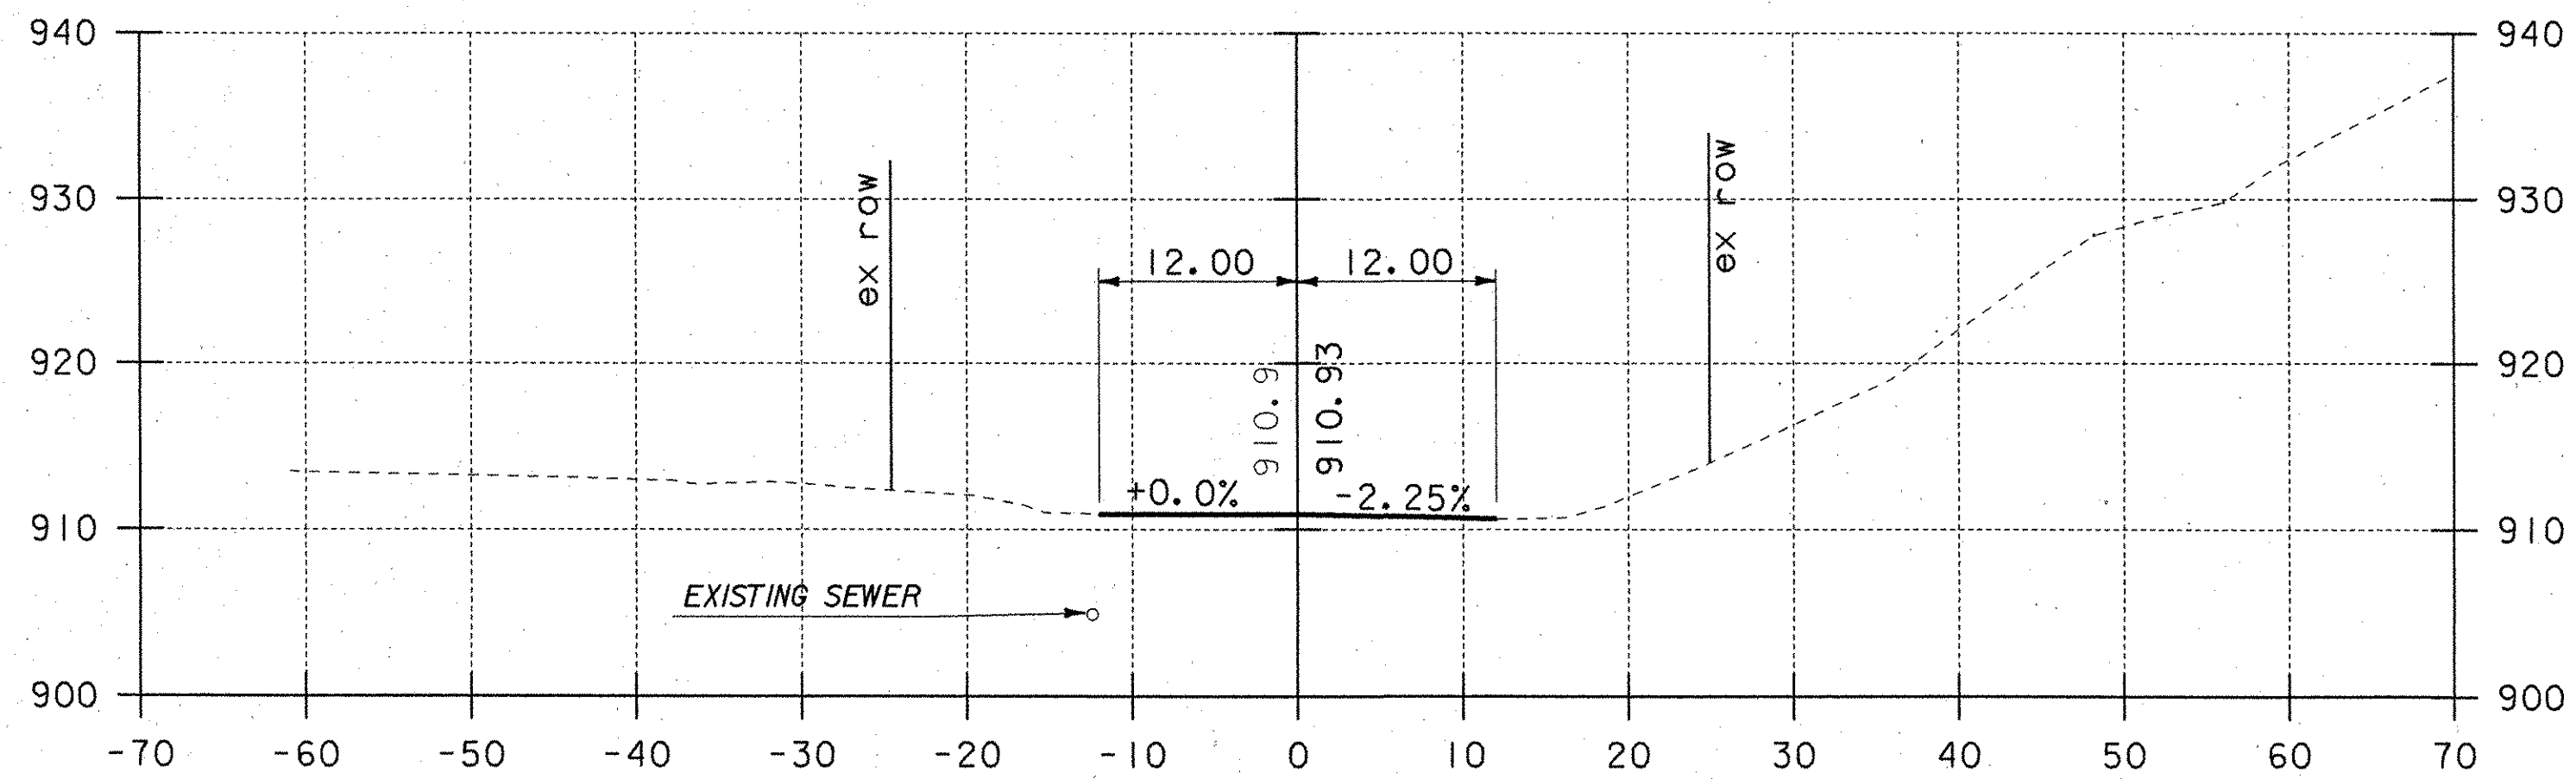


100+25

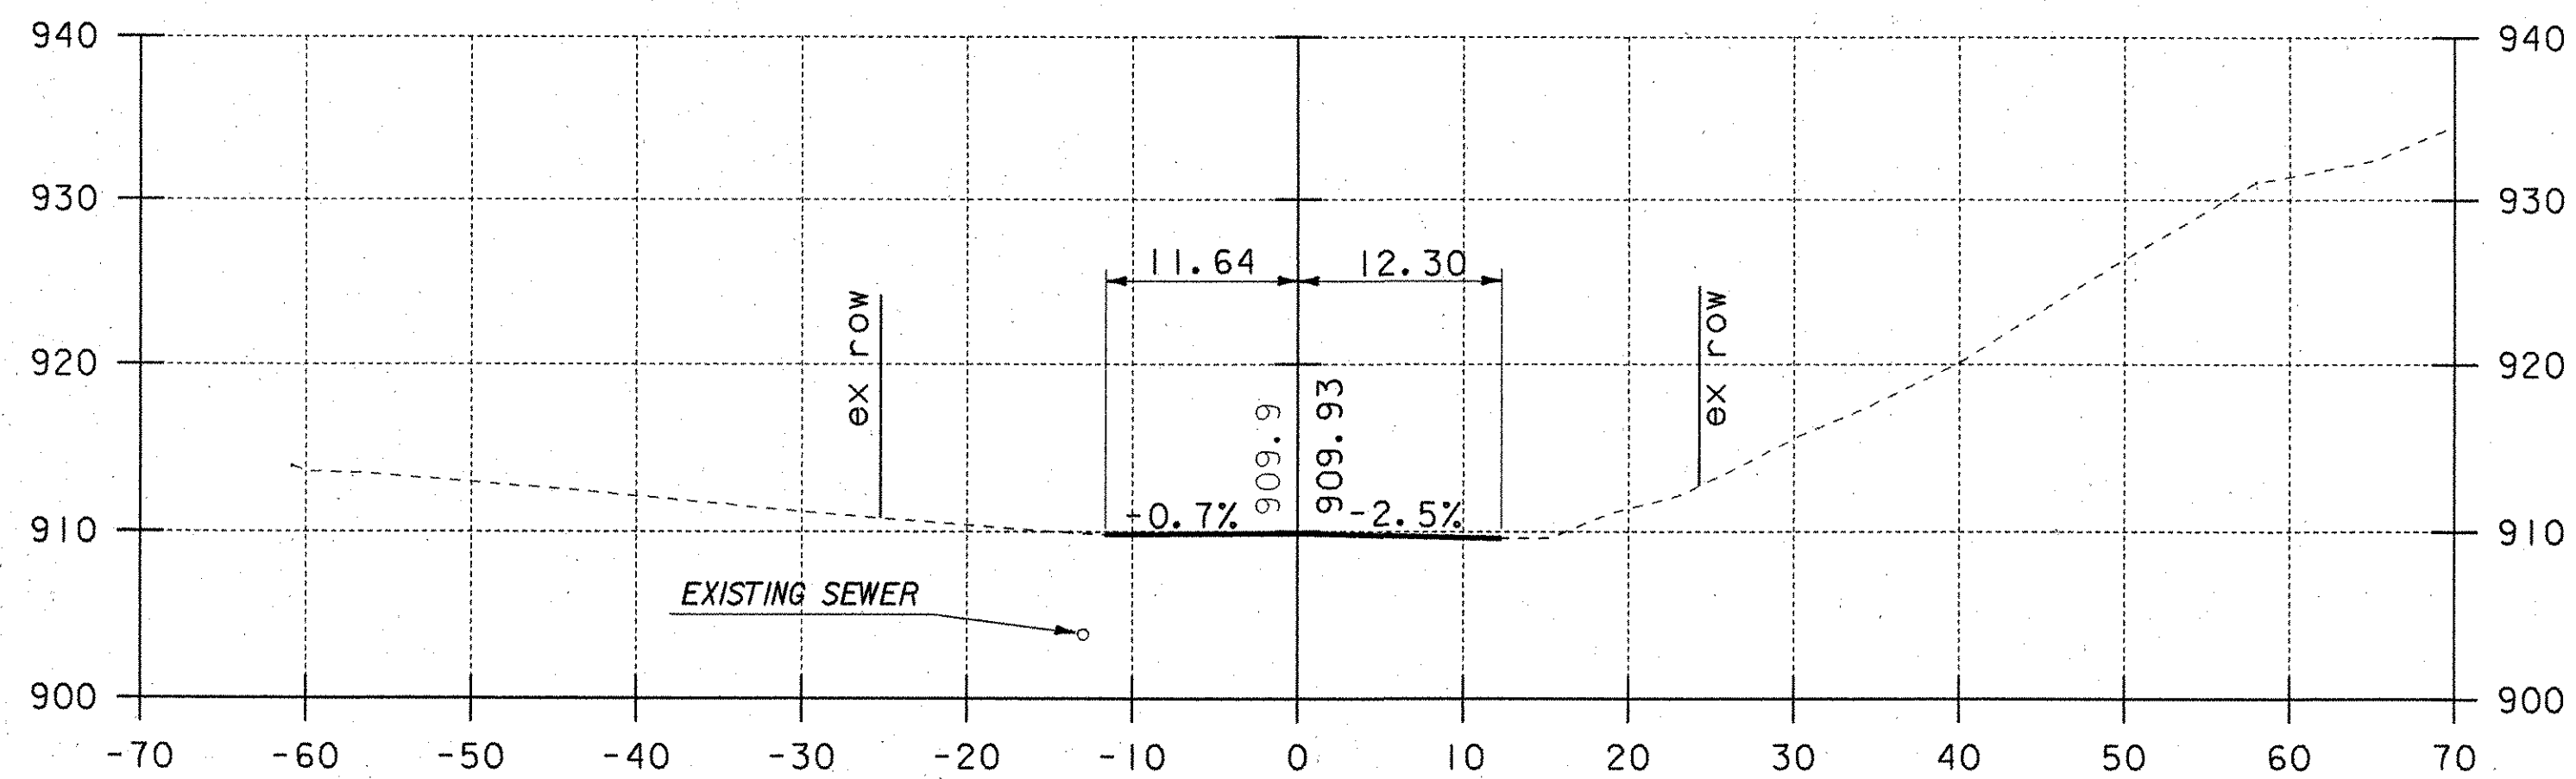


100+00
BEGIN APPROACH
MATCH EXISTING

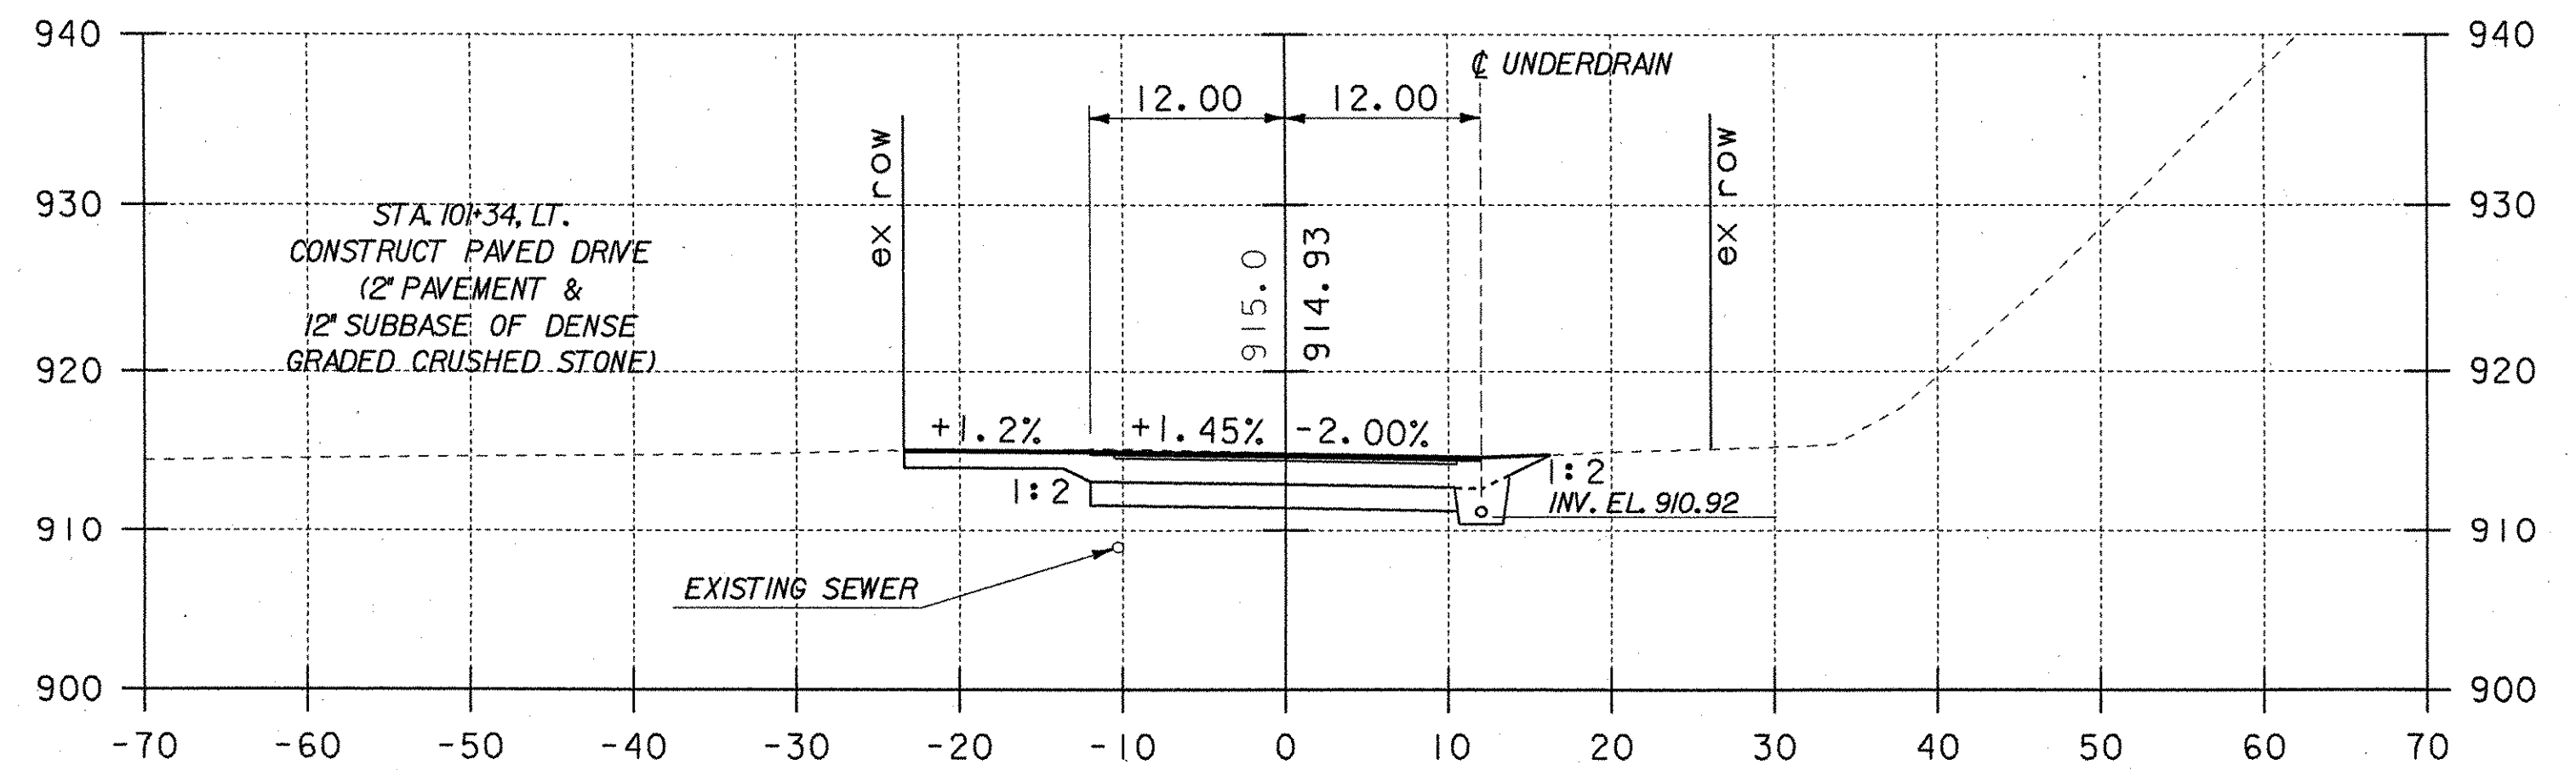

101+25
BEGIN PROJECT

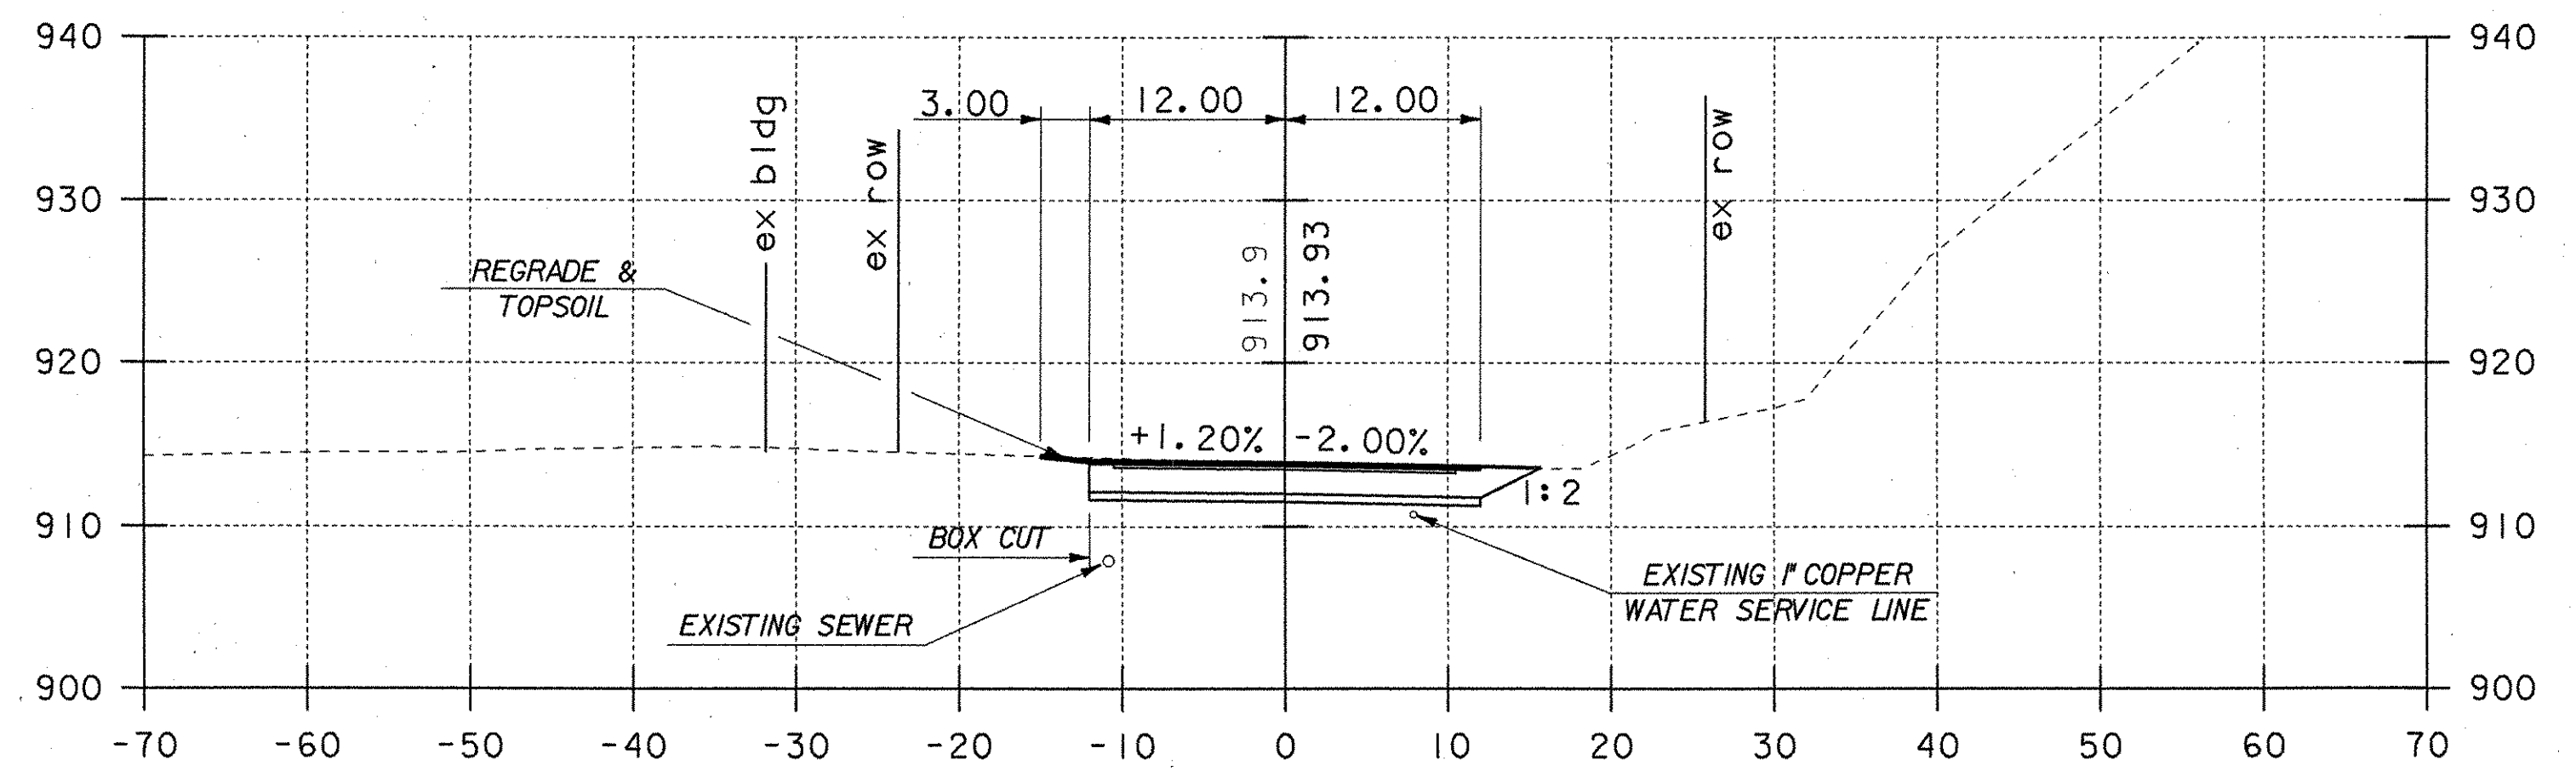


101+00

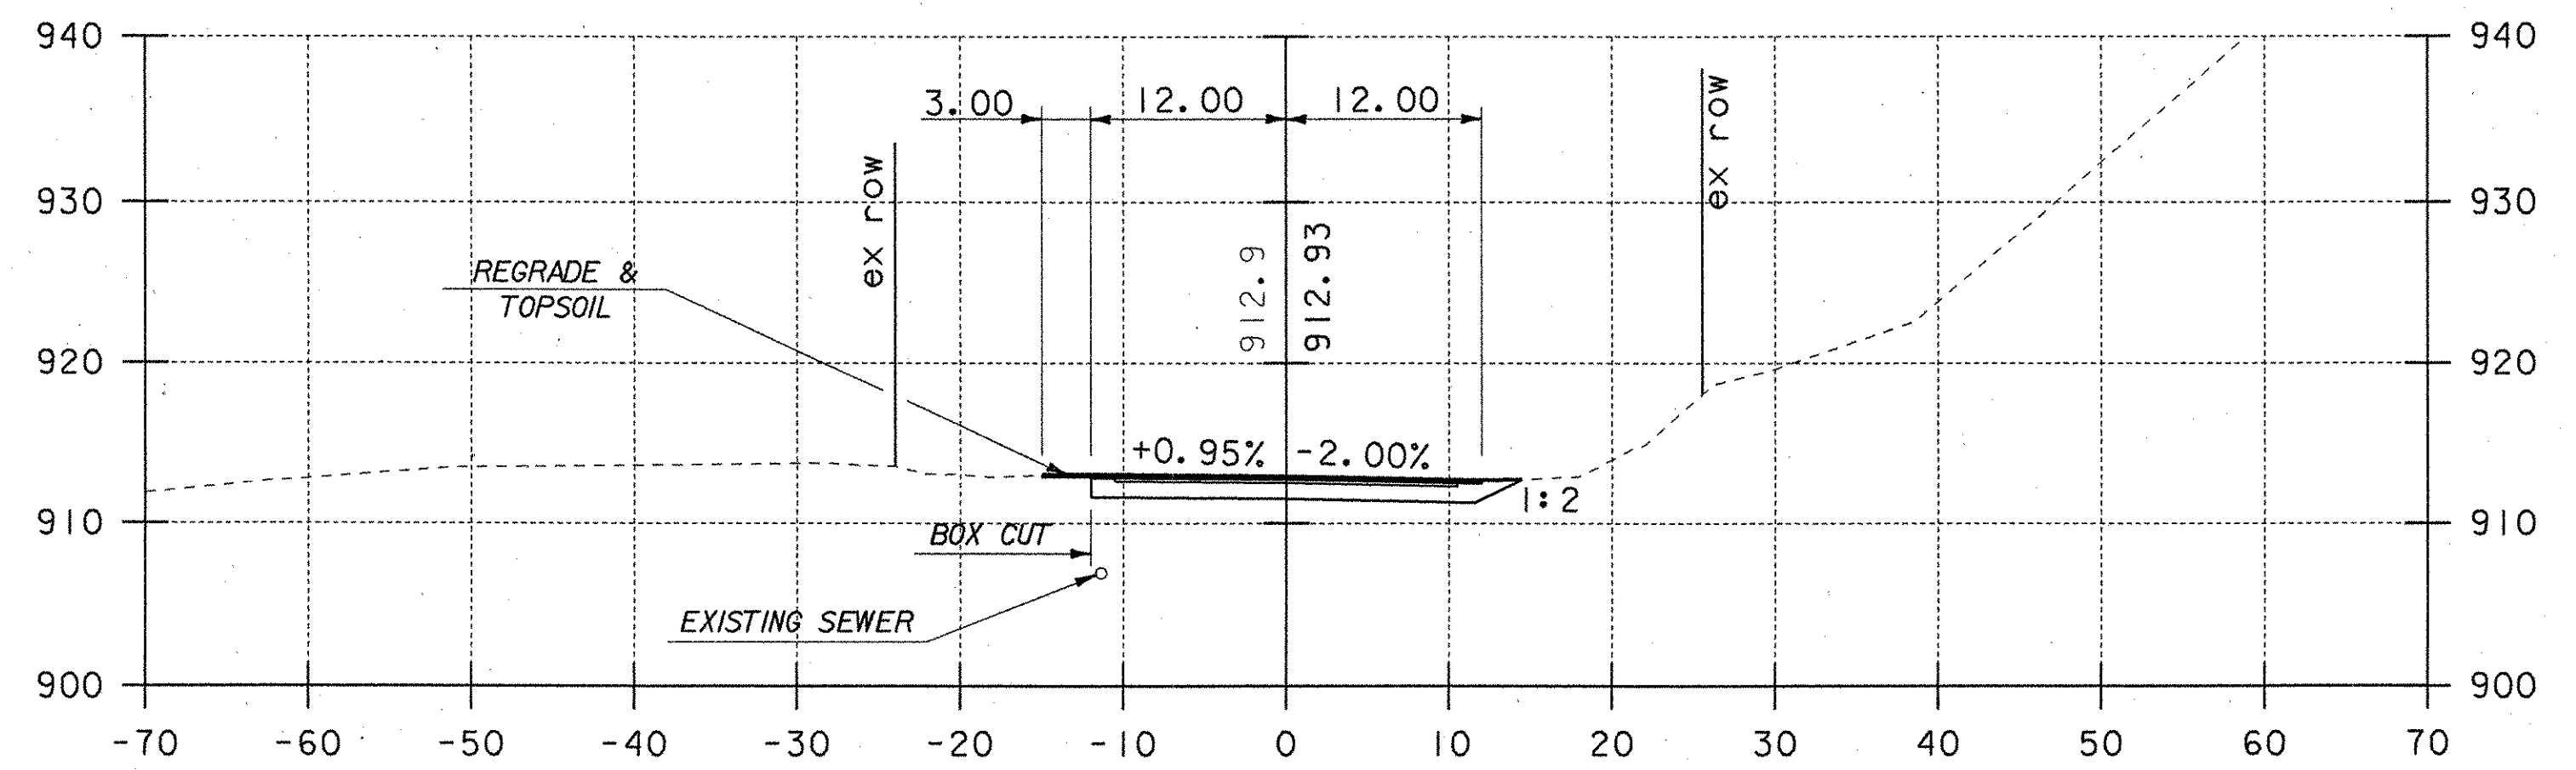

100+75

STATE OF VERMONT
AGENCY OF TRANSPORTATION

Town Of	WARREN	Bridge No.	7
Highway No.	TH 1	Log Sta.	
		Surv. Sta.	
BROOK ROAD OVER FREEMAN BROOK			
ROADWAY CROSS SECTIONS			
Designed By	L. WIXSON	Drawn By	P. DUSTIN
Checked By	R. JOY	Bridge Design Supervisor	R. ROONEY
	Date 02/07		Date 02/07
PROJECT	WARREN	PROJECT NO.	BHF 0188(7)
I.G.C. Info. m:\549\07-Warren\BRIDGE\Final\276xsl.dgn			
Bridge Sheet No.		Sheet	33 of 36

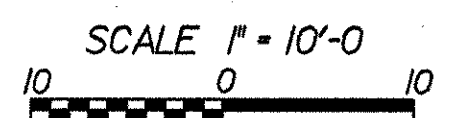

PLOTTED 19-FEB-2007