


NOTES
 1. FOR LIMITS OF STONE FILL SEE SHEET 5.



STATE OF VERMONT AGENCY OF TRANSPORTATION			
Town Of	WARREN	Bridge No.	7
Highway No.	TH 1	Log Sta.	
		Surv. Sta.	
BROOK ROAD OVER FREEMAN BROOK			
CHANNEL CROSS SECTIONS			
Designed By	L. WIXSON	Drawn By	S. MERKMAN
Checked By		Date	
R. JOY		02/07	R. ROONEY
Date			02/07
PROJECT	WARREN	PROJECT NO.	BHF 0188(7)
I.G.C. Info. m:\549107\Warren\BRIDGE\Final\z\276.xsdg			
Bridge Sheet No.		Sheet	36 of 36

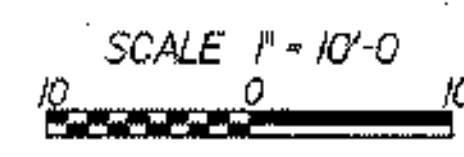

PLOTTED
 CE-APR-2007