




15 ~ x1a  
INT CONN PL - LOW END

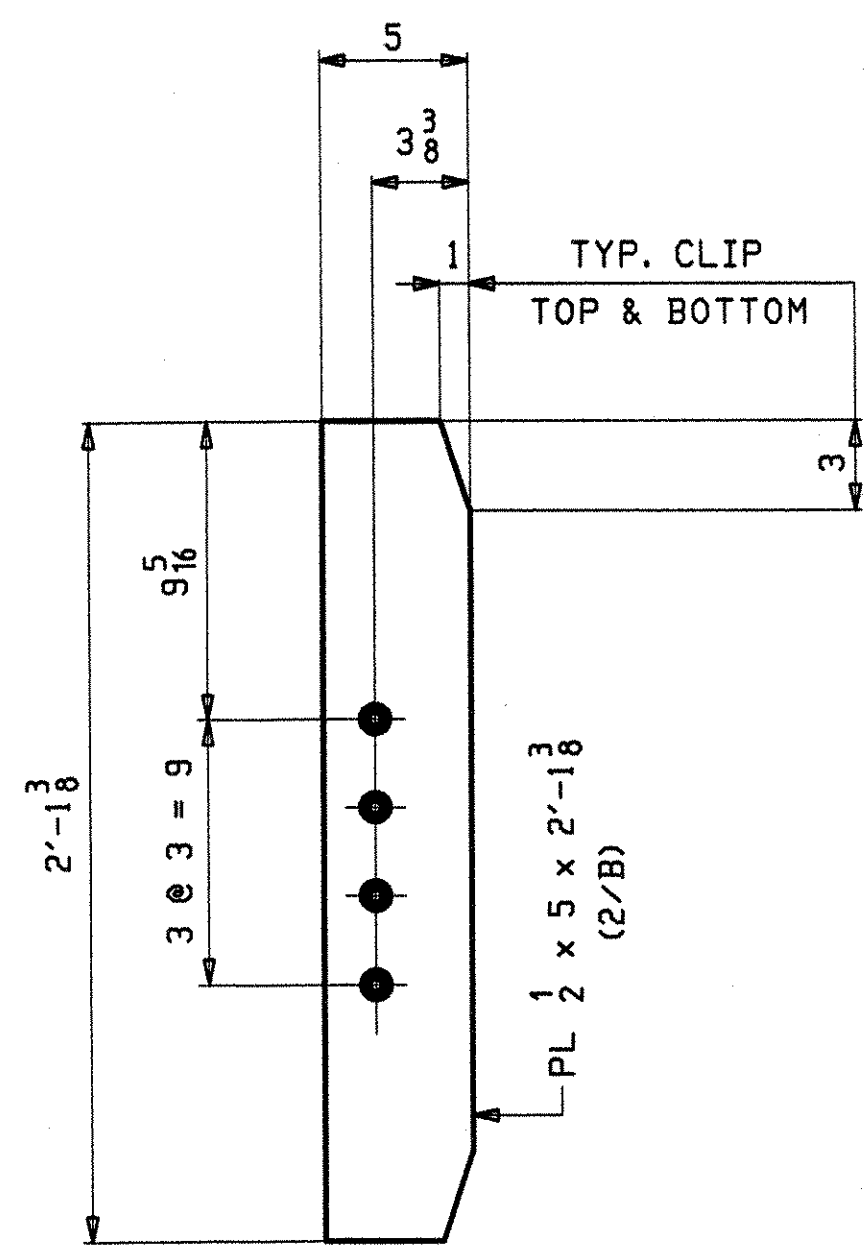


9 ~ x1b  
INT CONN PL - HIGH END

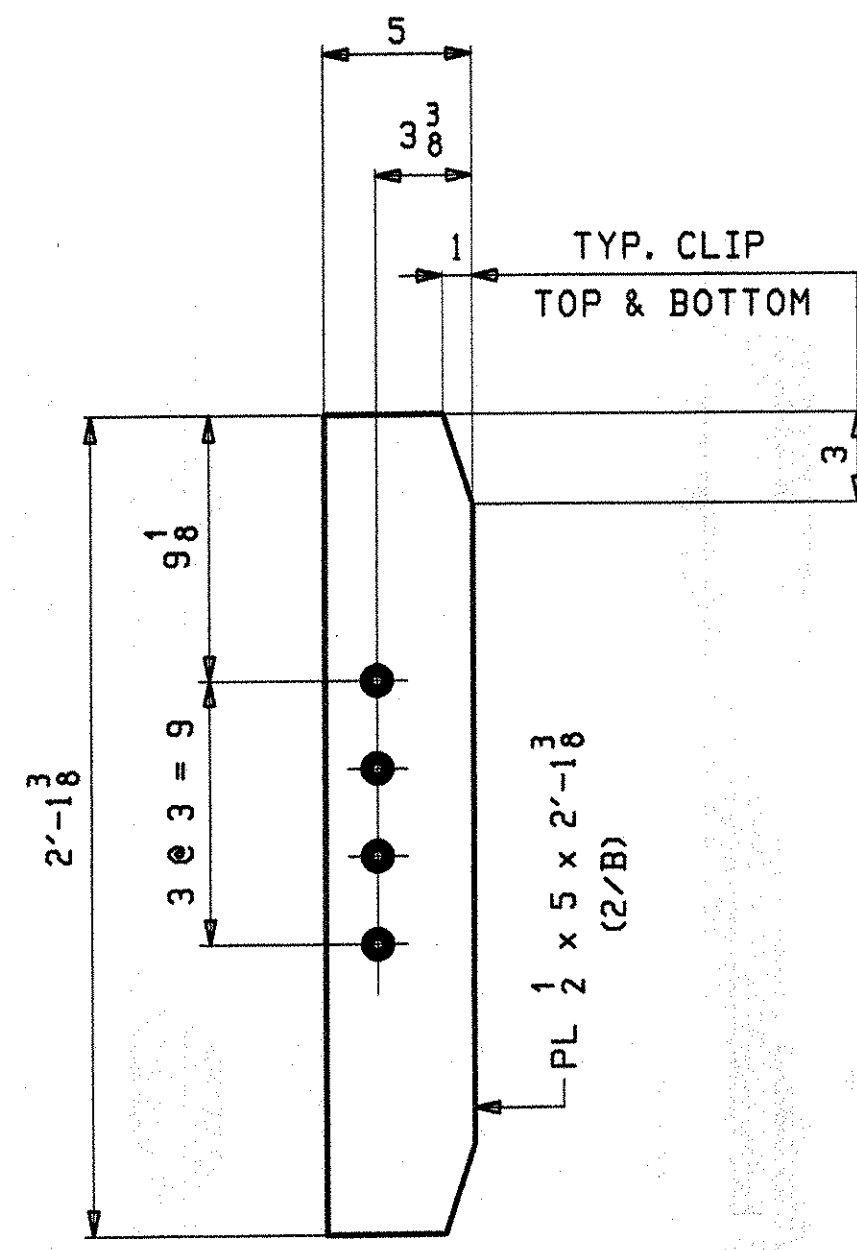


6 ~ x1c  
INT CONN PL - HIGH END

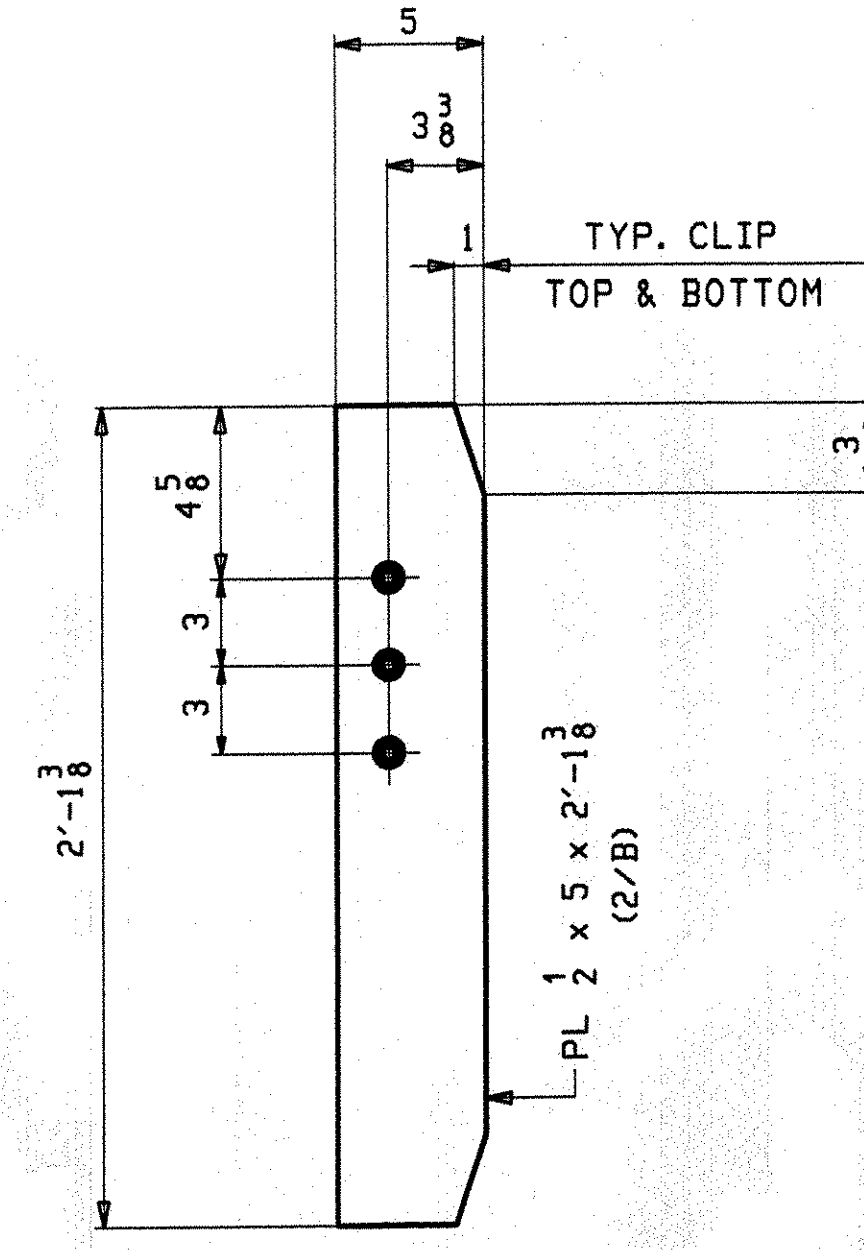


6 ~ x1d  
UTILITY CONN PL - LOW END

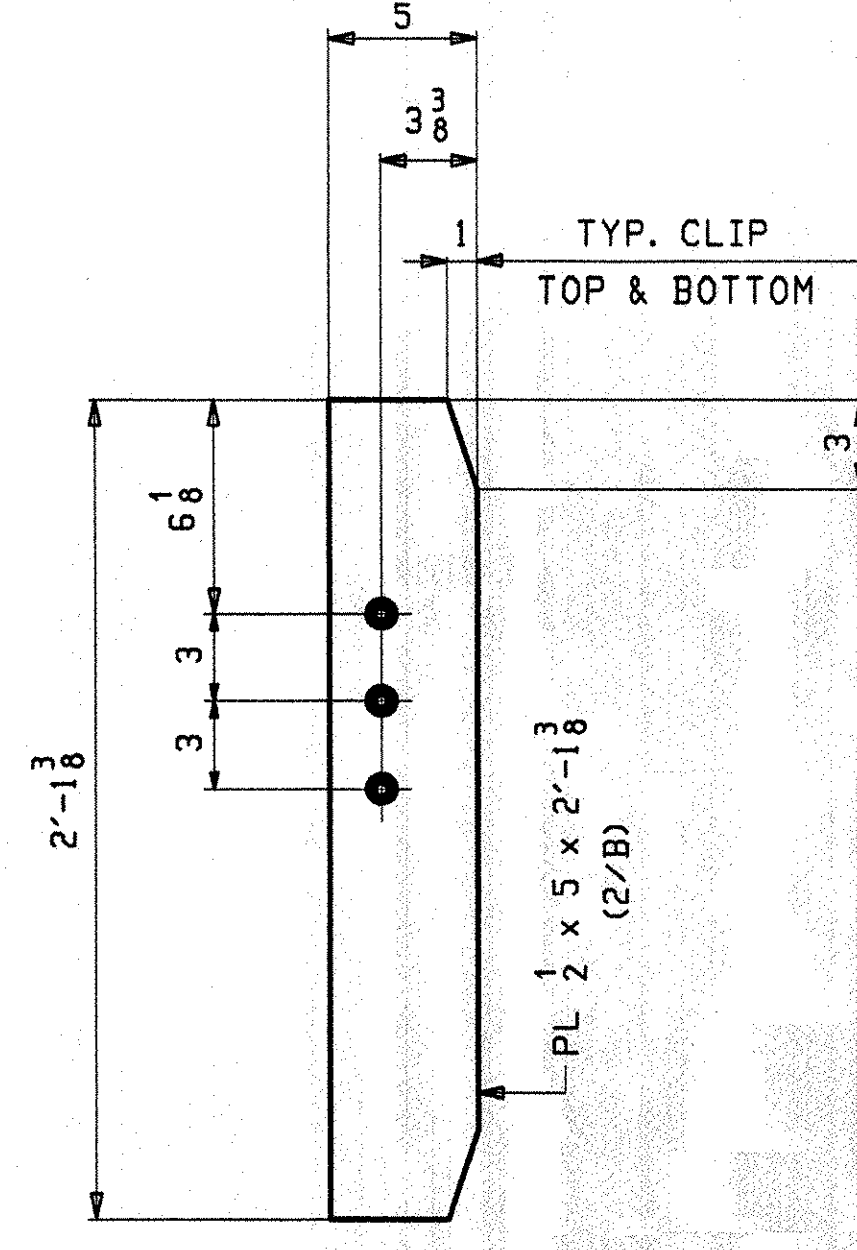


3 ~ x1f  
UTILITY CONN PL - HIGH END

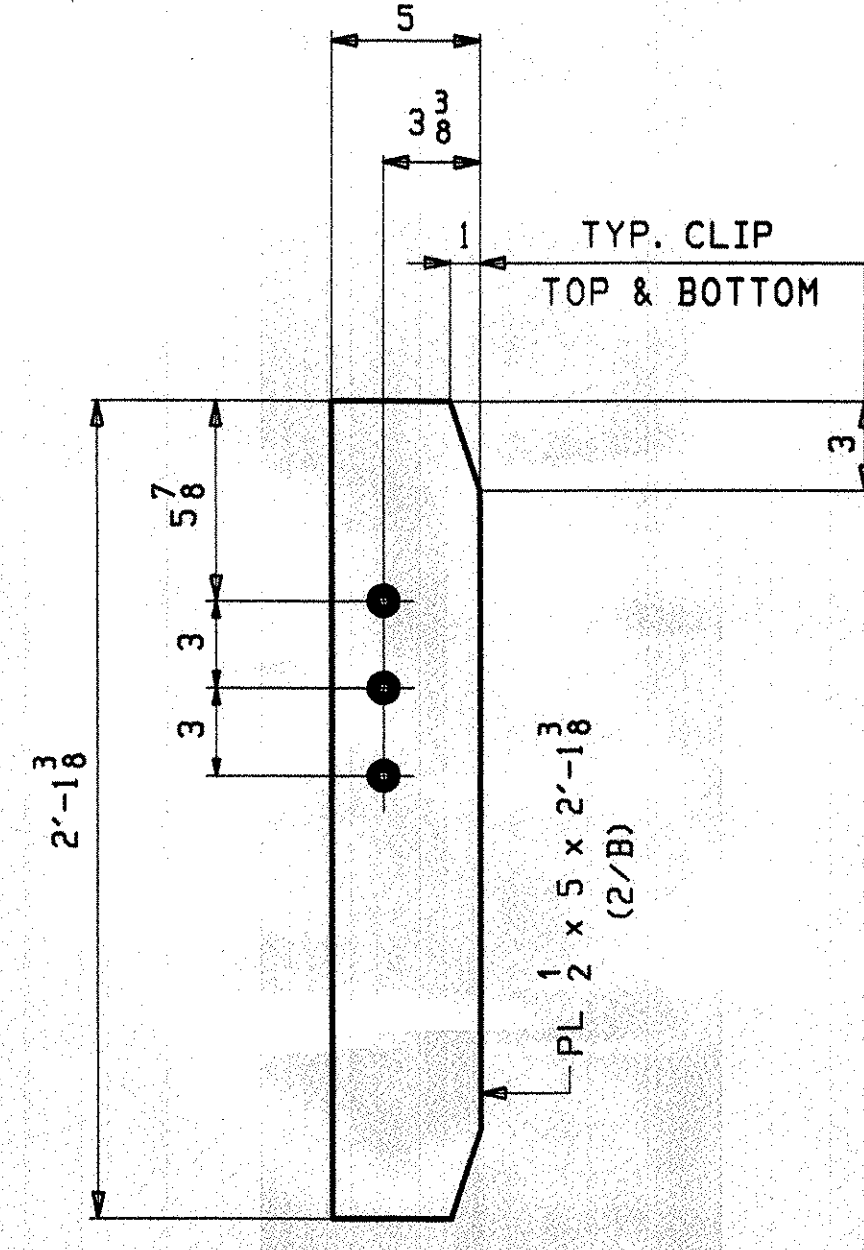

3 ~ x1g  
UTILITY CONN PL - HIGH END

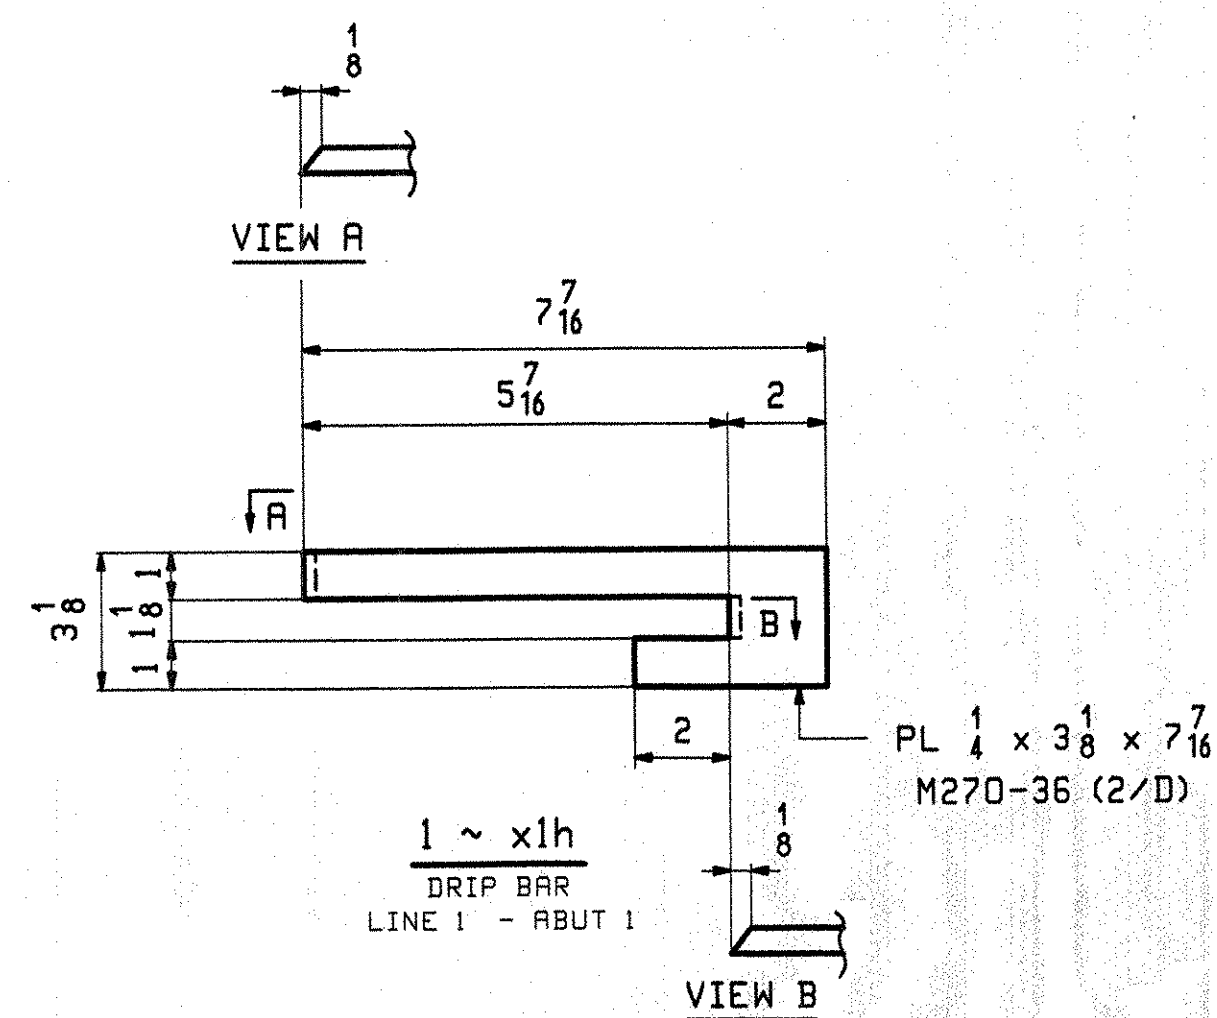

1 ~ x1h  
DRIP BAR  
LINE 1 - ABUT 1

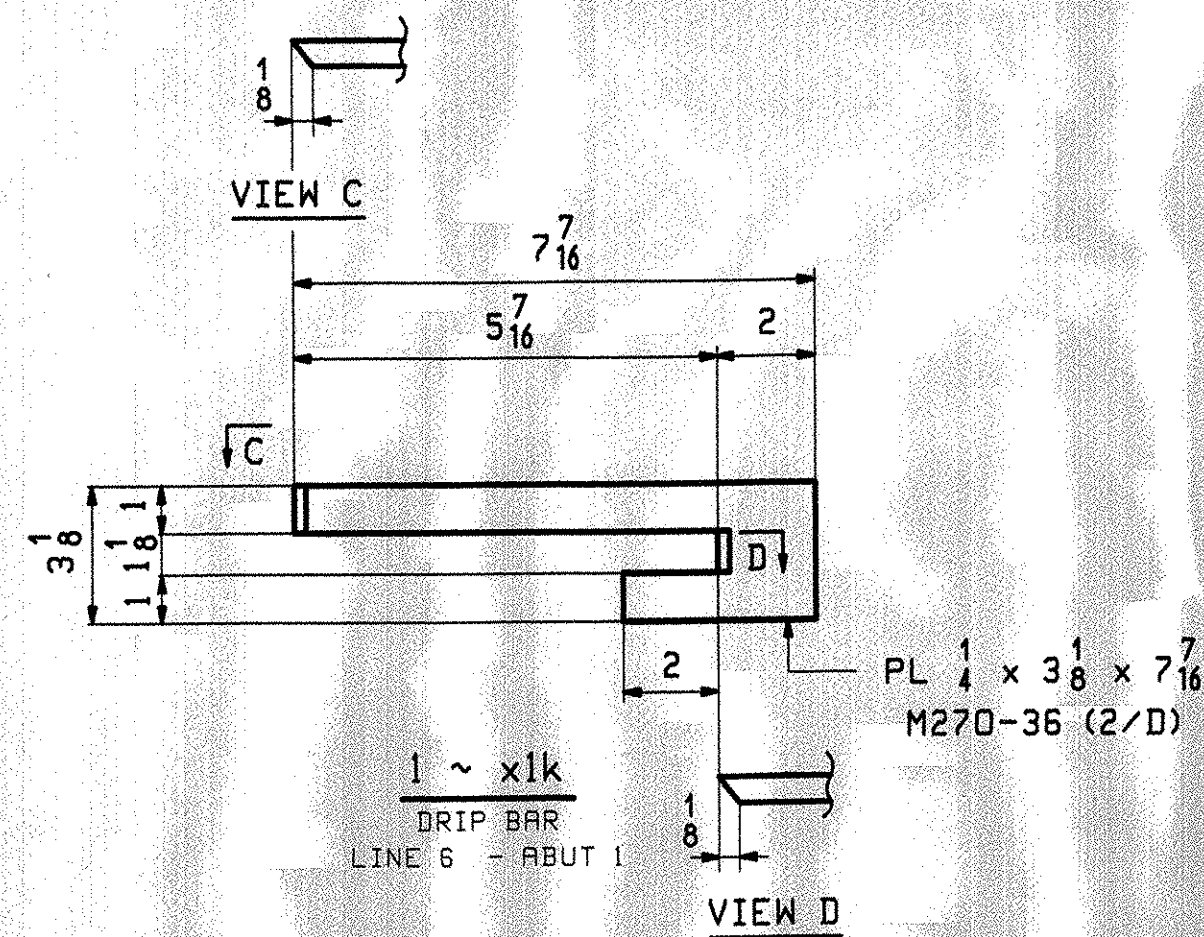

1 ~ x1k  
DRIP BAR  
LINE 6 - ABUT 1

Reviewed  
 Rejected  
 Furnish as Corrected  
 Revise and Resubmit  
 Submit Specified Item

This review is only for general conformance with the design concept and the information given in the Construction Documents. Corrections or comments made on the shop drawings during this review do not relieve the contractor from compliance with the requirements of the plans and specifications. Review of a specific item shall not include review of an assembly of which the item is a component. The Contractor is responsible for dimensions to be confirmed and corrected on the job. Responsibility for general safety to the fabrication process or to the materials, methods, techniques, sequence and procedure of construction, coordination of the Work with that of all other trades and performing all Work in a safe and satisfactory manner.

McFarland-Johnson, Inc.

Date: 7-11-07  
By: Steven F. Debra

NOTES:

1. ALL MATERIAL SHALL BE M270-50 U.N.
2. ALL BOLT HOLES SHALL BE 15/16" Ø FOR 7/8" Ø HSB.
3. FOR GENERAL NOTES SEE SHEET GNI.

RECEIVED  
CHK'D BY: \_\_\_\_\_ OK'D BY: \_\_\_\_\_  
JUL 16 2007  
RESUBMIT \_\_\_\_\_ APPROVED \_\_\_\_\_  
BY: \_\_\_\_\_ DATE: \_\_\_\_\_

OUT FOR APPROVAL	7-1-07								
OUT FOR APPROVAL									
ISSUED TO SHOP									
FIELD & OFFICE									

REV.	REMARKS	DATE	DNW	CHK	APP	Q.A.	NO.	DIA.	LGT	TYPE	WASHER
	MATERIAL: M270-50 U.N.							15/16"			NONE

SURFACE PREP. & PAINT:  
SEE SHT. GNI

DESCRIPTION:	GIRDER STANDARDS	DRAWN BY	EEO	DATE	06/08/07
JOB:	BROOK ROAD OVER FREEMAN BROOK	CHKD BY	ELC	DATE	06/11/07
	BIRDGE NO. 7	APPROV BY			
	WARREN, VT. (COUNTY OF WASHINGTON)	SUPERVISOR	M. J. GATTI		
PROJ NO.	BHF 0188(?)	Q.A.			

CUSTOMER:	BLOW & COTE	JOB NO.	324	DRG. NO.	X1
	CASCO BAY STEEL STRUCTURES, INC.				
	75 SPRING HILL ROAD				
	PHONE (207) 282-7360	SACO, MAINE 04072			
		FAX. (207) 282-1179	05/55	REV.	△