


ABM INFO		SHIP				BILL OF MATERIAL		JOB NO.		DRAWING NO.		REV.
PAGE	LINE	MARK	QTY	MARK	MATERIAL	LENGTH FT	INCHES	REMARKS	WT	PROCUREMENT NOTES		
		1S1A	1		STRINGER						8255	
1	A		1	ua	W 27x129	63	1 3/4	(M270-50T2) (H2-3)				
2	B		3	xif	PL 1/2 x 5	2	1 3/8					
2	B		3	xig	PL 1/2 x 5	2	1 3/8					
2	D		1	xih	PL 1/4 x 3/8	0	7 7/16	(M270-35)				
		1S2A	1		STRINGER						8328	
1	A		1	ua	W 27x129	63	1 3/4	(M270-50T2) (H2-3)				
2	B		3	xib	PL 1/2 x 5	2	1 3/8					
2	B		1	xic	PL 1/2 x 5	2	1 3/8					
2	B		6	xid	PL 1/2 x 5	2	1 3/8					

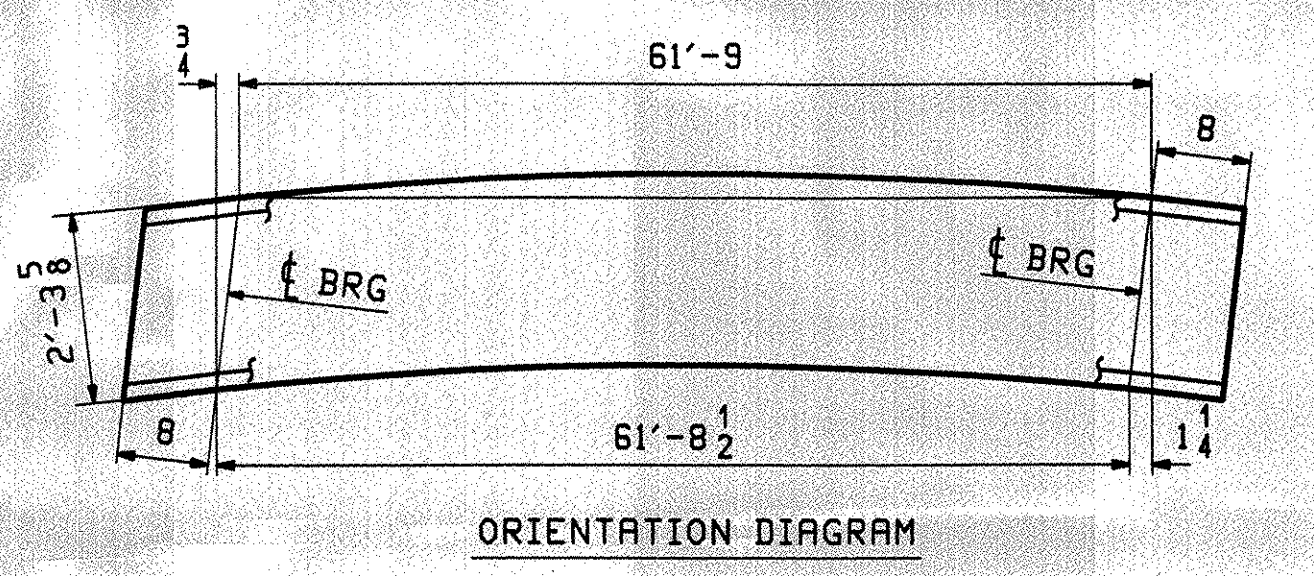

NOTES:

- FOR GENERAL NOTES SEE DRG. GNI.
- FOR STANDARD DETAILS SEE DRG. XI.
- FOR CAMBER DIAGRAM SEE DRG. CI.
- H2-3 DENOTES MATERIAL SUBJECT TO CHARPY V-NOTCH TESTING.
- FOR WELD TERMINATION SEE DETAIL WS1 ON GNI.

RECEIVED
 JUL 16 2007

OUT FOR APPROVAL	7-2-07											
OUT FOR APPROVAL												
ISSUED TO SHOP												
FIELD & OFFICE												

REV.	REMARKS	DATE	DWN	CHK	APP	O.A.	NO.	DIA.	LGT	TYPE	WASHER
MATERIAL:	ELECTRODES:	HOLES:	SHOP BOLTS:								
M270 50 U.N.		1/8 U.N.	NONE								

SURFACE PREP. & PAINT:
SEE GNI

DESCRIPTION:	STRINGERS - 1S1A & 1S2A	DRAWN BY	DATE
JOB:	BROOK ROAD OVER FREEMAN BROOK	EEO	06/11/07
	BIRDGE NO. 7	CHKD BY	
	WARREN, VT. (COUNTY OF WASHINGTON)	ELC	06/11/07
		APPROV BY	
		SUPERVISOR	W. J. GATTI
PROJ NO.	BHF 0188(7)	O.A.	
CUSTOMER:	BLOM & COTE		
CASCO BAY STEEL STRUCTURES, INC.		JOB NO.	DRG. NO.
75 SPRING HILL ROAD	SACO, MAINE 04072	324	1
PHONE (207) 282-7350	FAX (207) 282-1179	05255	REV. Δ

Reviewed **Rejected**
 Furnish as Corrected
 Revise and Resubmit
 Submit Specified Item

This review is only for general conformance with the design concept and the information given in the Construction Documents. Contractor or commercial users of the shop drawings during this review do not relieve the contractor from compliance with the requirements of the plans and specifications. Review of a specific item shall not include review of an assembly of which the item is a component. The Contractor is responsible for dimensions to be confirmed and corrected as the job progresses. It is the Contractor's responsibility to coordinate the work with that of all other trades and performing all work in a safe and satisfactory manner.

McFarland-Johnson, Inc.
 Date: 7-11-07
 By: Steven F. Della

ELC Mod. Jan. 13, 2007 03:08:51 PM /user/ghh/2721/1 Rev0