



PLAN
SCALE 1" = 10'-0"

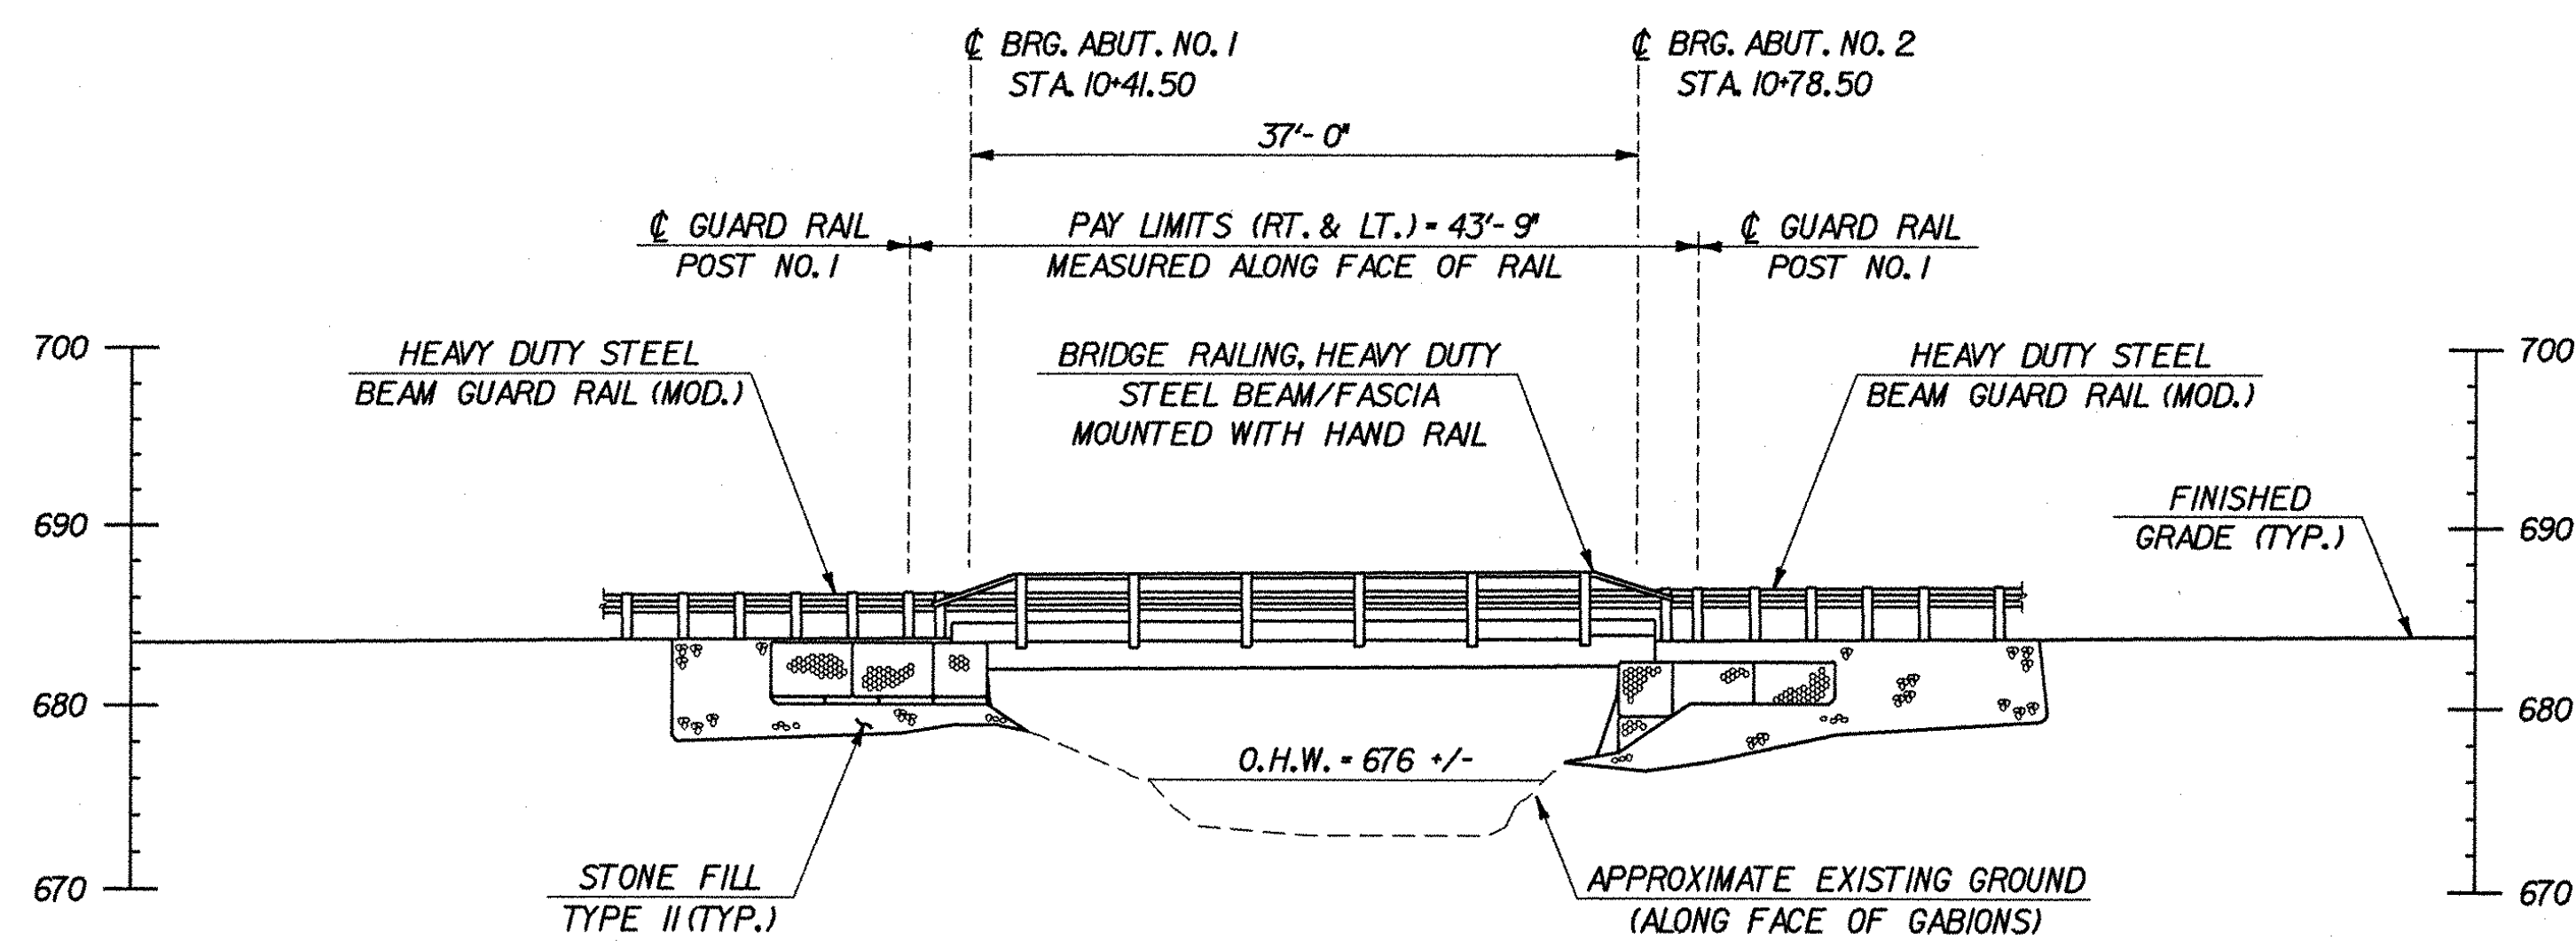

ELEVATION
SCALE 1" = 10'-0"

STATE OF VERMONT AGENCY OF TRANSPORTATION	
Town Of WATERBURY	Bridge No. 14
Highway No. 6	Log Sta. Surv. Sta.
LOOMIS HILL ROAD OVER THATCHER BROOK	
PLAN AND ELEVATION	
Designed By L.WIXSON	Drawn By P.DUSTIN
Checked By R.JOY	Date 03/03
M.ZYDEL	Date 03/03
PROJECT WATERBURY	PROJECT NO. TH 3-9637
I.G.C. Info. m:\549108-Waterbury\BRIDGE\6cont\1\278gpe.dgn	
Bridge Sheet No.	Sheet 8 of 18

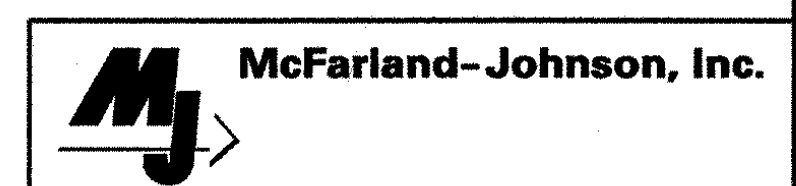

PLOTTED 05-MAY-2003