



PLAN

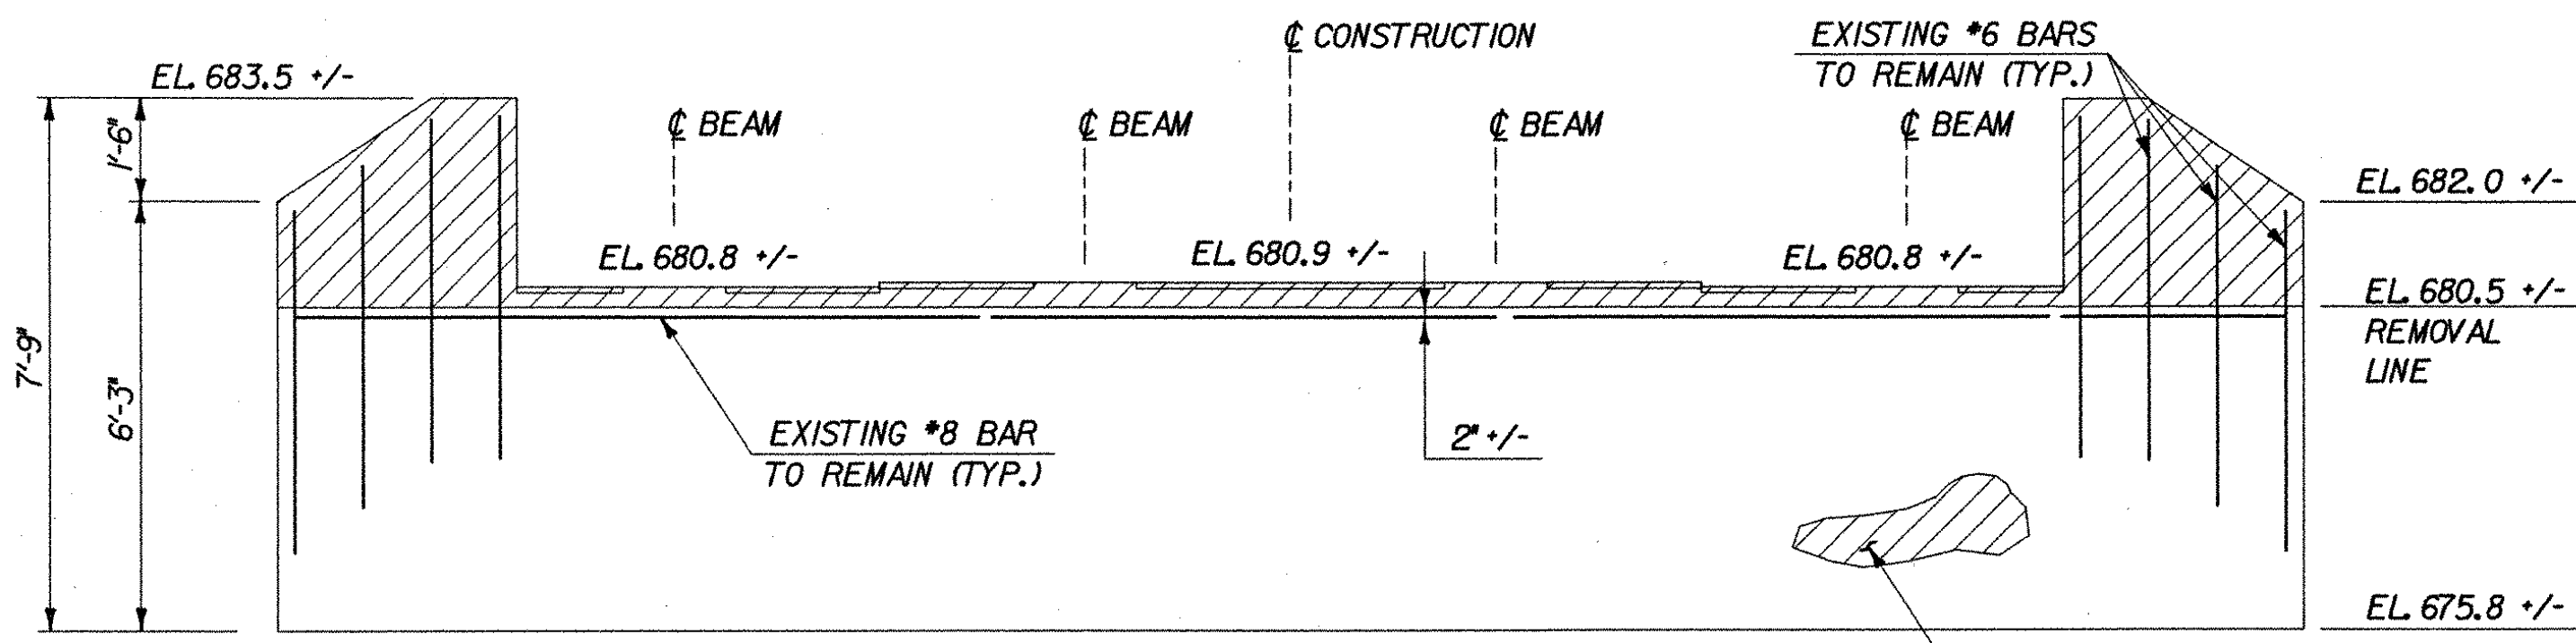

ELEVATION

ABUTMENT REMOVAL

SCALE: 3/8" = 1'-0"

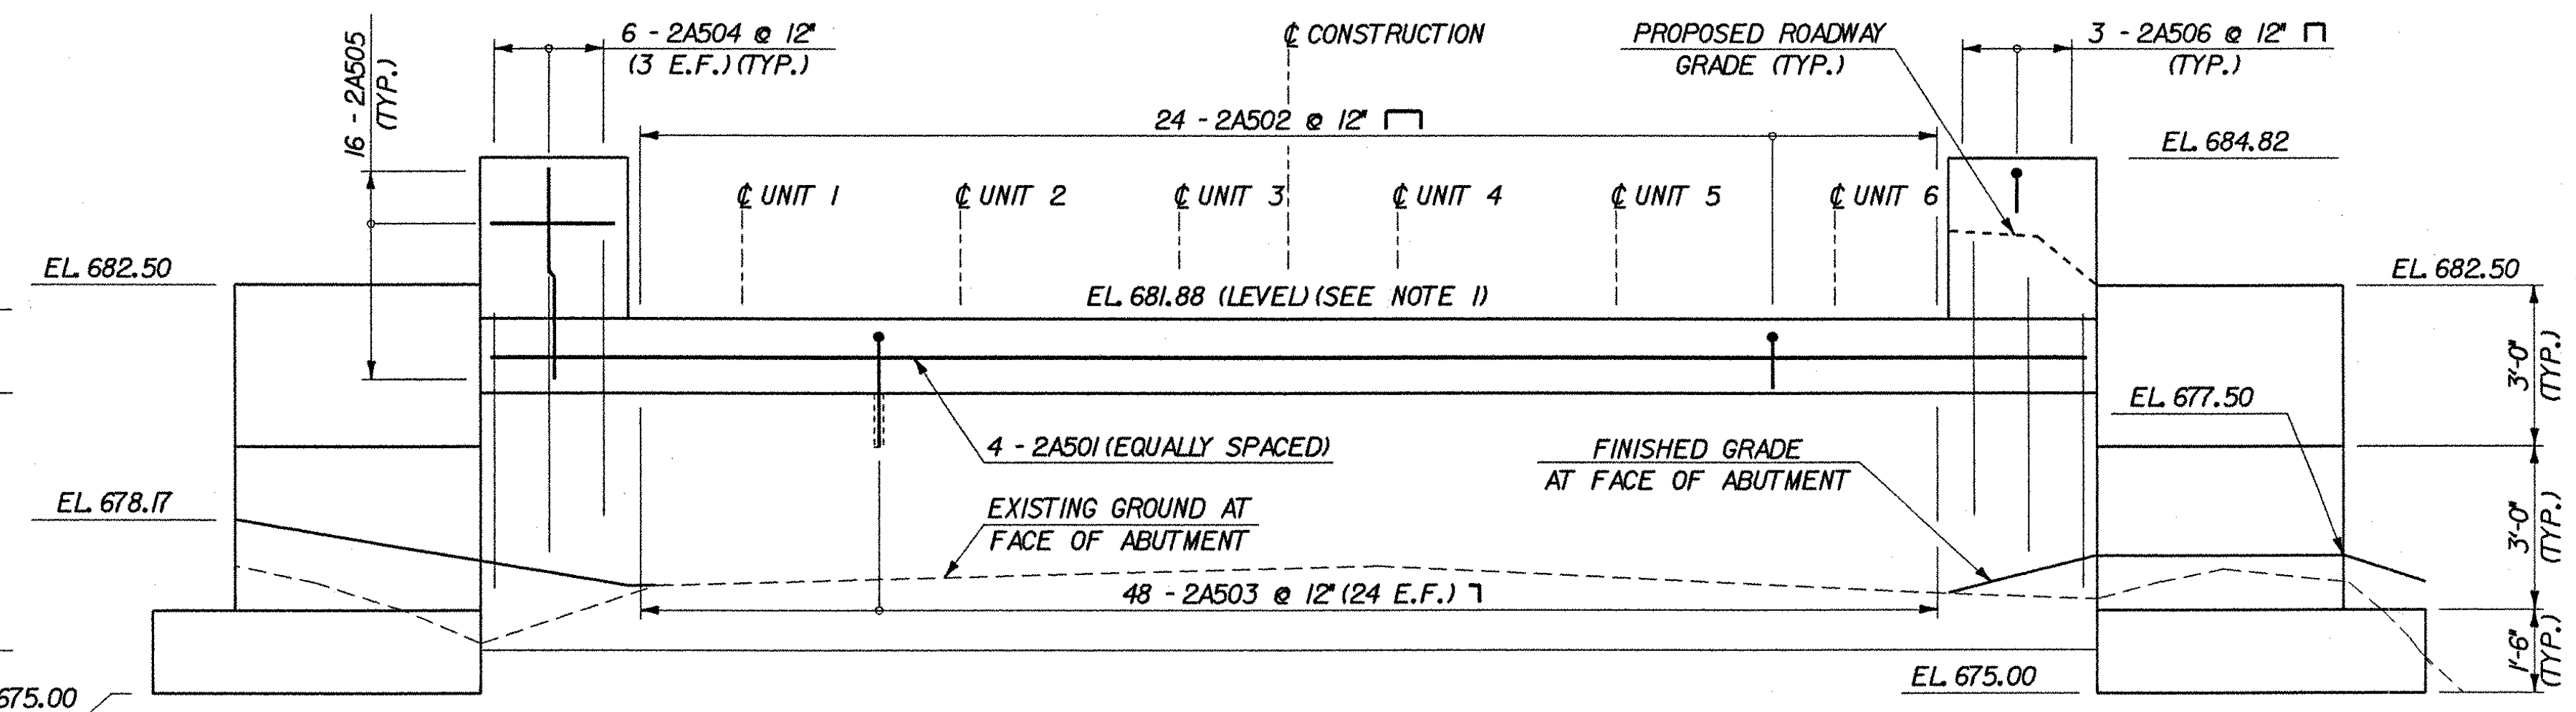

ELEVATION

ABUTMENT MODIFICATIONS

SCALE: 3/8" = 1'-0"

WORKING POINTS		
LOCATION	NORTHING	EASTING
W.P. 4	83729.2087	85939.2352
W.P. 5	83715.7368	85933.1278
W.P. 6	83702.2649	85927.0204

NOTES

1. BEAM SEAT ELEVATION HAS BEEN ADJUSTED FOR MAXIMUM CAMBER AT MIDSPAN. FINAL BEAM SEAT ELEVATION TO BE CONFIRMED.
2. FOR SECTIONS C-C AND D-D, SEE SHEET 14.
3. E.F. DESIGNATES EACH FACE.
4. ONE-INCH THICK PREFORMED JOINT FILLER SHALL BE PLACED BETWEEN VOIDED SLABS AND CONCRETE WINGWALLS. COST SHALL BE SUBSIDIARY TO ITEM 501.34.

**STATE OF VERMONT  
AGENCY OF TRANSPORTATION**

Town Of **WATERBURY** Bridge No. **14**

Highway No. **6** Log Sta.

**LOOMIS HILL ROAD OVER THATCHER BROOK**

**ABUTMENT NO. 2**

Designed By **L. WIXSON** Drawn By **P. DUSTIN**

Checked By **R. JOY** Date **03/03** Bridge Design Supervisor **M. ZYDEL** Date **03/03**

PROJECT **WATERBURY** PROJECT NO. **TH 3-9637**

I.G.C. Info. **m:\549108-Waterbury\BRIDGE\6cont\1\278ad2.dgn**

Bridge Sheet No.  Sheet **13** of **18**



PLOTTED 05-MAY-2003