




11+75

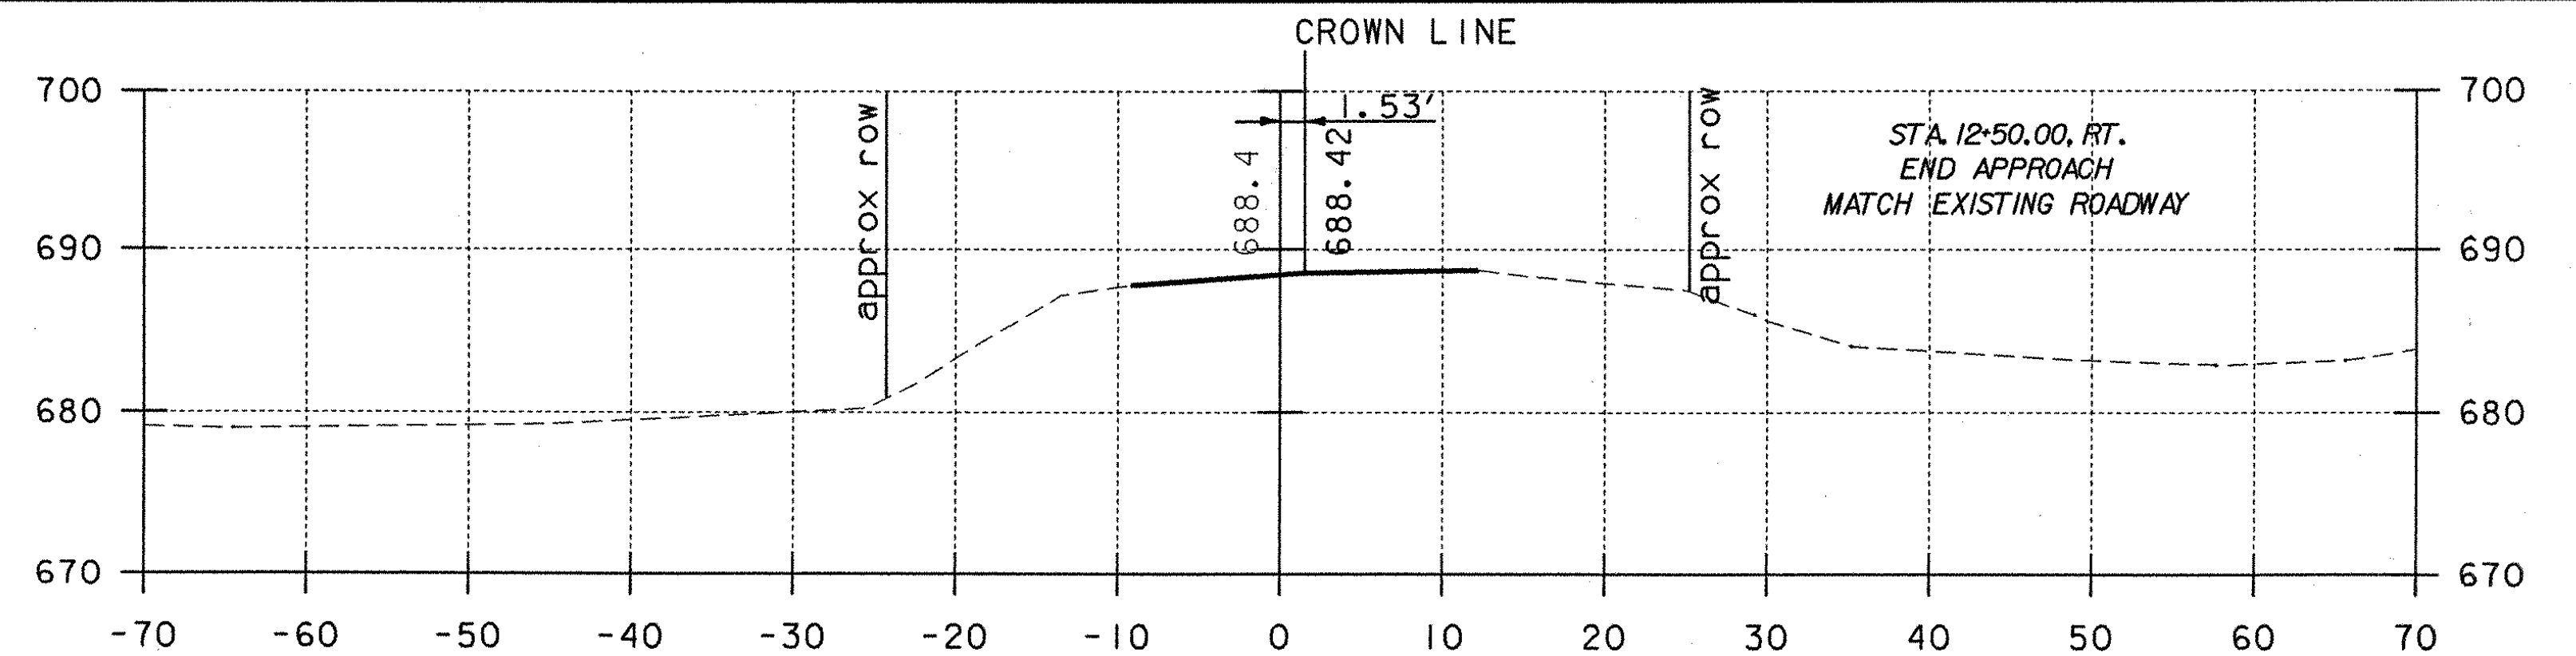


12+50

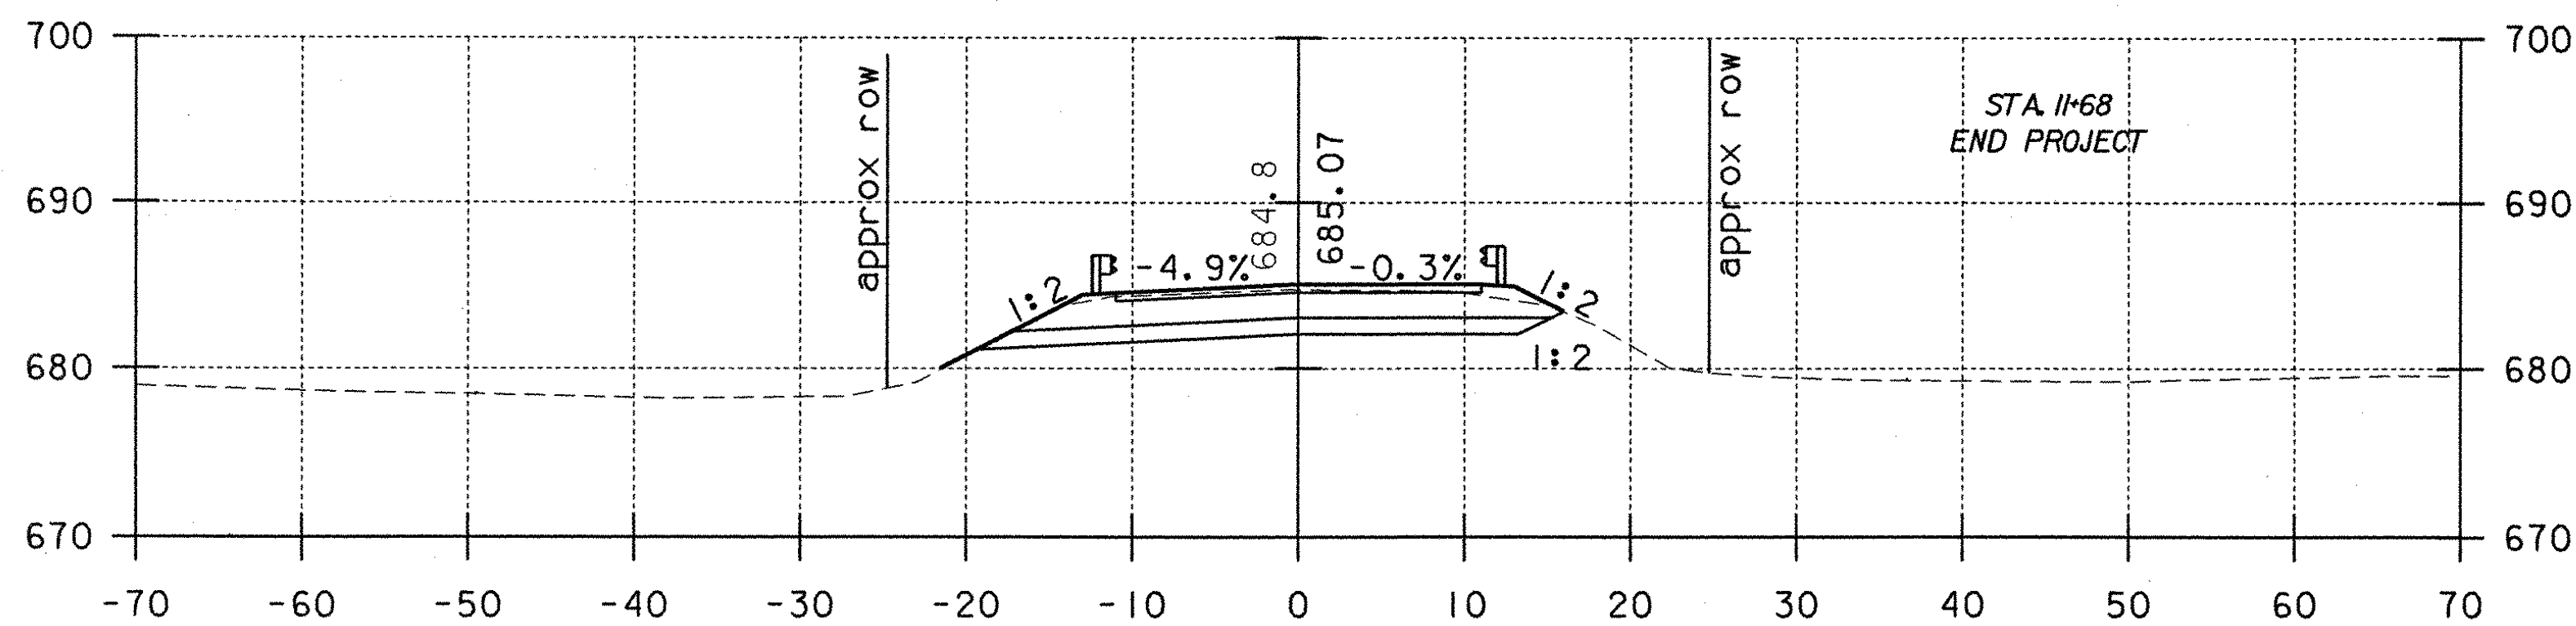


11+50

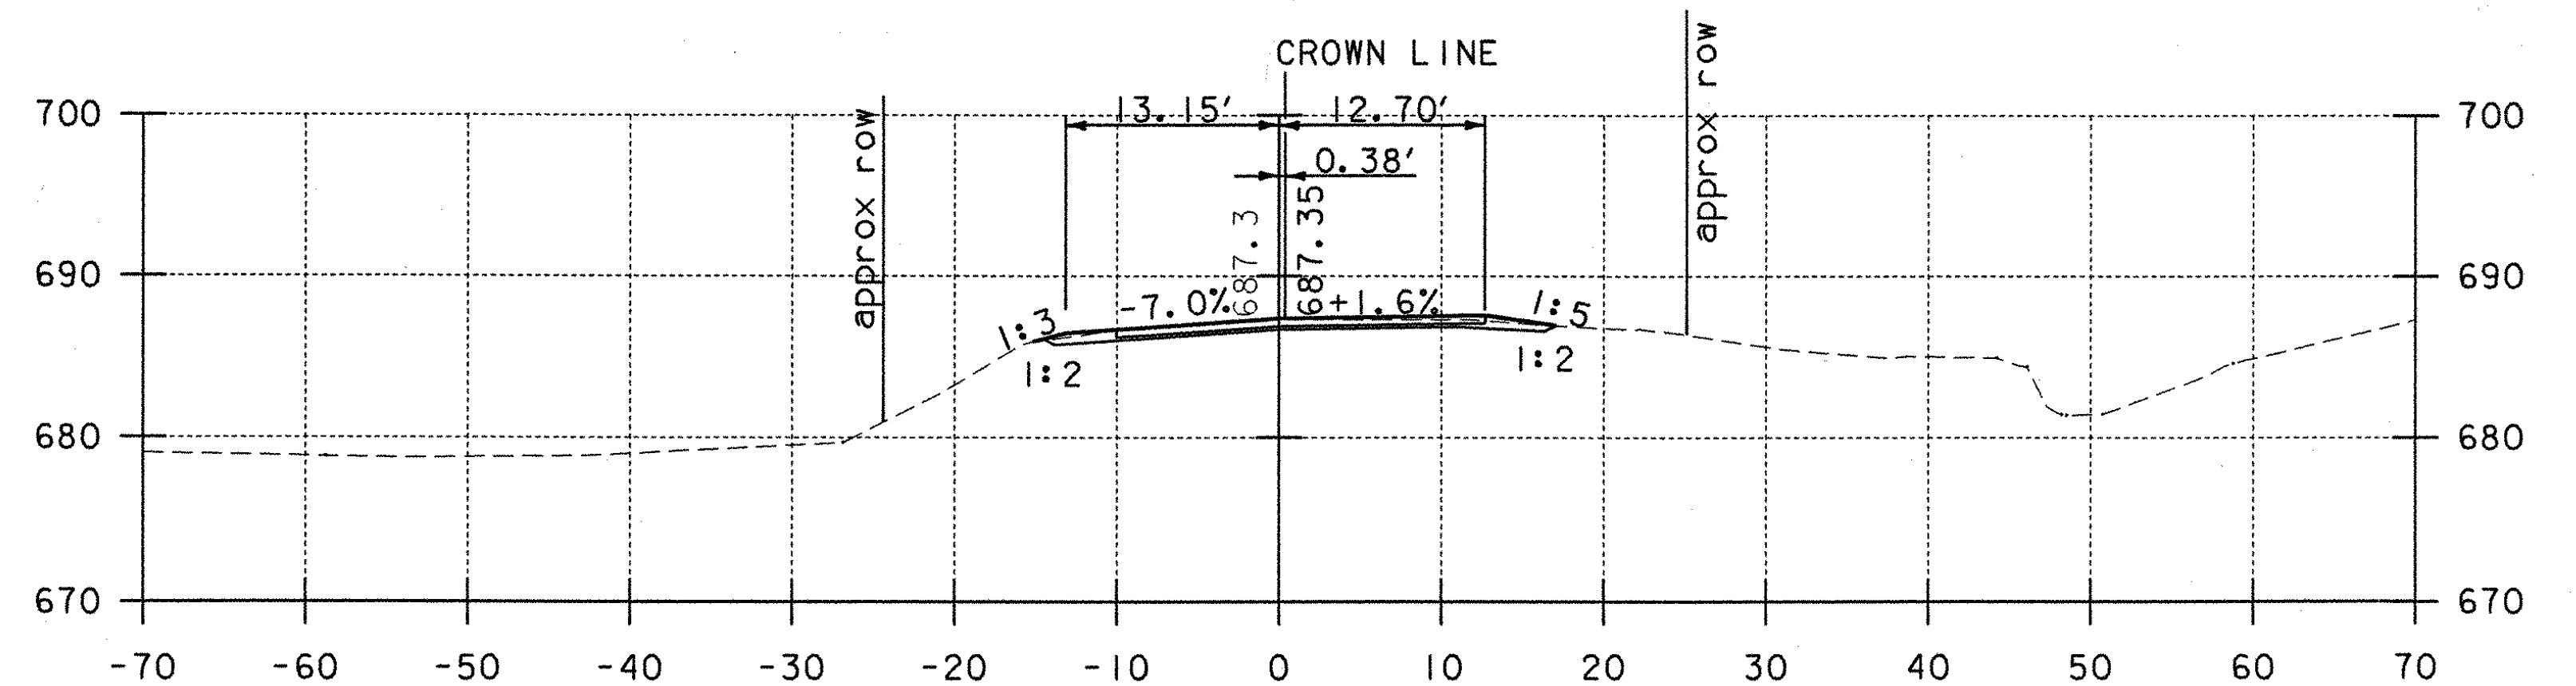


12+25

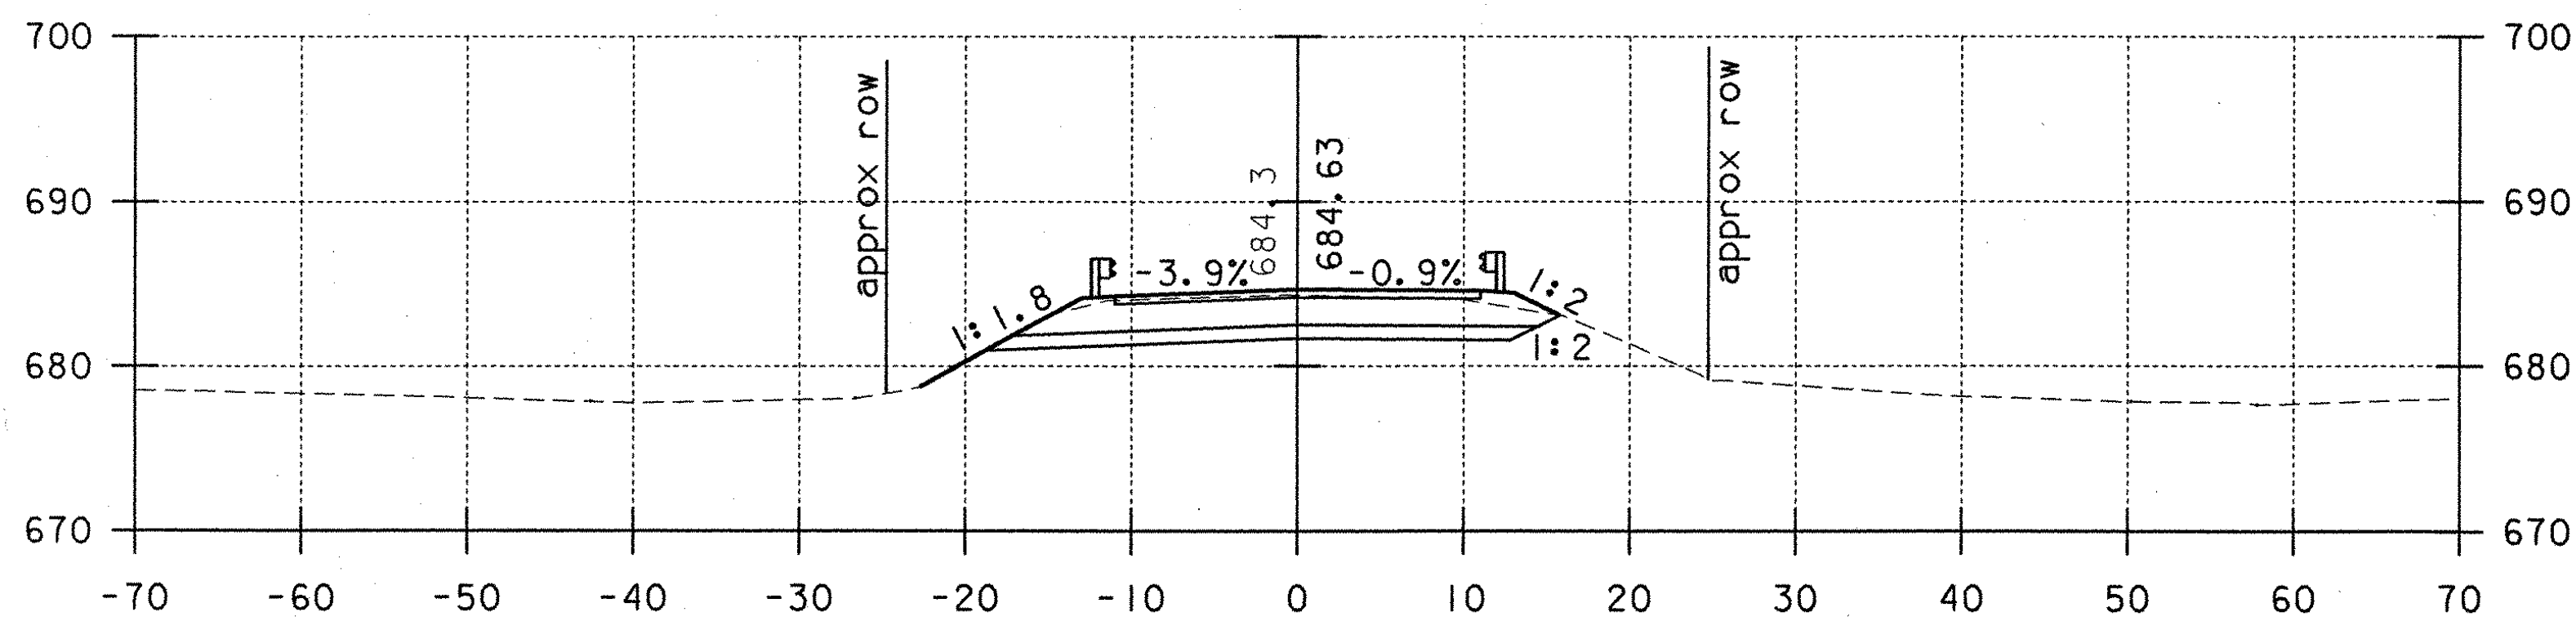

11+25

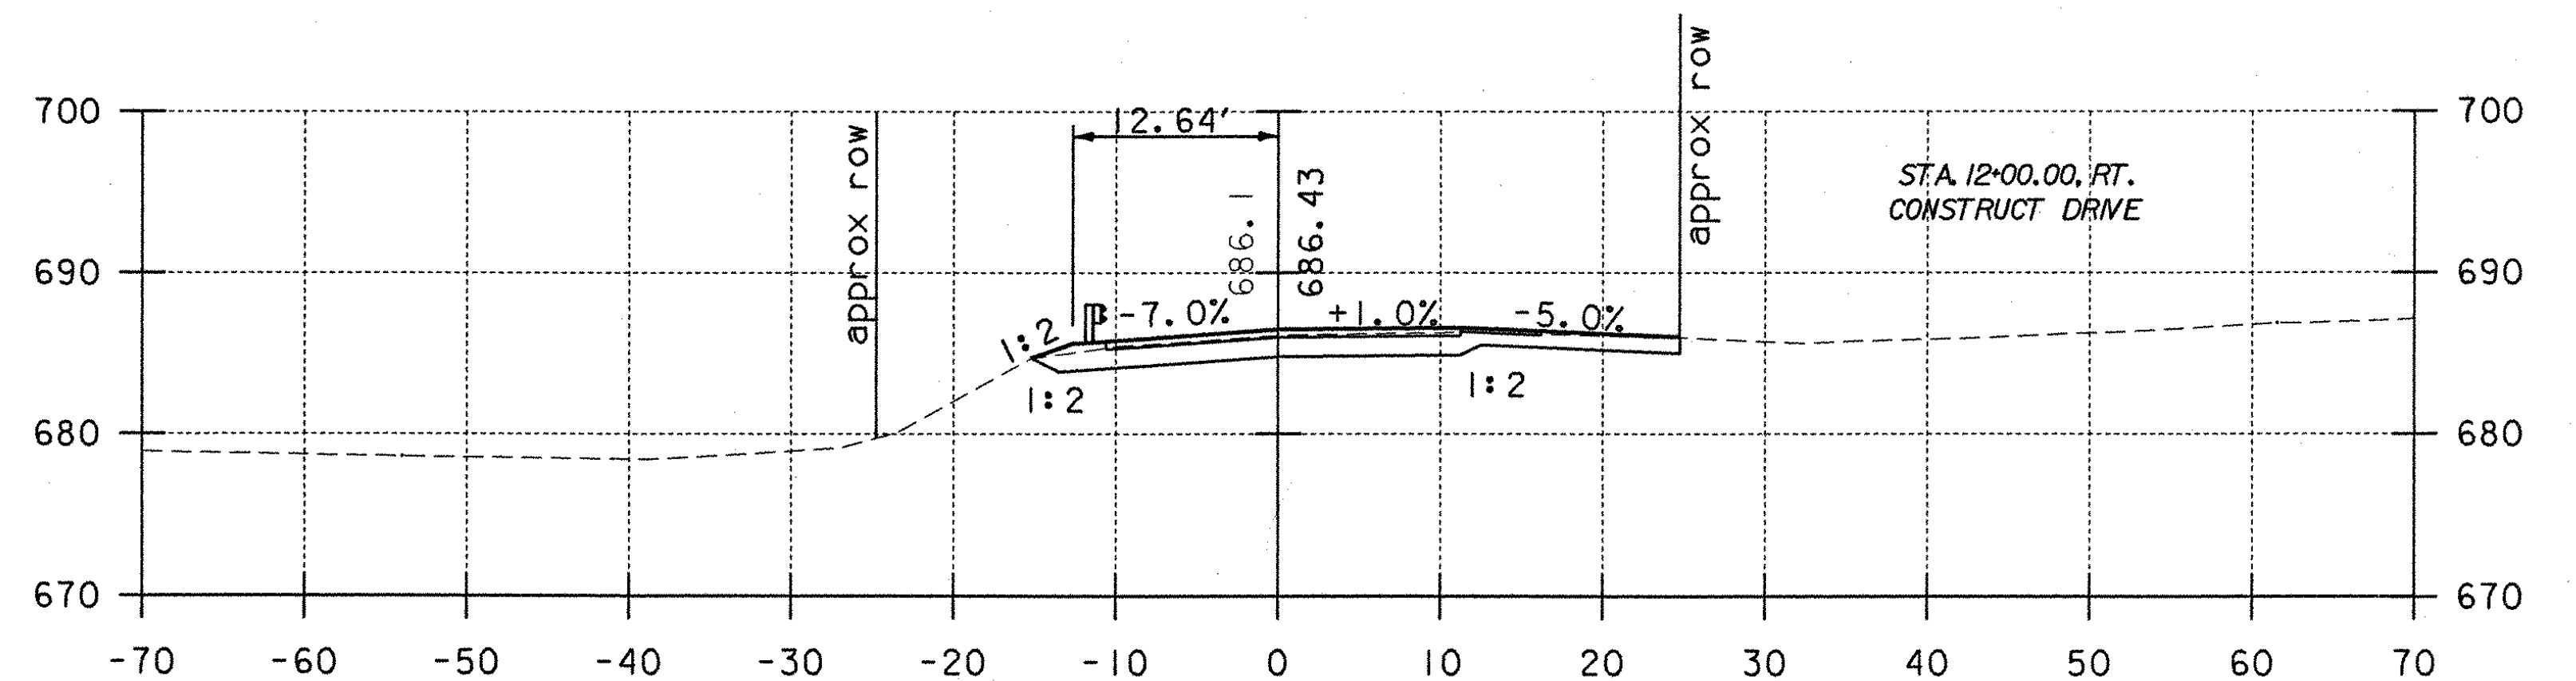

12+00

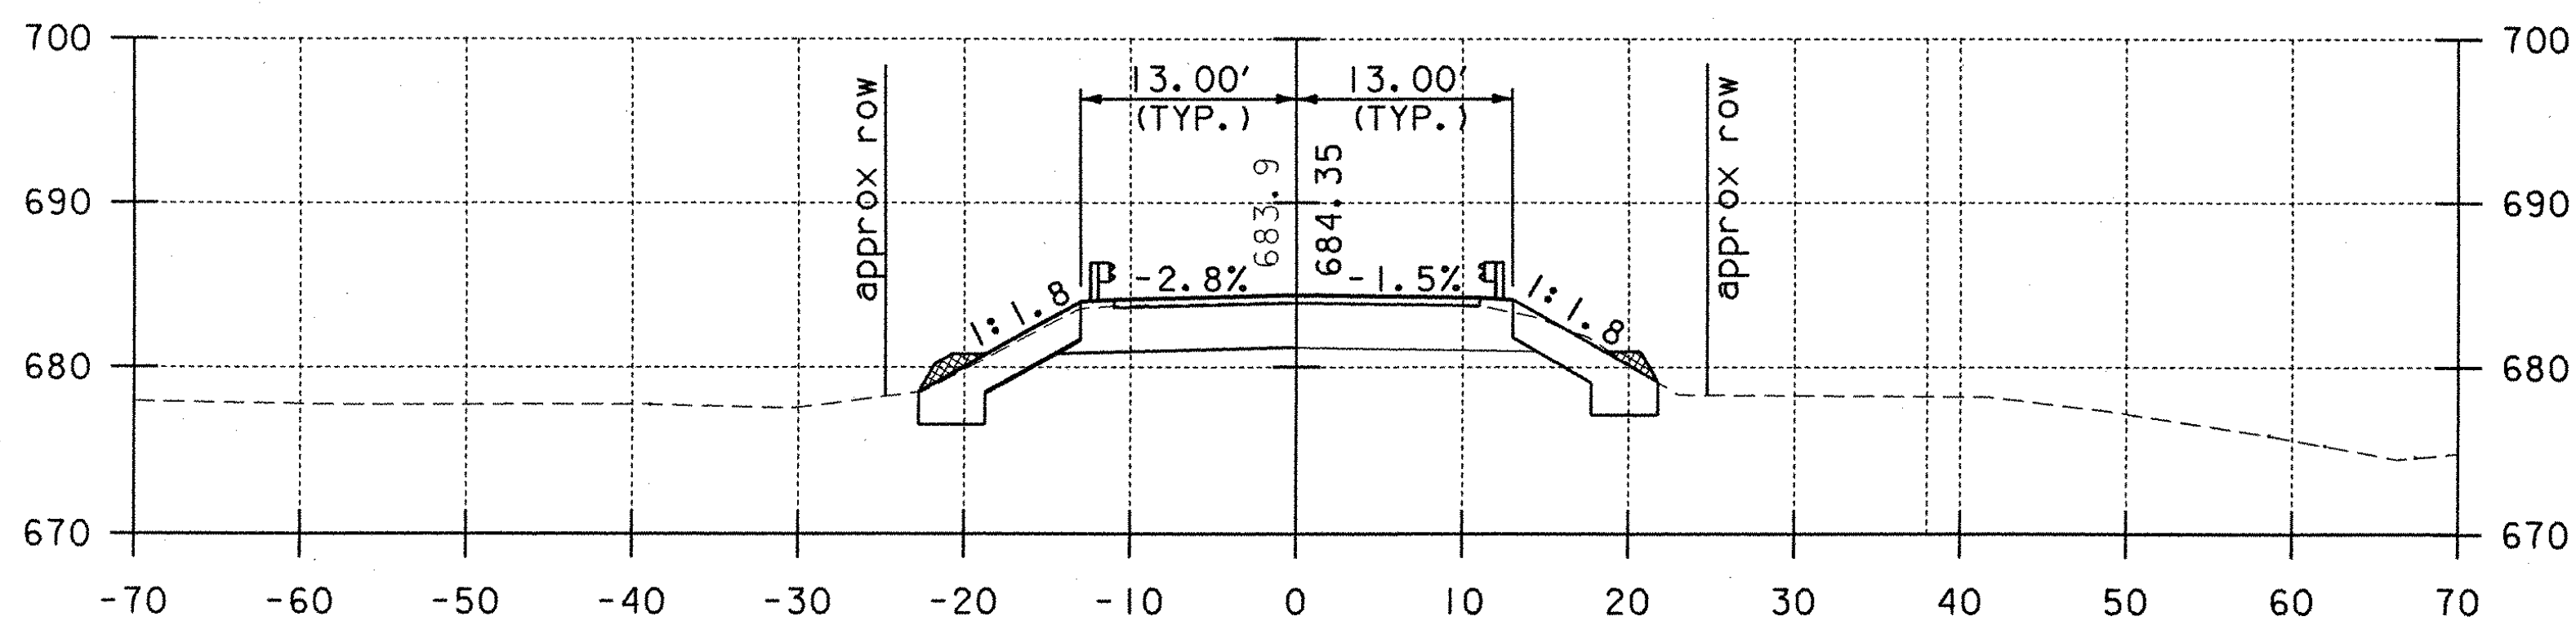

11+00

STATE OF VERMONT AGENCY OF TRANSPORTATION			
Town Of	WATERBURY	Bridge No.	14
Highway No.	6	Log Sta.	
LOOMIS HILL ROAD OVER THATCHER BROOK		Surv. Sta.	
ROADWAY CROSS SECTIONS			
Designed By	L. WIXSON	Drawn By	P. DUSTIN
Checked By	R. JOY	Bridge Design Supervisor	M. ZYDEL
Date	03/03	Date	03/03
PROJECT	WATERBURY	PROJECT NO.	TH 3-9637
I.G.C. Info. m:\549108-Waterbury\BRIDGE\6cont\1\J278xs2.dgn		Bridge Sheet No. Sheet 17 of 18	



PLOTTED 05-MAY-2003