




# Profiles

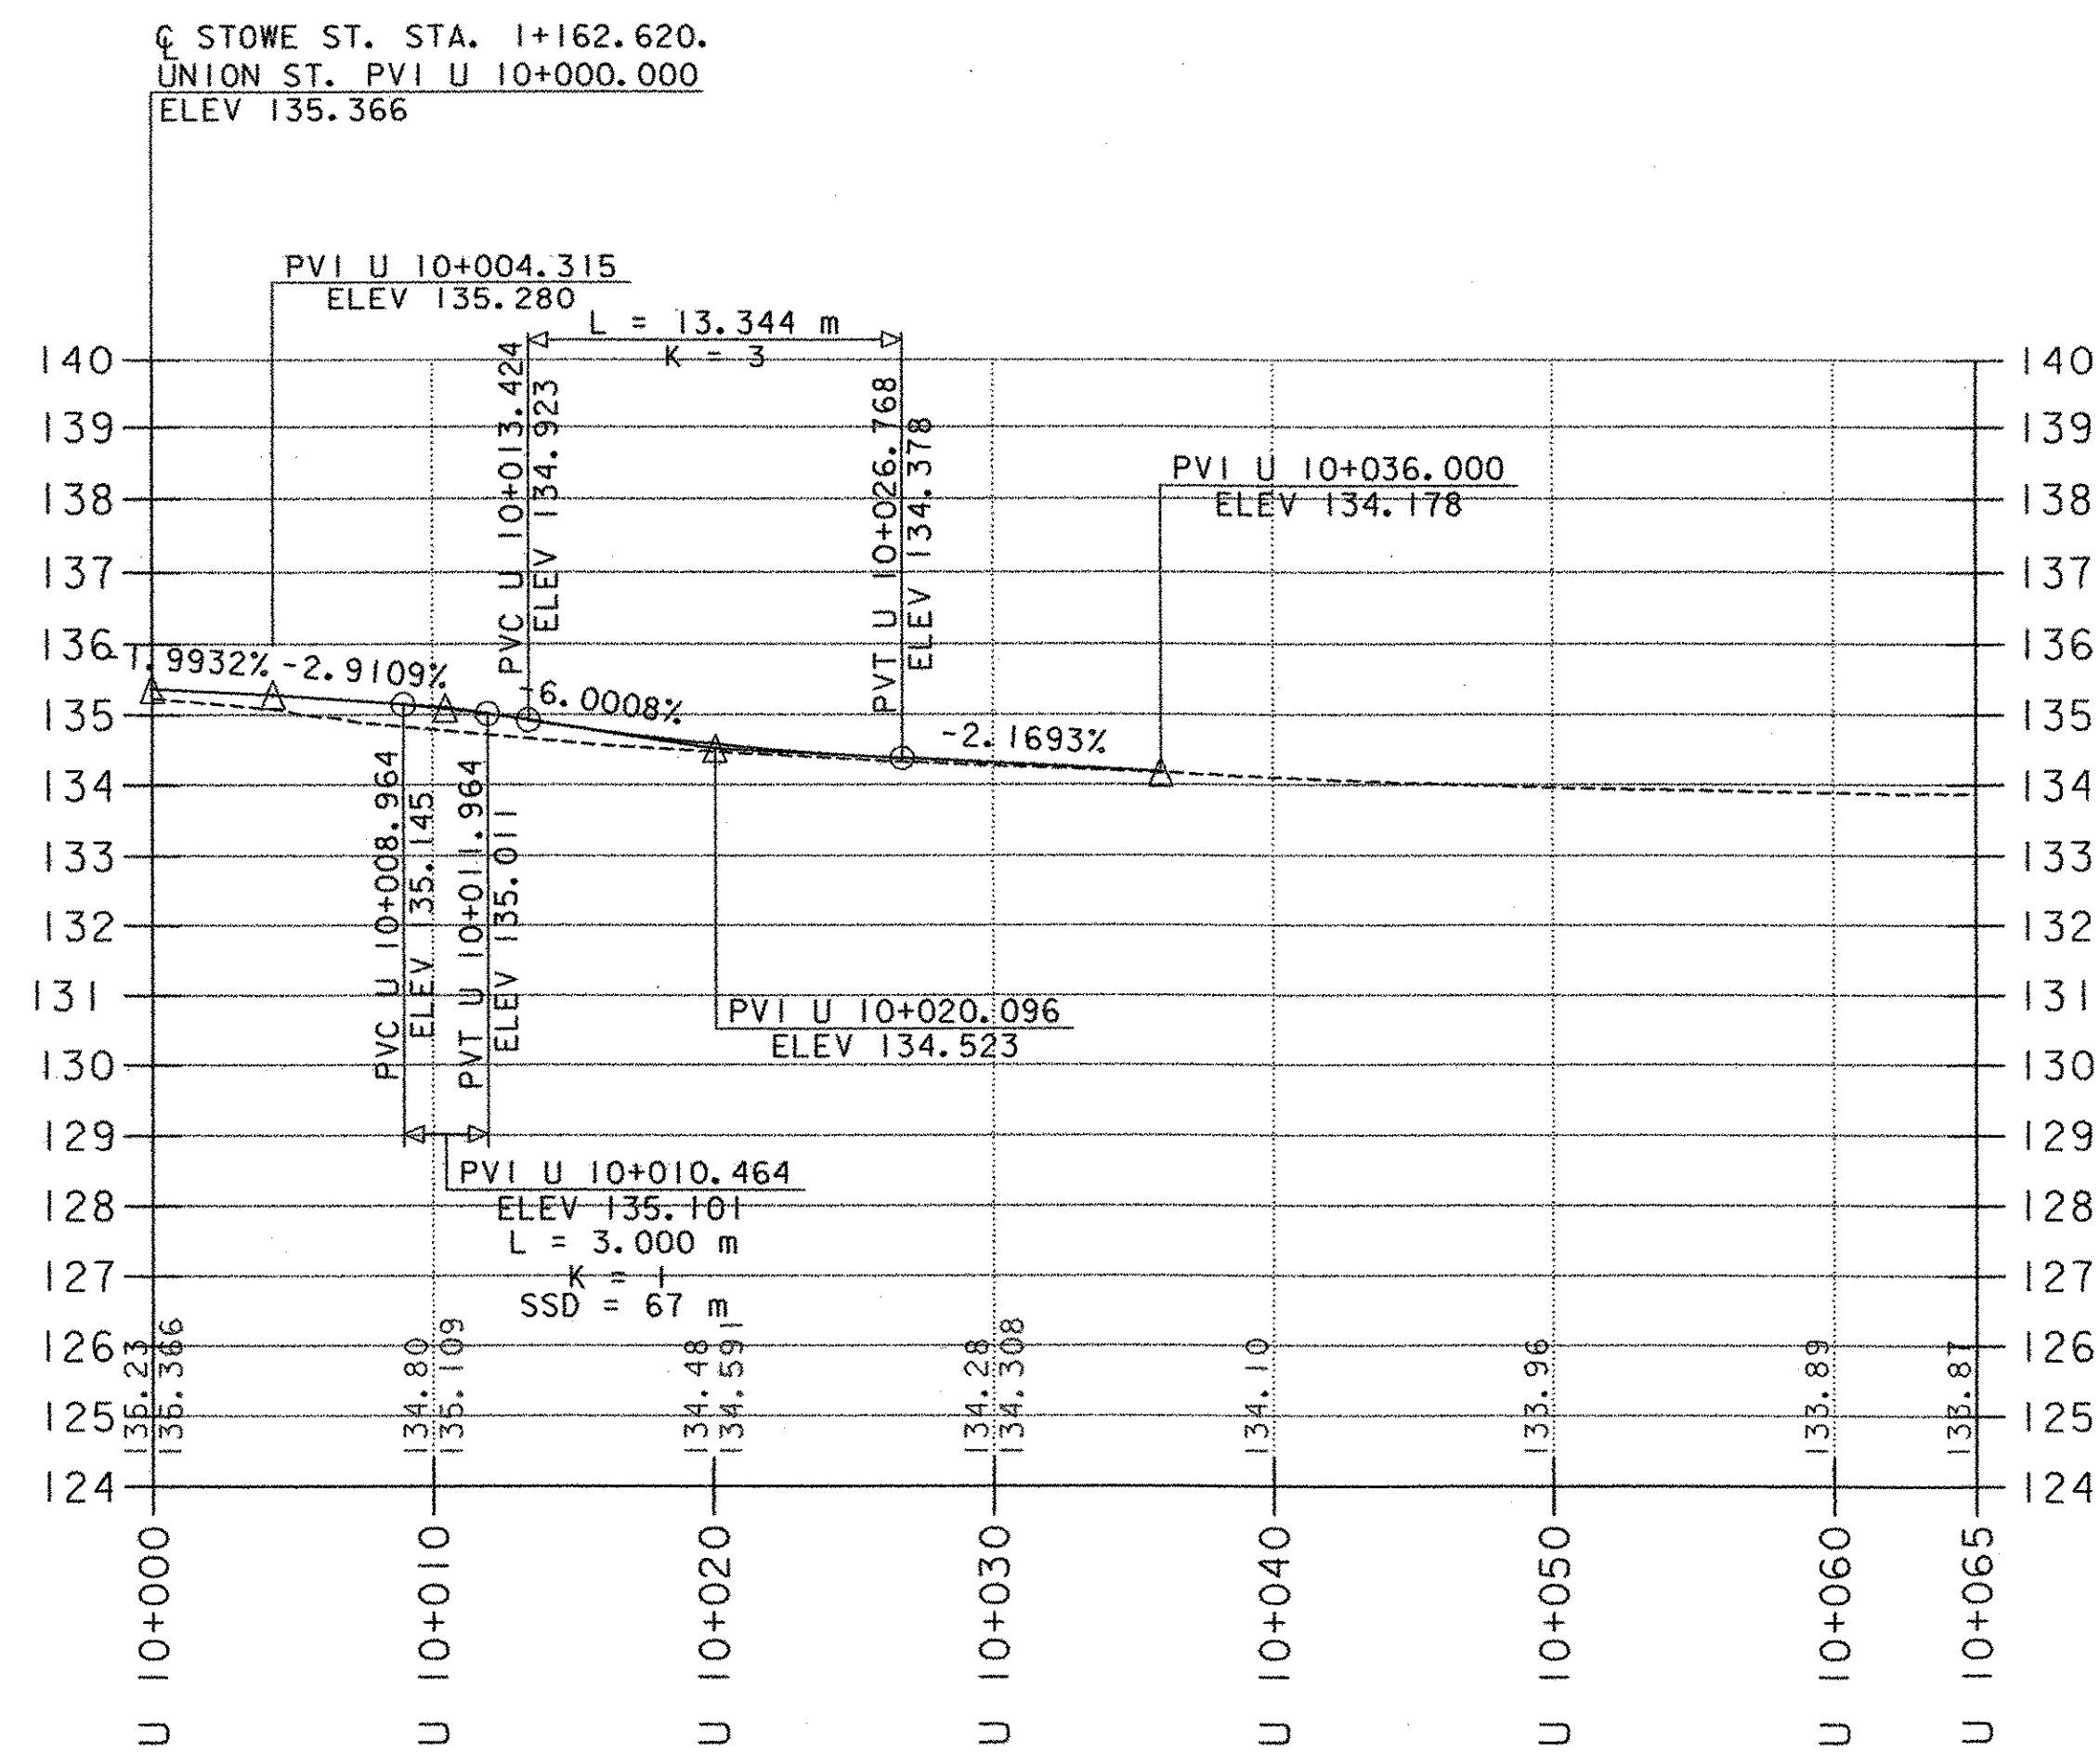


**UNION STREET**

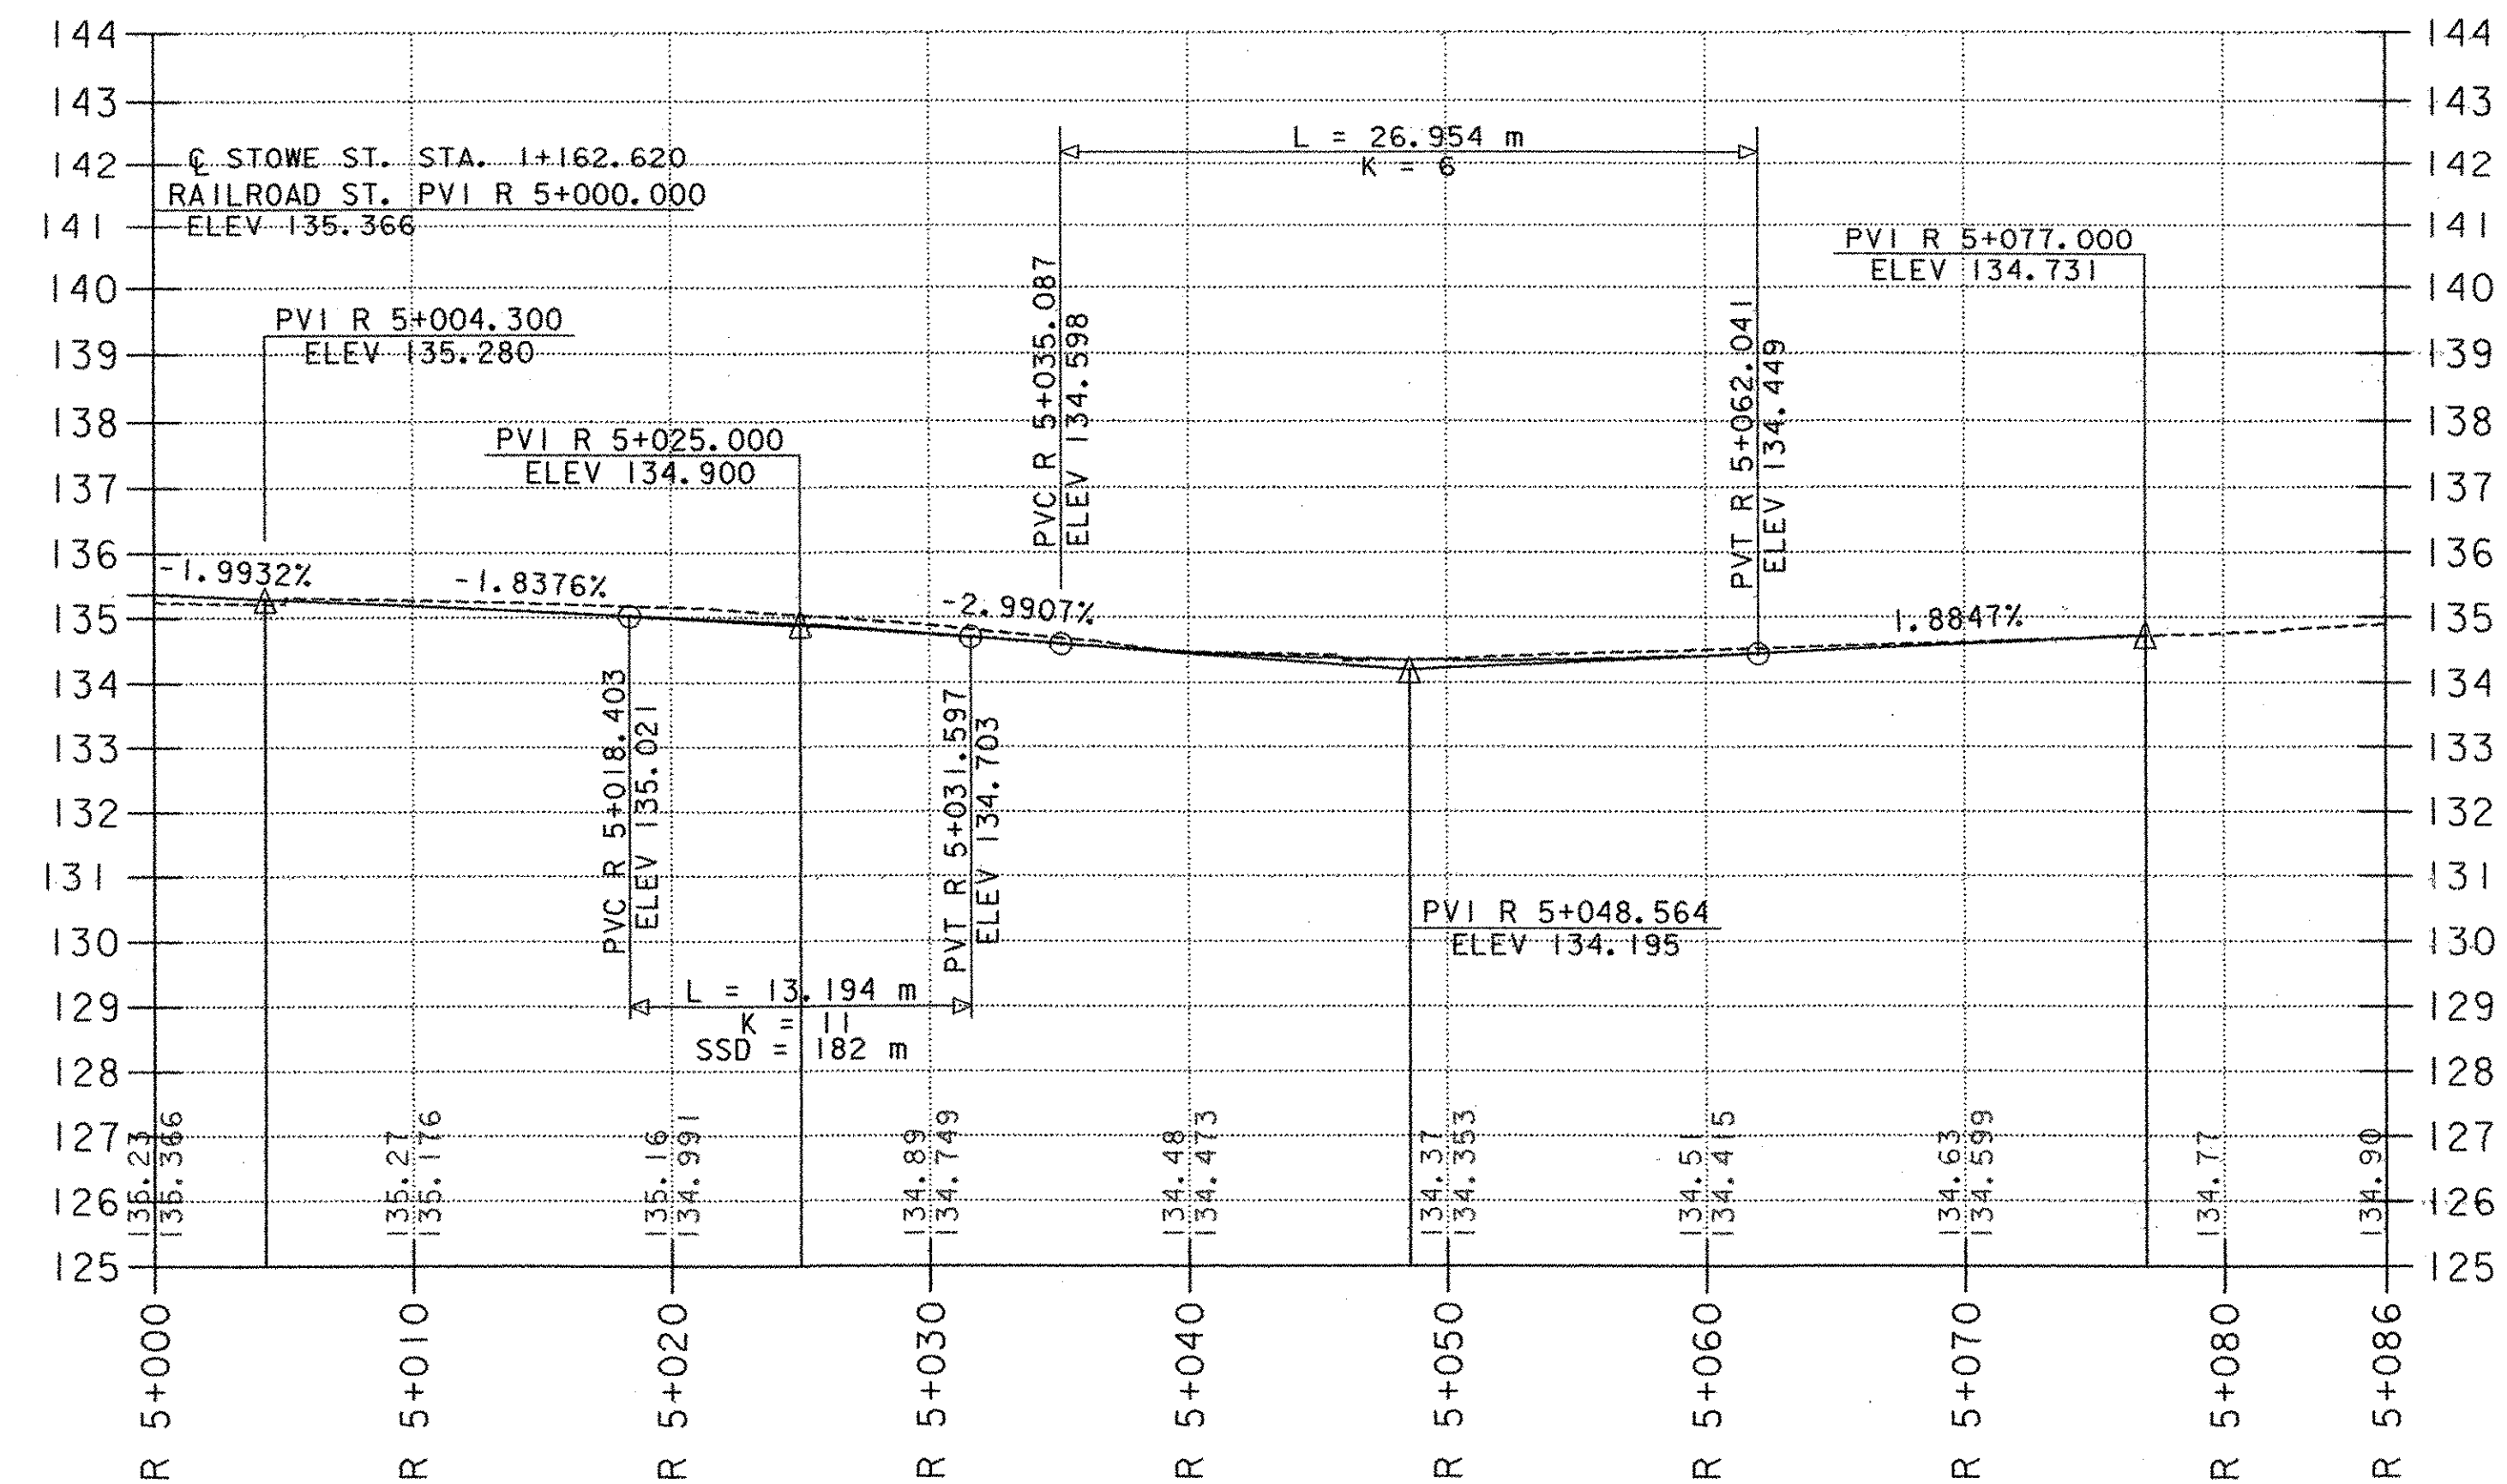

**RELOCATED RAILROAD STREET**

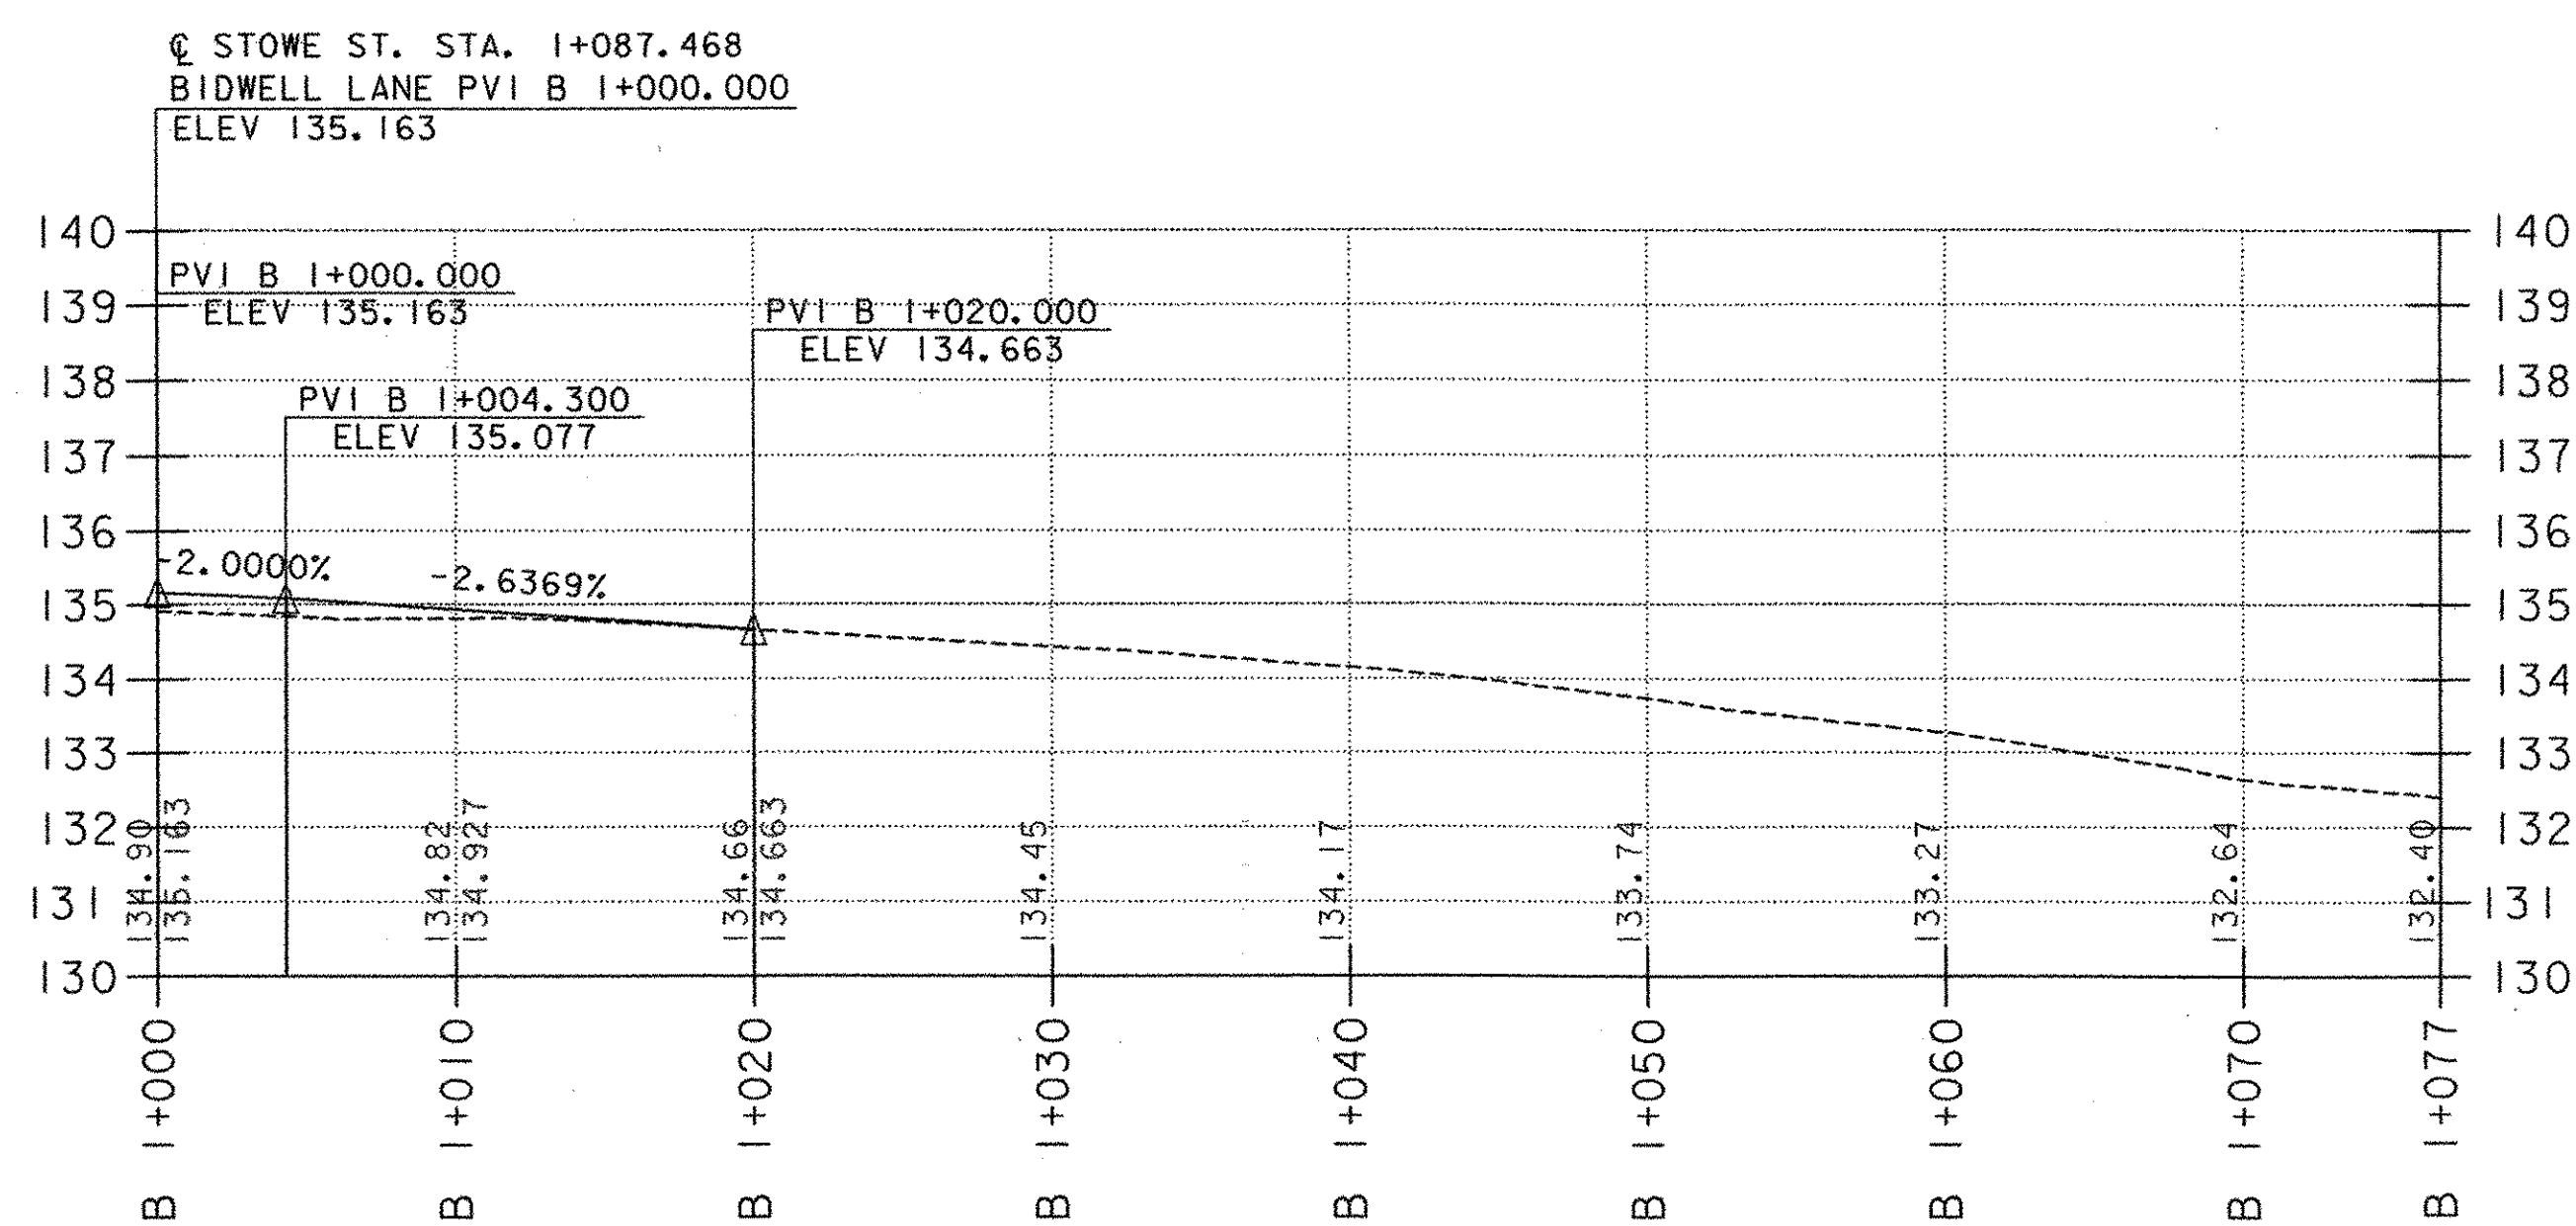

**BIDWELL LANE**

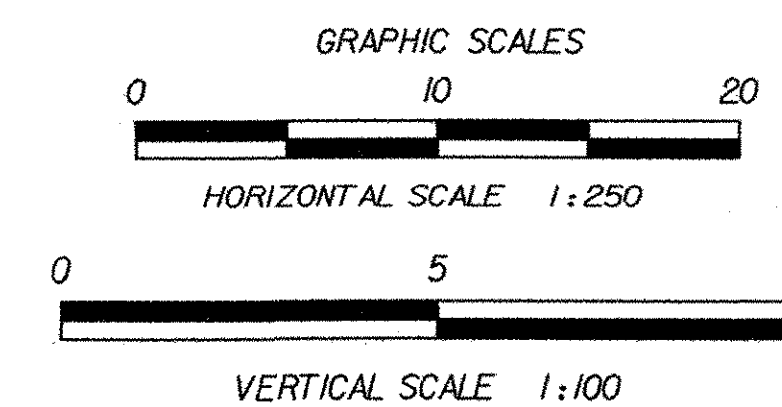

PROJECT NAME: WATERBURY  
 PROJECT NUMBER: BRO 1446(26)

FILE NAME: ...19-20 PROFILES.PTF  
 PROJECT LEADER: G EDWARDS/R GINGRAS  
 DESIGNED BY: R WALKER  
 PLOT DATE: 01/26/2004  
 DRAWN BY: R WALKER  
 CHECKED BY: R GINGRAS  
 SHEET 20 OF 63

**SIDEROAD PROFILES**