


REMOVING SIGNS
AS SHOWN - 15

- SIGN LEGEND**
- N = NEW
 - R = REMOVE
 - R&S = REMOVE & SALVAGE
 - S = SALVAGE SIGN
 - RET = RETAIN
 - B-B = BACK TO BACK
 - ⓪ = RETURN TO TOWN OF WATERBURY

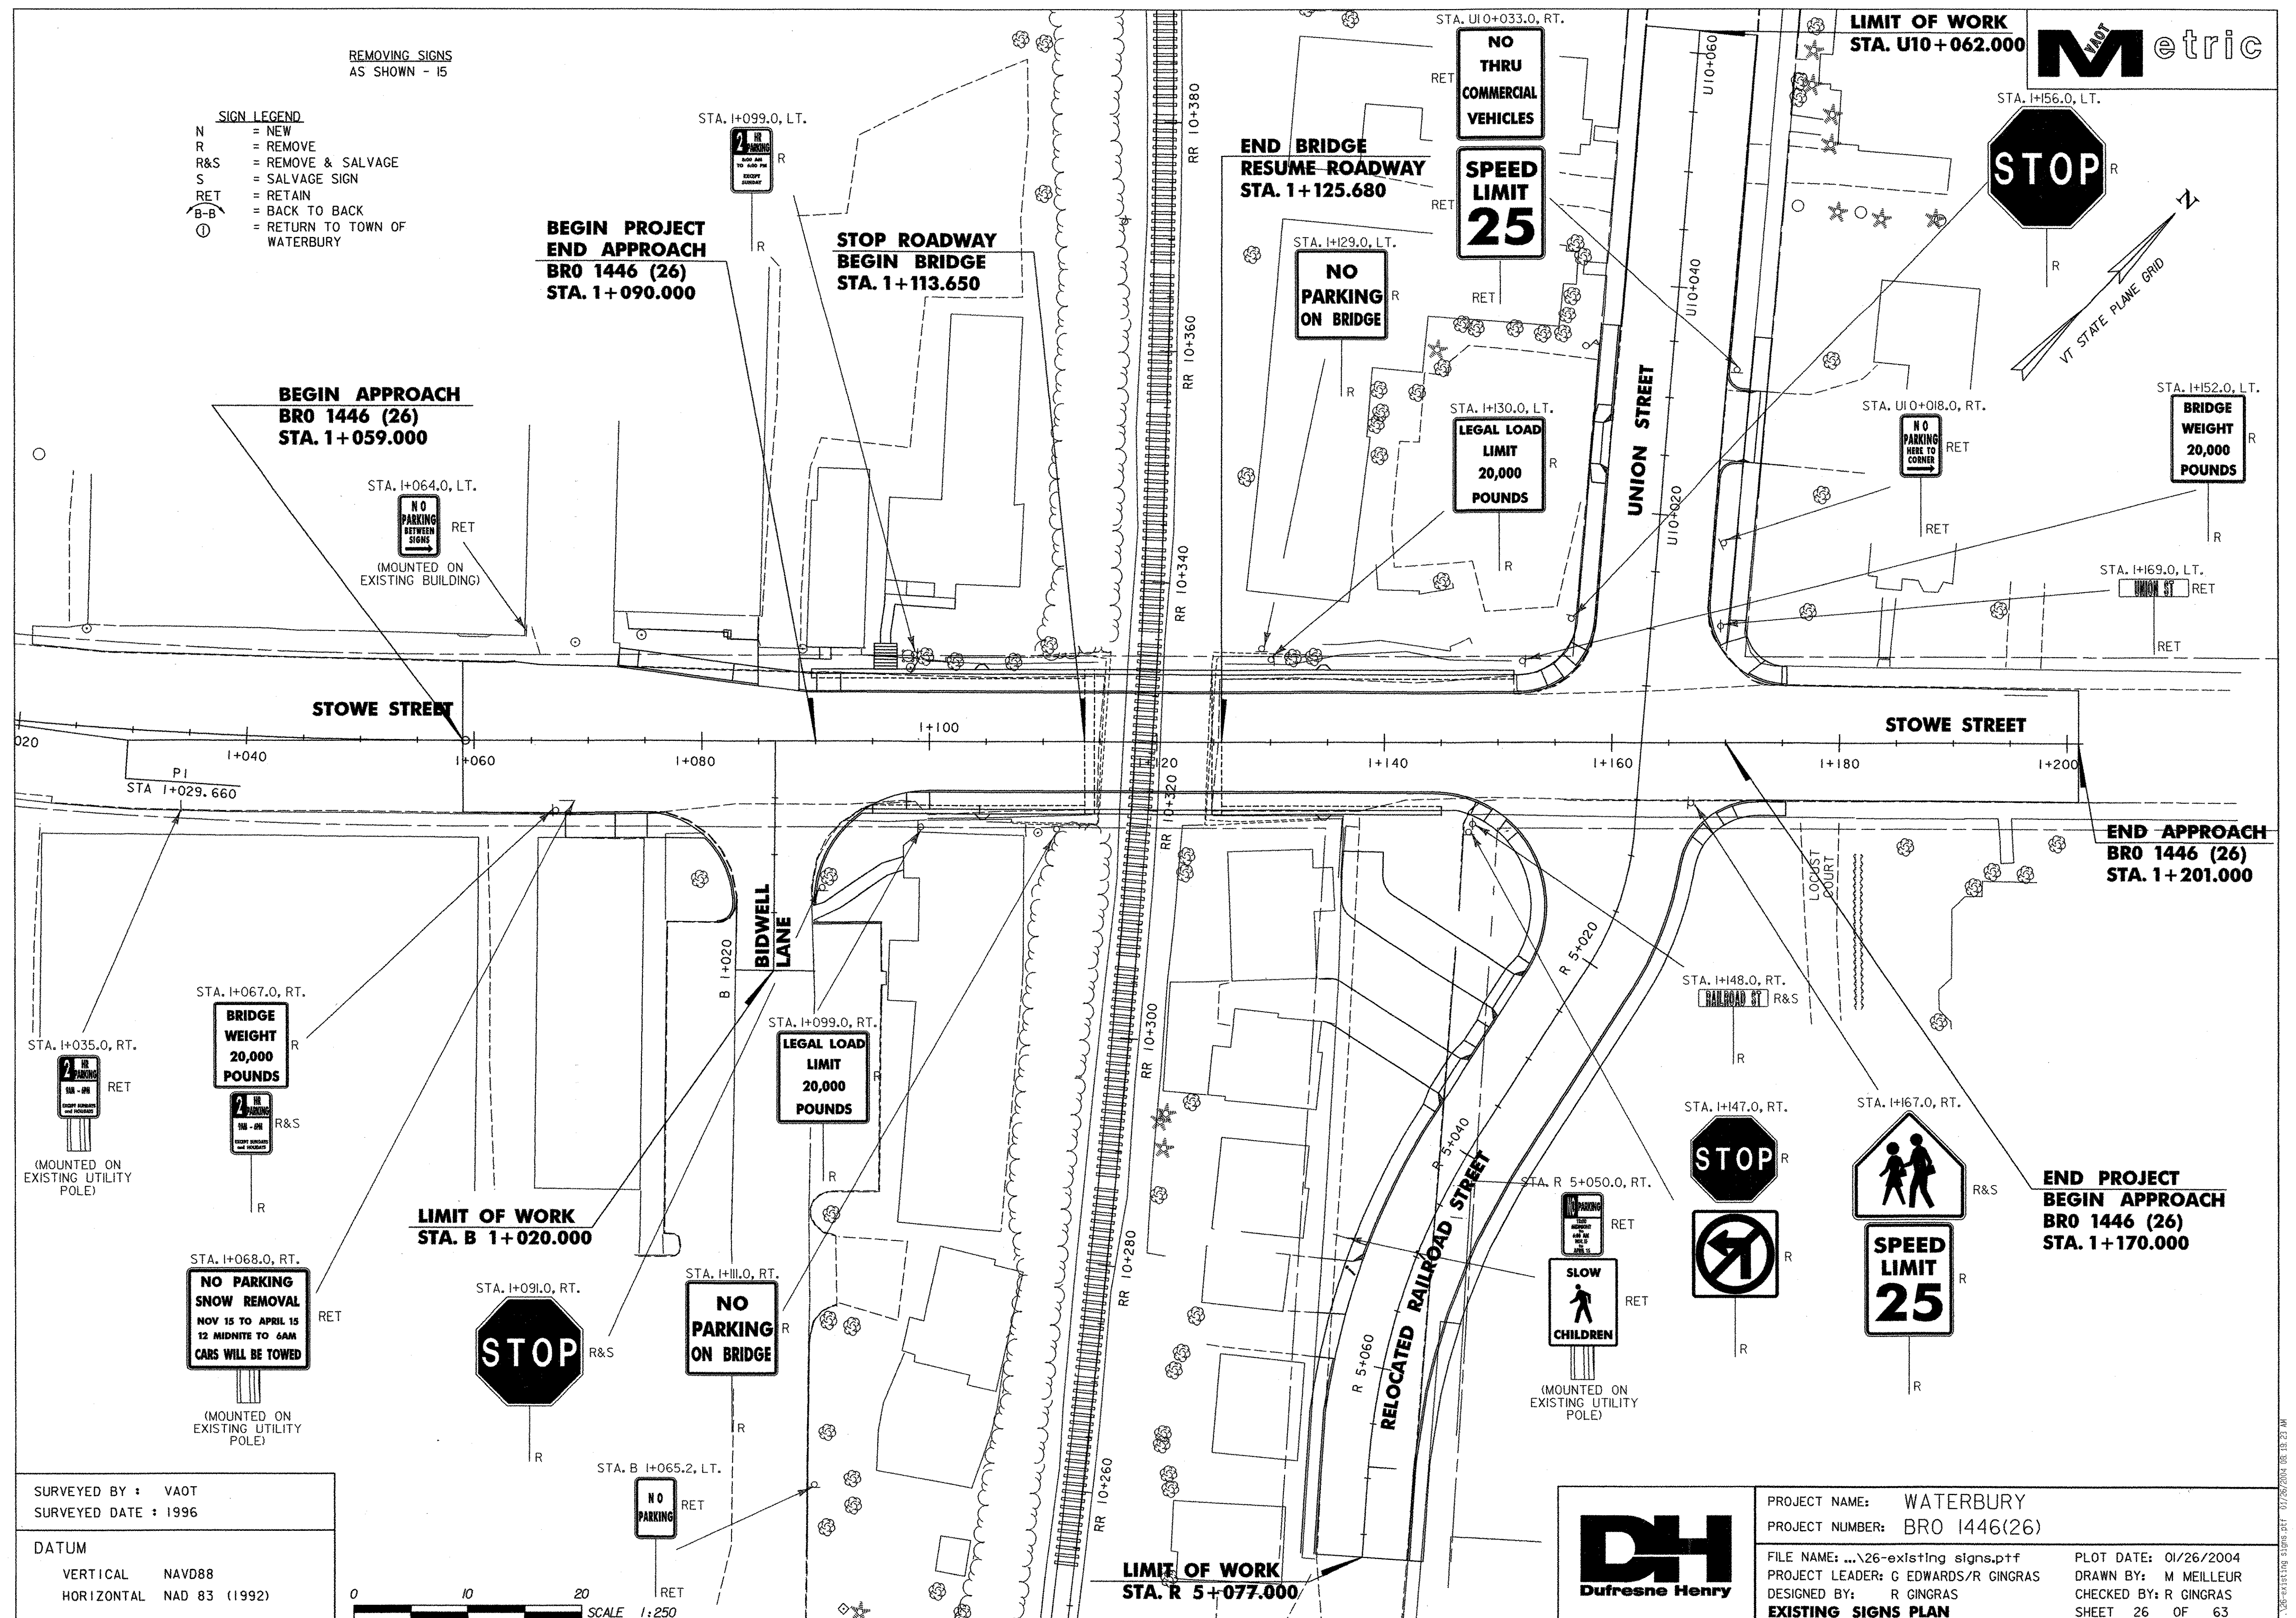

SURVEYED BY : VAOT
SURVEYED DATE : 1996

DATUM
VERTICAL NAVD88
HORIZONTAL NAD 83 (1992)



PROJECT NAME: WATERBURY
PROJECT NUMBER: BRO 1446(26)

FILE NAME: ...26-existing signs.ptf
PROJECT LEADER: G EDWARDS/R GINGRAS
DESIGNED BY: R GINGRAS
EXISTING SIGNS PLAN

PLOT DATE: 01/26/2004
DRAWN BY: M MEILLEUR
CHECKED BY: R GINGRAS
SHEET 26 OF 63

...26-existing signs.ptf 01/26/2004 08:18:21 AM