

TEMPORARY & DURABLE 100 mm WHITE LINE
 STA. I+059.0 TO I+201.0, SOLID LT. & RT.
 (WITH EDGELINE BREAKS FOR BIDWELL
 LANE, UNION STREET & RELOCATED RAILROAD STREET)

TEMPORARY & DURABLE CROSSWALK WITH DIAGONAL LINES (MOD.)
 STA. B I+007.0 (BIDWELL LANE)
 STA. U10+007.0 (UNION ST.)
 STA. R 5+007.0 (RELOCATED RAILROAD STREET)

TEMPORARY & DURABLE LETTER OR SYMBOL
 STA. B I+012.5, LT. *STOP* (BIDWELL LANE)
 STA. U10+012.4, LT. *STOP* (UNION ST.)
 STA. R 5+012.8, LT. *STOP* (RELOCATED RAILROAD ST.)

ERECTING SALVAGED SIGNS
 AS SHOWN - 4

TEMPORARY & DURABLE 100 mm YELLOW LINE
 STA. I+059.0 TO I+201.0, SOLID LT. & RT.
 (WITH CENTERLINE BREAKS FOR BIDWELL
 LANE, UNION STREET & RELOCATED RAILROAD STREET
 STA. I+086.0, DOUBLE SOLID RT. (BIDWELL LANE)
 STA. I+163.0, DOUBLE SOLID LT. & RT.
 (UNION STREET & RELOCATED RAILROAD STREET)

TEMPORARY & DURABLE 600 mm STOP BAR
 STA. B I+009.8, LT. (BIDWELL LANE)
 STA. U10+009.7, LT. (UNION ST.)
 STA. R 5+010.0, LT. (RELOCATED RAILROAD STREET)

**BEGIN PROJECT
 END APPROACH
 BRO 1446 (26)
 STA. 1+090.000**

**STOP ROADWAY
 BEGIN BRIDGE
 STA. 1+113.650**

**END BRIDGE
 RESUME ROADWAY
 STA. 1+125.680**

**LIMIT OF WORK
 STA. U10+062.000**



**NO
 THRU
 COMMERCIAL
 VEHICLES**


**SPEED
 LIMIT
 25**

**NO
 PARKING
 HERE TO
 CORNER**


**NO
 PARKING
 NOV 15 TO APRIL 15
 12 MIDNITE TO 6AM
 CARS WILL BE TOWED**

**END APPROACH
 BRO 1446 (26)
 STA. 1+201.000**


**SPEED
 LIMIT
 25**

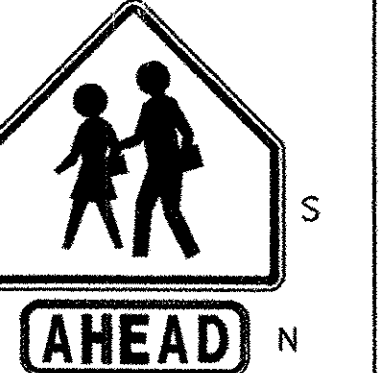

**END PROJECT
 BEGIN APPROACH
 BRO 1446 (26)
 STA. 1+170.000**

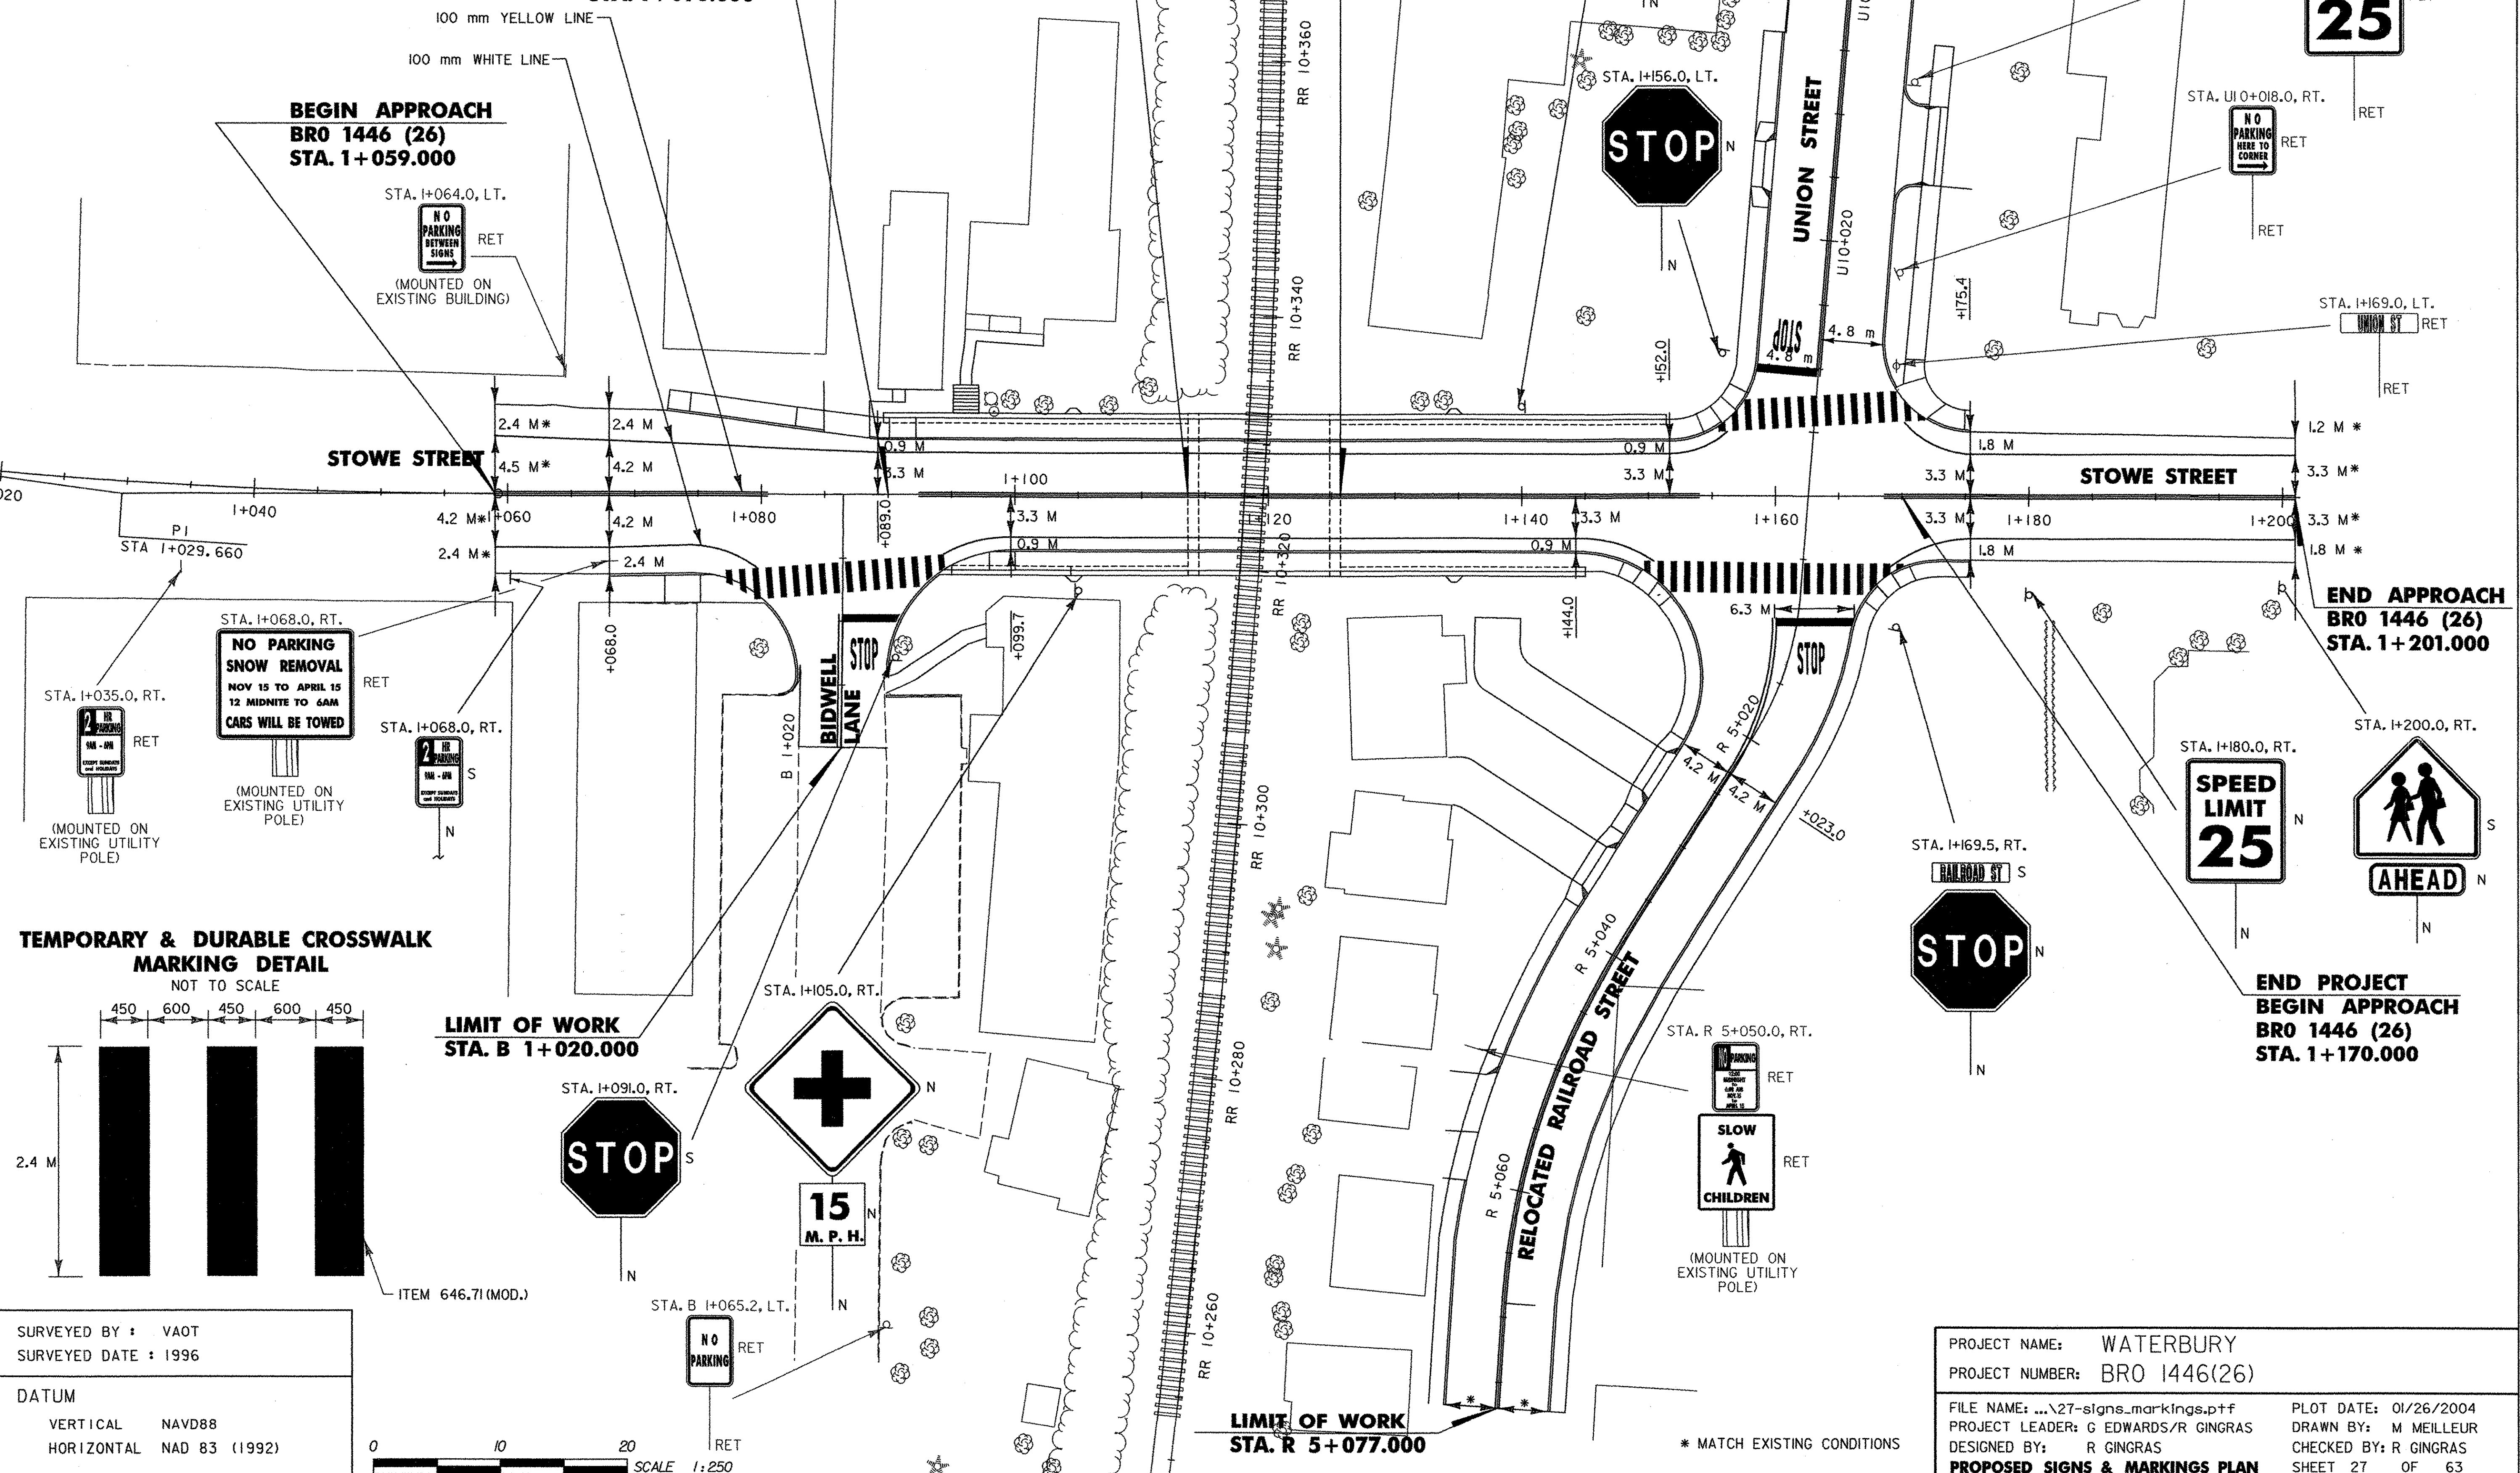

TEMPORARY & DURABLE CROSSWALK MARKING DETAIL
 NOT TO SCALE

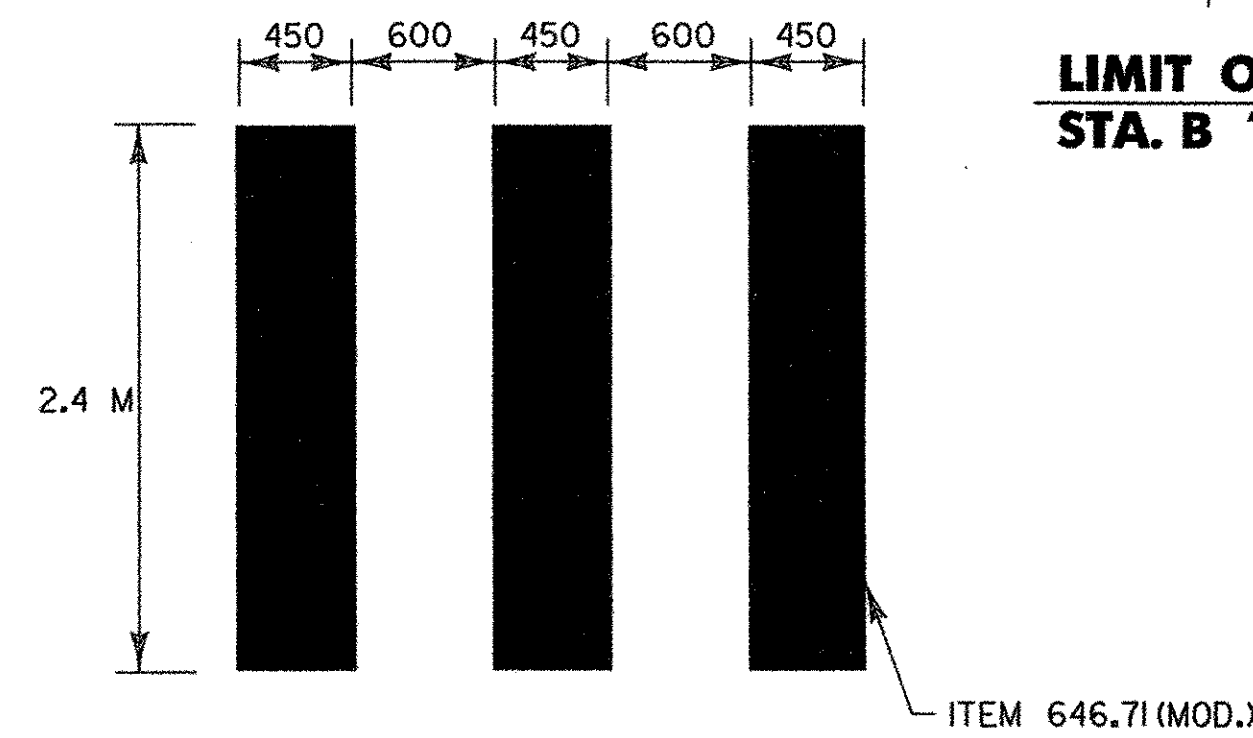

SURVEYED BY : VAOT
 SURVEYED DATE : 1996

DATUM
 VERTICAL NAVD88
 HORIZONTAL NAD 83 (1992)



**LIMIT OF WORK
 STA. R 5+077.000**

* MATCH EXISTING CONDITIONS

PROJECT NAME: WATERBURY
 PROJECT NUMBER: BRO 1446(26)

FILE NAME: ...27-signs_markings.pxf
 PROJECT LEADER: G EDWARDS/R GINGRAS
 DESIGNED BY: R GINGRAS
 PROPOSED SIGNS & MARKINGS PLAN

PLOT DATE: 01/26/2004
 DRAWN BY: M MEILLEUR
 CHECKED BY: R GINGRAS
 SHEET 27 OF 63