


BORING No.	ALIGNMENT	STATION	OFFSET
B-01	STOWE STREET	1+083.000	0
B-02	STOWE STREET	1+100.000	2.2 LT
B-04	STOWE STREET	1+111.400	2.2 LT
B-05	STOWE STREET	1+130.000	2.2 RT
B-07	STOWE STREET	1+143.000	2.2 LT
B-08	STOWE STREET	1+180.000	0
B-09	UNION STREET	U 10+025.000	0
B-10	REL. RAILROAD STREET	R 5+045.000	0

B-01 = BORING



DATUM
 VERTICAL NAV 88
 HORIZONTAL NAD83 (1992)

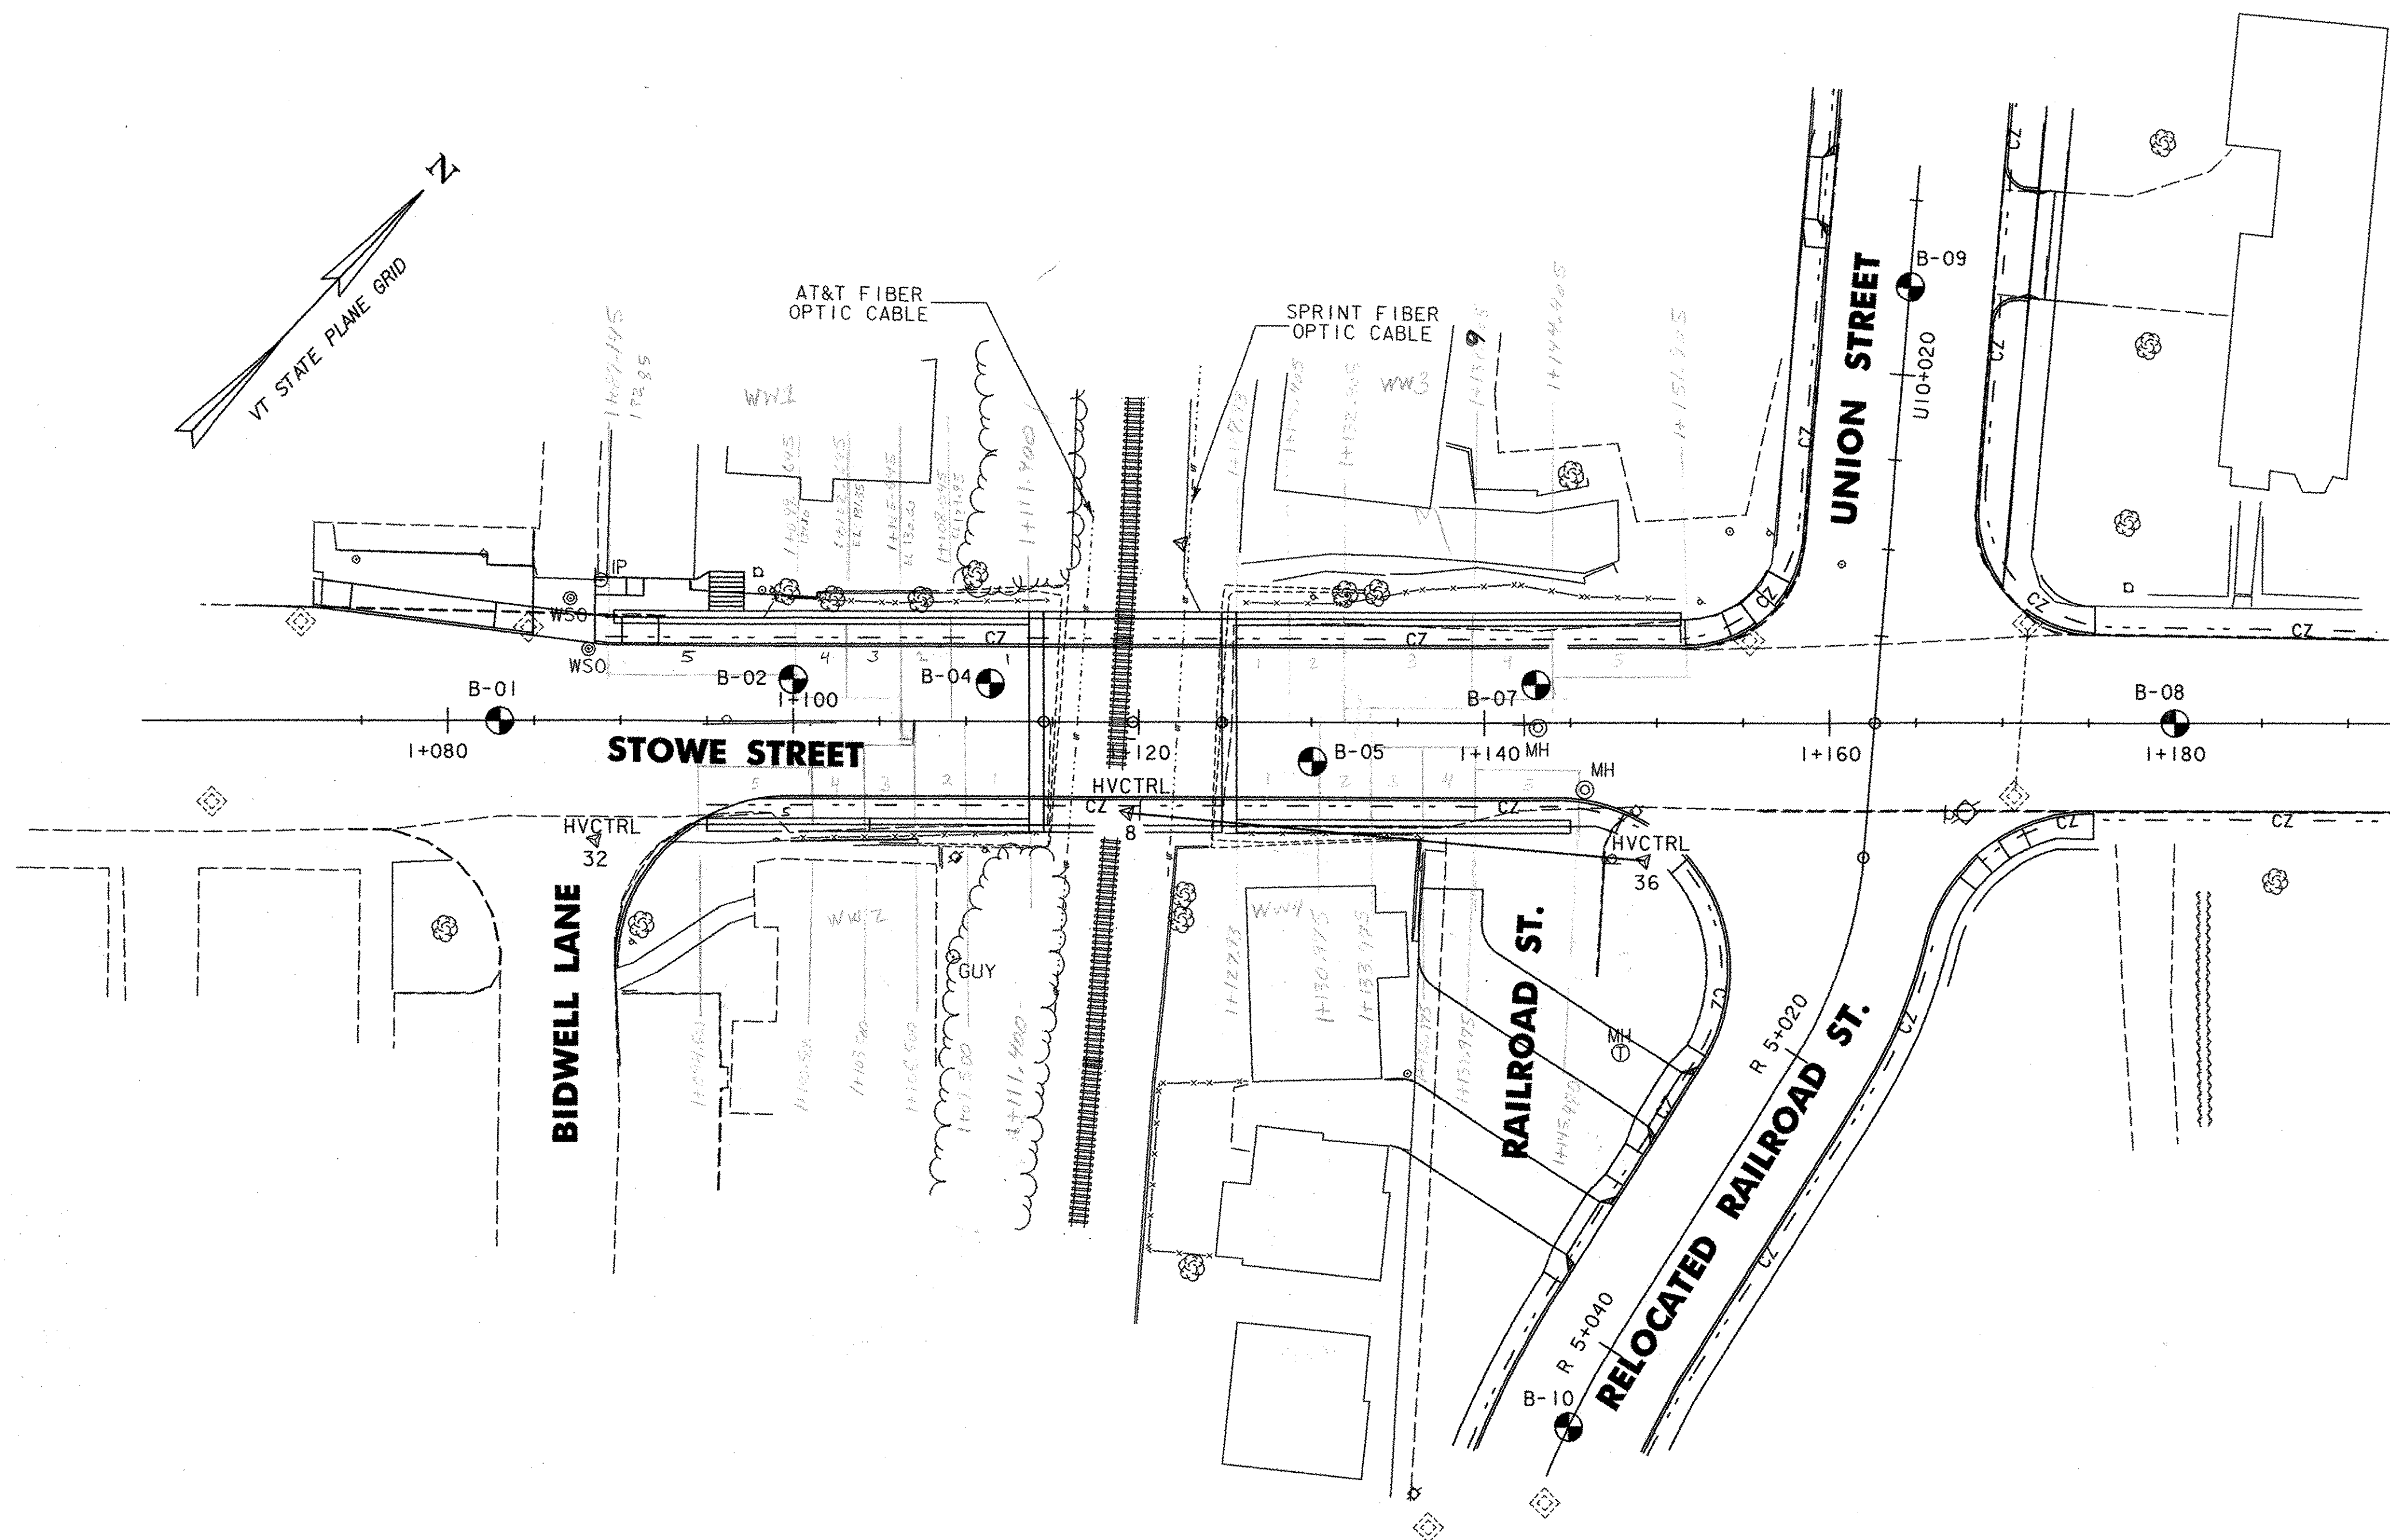

PROJECT NAME: WATERBURY
 PROJECT NUMBER: BRO 1446(26)

FILE NAME: ...\30-boring layout.pif
 PROJECT LEADER: R GINGRAS
 DESIGNED BY: R GINGRAS
BORING LAYOUT SHEET

PLOT DATE: 01/26/2004
 DRAWN BY: M MELLEUR
 CHECKED BY: R GINGRAS
 SHEET 30 OF 63