


**PLAN**  
SCALE 1:50

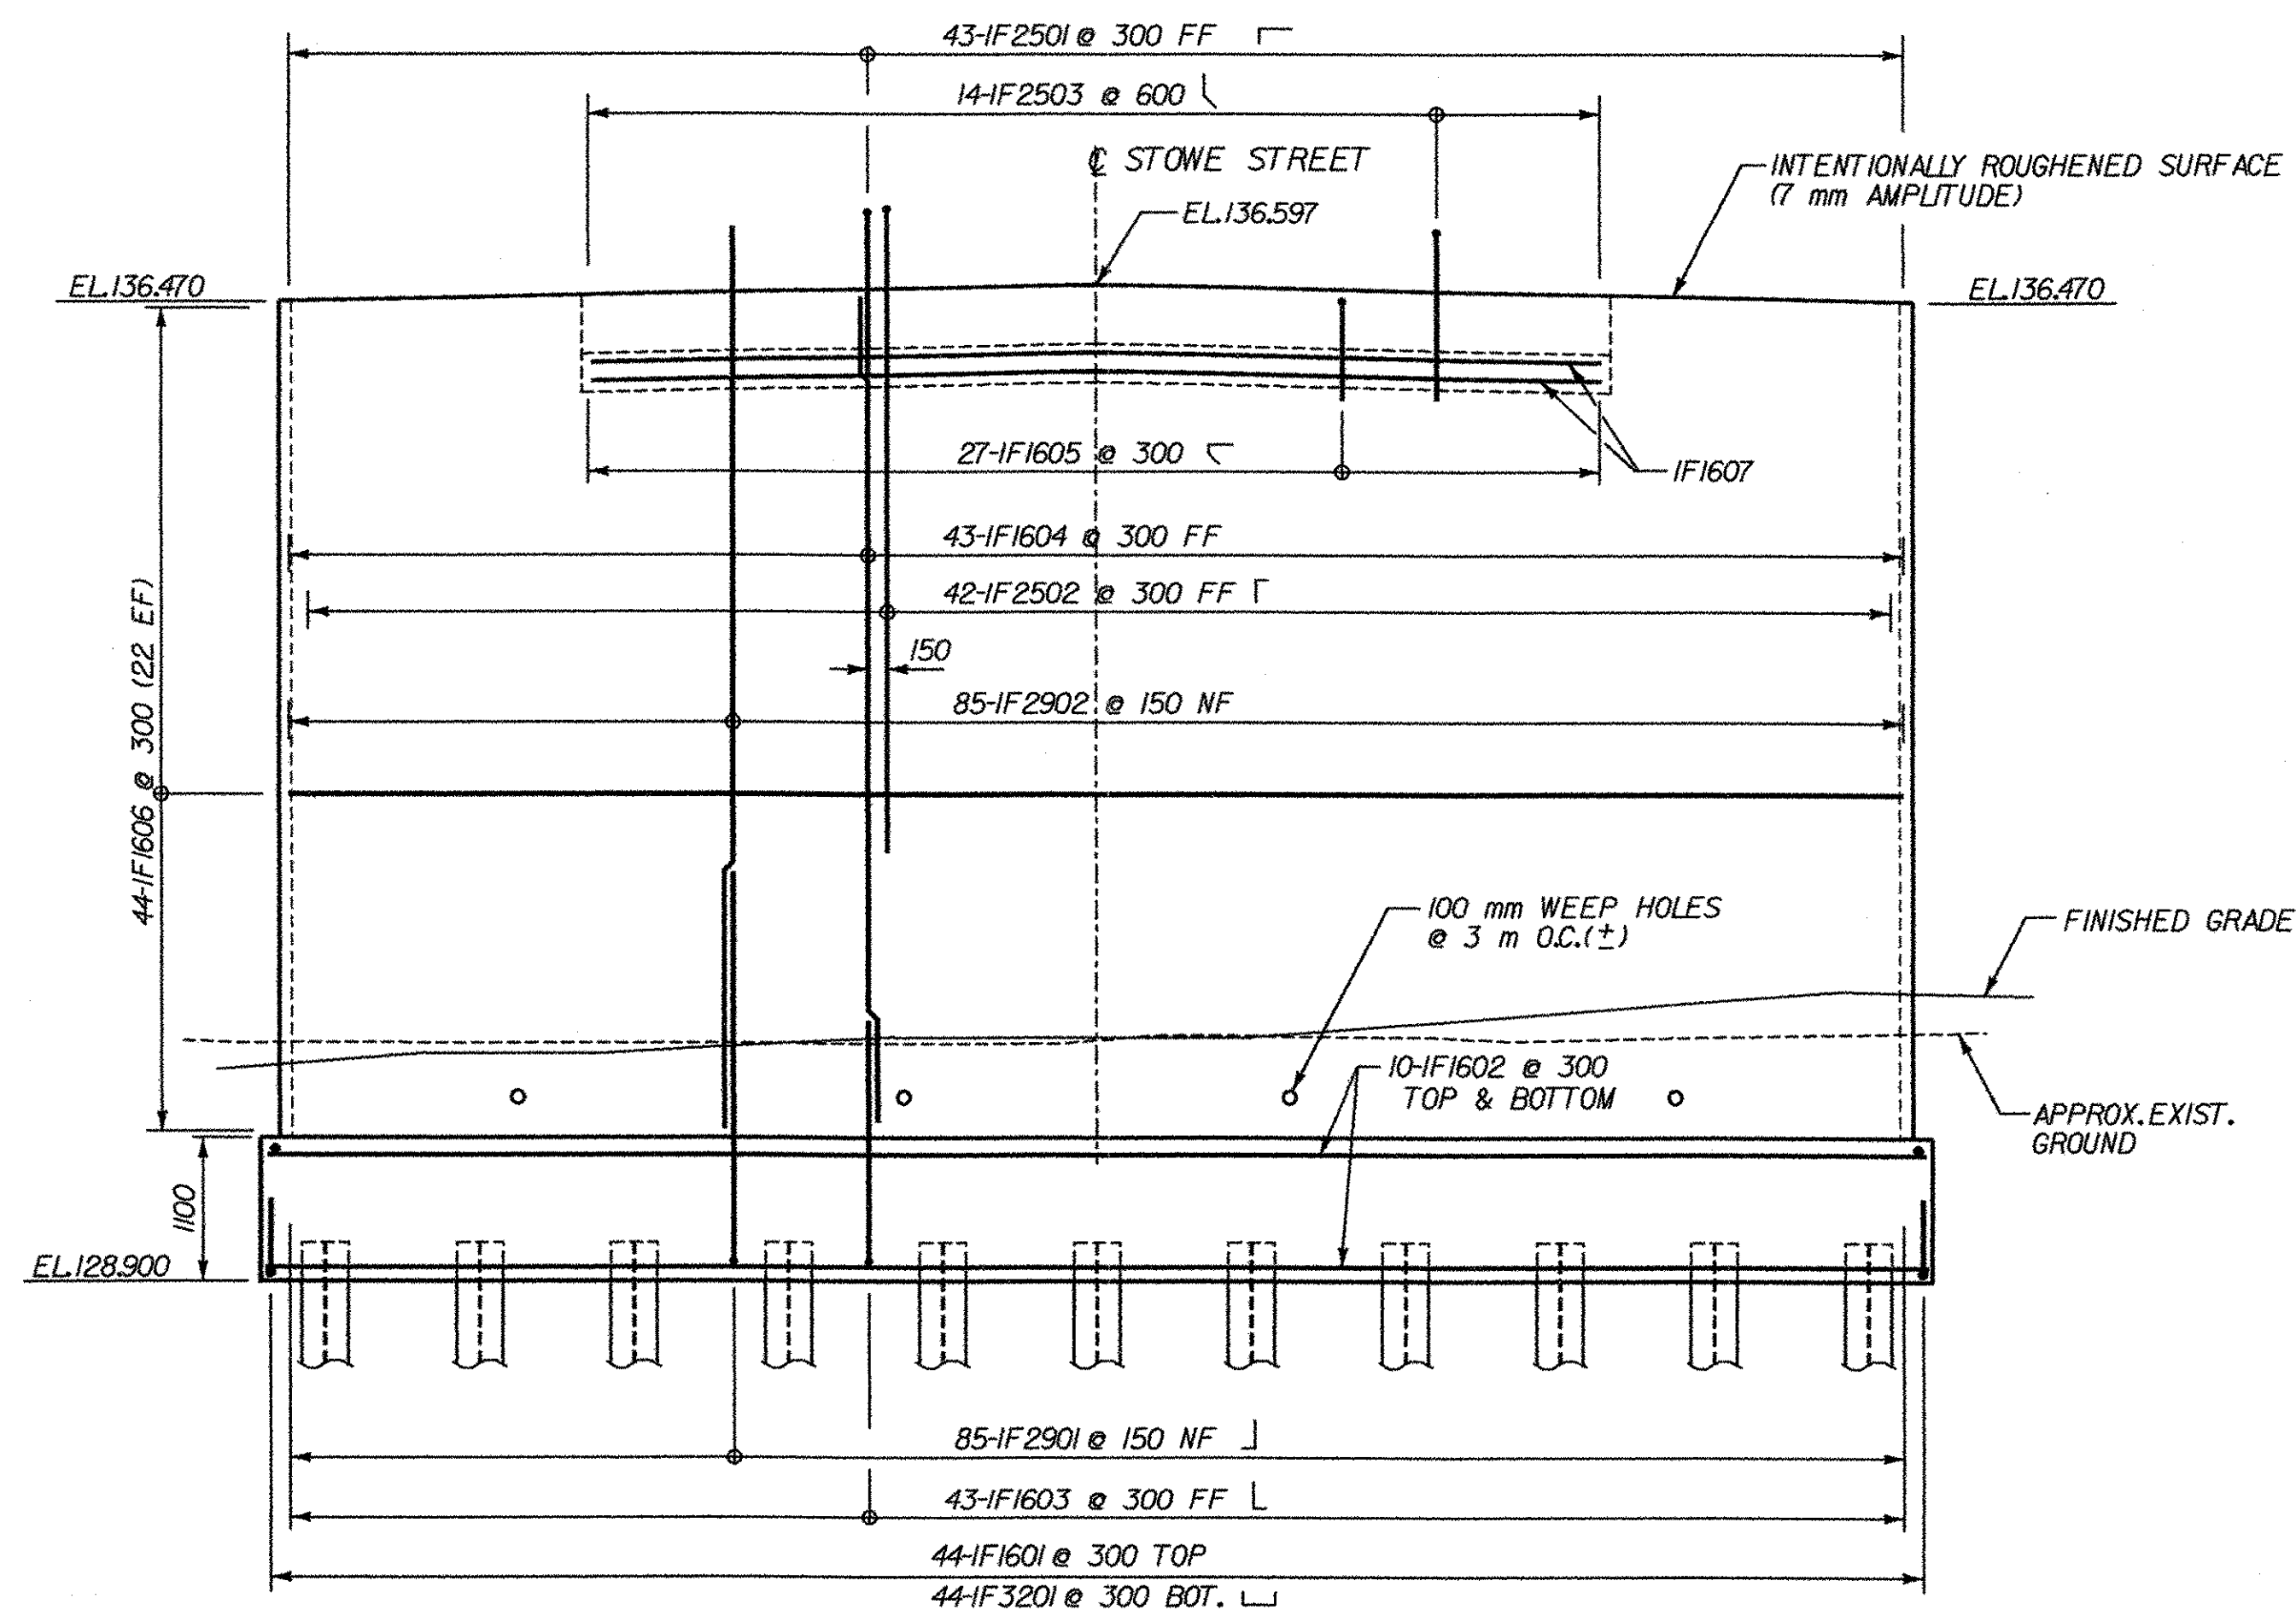

**ELEVATION**  
SCALE 1:50

**NOTE:**

- NF - NEAR FACE
  - FF - FAR FACE
  - EF - EACH FACE
  - ▲ - CUT TO FIT IN FIELD
- 75 CLR. UNLESS OTHERWISE SPECIFIED ON THE PLANS.

**STATE OF VERMONT  
AGENCY OF TRANSPORTATION**

Town Of	WATERBURY	Bridge No.	35
Highway No.		Log Sta.	
		Surv. Sta.	
STOWE ST. BRIDGE OVER CENTRAL VERMONT RAILROAD			
<b>FRAME LEG NO.1 PLAN &amp; ELEVATION</b>			
Designed By	T. KNIGHT	Drawn By	A. THIBAULT
Checked By	G. BOGUE	Date	3/03
		Bridge Design Supervisor	G. BOGUE Date 3/03
PROJECT	STOWE STREET	PROJECT NO.	BRO 1446(26)
DH CAD Filename:	...42_ssb_leg1.dgn	Plot Date:	01/26/2004
Bridge Sheet No.	BR106	Sheet	42 of 63