
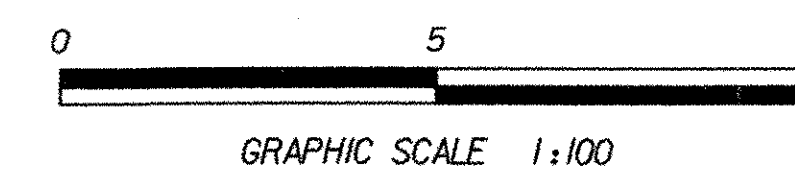
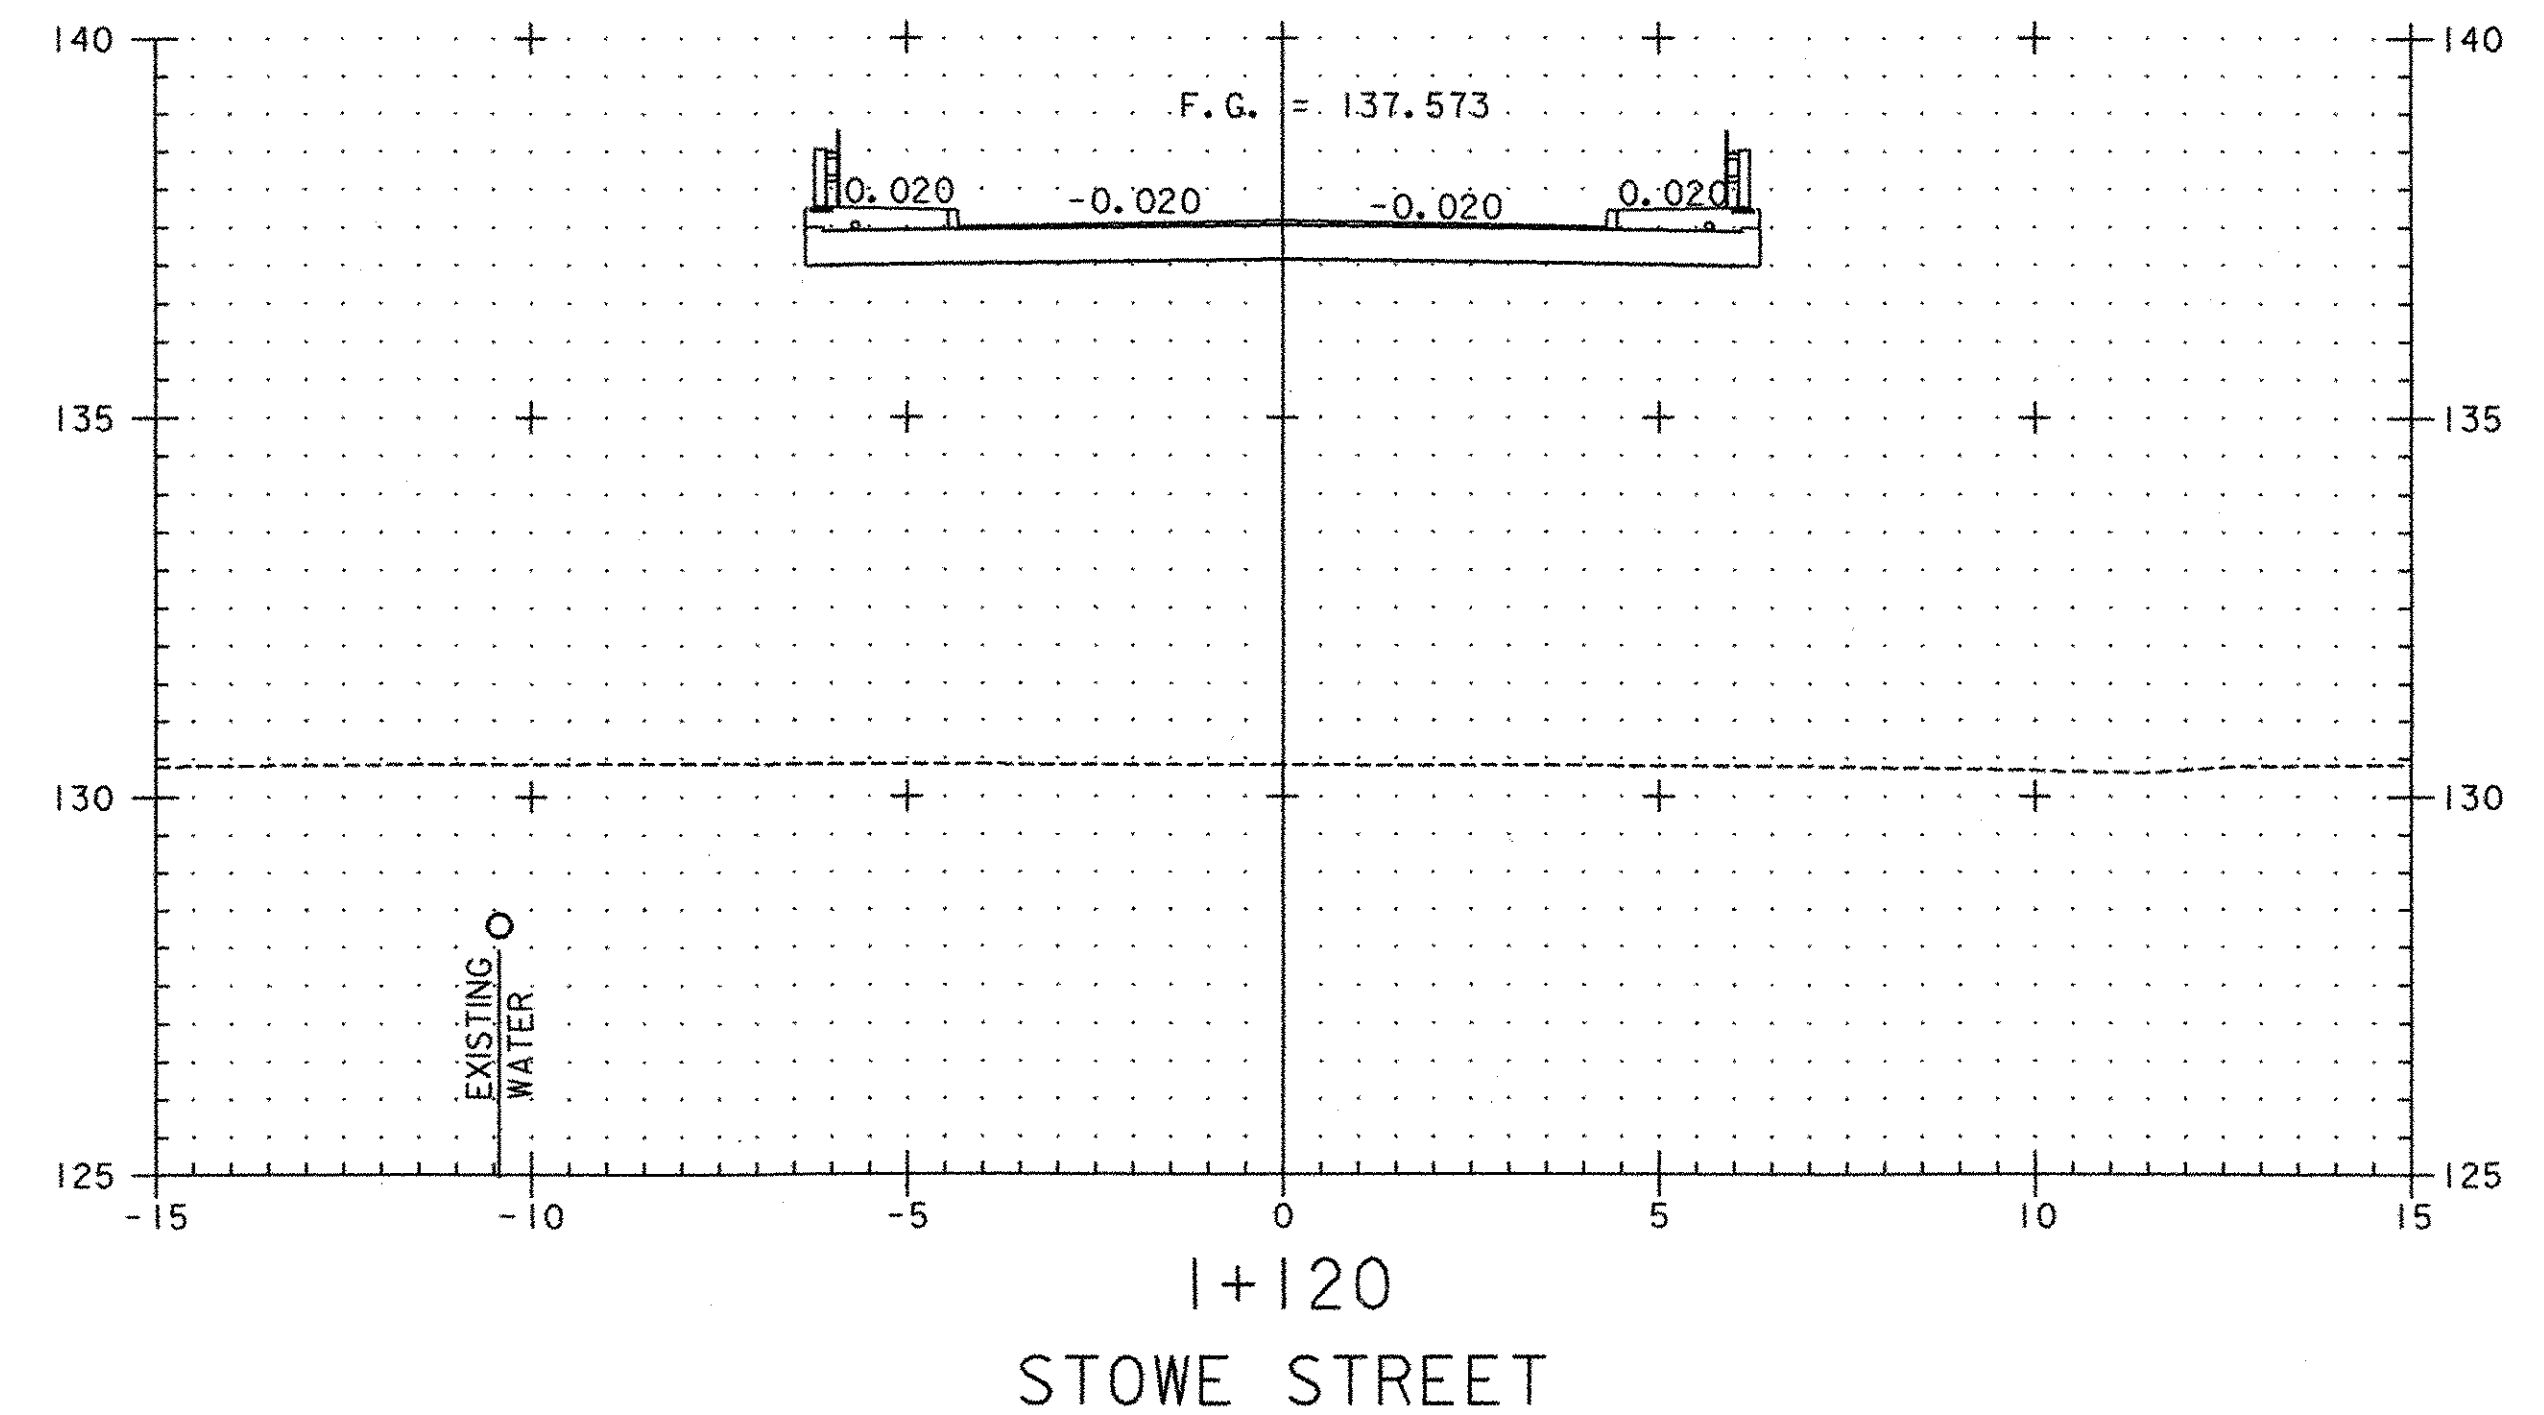
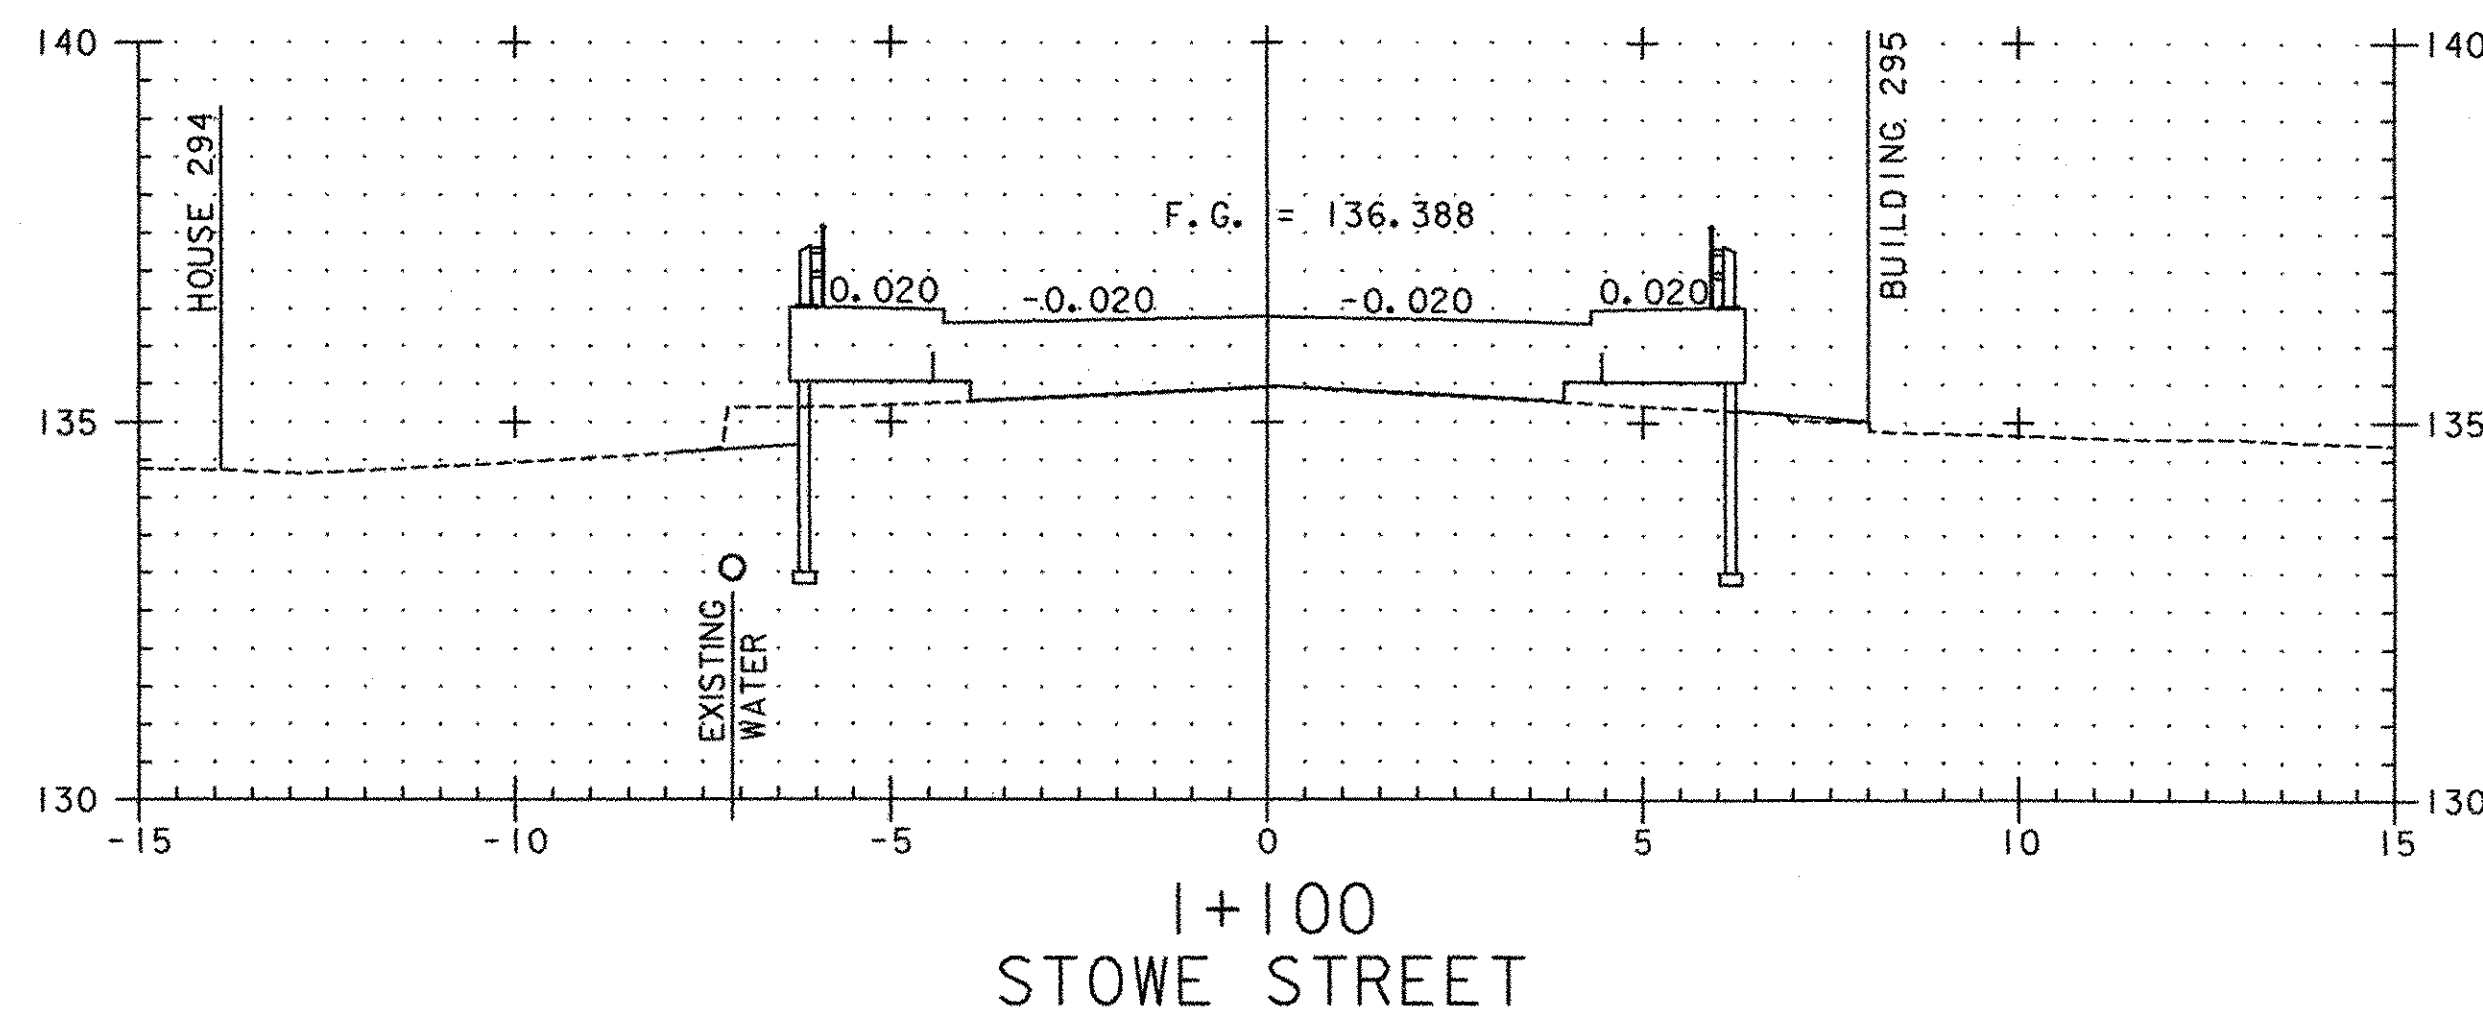
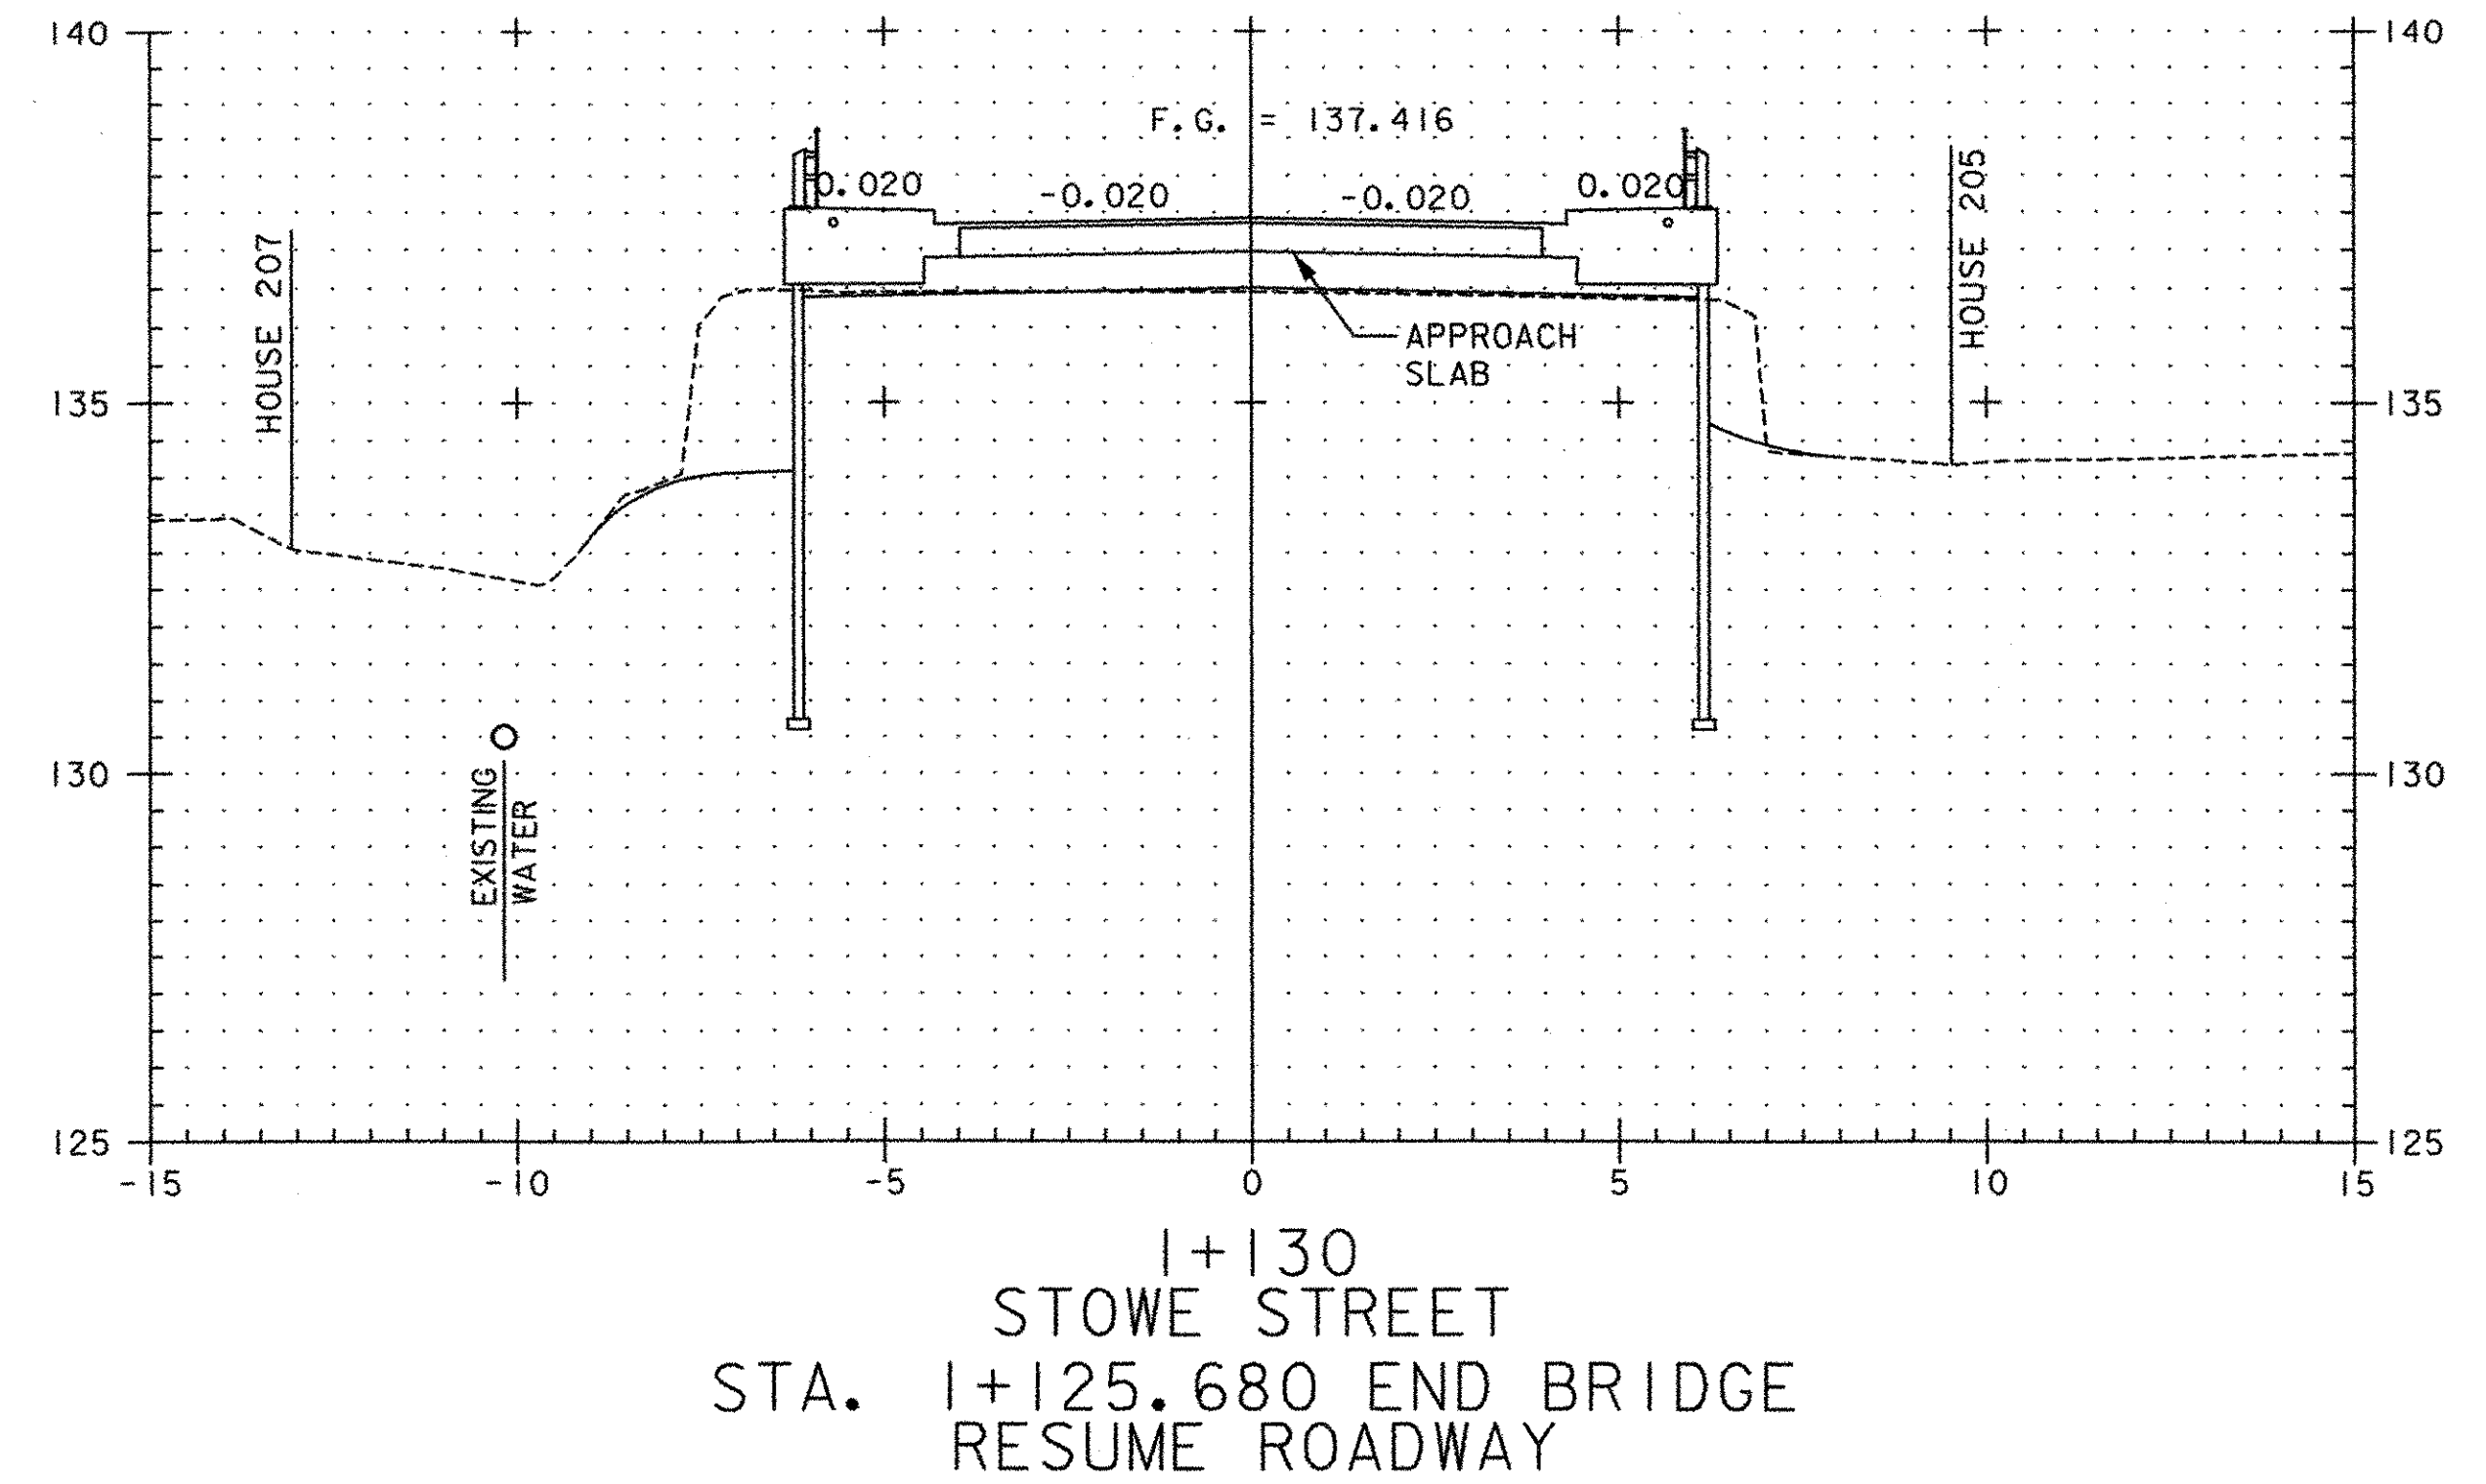


STA. 1+113.650 STOP ROADWAY  
BEGIN BRIDGE

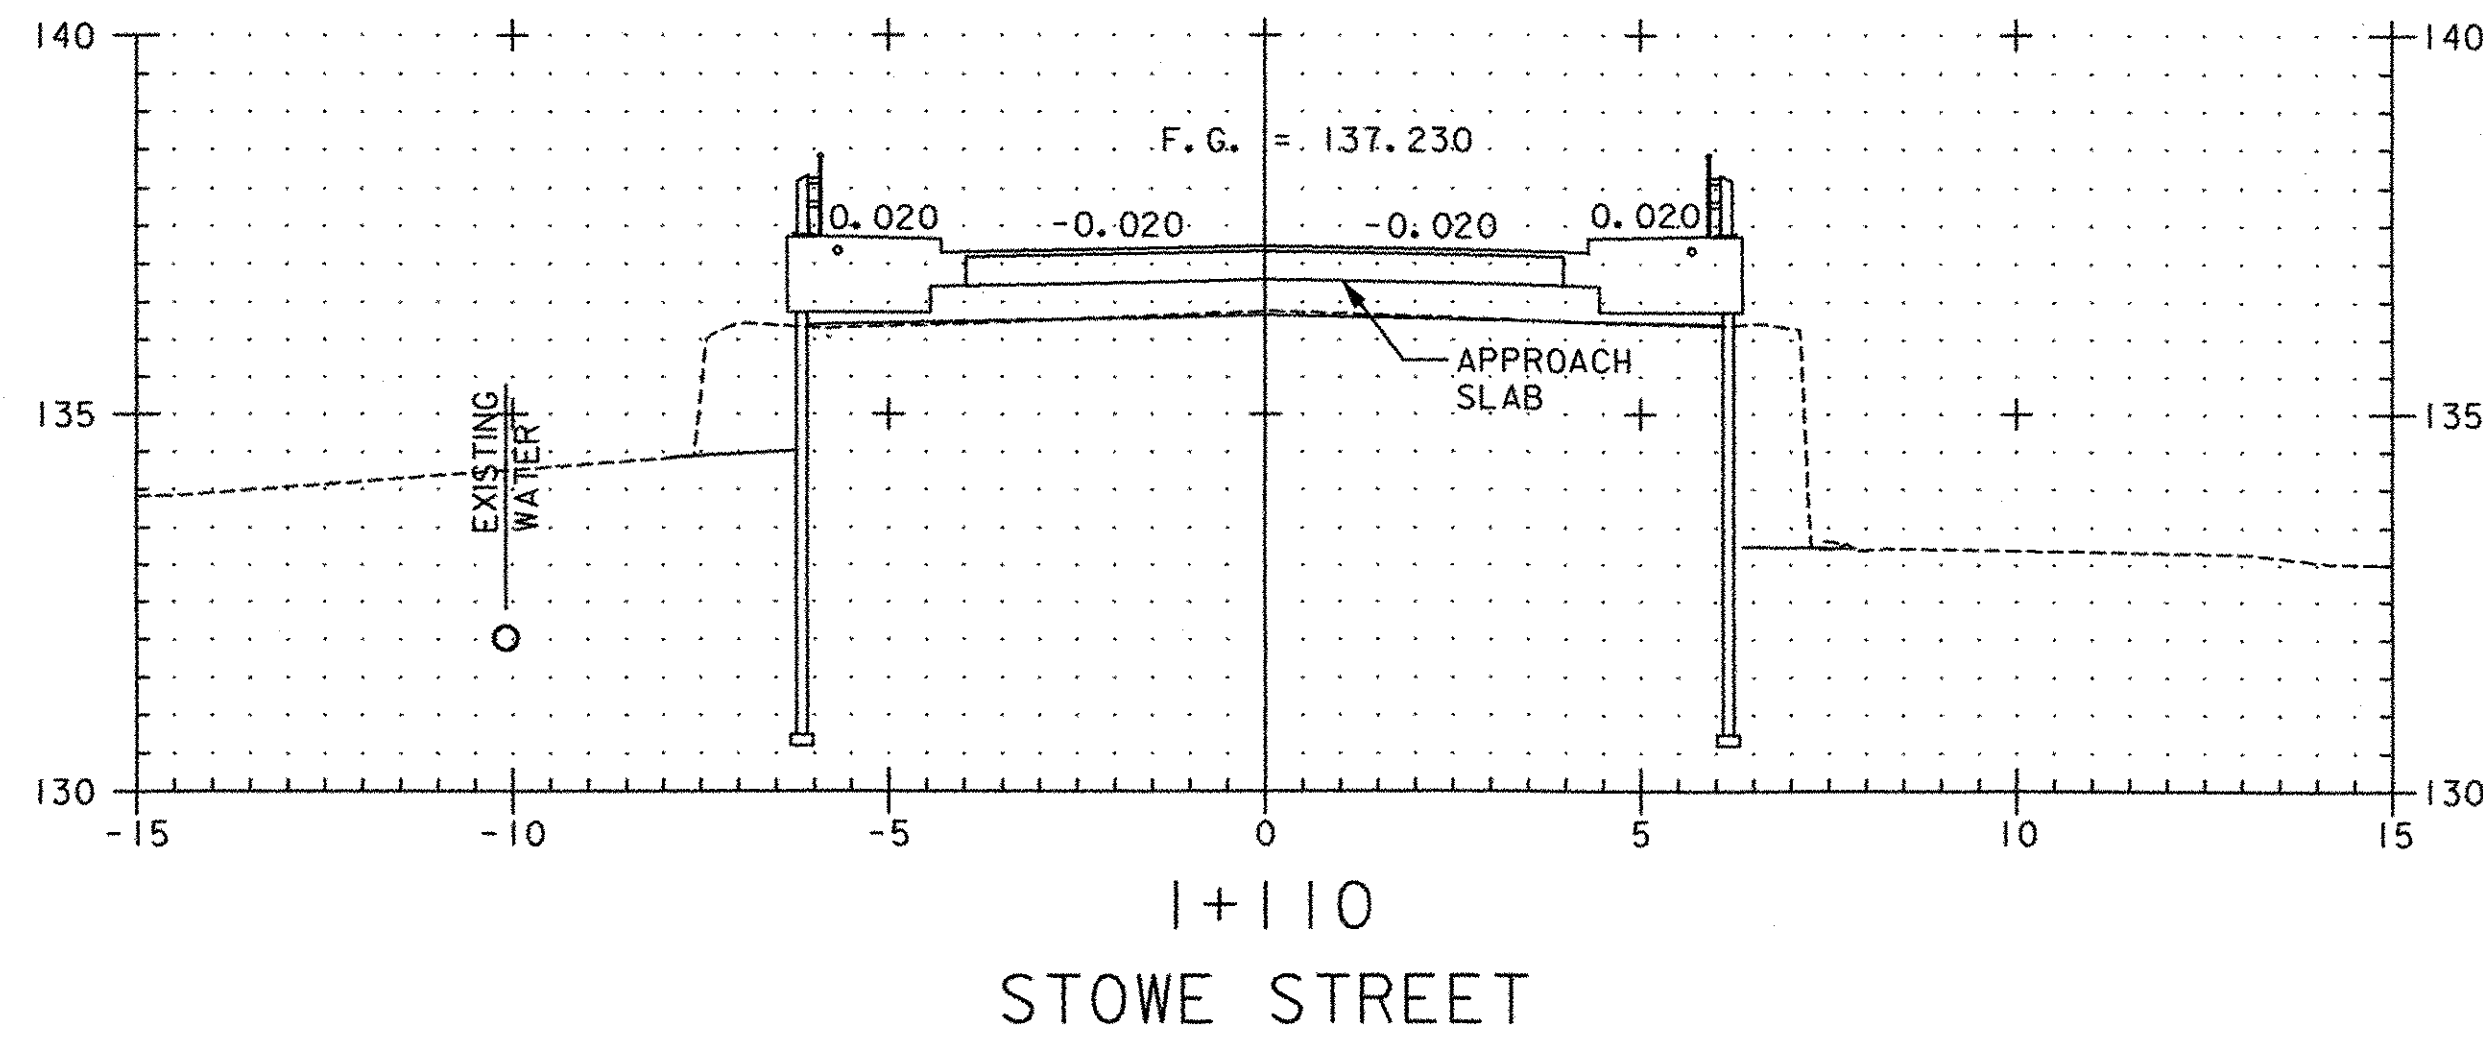

PROJECT NAME: WATERBURY  
PROJECT NUMBER: BRO 1446(26)

FILE NAME: ...49-59 sections.ptf PLOT DATE: 01/26/2004  
PROJECT LEADER: G EDWARDS/R GINGRAS DRAWN BY: M. MEILLEUR  
DESIGNED BY: M. MEILLEUR CHECKED BY: R GINGRAS  
**STOWE STREET CROSS SECTIONS** SHEET 50 OF 63