



1+210
STOWE STREET
STA. 1+201.000
END APPROACH

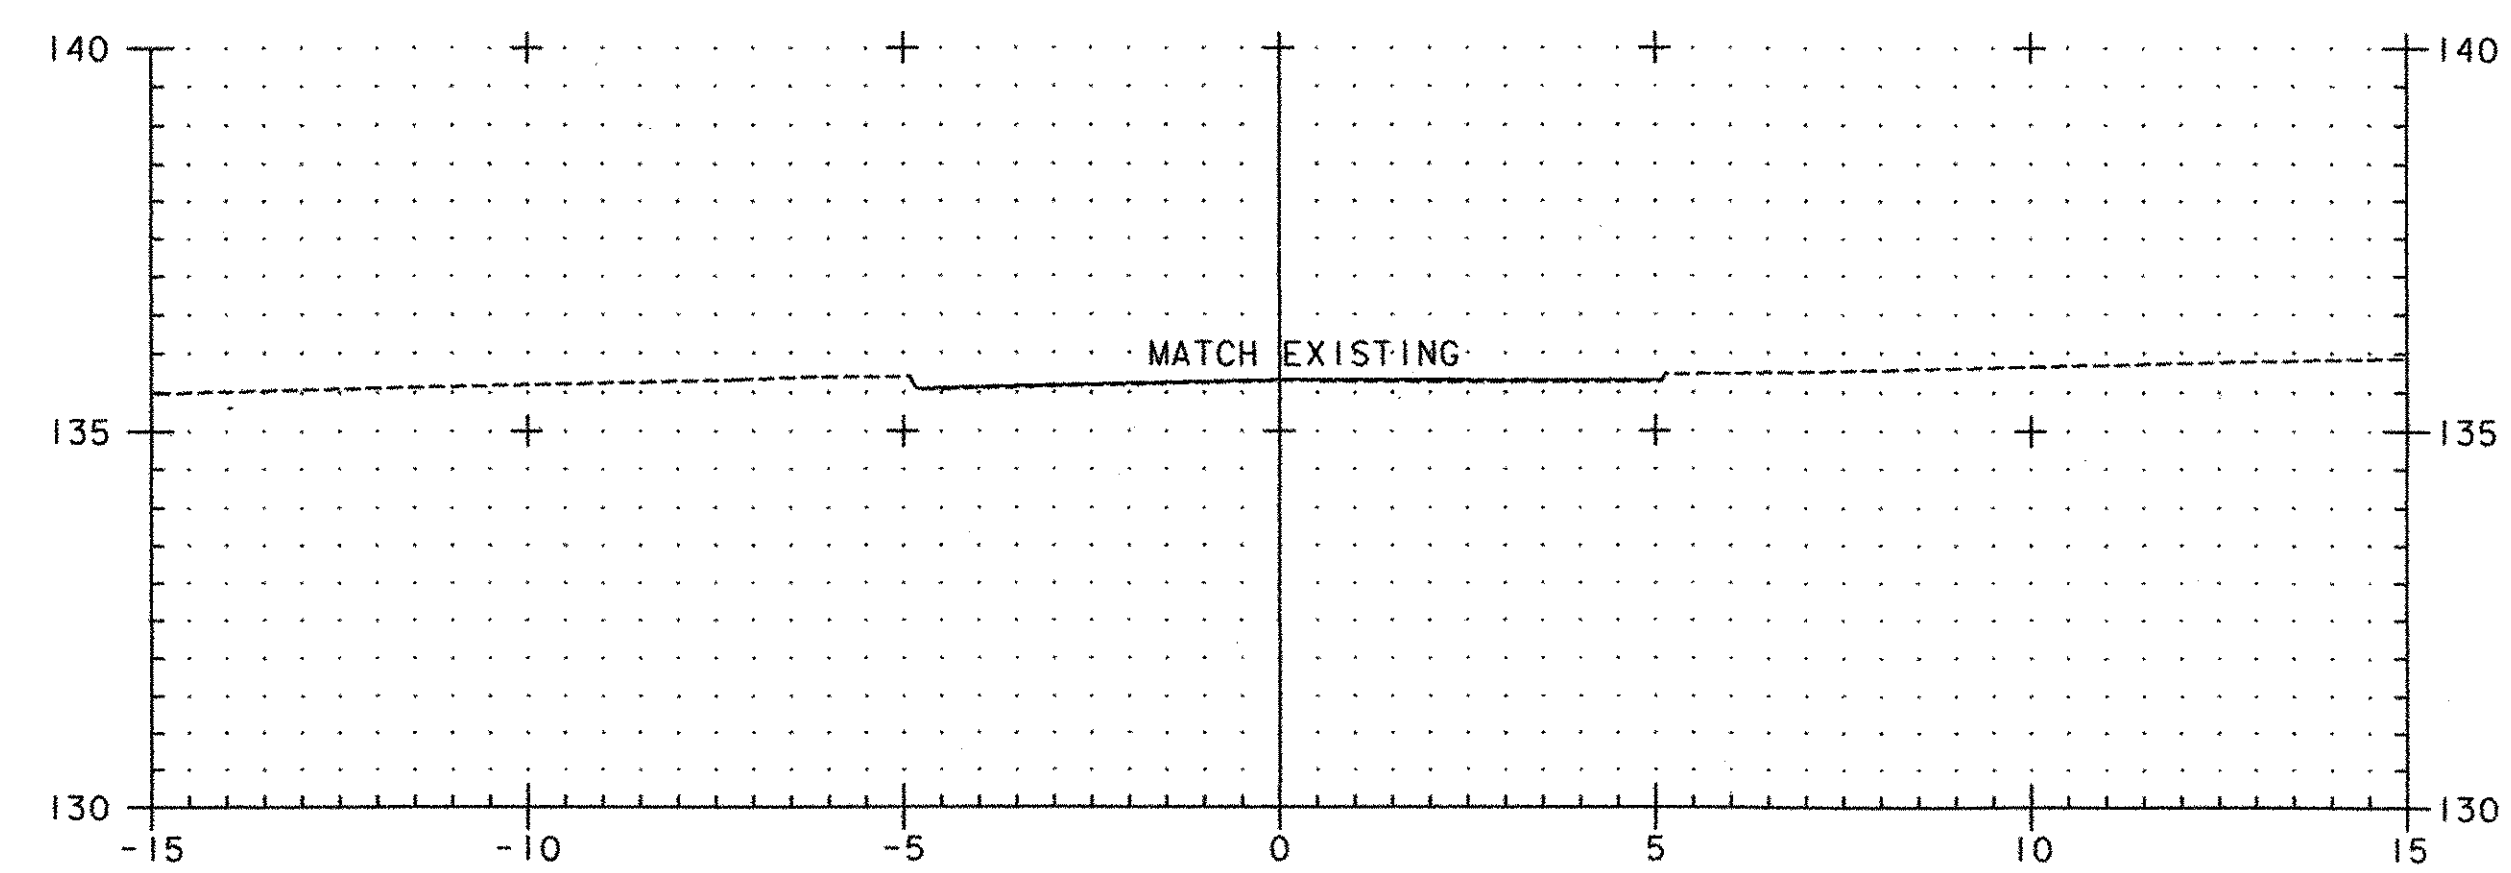

1+200
STOWE STREET

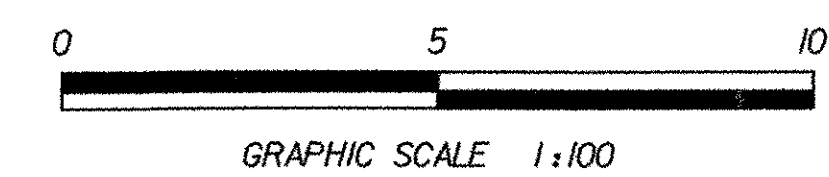

PROJECT NAME: WATERBURY
PROJECT NUMBER: BRO 1446(26)

FILE NAME: ...49-59 sections.ptf	PLOT DATE: 01/26/2004
PROJECT LEADER: G EDWARDS/R GINGRAS	DRAWN BY: M. MEILLEUR
DESIGNED BY: M. MEILLEUR	CHECKED BY: R GINGRAS
STOWE STREET CROSS SECTIONS	SHEET 52 OF 63