




RR 10+320  
RAILROAD

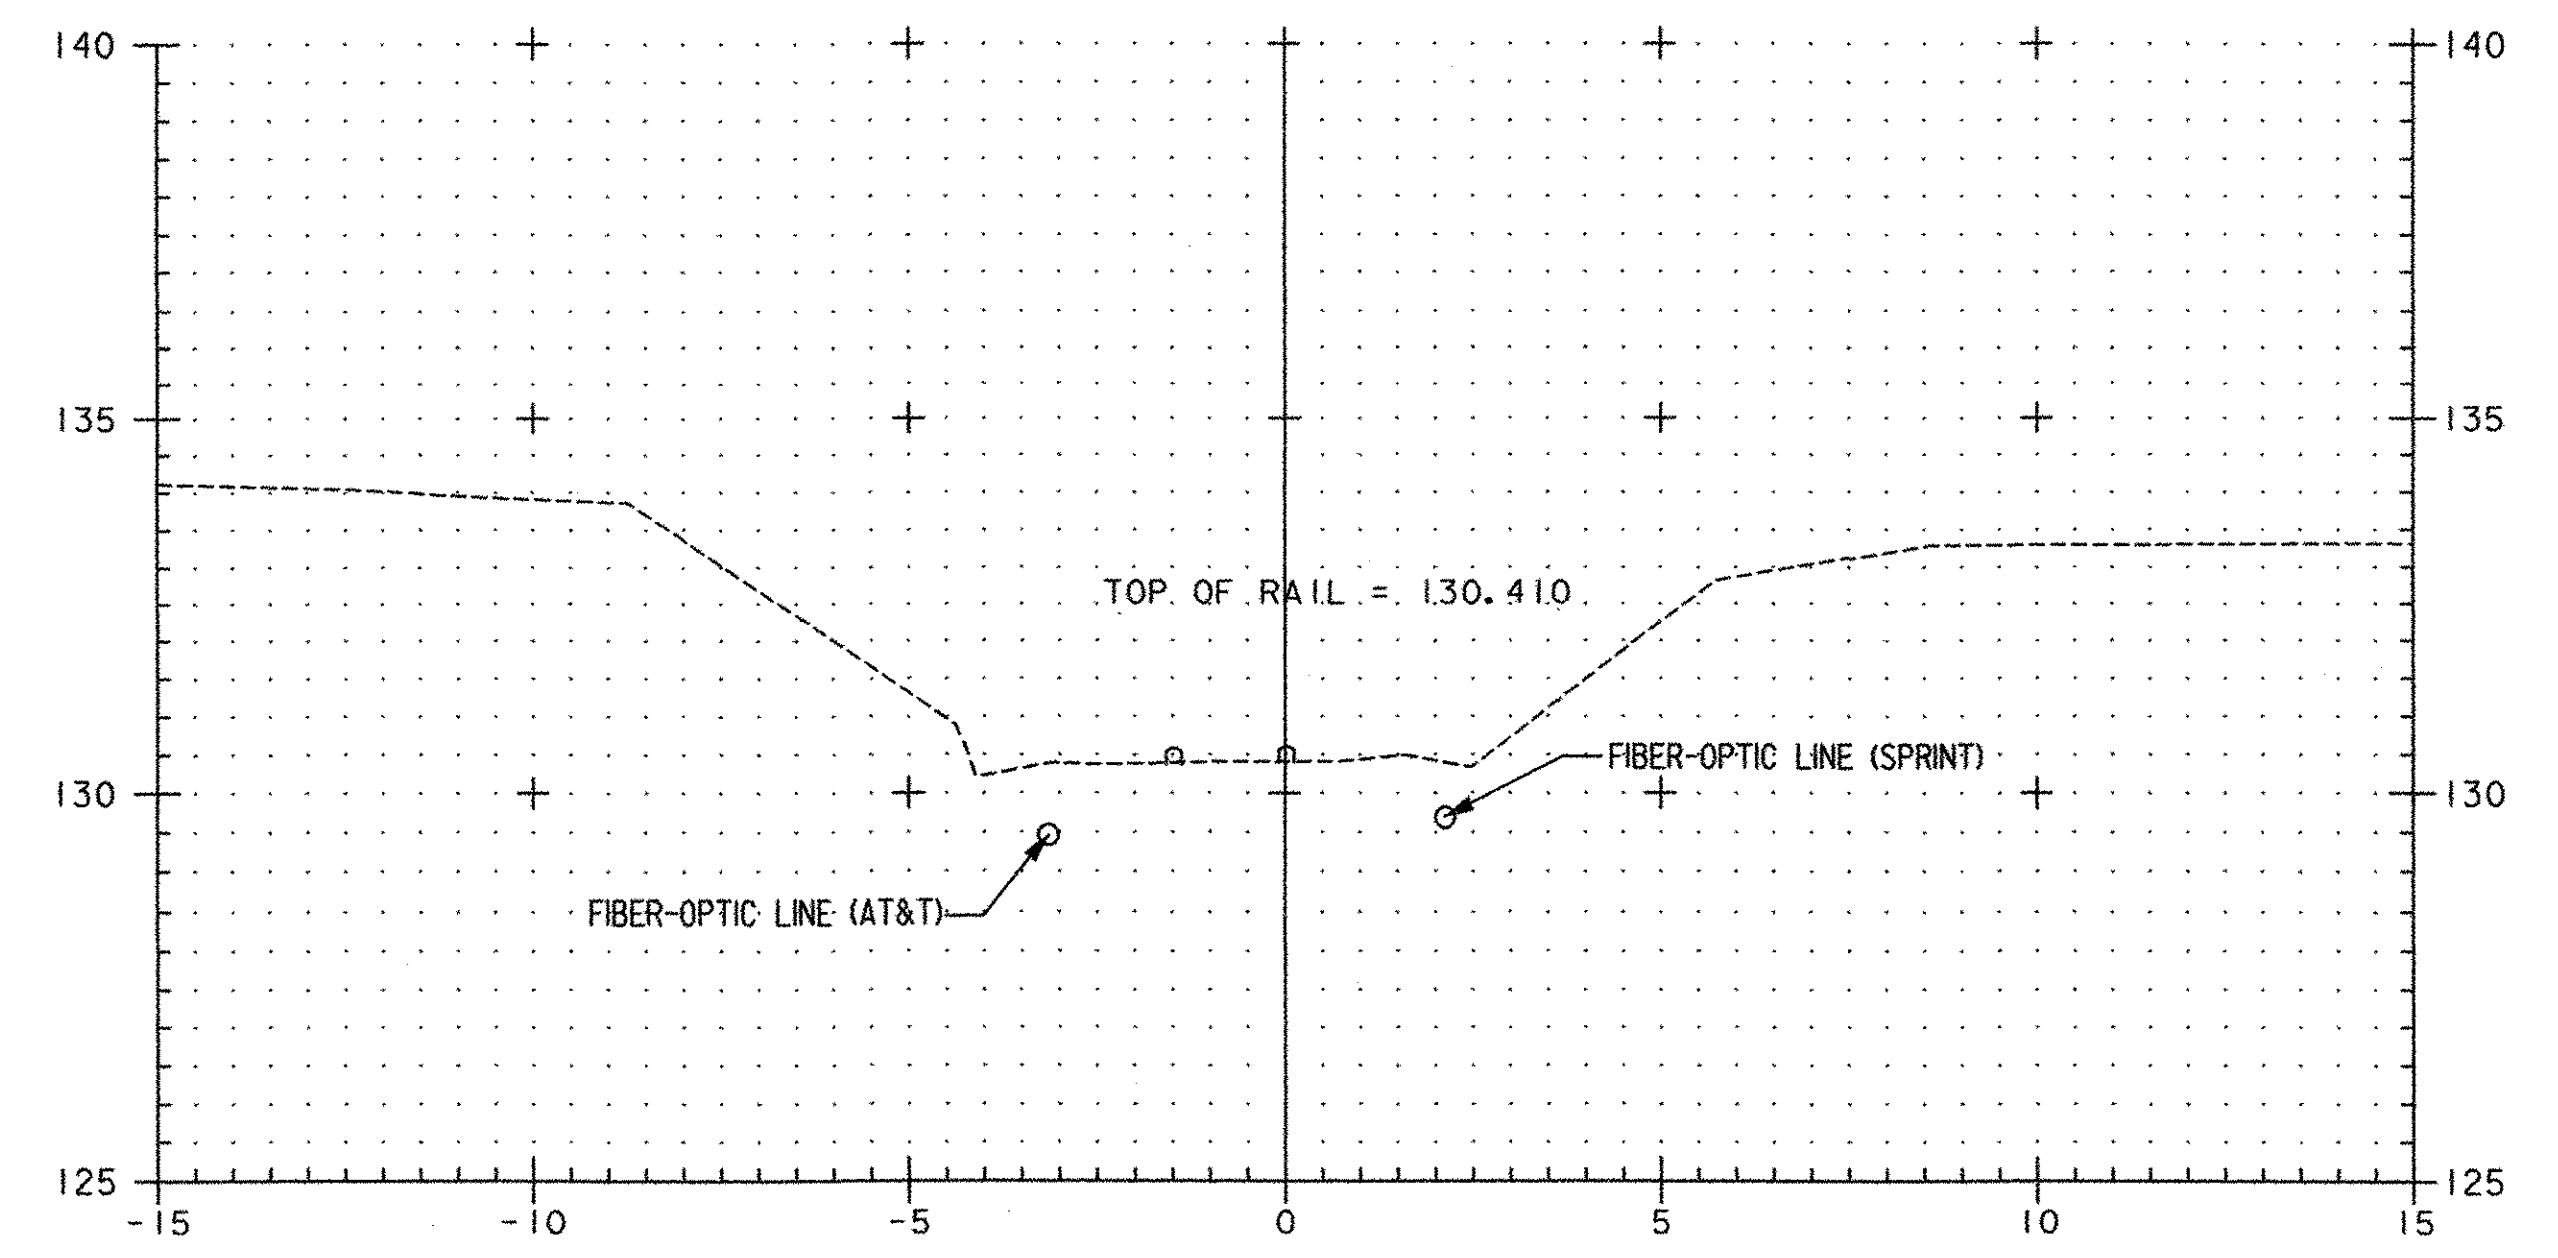


RR 10+340  
RAILROAD

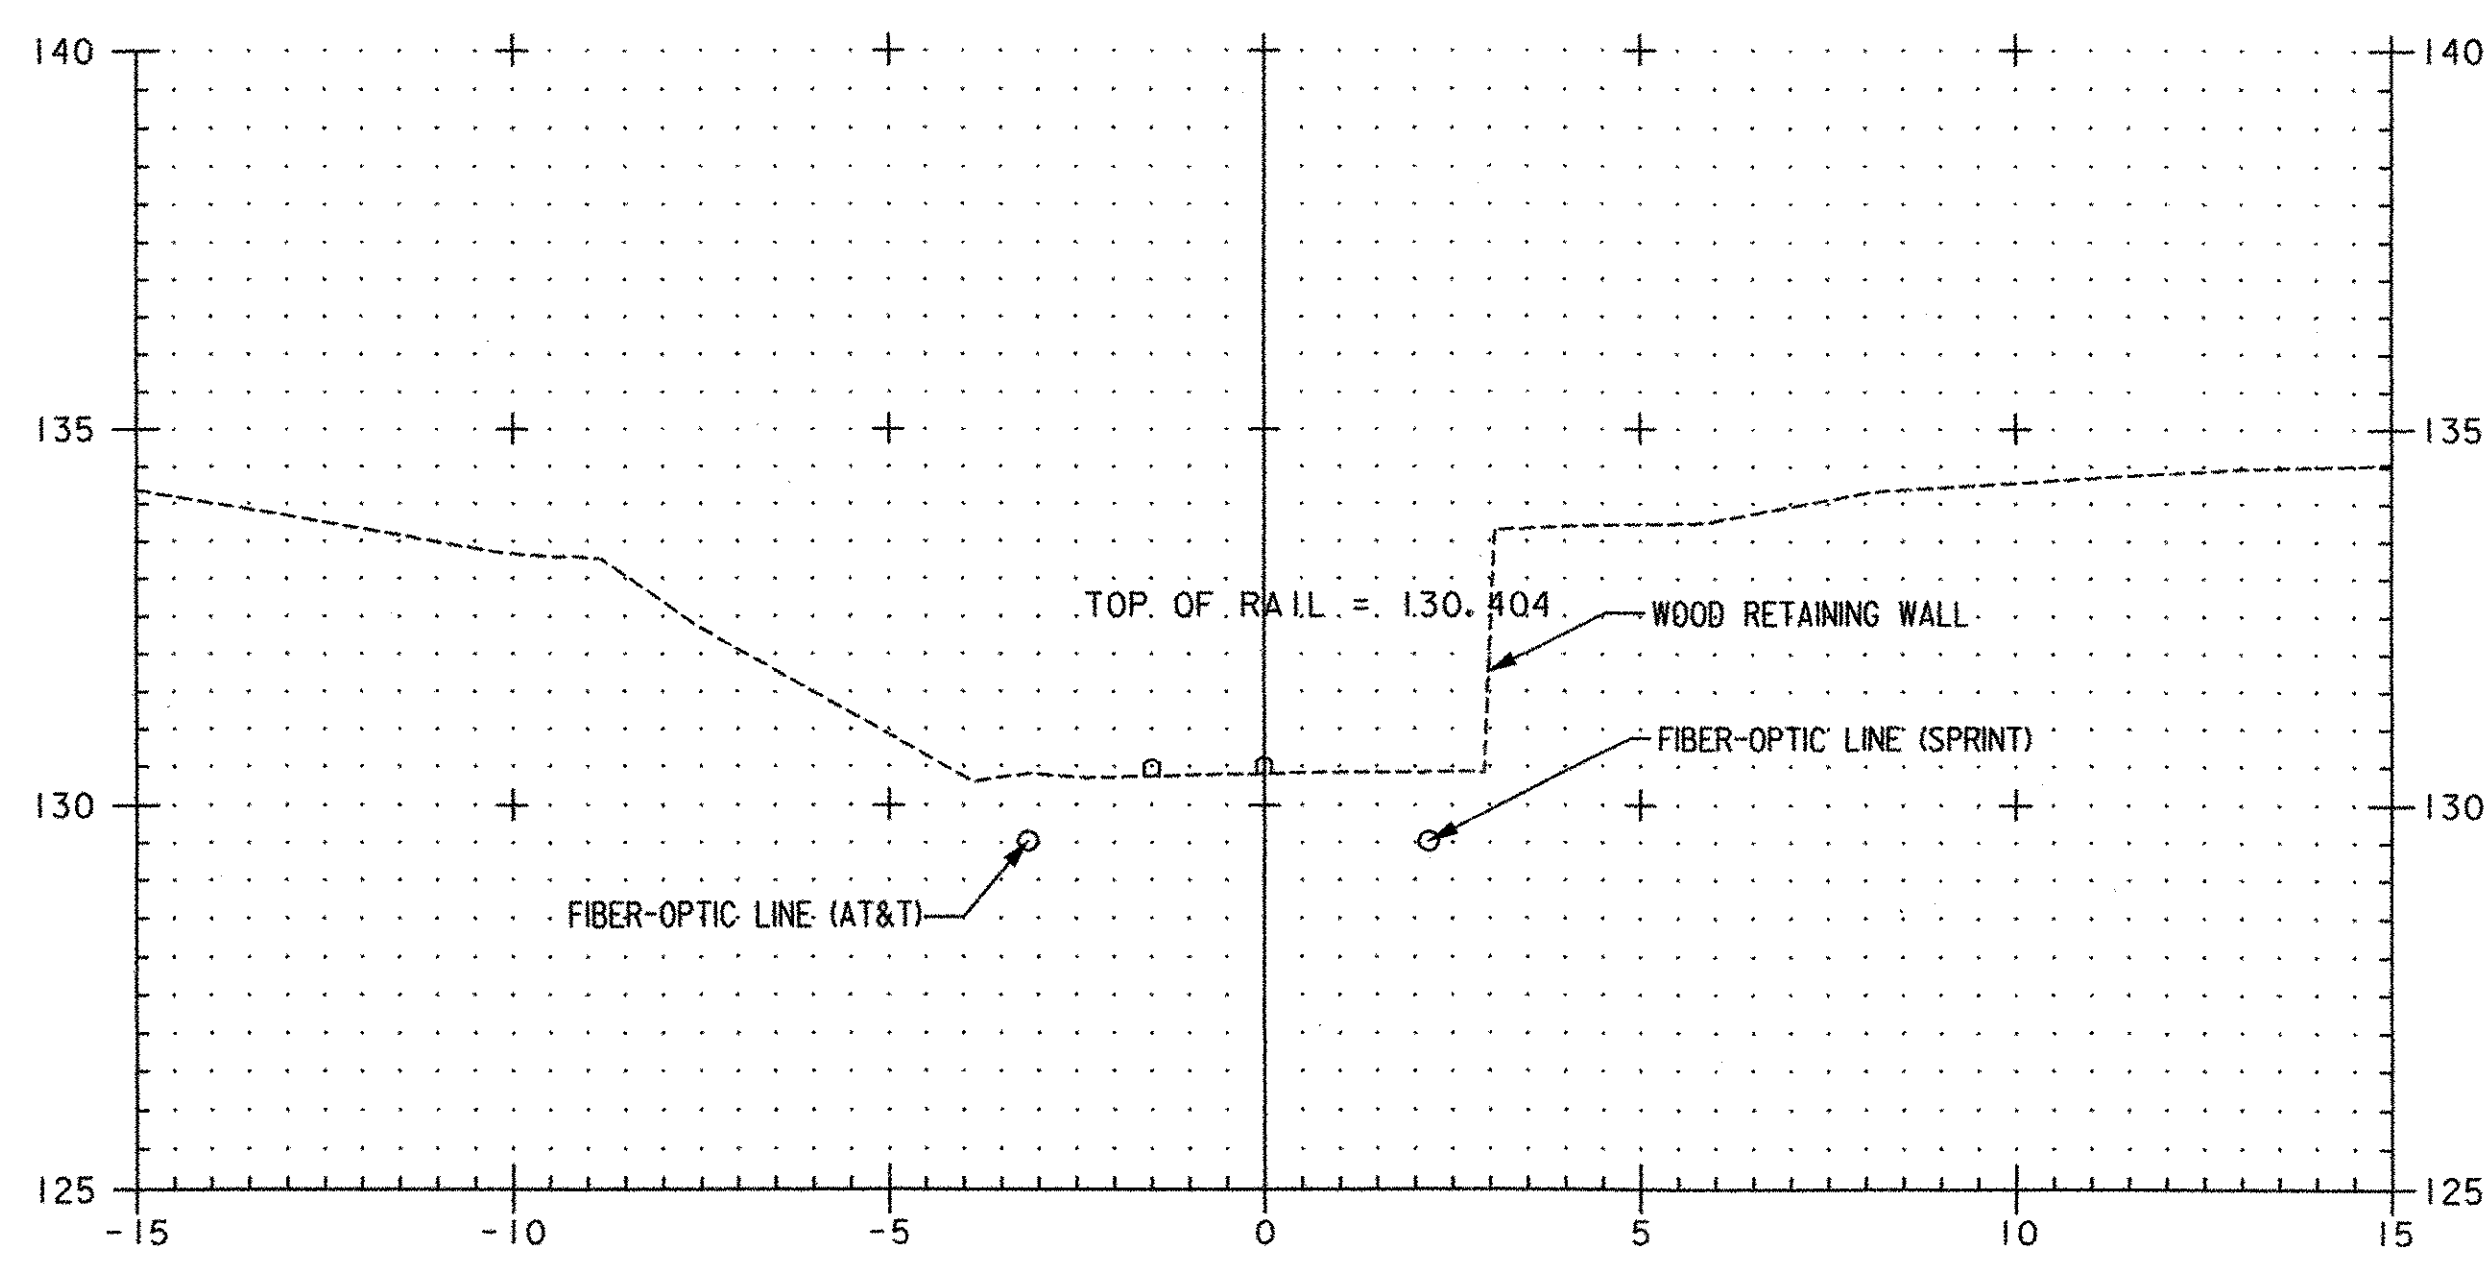

RR 10+310  
RAILROAD

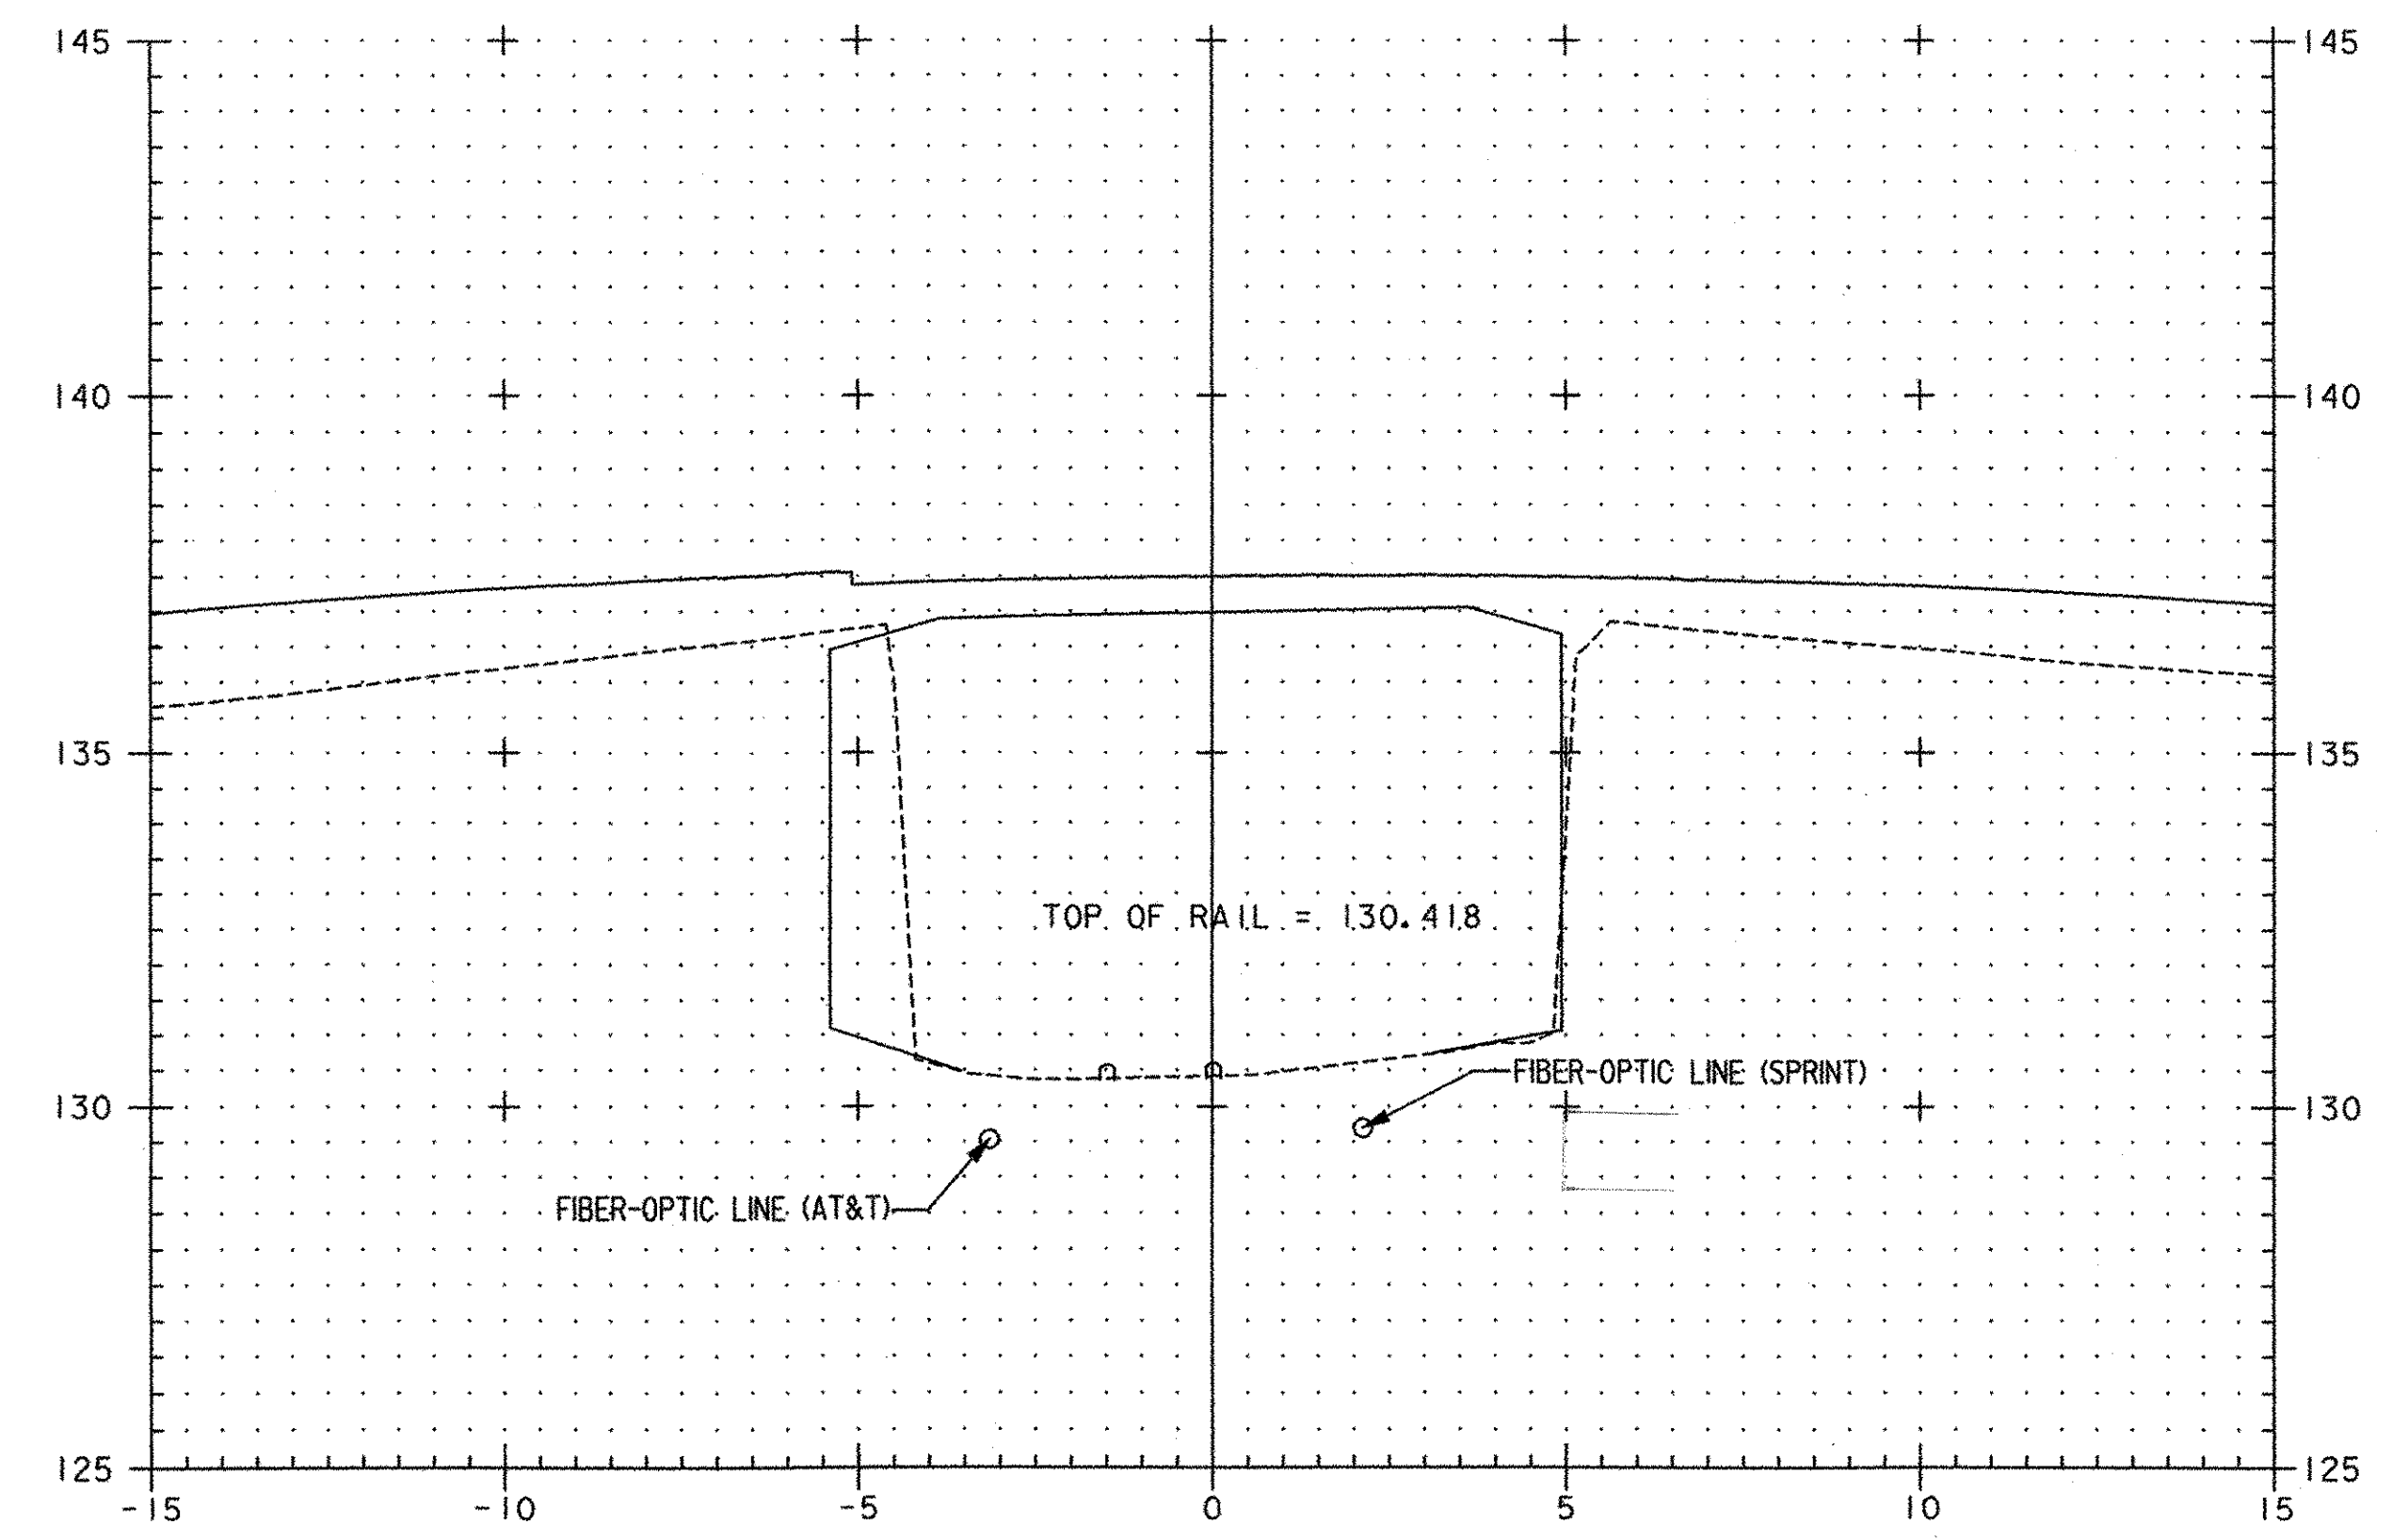

RR 10+330  
RAILROAD

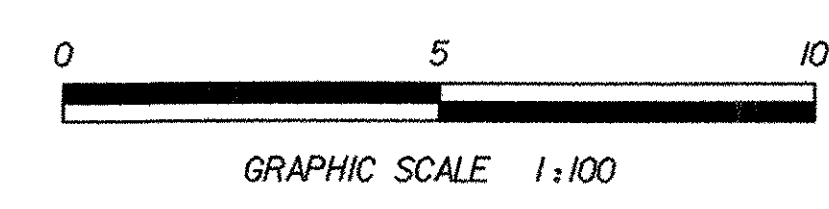

PROJECT NAME:	WATERBURY	
PROJECT NUMBER:	BRO 1446(26)	
FILE NAME: ...49-59 sections.ptf	PROJECT LEADER: G EDWARDS/R GINGRAS	PLOT DATE: 01/26/2004
DESIGNED BY: M. MEILLEUR	DRAWN BY: M. MEILLEUR	CHECKED BY: R GINGRAS
<b>RAILROAD CROSS SECTIONS</b>		SHEET 59 OF 63

D:\01\11\146\04\59\sec1106a.plt 01/26/2004 09:18:26 AM