


### WATER MAIN PROFILE

SCALE HORZ. 1:250  
VERT. 1:5

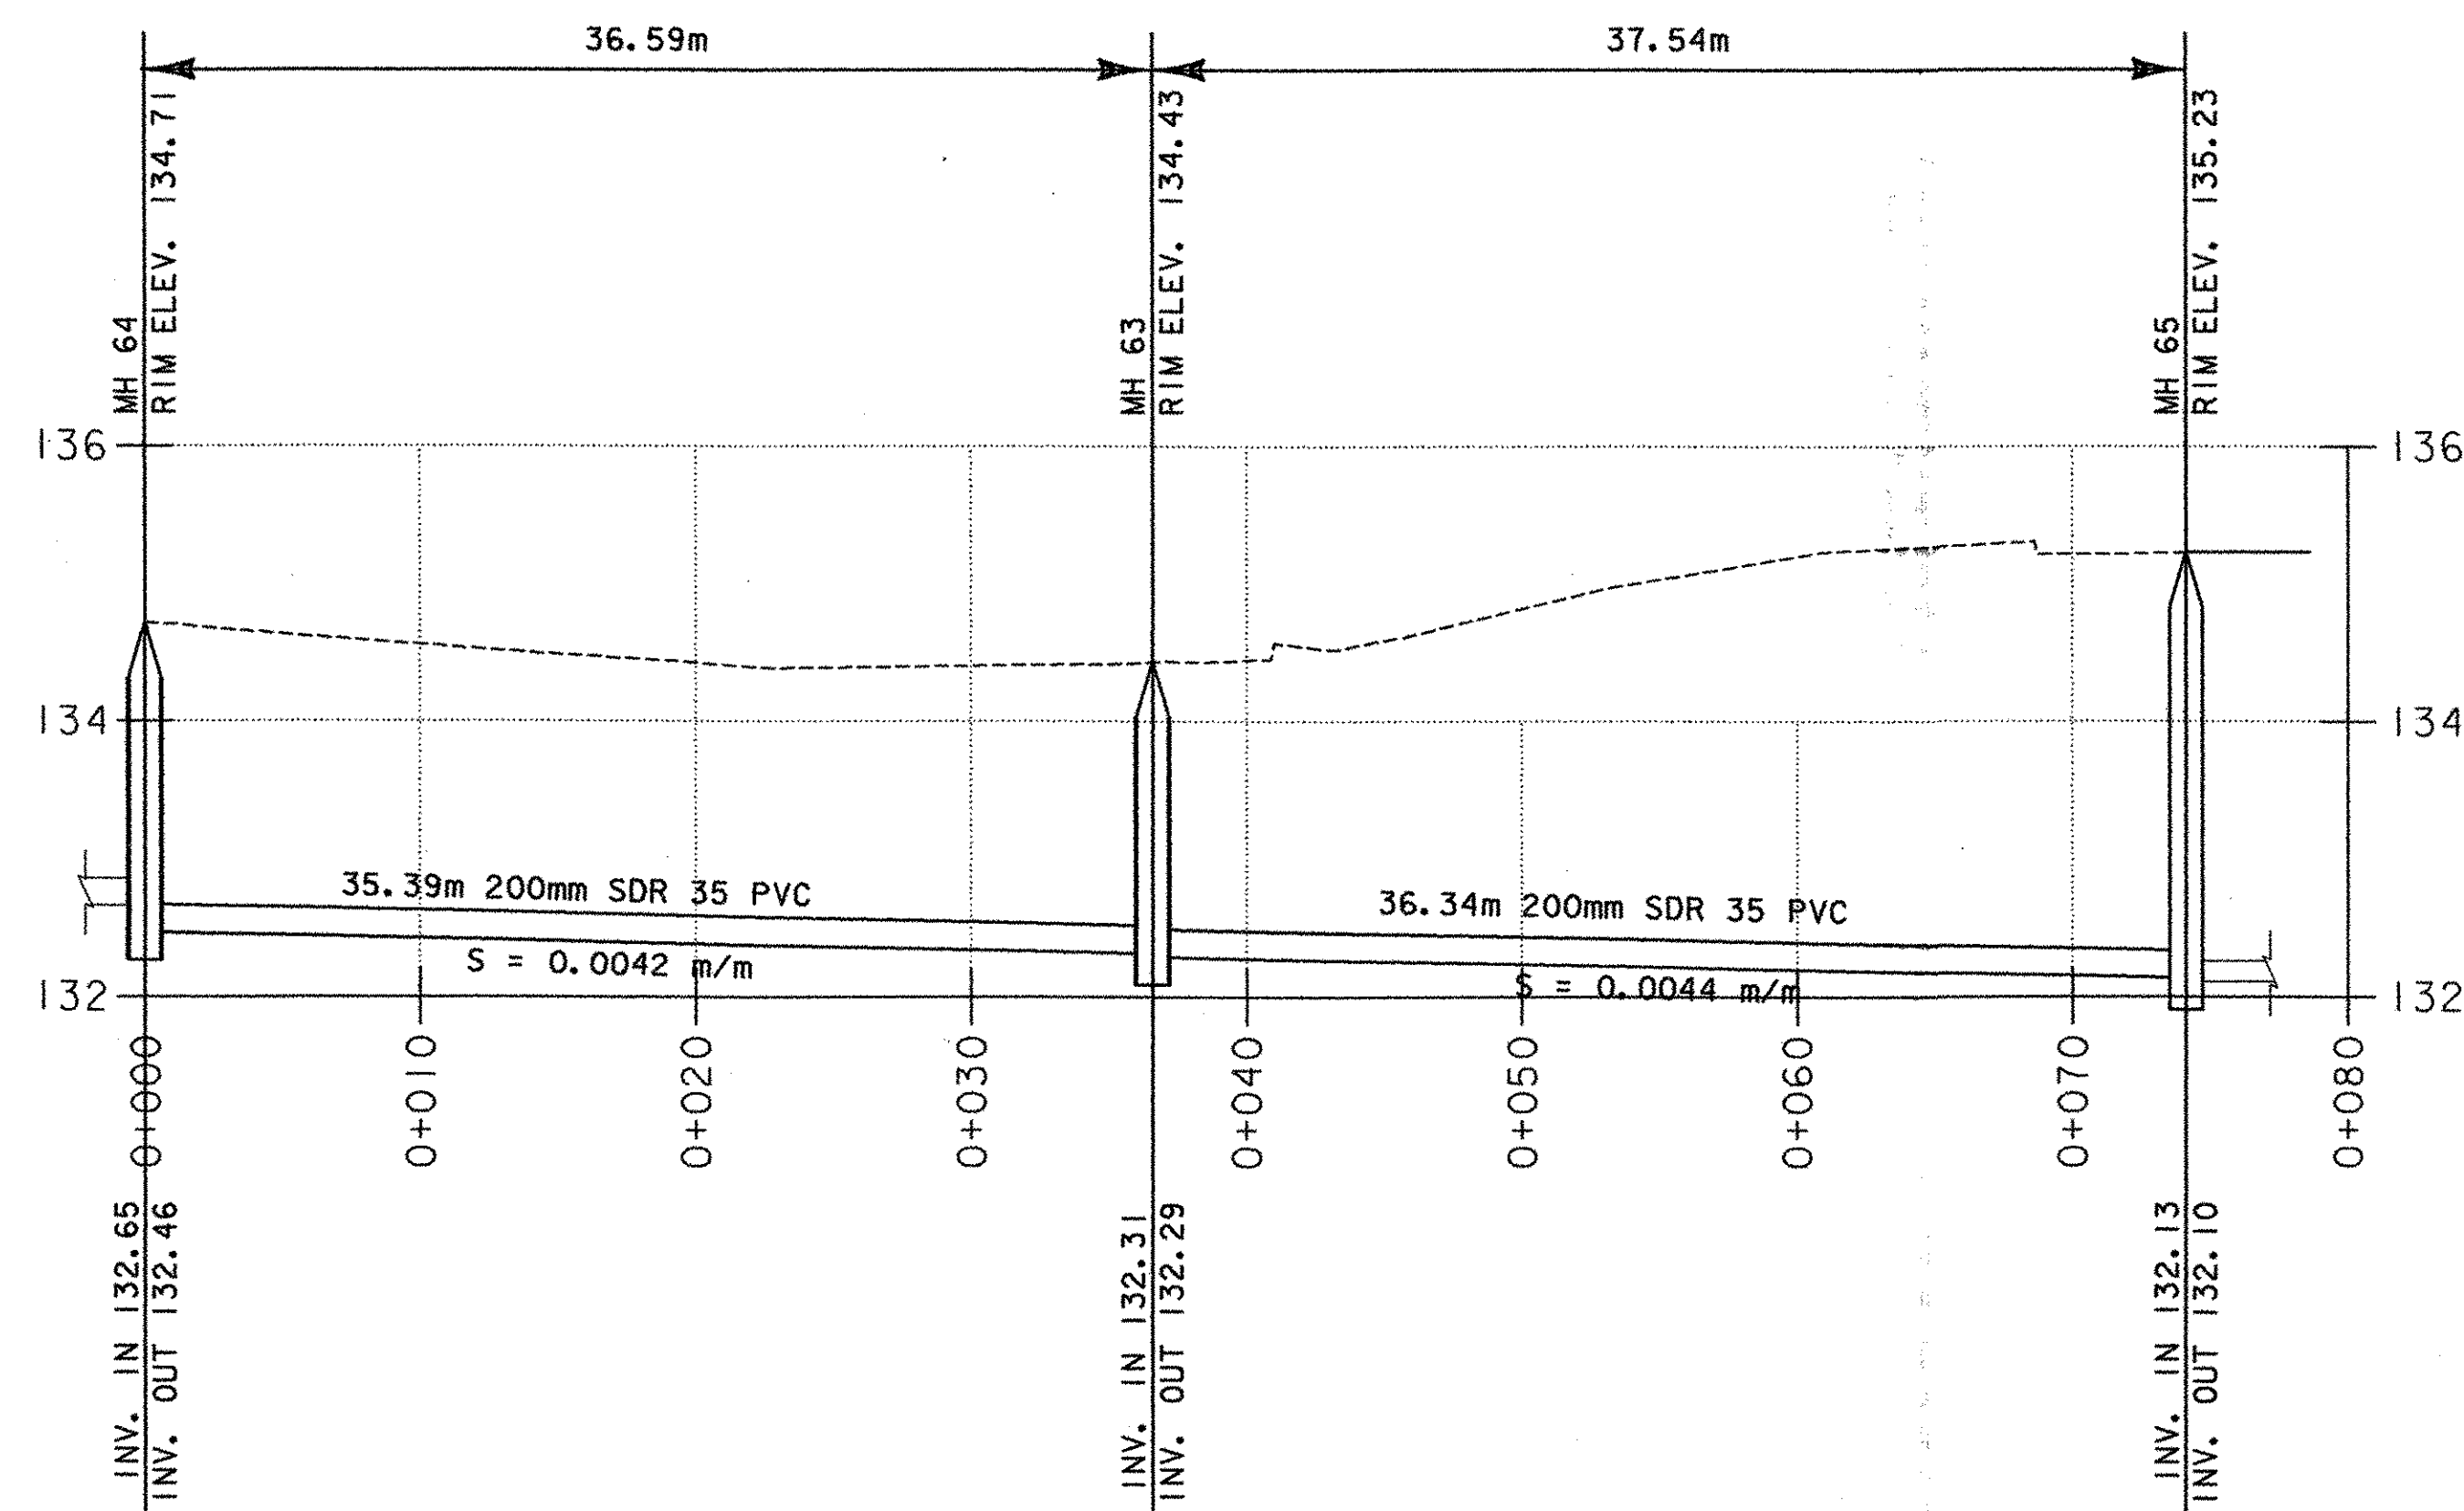

### SANITARY SEWER PROFILE

SCALE HORZ. 1:250  
VERT. 1:5



PROJECT NAME: WATERBURY  
PROJECT NUMBER: BRO 1446(26)

FILE NAME: ...61-Utility Profiles.pxf  
PROJECT LEADER: A.T. RICE  
DESIGNED BY: A.T. RICE

PLOT DATE: 01/27/2004  
DRAWN BY: B.L. BAKER  
CHECKED BY: A.T. RICE

**WATER AND SEWER PROFILES**

61 OF 63