

6.112
- 70
6.042
+ 650
6.692


150
300

6.612
- 70
6.542
+ 650
7.192

150
300

6.112
500
6.800

GRAPHIC SCALE

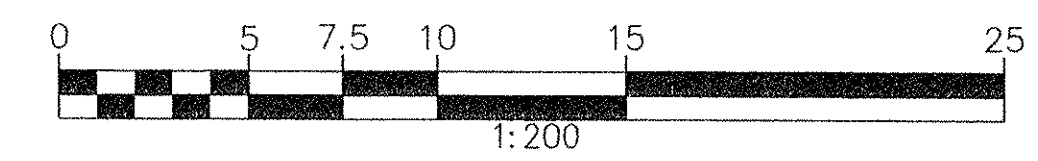

NOTE TO CONTRACTOR / VT AOT:
 AS PER VTRANS COMMENTS, THE DRAINAGE STRUCTURE OFFSET INFORMATION HAS BEEN PROVIDED. HOWEVER, DUE TO FIELD TOLERANCES IN PLACING DRAINAGE STRUCTURES, THE MSE WALL PANELS MAY BE FIELD CUT IN ORDER TO ALLOW FOR PIPES TO PASS THRU THE WALL. ANY REBAR EXPOSED DUE TO SAW CUTTING SHALL BE PAINTED WITH TWO COATS OF VTRANS APPROVED EPOXY PAINT.
 IN INSTANCES WHERE THE TIE STRIPS ARE REMOVED DUE TO THE SAW CUT, OR INSUFFICIENT CLEARANCE FROM THE EDGE OF CONCRETE TO THE EDGE OF TIE STRIPS (LESS THAN 3") IS PROVIDED, THE CONTRACTOR SHALL INSTALL CLIP ANGLES AS SHOWN ON THE CLIP ANGLE DETAIL (SHEET 5 OF 7, THESE PLANS). RECO SHALL PROVIDE THE NECESSARY CLIP ANGLES AND HILTI ANCHORS.

SECTION THROUGH FACING PANEL

NOTES: STATIONS AND OFFSETS ARE GIVEN TO THE FRONT FACE OF REINFORCED EARTH WALL PANELS.
 REF: SHEET Nos. 21, 38 & 46 OF 63 IN CONTRACT PLANS FOR BASELINE AND OFFSET INFORMATION.
 ALL DIMENSIONS IN METERS UNLESS NOTED OTHERWISE

RECEIVED
 AUG 11 2004
 BY CPW DATE 8/13/04

CERTIFIED WITH RESPECT TO THE INTERNAL STABILITY OF REINFORCED EARTH STRUCTURES ONLY

VT AOT PROJ. NO. BRO 1446(26)

This drawing contains information proprietary to The Reinforced Earth Company, and is being furnished for the use of VT AOT only in connection with this project, and the information contained herein is not to be transmitted to any other organization unless specifically authorized in writing by The Reinforced Earth Company. The Reinforced Earth Company is exclusive licensee in the United States under patents issued to Henri Vidal, and the furnishing of this drawing does not constitute an expressed or implied license under the Vidal patents.	The design contained on these drawings is based on information provided by the owner. On the basis of this information, The Reinforced Earth Company has designed, and is responsible for the internal stability of the structure only. External stability, including foundation and slope stability, is the responsibility of the owner.			DESIGNED BY:	KPB	PROJECT NAME:	STOWE STREET BRIDGE OVER CENTRAL VT RAILROAD	DATE:	6-25-04
		PROJECT ENGR:	KPB	LOCATION:	WATERBURY VERMONT	CONTRACT NO.:	11069		
		CHECKED BY:	PLA	8/6/04	REV. AS PER VTRANS COMMENTS.	OWNER:	VT AOT	DRAWING NO.:	2 OF 7
		ENG. MANAGER:		REV.	DATE	DESCRIPTION	DRAWING COVERS:	PLAN VIEW- R.E. WALLS	SCALE AS SHOWN

C:\11069\11069_C1.DWG

065 E.W.