



**I+105**

STAKE LENGTH	LT	RT
4270	1+105.645° BK @ 131.35° 23.12	1+105.645° BK @ 131.35° 23.12
6730+ (7930) (FULL WIDTH)	1+105.645° Ahd @ 130.60° 34.56	1+106.500° BK @ 130.6° 34.58

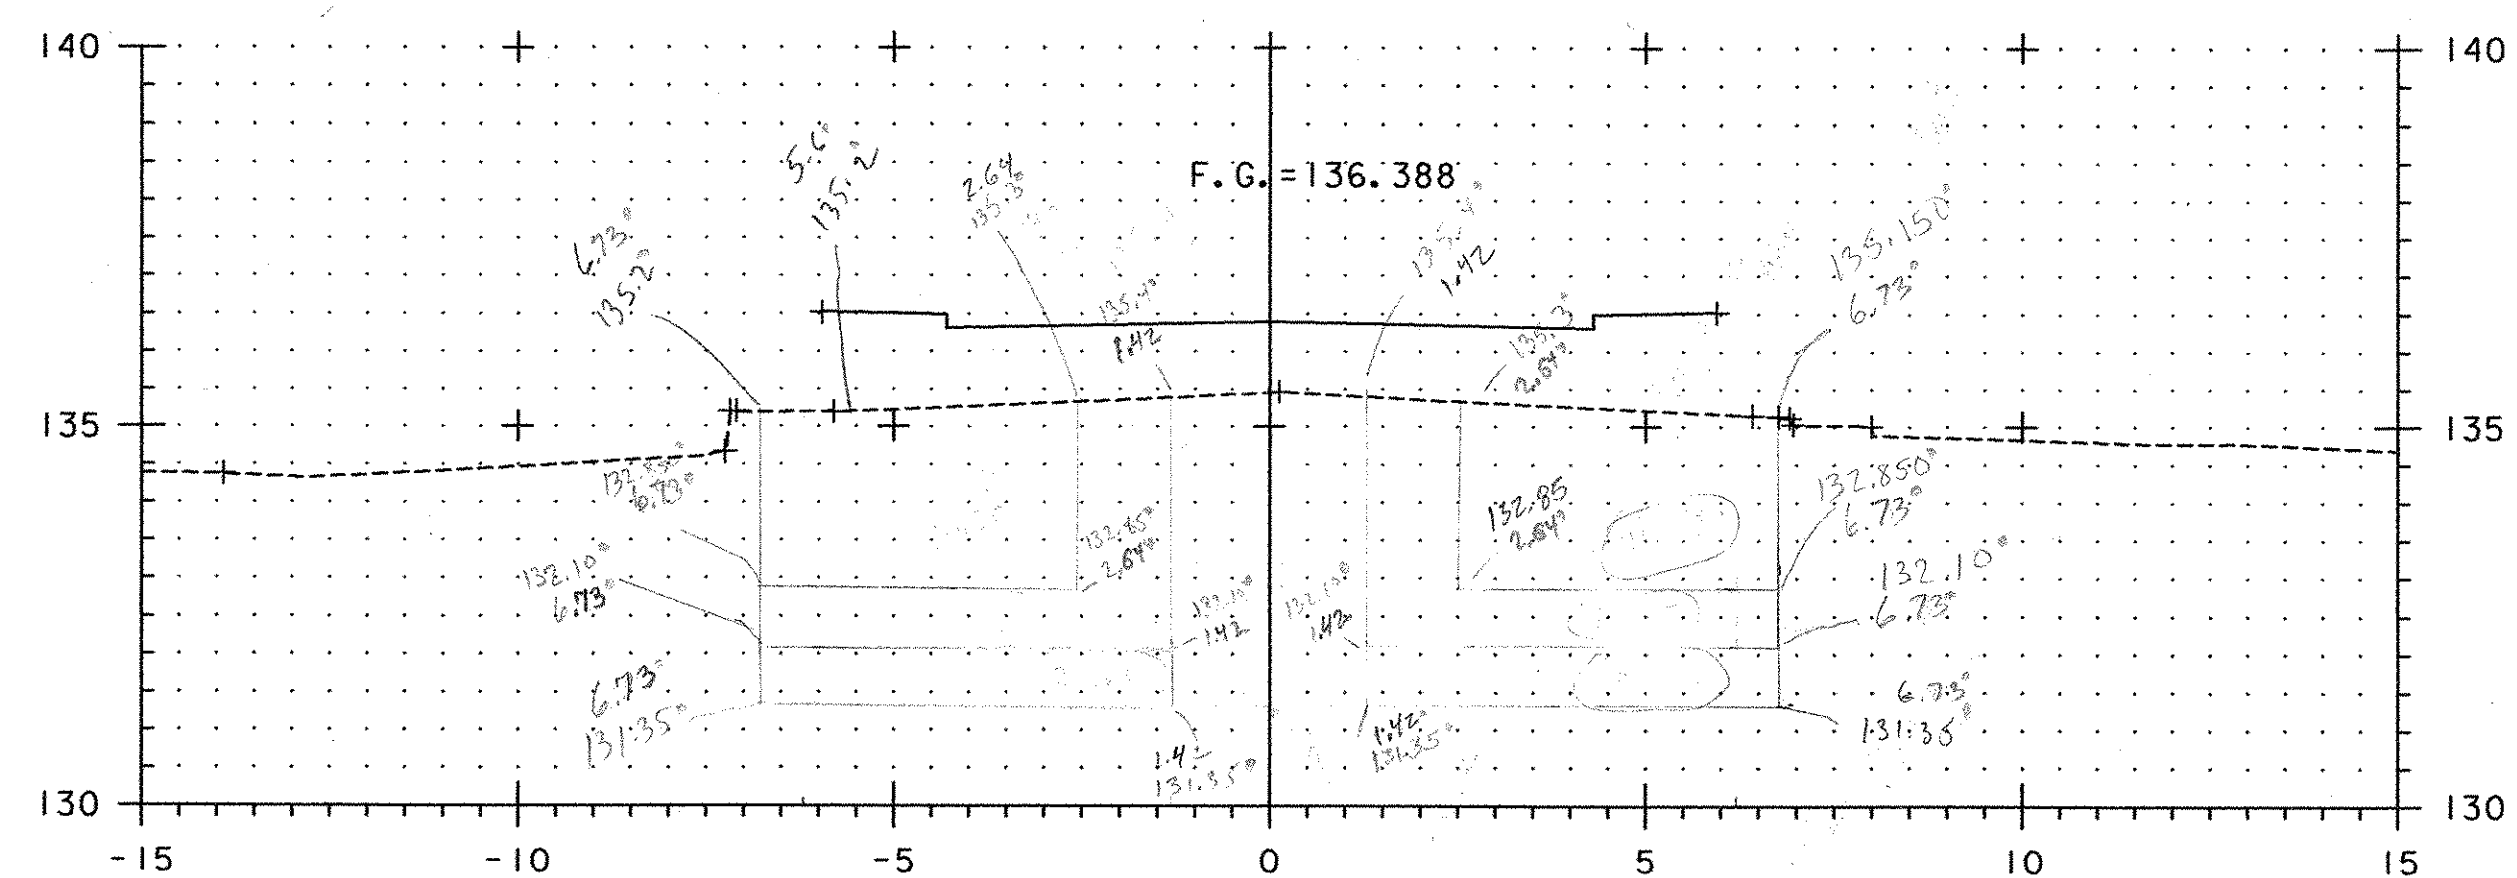

**I+100**

STAKE LENGTH	LT	RT
3080	1+100.500° BK @ 132.85° 9.76	1+100.500° BK @ 132.85° 9.77
4270	1+100.500° Ahd @ 132.10° 16.79	1+100.500° Ahd @ 132.10° 16.75
4270	1+102.645° BK @ 132.10° 16.79	1+103.500° BK @ 132.10° 16.75
4270	1+102.645° Ahd @ 131.35° 20.77	1+103.500° Ahd @ 131.35° 20.73

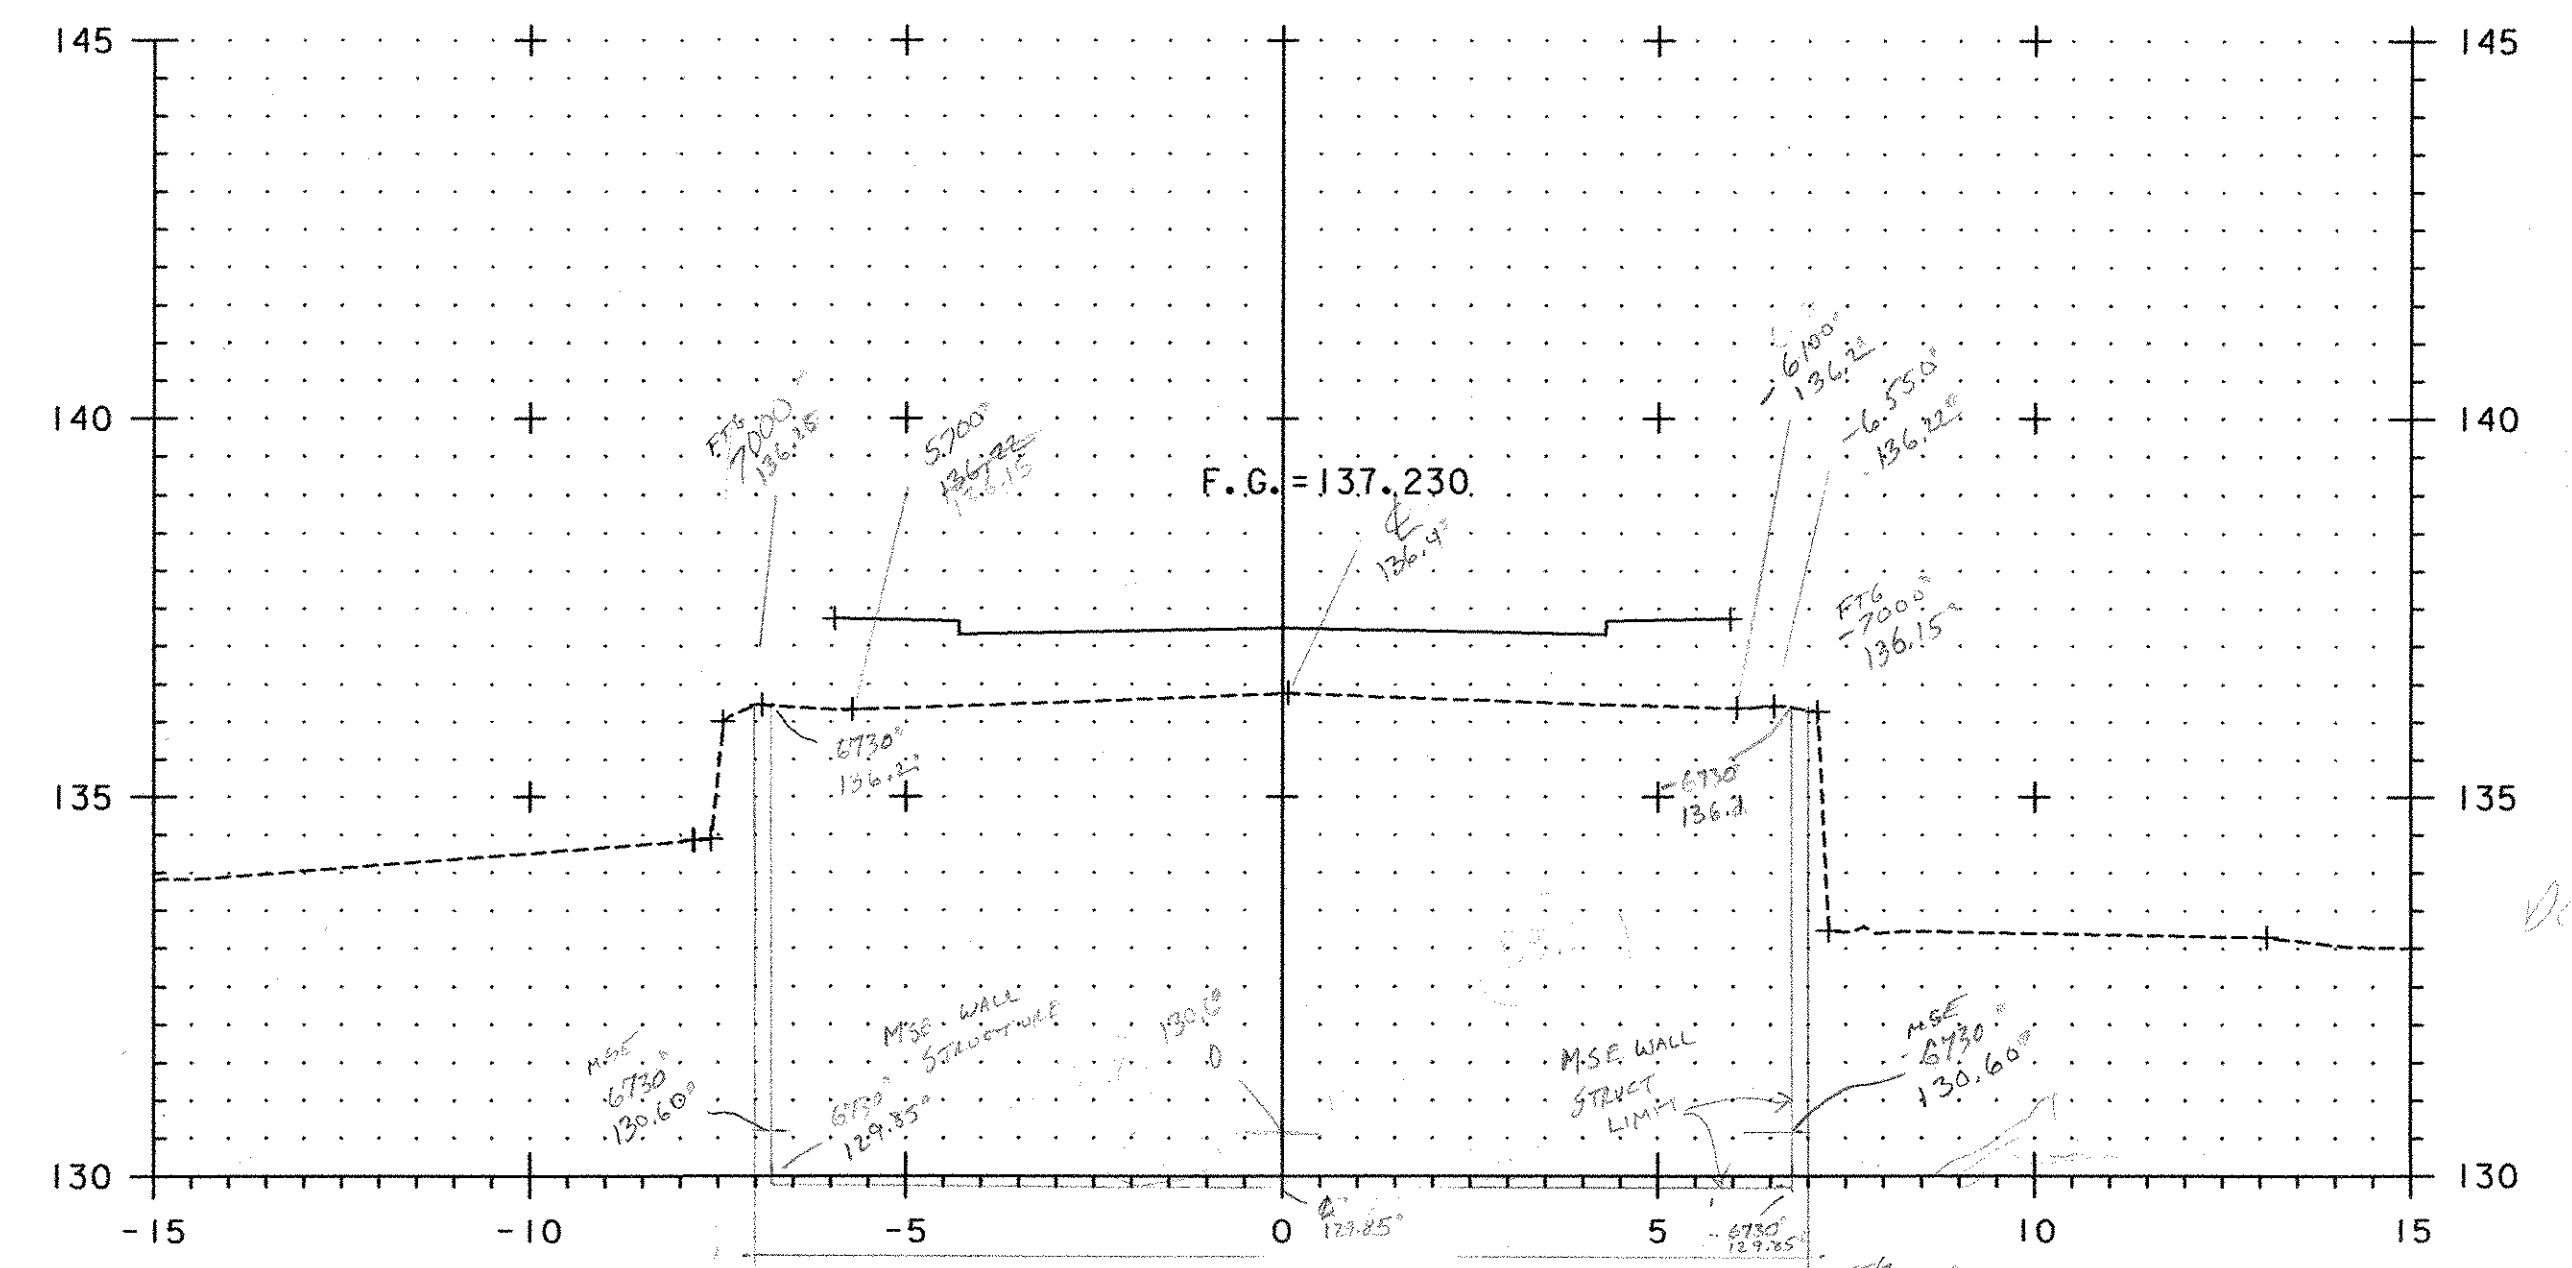

**I+110**

STAKE LENGTH	LT	RT
1108.645	1+111.4° Ahd @ 103.481° 43.14	1+111.4° Ahd @ 103.481° 43.14
1111.4	1+111.4° BK MSE	1+111.4° BK MSE



PROJECT NAME: WATERBURY  
 PROJECT NUMBER: BRO 1446(26)  
 FILE NAME: ...SSB-SupXS.dgn  
 PROJECT LEADER: G EDWARDS/R GINGRAS  
 DESIGNED BY: T. KNIGHT  
 SUPPLEMENTAL CROSS SECTIONS

PLOT DATE: 05/14/2004  
 DRAWN BY: T. KNIGHT  
 CHECKED BY:  
 SHEET 2 OF 6