
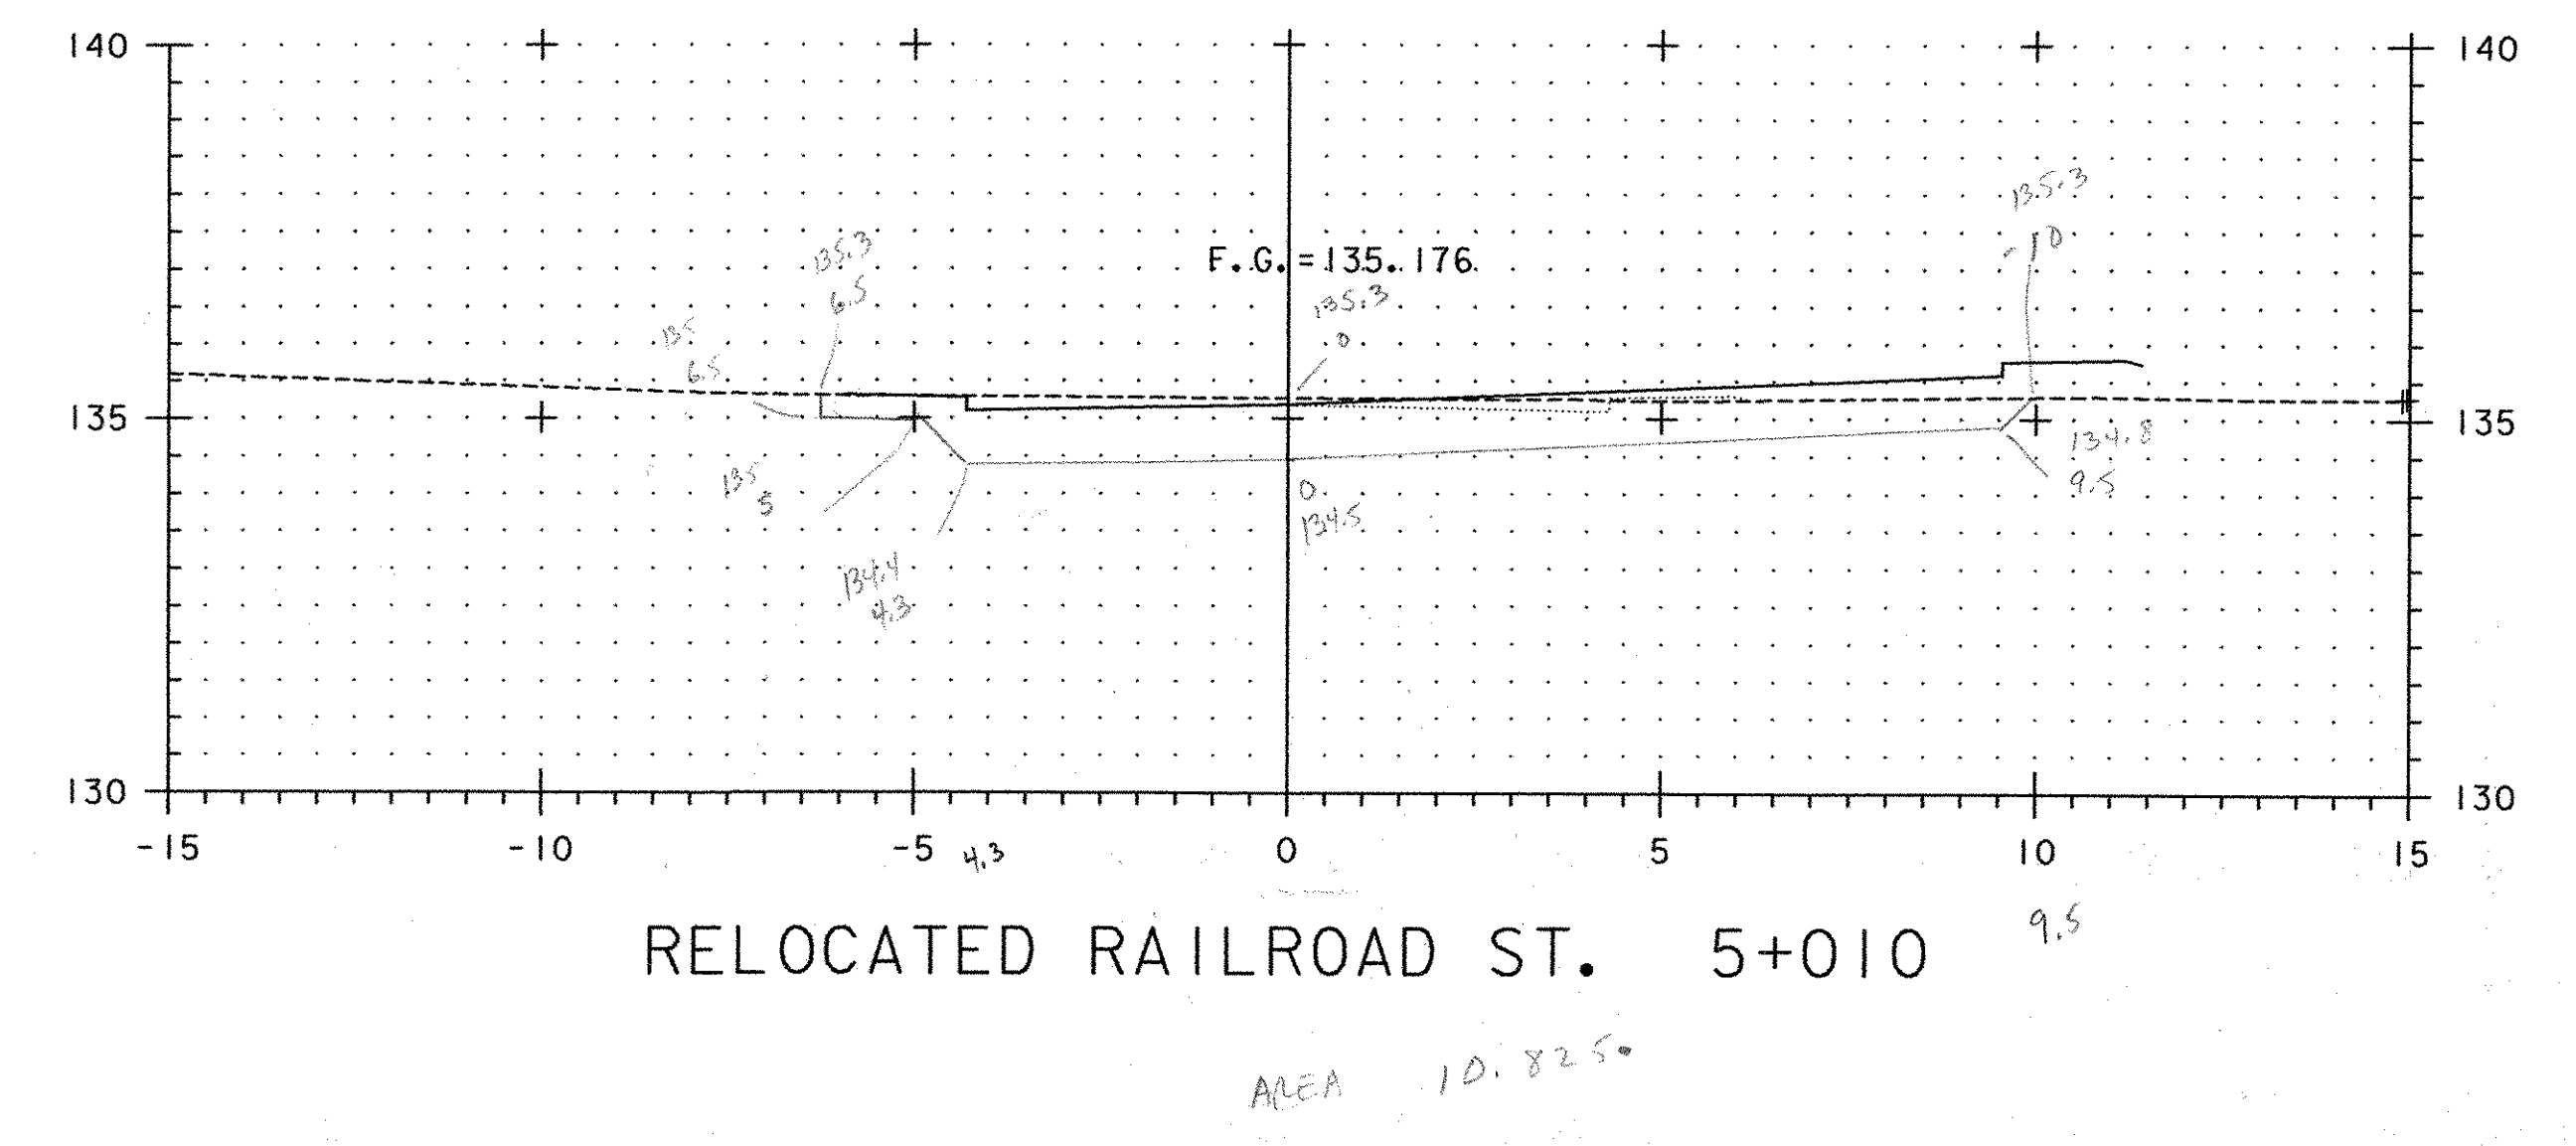
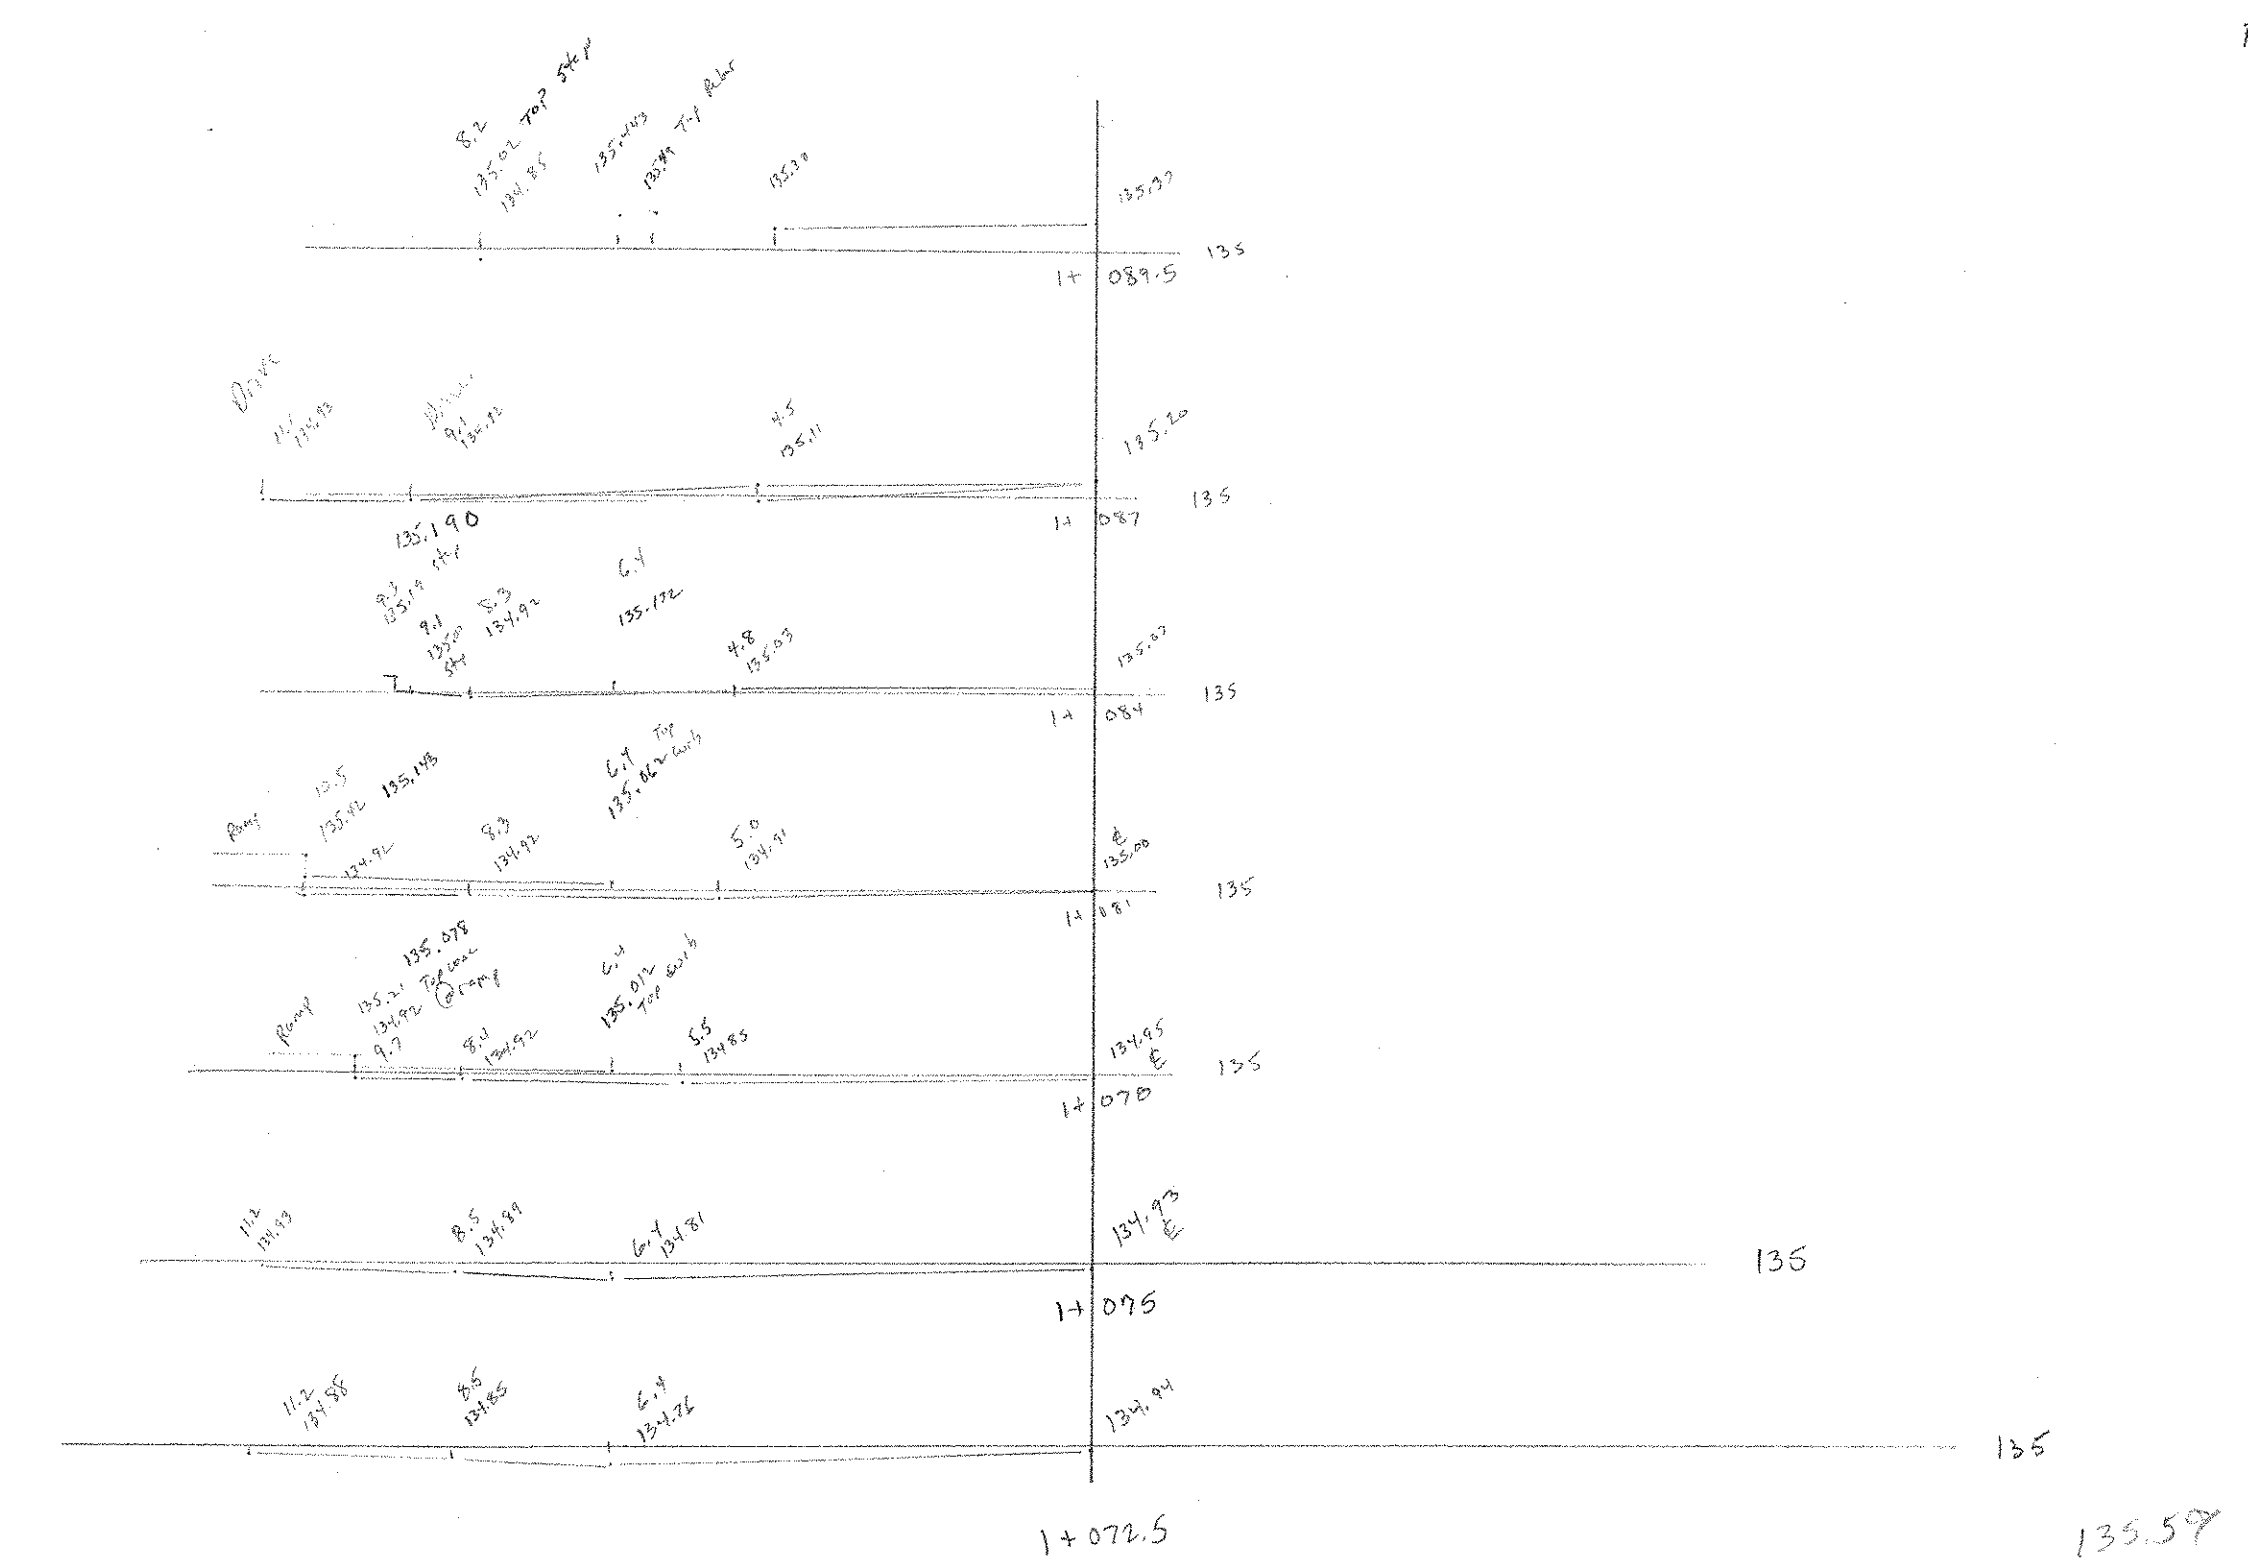
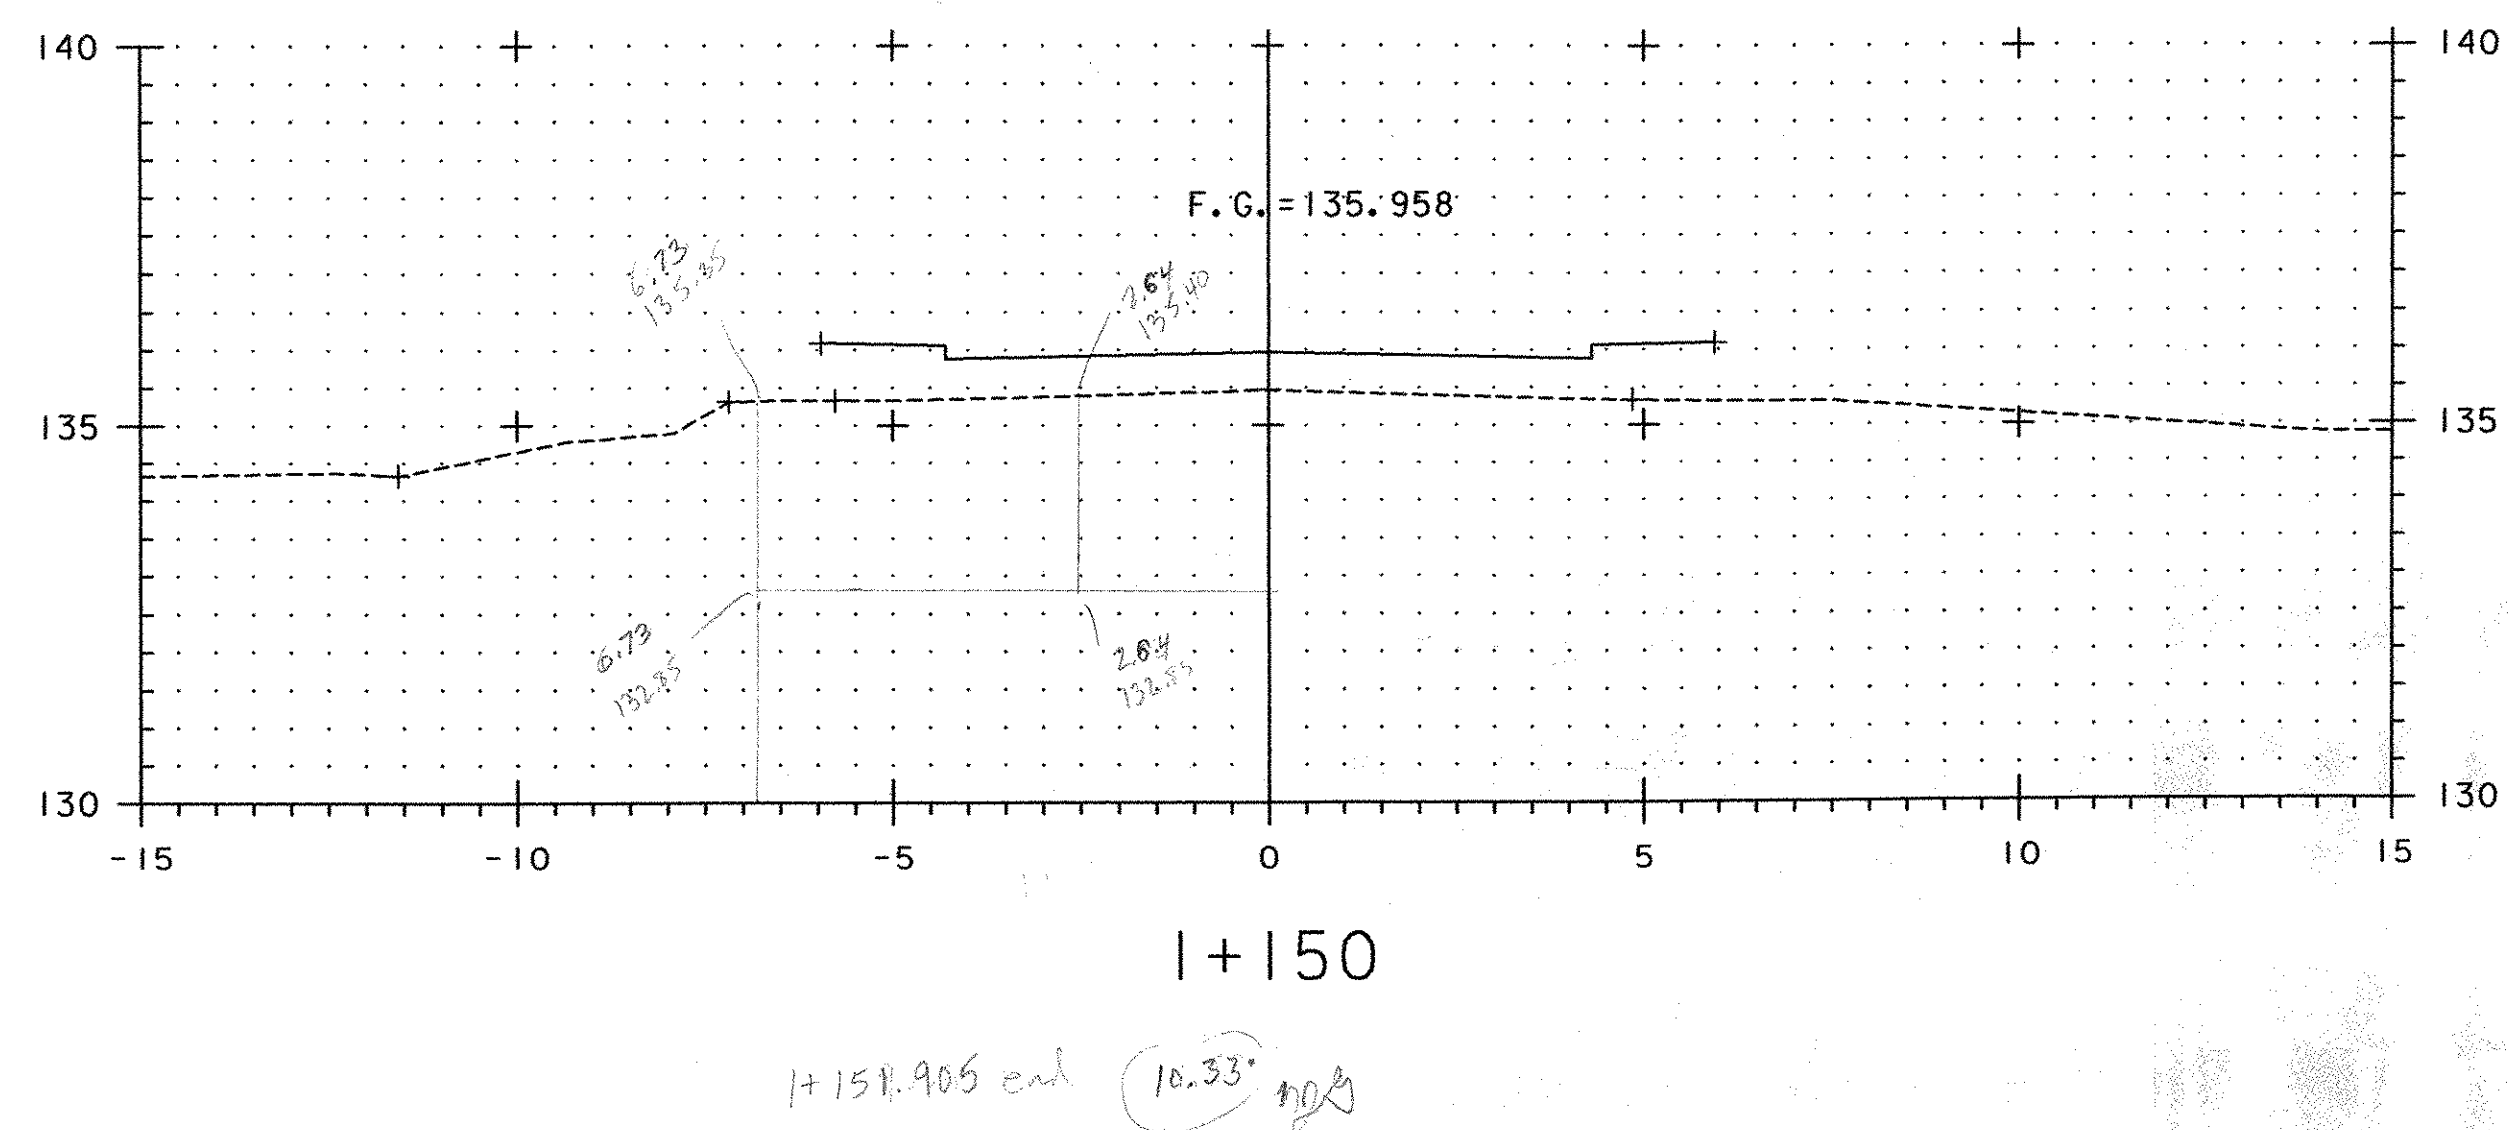


FG 440  
-128  
+150

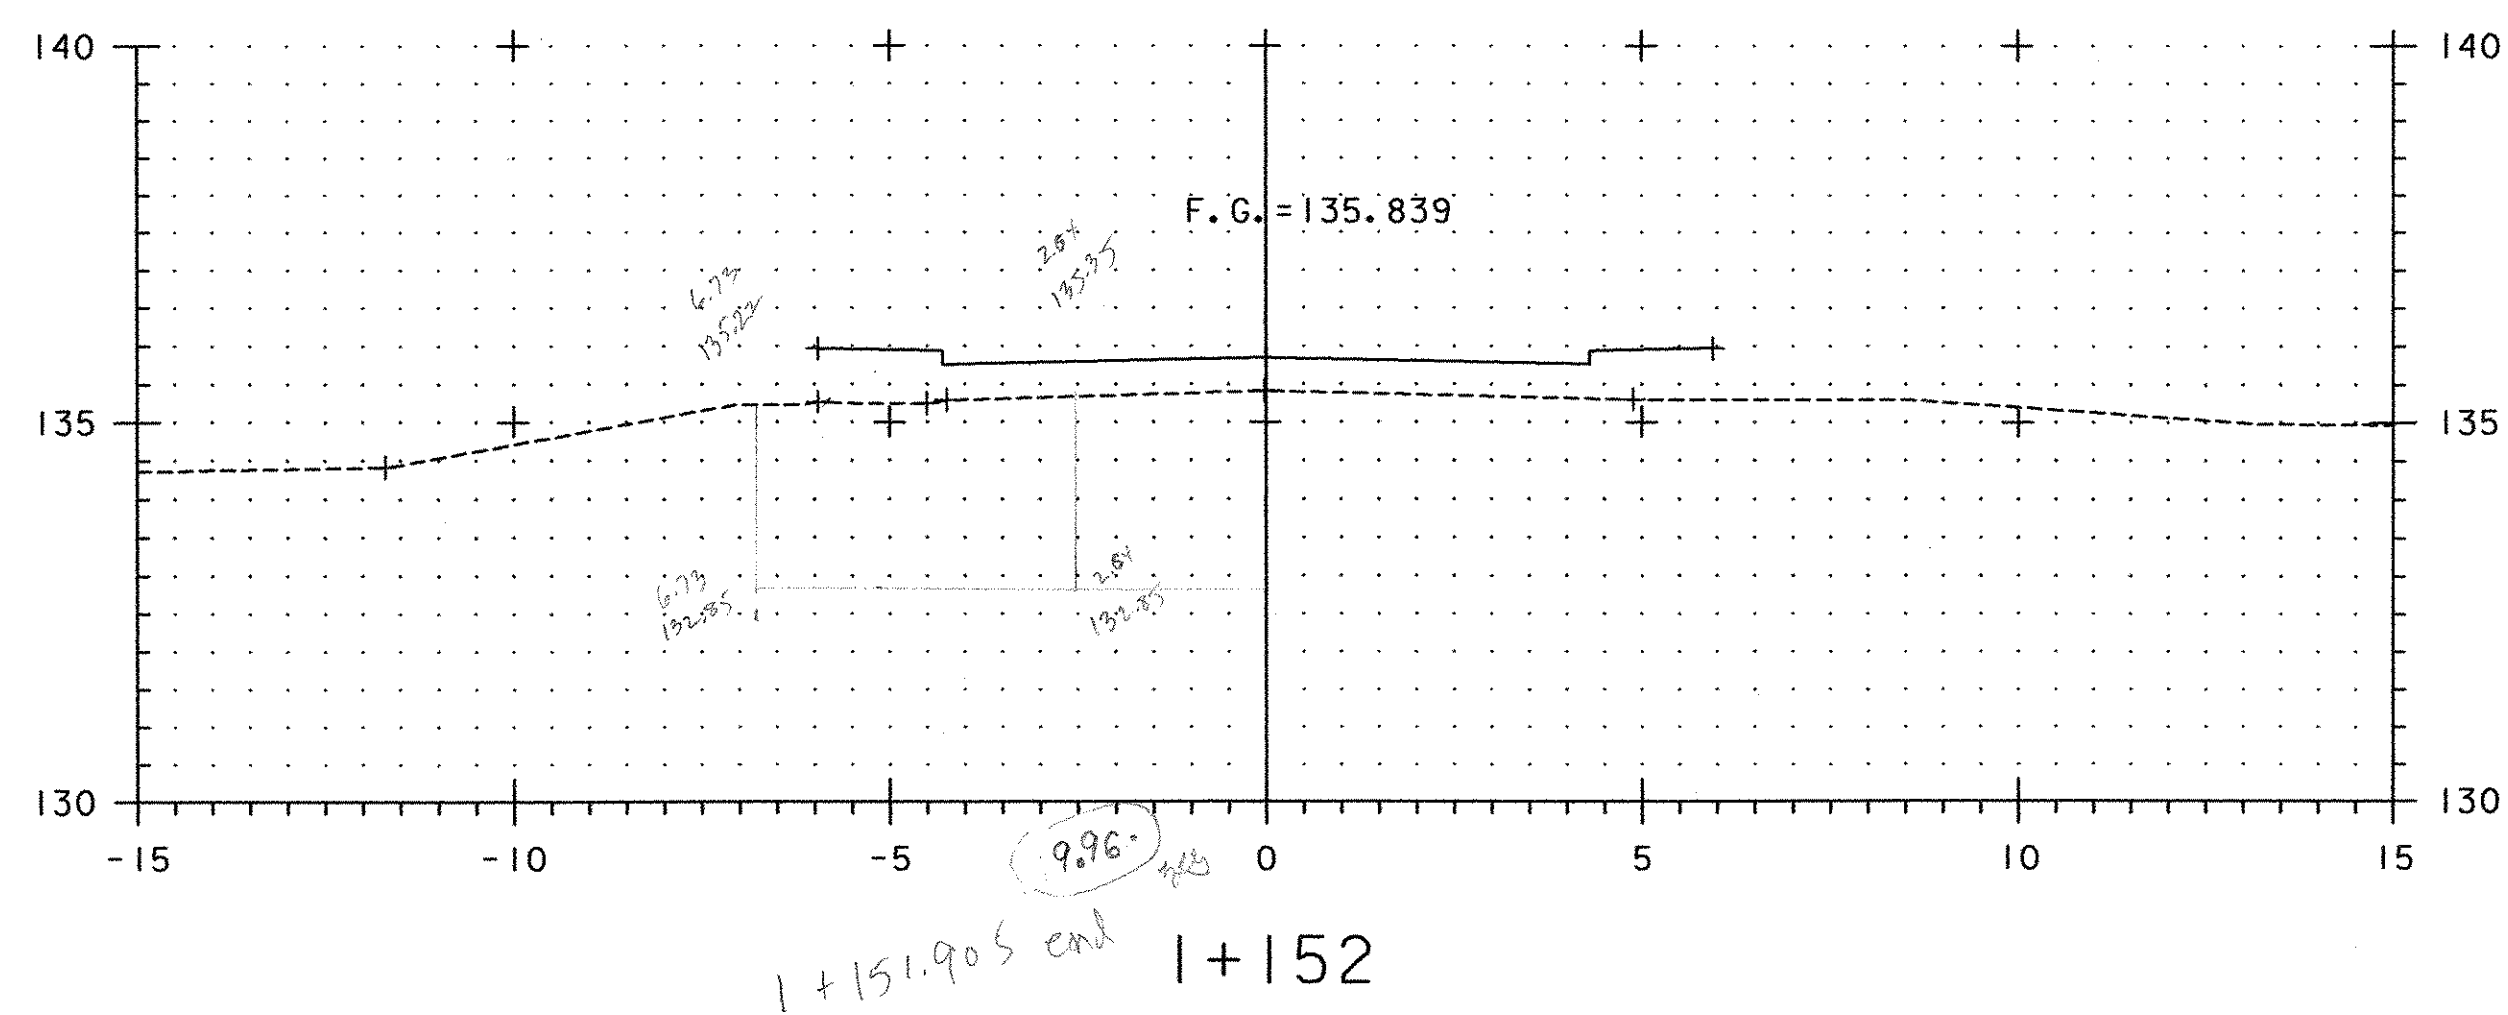

<b>DH</b> Dufresne-Henry	PROJECT NAME: WATERBURY	PLOT DATE: 05/14/2004
	PROJECT NUMBER: BRO 1446(26)	DRAWN BY: T. KNIGHT
	FILE NAME: ...\\SSB-SupXS.dgn	CHECKED BY:
	PROJECT LEADER: G EDWARDS/R GINGRAS	SHEET 6 OF 6
DESIGNED BY: T. KNIGHT	<b>SUPPLEMENTAL CROSS SECTIONS</b>	

RVB 9/3/04

083+5