




STATE OF VERMONT
AGENCY OF TRANSPORTATION
RIGHT OF WAY PLANS
DETAIL SHEET

TABLE OF PROJECT PROPERTY ACQUISITION

PARCEL NO.	GRANTOR	SHEET NO.	BEGINNING STATION	ENDING STATION	TAKING	REM.	RIGHTS	TITLE TAKEN	DATE	TOWN OR CITY RECORDED	BK.	PG.	REMARKS	REVISION NO.	SHEET	DESCRIPTION OF REVISION	DATE	MADE BY	APPROVED BY
1	GREEN MOUNTAIN POWER CORPORATION												UTILITY			PAPER PRINTS TO STRUCTURES	1/15/04	G.J.F.	R. P. D.
2	VERIZON NEW ENGLAND, INC.												UTILITY	1	12	PARCEL NO. 299 TILLOTSON. EXTEND LIMITS OF DRIVE. PER C.O. 9327	1/14/04	G.J.F.	R.P.D.
3	ADELPHIA CABLE COMMUNICATIONS												UTILITY						
156	STIREWALT, ROBERT K. AND STIREWALT, ROBYN L. SKIFF	12	I+172.74 RT.	I+173.89 RT.			INSTALL AND MAINTAIN (P)						UTILITY ANCHOR						
158	BARBER, GEORGE E. & CAROL H.	12	<u>RAILROAD STREET</u> R 5+049.7 LT.	<u>RAILROAD STREET</u> R 5+068.0 LT.			INSTALL (T)	TUP	1-21-04	WATERBURY	219	364	FENCE						
200	THE ELDRIDGE COMPANY, INC.	12	<u>RAILROAD STREET</u> R 5+073.0 RT.	R 5+077.0 RT.									EXCEPT AND RESERVE HOUSE						
201	MARTIN, STEVEN A. & DIXIE R.	12	<u>RAILROAD STREET</u> R 5+058.0 RT. R 5+060.9 RT.	R 5+069.2 RT.									DRIVE, 3.8m (12') GRAVEL EXCEPT AND RESERVE HOUSE						
202A	A. M. VENTURES (ROBERT W. MURRAY & GALEN D. AINSWORTH)	12	<u>RAILROAD STREET</u> R 5+034.81 LT.	<u>RAILROAD STREET</u> R 5+068.53 LT.	0.03 HA.±	0.00		WD	1-23-04	WATERBURY	219	405-406	HOUSE AND LOT AND ALL APPURTENANCES RELATED TO PARCEL (0.07A±)						
202B			<u>RAILROAD STREET</u> R 5+039.93 LT.	<u>RAILROAD STREET</u> R 5+068.60 LT.	0.02 HA.±		ALL RIGHT, TITLE AND INTEREST						HIGHWAY EASEMENT FOR RAILROAD STREET (0.05A±)						
203	ABARE, MICHAEL L. & LAURIE A.	12	<u>RAILROAD STREET</u> R 5+045.6 RT. R 5+055.0 RT.	R 5+052.0 RT.									EXCEPT AND RESERVE HOUSE DRIVE, 4.6m (15') PAVEMENT						
204	DUNN, SARA A.	12	<u>RAILROAD STREET</u> R 5+035.0 RT. R 5+037.8 RT.	R 5+043.2 RT.									DRIVE, 3.6m (12') PAVEMENT EXCEPT AND RESERVE HOUSE						
205	MAYFLOWER MANAGEMENT, L.L.C.	12	I+123.6 RT. <u>RAILROAD STREET</u> R 5+025.8 RT. R 5+026.0 RT.	I+134.6 RT. R 5+029.8 RT.			SLOPE (T) 0.9 SM±						10 SF± EXCEPT AND RESERVE HOUSE DRIVE, 3.6m (12') PAVEMENT						
206A	MAYFLOWER MANAGEMENT, L.L.C.	12	I+170.50 RT.	<u>RAILROAD STREET</u> R 5+039.93 LT.	0.06 HA.±	0.00		WD	2-26-04	WATERBURY	220	280-281	LAND-TOTAL TAKE 0.15A±						
206B			I+170.50 C	R 5+043.15 RT.	0.04 HA.±		ALL RIGHT, TITLE AND INTEREST						HIGHWAY EASEMENT FOR RAILROAD STREET AND STOWE STREET (0.11A±)						

SURVEYED BY _____ DATE _____
 DESIGN BY _____ DATE _____
 DRAWN BY _____ DATE _____
 DESIGN FILE NO. ROW DETAIL.DGN
 PRF FILE 6310004 DATE PLOTTED 05/14/2003

DR. (P) - DRAINAGE RIGHT
 DIT. (P) - DITCHING RIGHT
 CH. (P) - CHANNEL RT.
 DRIVE (T) - DRIVE RIGHT
 CUL. (P) - CULVERT RIGHT

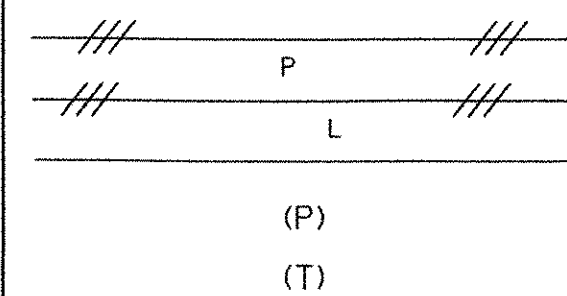

PRESENT R.O.W.
 TAKING WITHOUT ACCESS
 TAKING WITHOUT ACCESS ALONG PROPERTY LINE
 TAKING WITH ACCESS
 PERMANENT EASEMENT
 TEMPORARY EASEMENT

LEGEND
 CZ (P) CLEAR ZONE
 CONST. (T) CONSTRUCTION EASEMENT
 SR SR SLOPE RIGHTS
 P L PROPERTY LINE
 Δ TOP OF CUT
 ○ TOE OF SLOPE



R.O.W. PLANS
MARCH, 2003

PROJECT NAME: WATERBURY
 PROJECT NUMBER: BRO 1446(26)
 FILE NAME: ... \ROW DETAIL.prf
 PROJECT LEADER: G. EDWARDS
 DESIGNED BY: G. BOGUE
R.O.W. PLANS

PLOT DATE: 05/14/2003
 DRAWN BY: M MEILLEUR
 CHECKED BY: G. BOGUE
 R.O.W. SHEET 10 OF 12