


59.954
.175 SPACE POINTS
60.129
HWN
MS
8/2/05

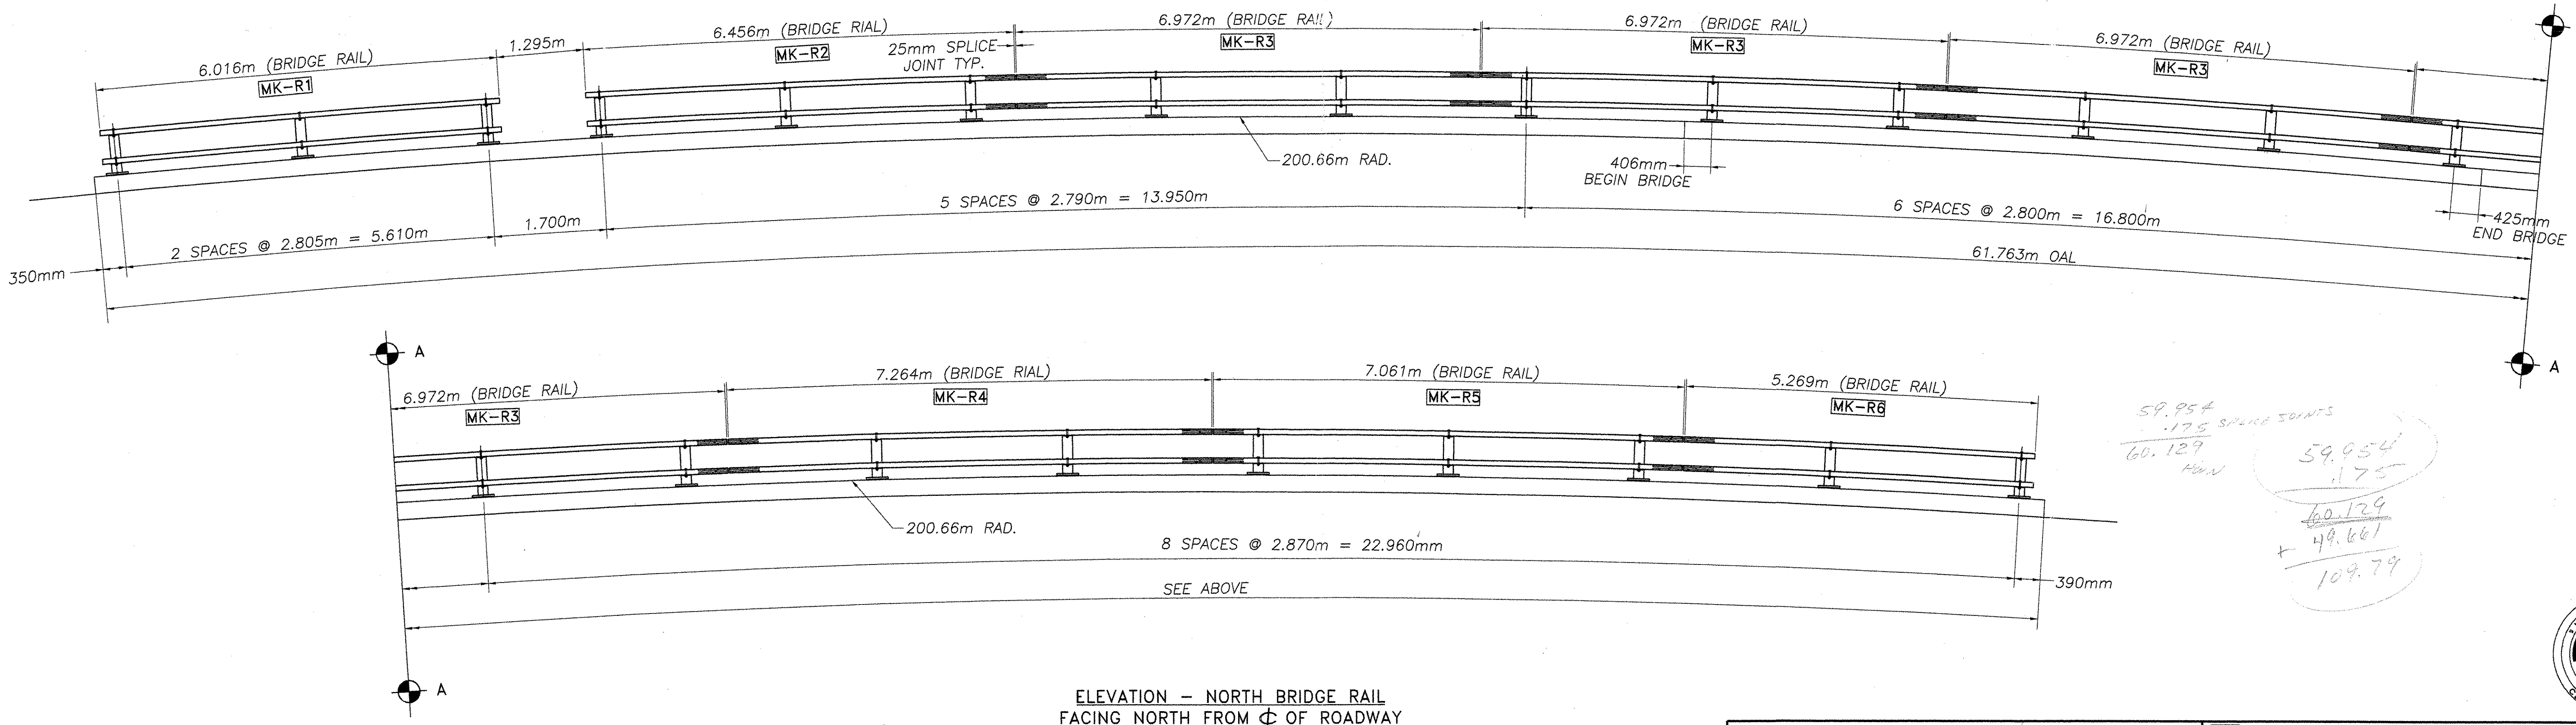

59.954
.175 SPACE POINTS
60.129
HWN
59.954
.175
60.129
+ 49.661
109.79

TOTAL PAY LIMIT = 112m

REVISIONS		
No.	Remarks	Date
0	Initial submittal	9/4/04
	Second submittal	10/6/04
	Third submittal	10/18/04

RECEIVED
OCT 20 2004
APPROVED
BY CPW DATE 10/21/04



HIGHWAY SAFETY CORP.
GLASTONBURY, CT

ITEM 525.31 - 2 RAIL BOX BEAM (MOD.)
TOWN OF WATERBURY
STOWE STREET, BRIDGE 35 (LOCAL ROAD)
PROJECT No. BRO 1446(26)
WASHINGTON COUNTY

DRAWN J. Ruiz
CHECKED [Signature]
DATE 6/1/04
SCALE NONE
HSC REFERENCE NO. 1449
GENERAL CONTRACTOR SIZE D REVISION 0
SUB CONTRACTOR F.R. LAFAYETTE 0958R SHEET NO. 1 of 3