


ELEVATION - SOUTH PEDESTRIAN FENCE
FACING SOUTH FROM ϕ OF ROADWAY

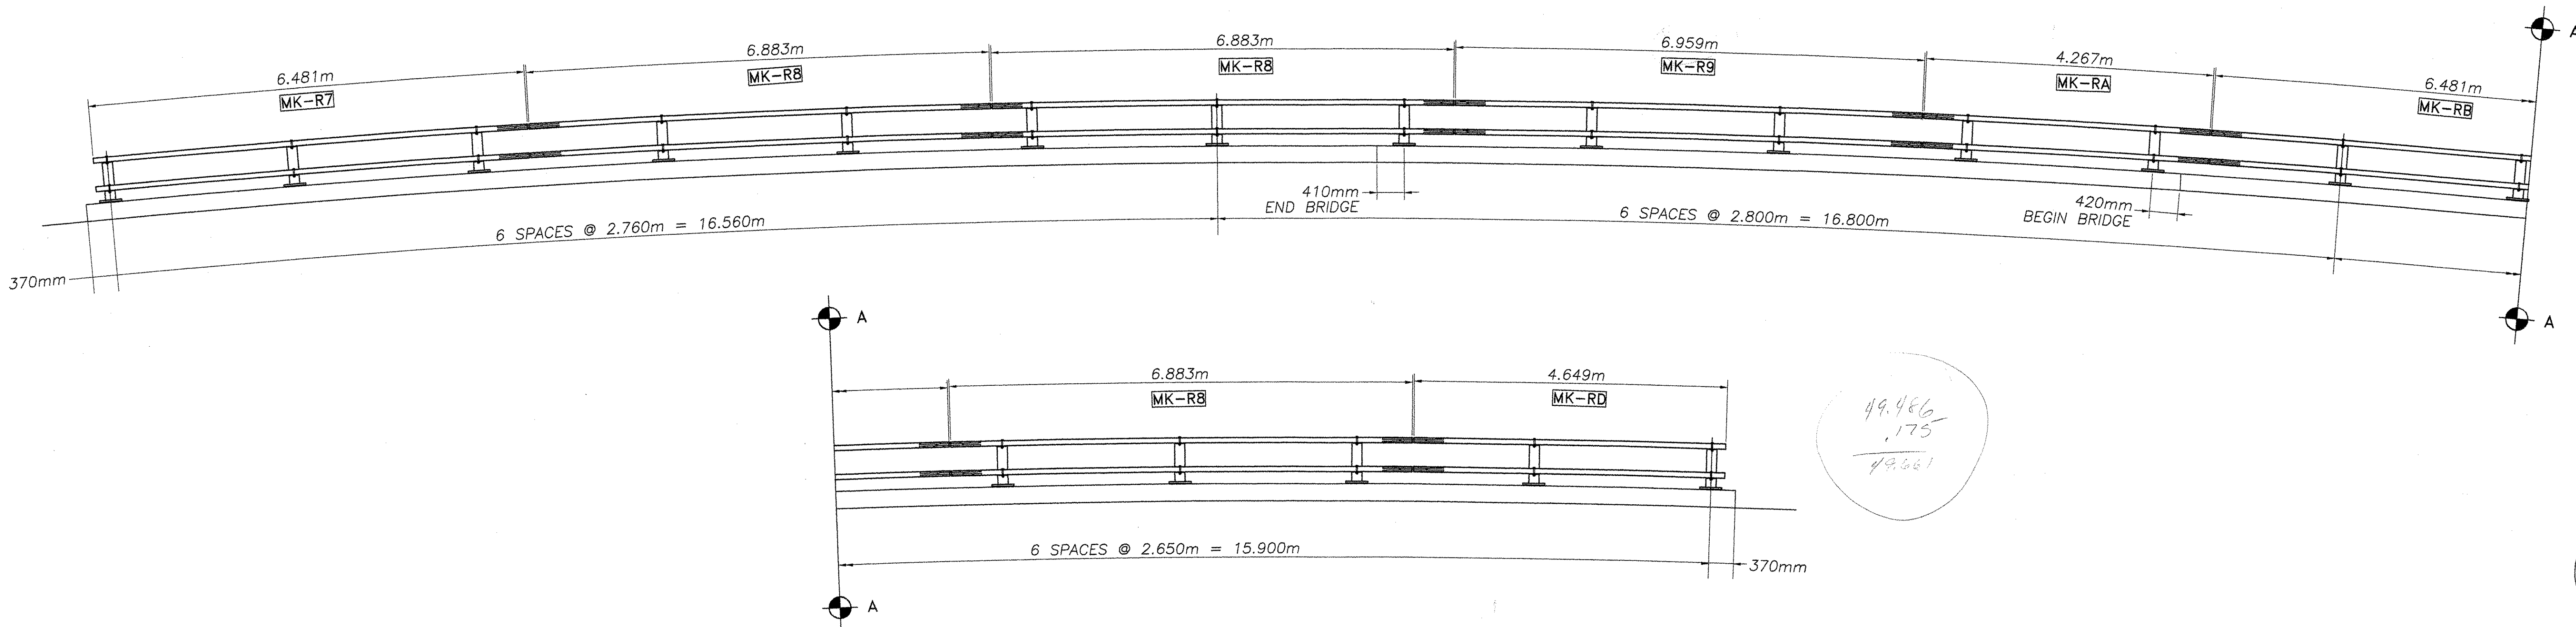

ELEVATION - SOUTH BRIDGE RAIL
FACING SOUTH FROM ϕ OF ROADWAY

49.486
.175
49.361

109-980



REVISIONS		
No.	Remarks	Date
0	Initial submittal	9/4/04
	Second submittal	10/6/04
	Third submittal	10/18/04

RECEIVED
OCT 20 2004
BY CPW DATE 10/21/04

HIGHWAY SAFETY CORP.
GLASTONBURY, CT

ITEM 525.31 - 2 RAIL BOX BEAM (MOD.)
TOWN OF WATERBURY
STOWE STREET, BRIDGE 35 (LOCAL ROAD)
PROJECT No. BRO 1446(26)
WASHINGTON COUNTY

DRAWN J. Ruiz
CHECKED [Signature]
DATE 6/1/04
SCALE NONE
HSC REFERENCE NO. 1449
GENERAL CONTRACTOR [Blank]
SUB CONTRACTOR F.R. LAFAYETTE 096 BR

SIZE D REVISION 0
SHEET NO. 2 of 3