




NOTE:
SEE WATER MAIN SHEETS
FOR PIPE SUPPORT DETAILS
ON WW#2

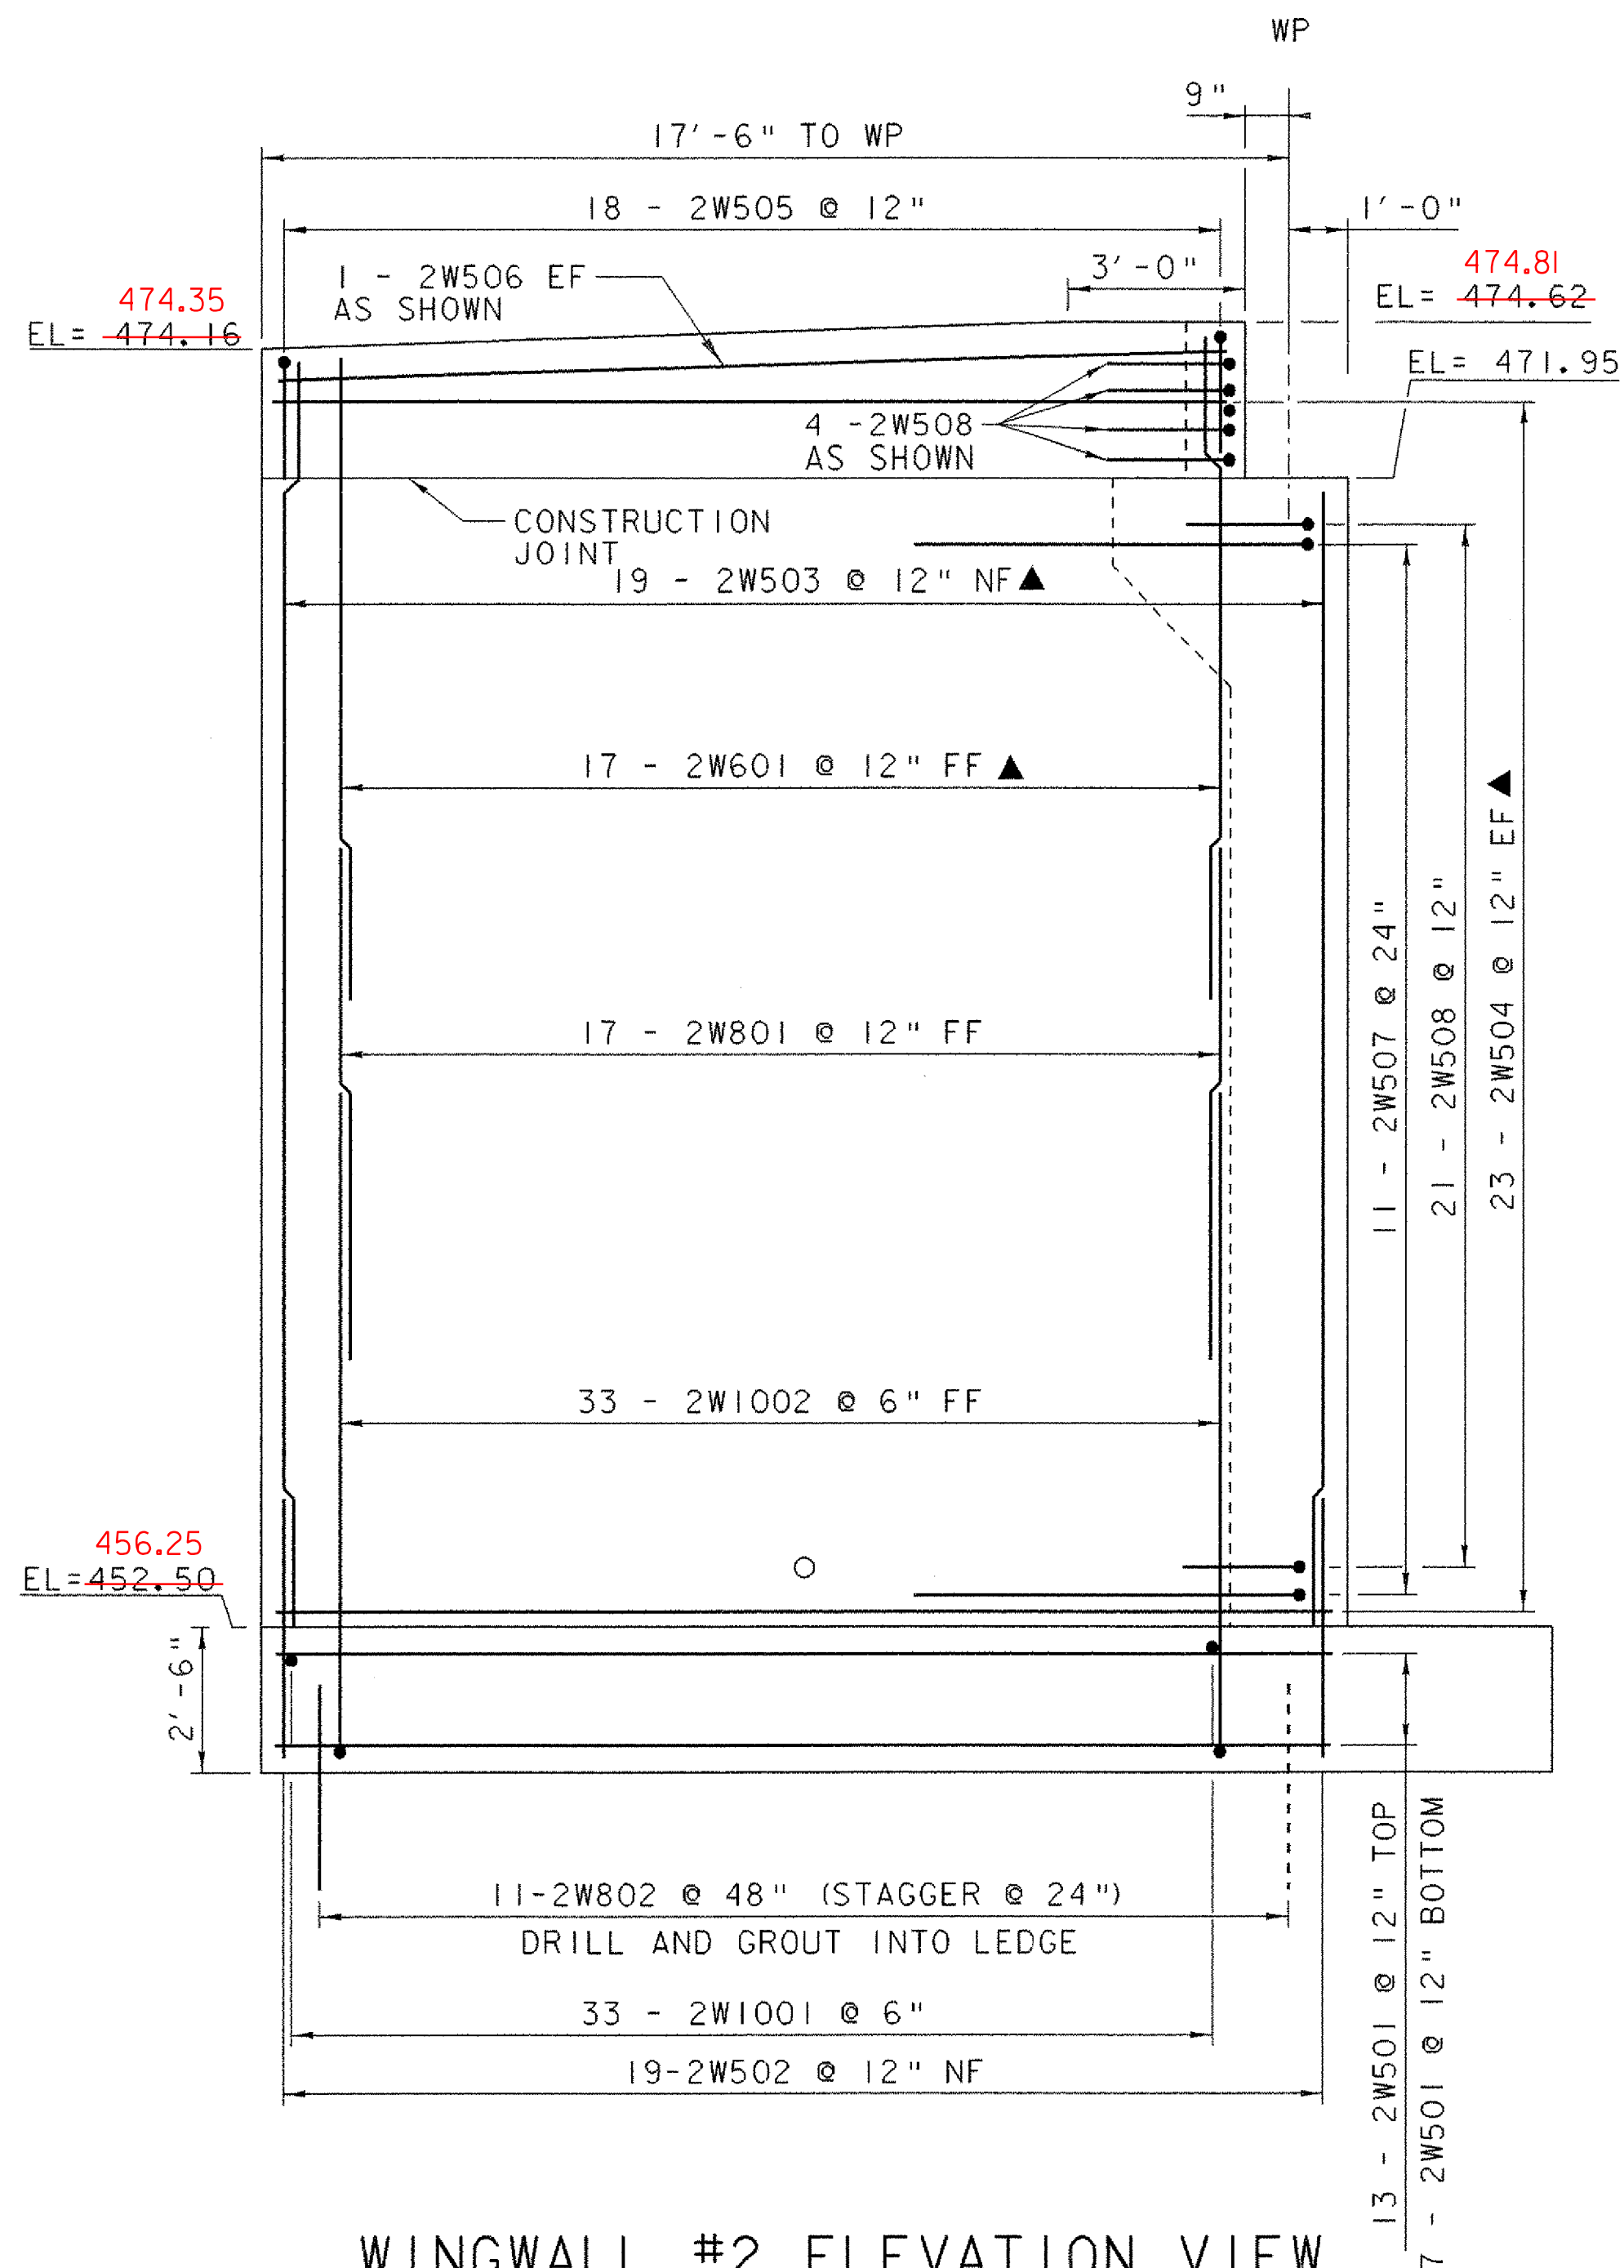

WINGWALL #2 ELEVATION VIEW
SCALE 3/8" = 1'-0"

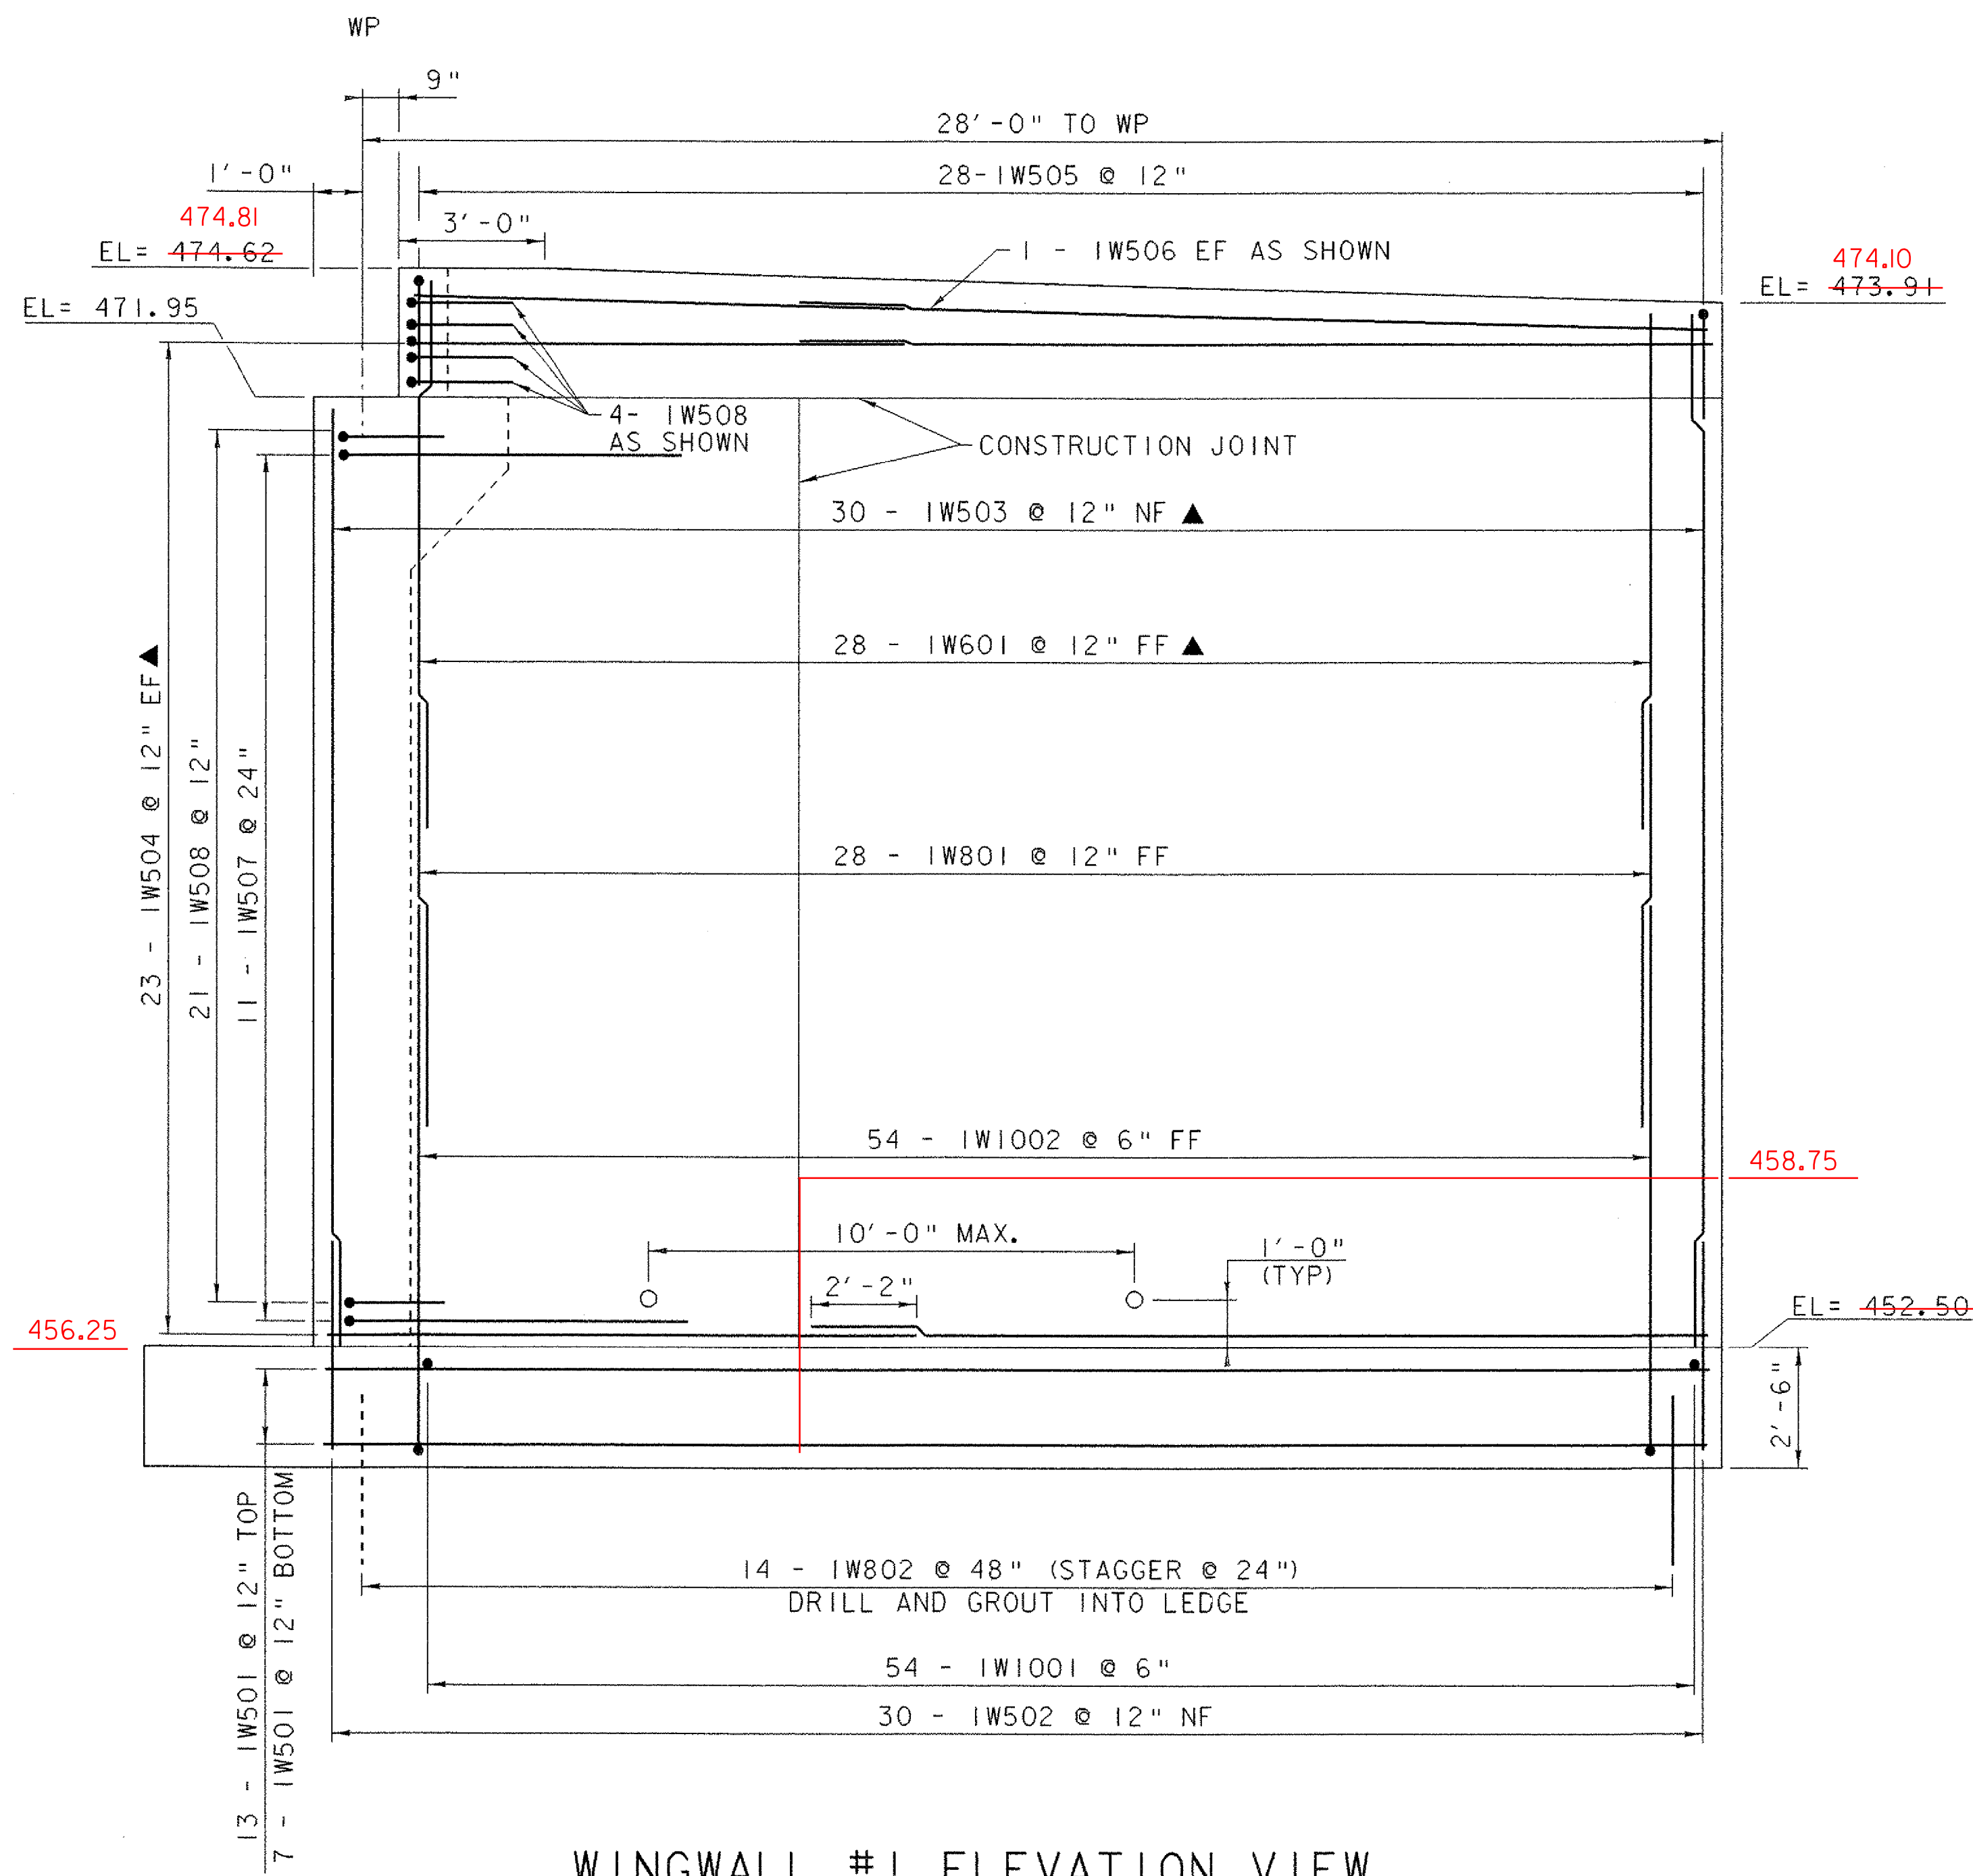

WINGWALL #1 ELEVATION VIEW
SCALE 3/8" = 1'-0"

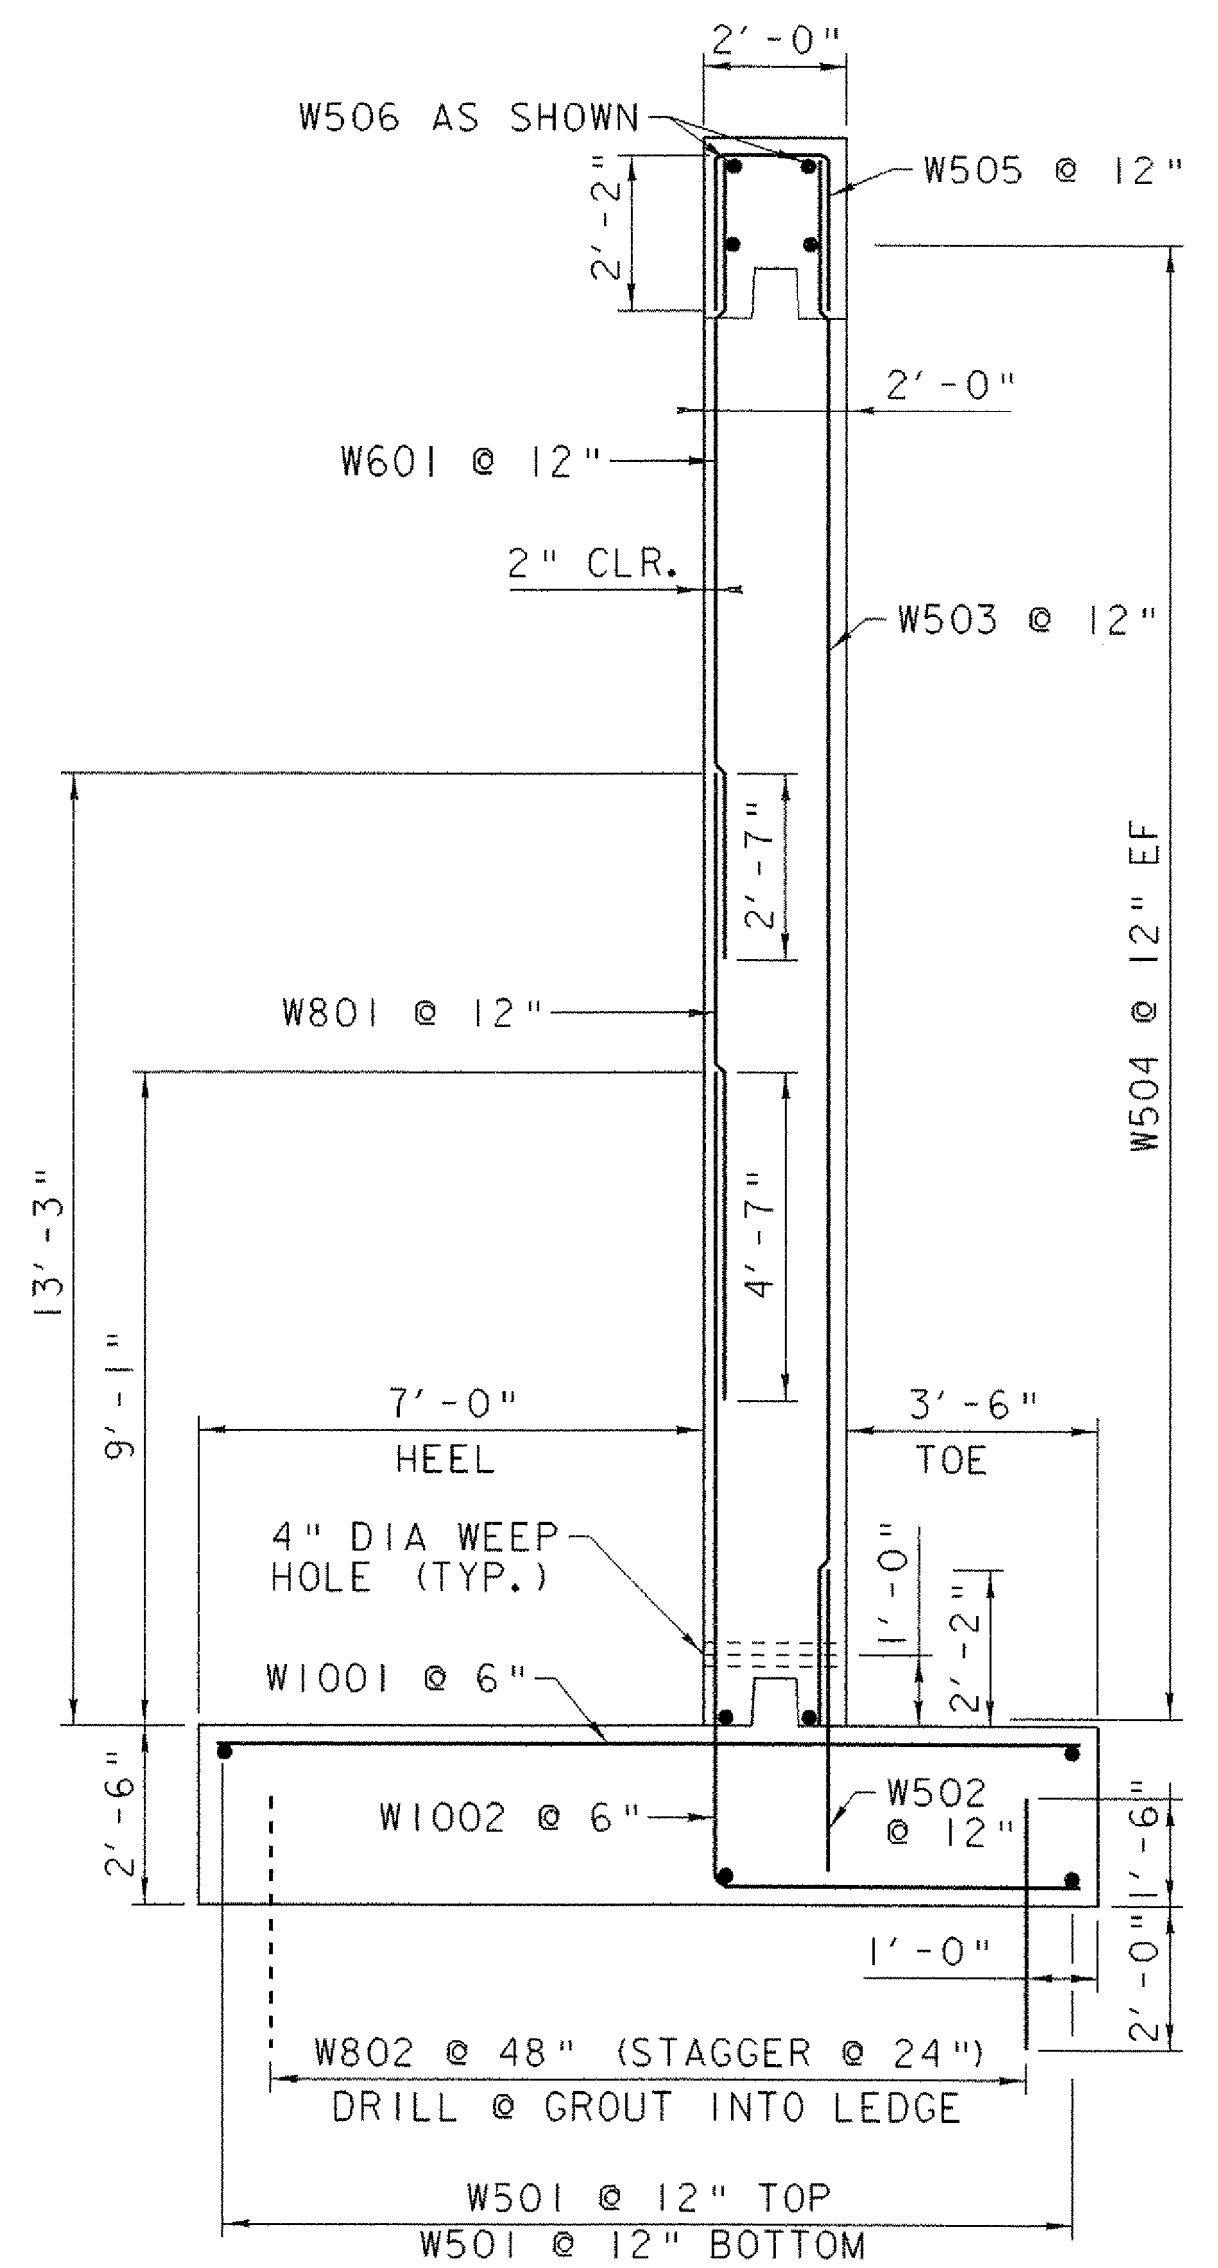

**TYPICAL SECTION
WINGWALLS #1 & #2**
SCALE 3/8" = 1'-0"

NOTE:

- NF = NEAR FACE
- FF = FAR FACE
- EF = EACH FACE
- ▲ = CUT TO FIT IN FIELD
- 3" CLR. UNLESS OTHERWISE SPECIFIED ON THE PLANS.

SCALE 3/8" = 1'-0"
1 0 1 2 3 4

PROJECT NAME: BRADFORD	PLOT DATE: 22-NOV-2006
PROJECT NUMBER: STP I447(28)	DRAWN BY: D.D.BEARD
FILE NAME: \Structures\s96j286sub.dgn	CHECKED BY: R.S.YOUNG
PROJECT LEADER: C.WILLIAMS	SHEET 26 OF 63
DESIGNED BY: M.GAGULIC	
WW#1 AND WW#2	

WINGWALL DETAILS