



WINGWALL #3 ELEVATION VIEW
SCALE 3/8" = 1'-0"

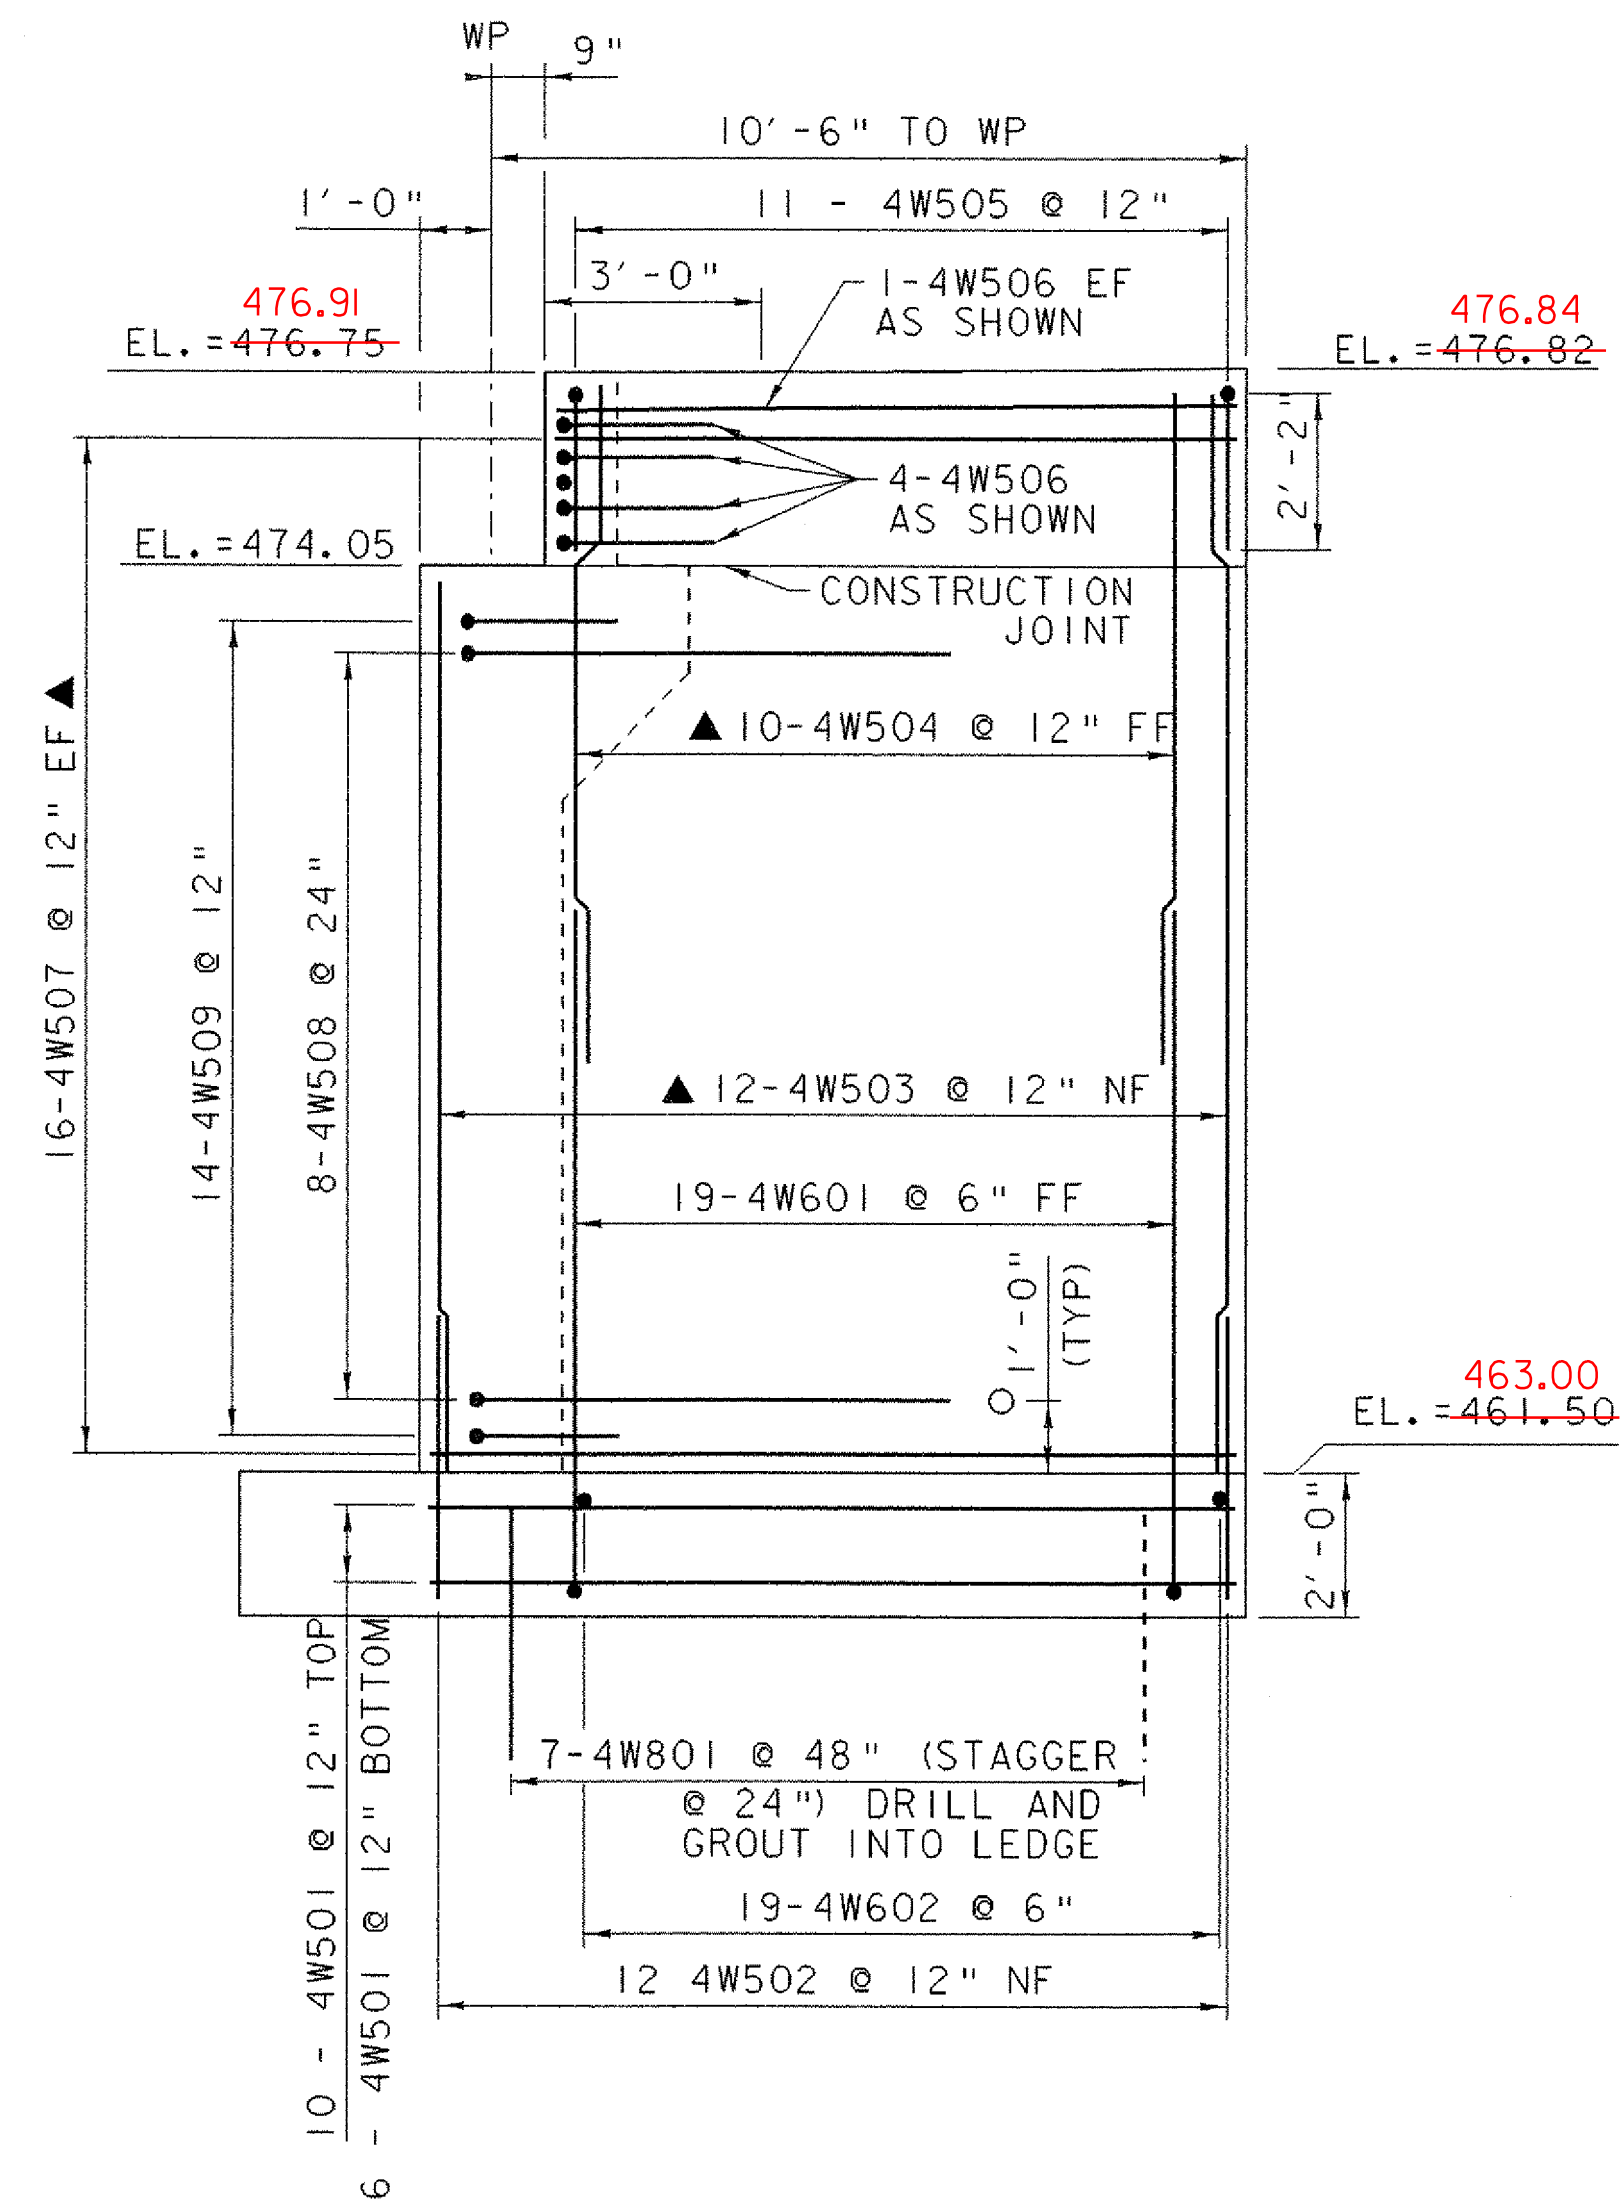

WINGWALL #4 ELEVATION VIEW
SCALE 3/8" = 1'-0"

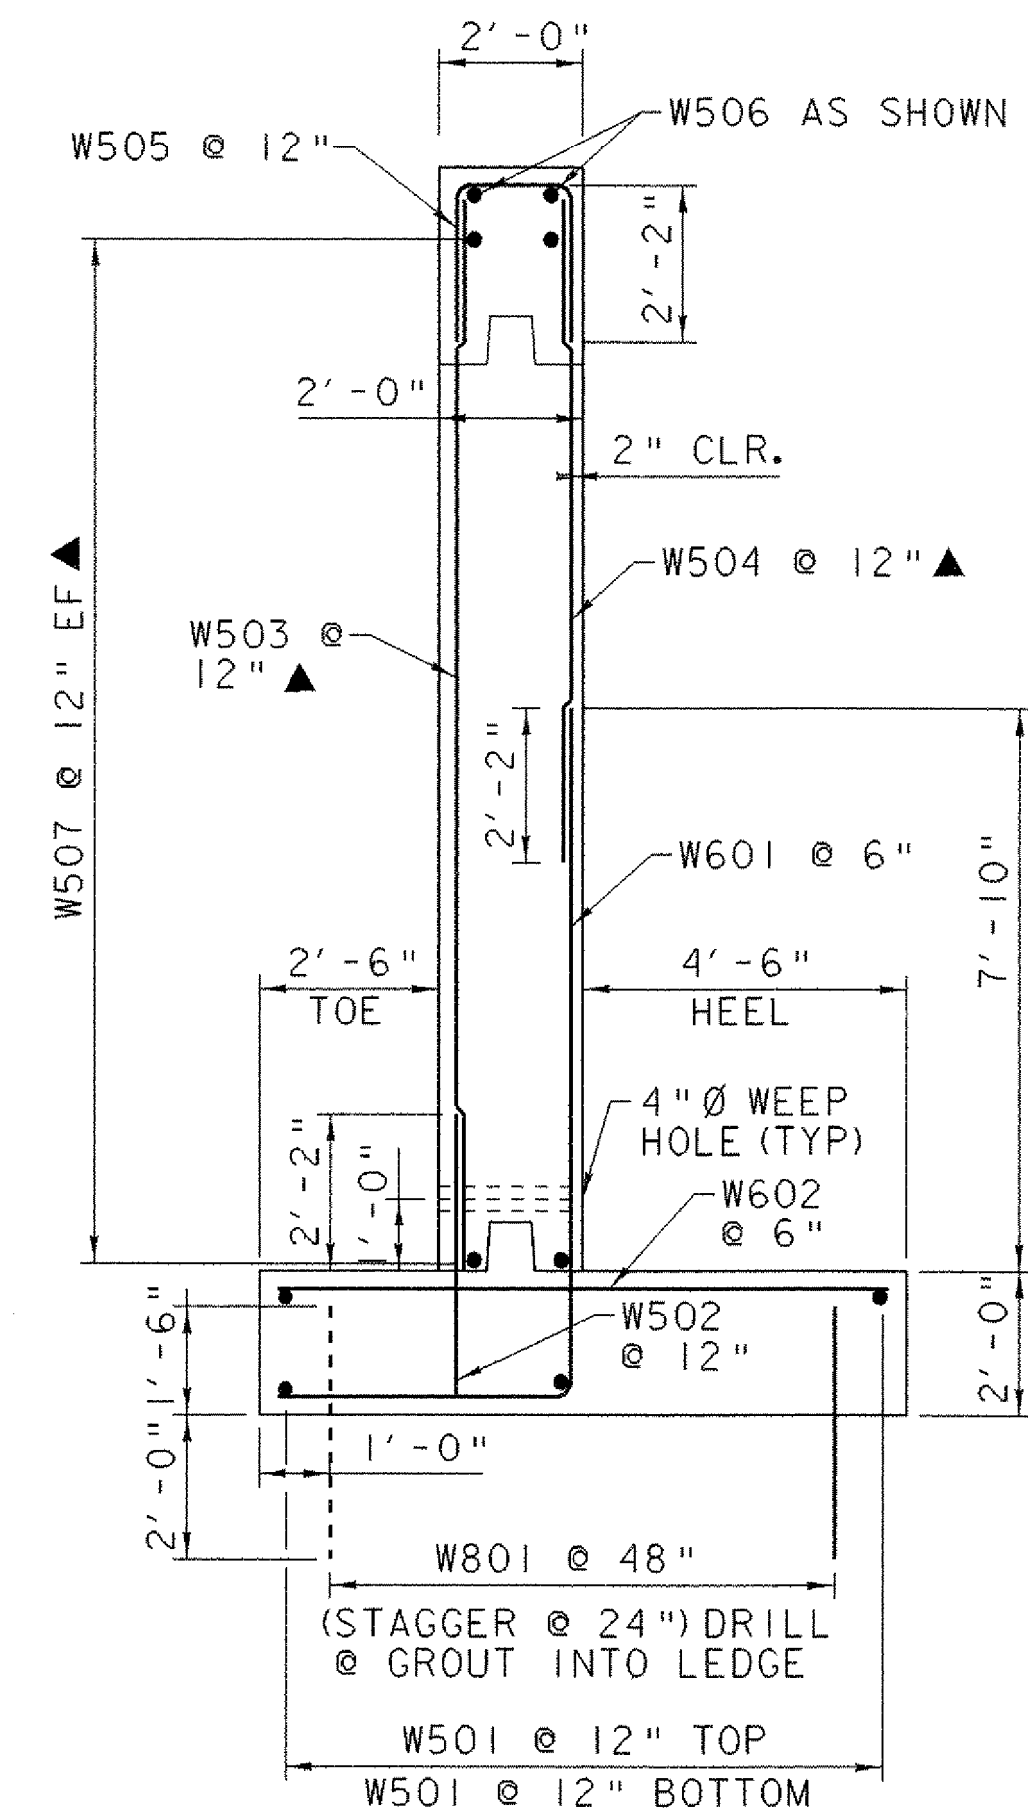

TYPICAL SECTION
WINGWALLS #3 & #4
SCALE 3/8" = 1'-0"

NOTE:

NF = NEAR FACE
FF = FAR FACE
EF = EACH FACE
▲ = CUT TO FIT IN FIELD
3" CLR. UNLESS OTHERWISE SPECIFIED ON THE PLANS.

SCALE 3/8" = 1'-0"
1 0 1 2 3 4

WINGWALL DETAILS

PROJECT NAME: BRADFORD	FILE NAME: \Structures\s96j286sub.dgn	PLOT DATE: 22-NOV-2006
PROJECT NUMBER: STP 1447(28)	PROJECT LEADER: C. WILLIAMS	DRAWN BY: D.D.BEARD
	DESIGNED BY: M.GAGULIC	CHECKED BY: R.S.YOUNG
	WW #3 AND WW #4	SHEET 27 OF 63