

PAY LIMITS ITEM 629.60 WATER MAIN ON BRIDGE (8")

8" DUCTILE IRON, MECHANICAL JOINT PIPE WITH MEGA-LUG RETAINER GLANDS AND 2" PREFORMED URETHANE INSULATION

PIPE SUPPORT, TYP SEE DETAIL SHEET 32

REHABILITATED TRUSS BRIDGE SEE BRIDGE PLANS FOR DETAILS

INSTALL PIPE EXPANSION JOINT

WINGWALL NO. 2 SEE BRIDGE PLANS FOR DETAILS


EXISTING GRADE

WINGWALL NO. 4 SEE BRIDGE PLANS FOR DETAILS

CREAMERY ROAD FINISHED GRADE (TYP)

EXISTING 8" WATER MAIN

PROFILE

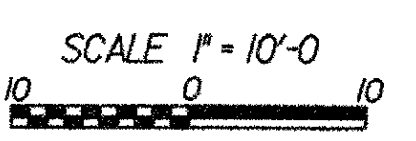

NOTE:
PIPE SUPPORT LOCATIONS SHALL BE IDENTIFIED IN THE FIELD IN ACCORDANCE WITH PIPE MANUFACTURER'S RECOMMENDATION AND SHALL BE APPROVED BY THE ENGINEER. SUPPORT LOCATIONS SHALL NOT CONFLICT WITH TRUSS VERTICAL MEMBERS.

NOTE:
INFORMATION ON THIS SHEET FOR WATER MAIN AND DETAILS ONLY. REFER TO OTHER DRAWINGS FOR BRIDGE AND ROADWAY DETAILS.

STATE OF VERMONT AGENCY OF TRANSPORTATION	
Town Of BRADFORD	Bridge No. 22
Highway No. 27	Log Sta. Surv. Sta.
CREAMERY ROAD OVER WAITS RIVER	

NO.	DATE	REVISIONS	BY	CK'D

DuBois & King
INC.

engineering planning management development

TOWN OF BRADFORD,
VERMONT

-
CREAMERY ROAD
BRIDGE REPLACEMENT
WATER MAIN REPLACEMENT PROFILE

DRAWN BY APG	DATE OCT. 2006
CHECKED BY CKG	PROJ. NO. 219248L
PROJ. ENG. APG	DRAW. NO. ---
SHEET 31 OF 63	

PLOTTED 11/01/2006