



1+50

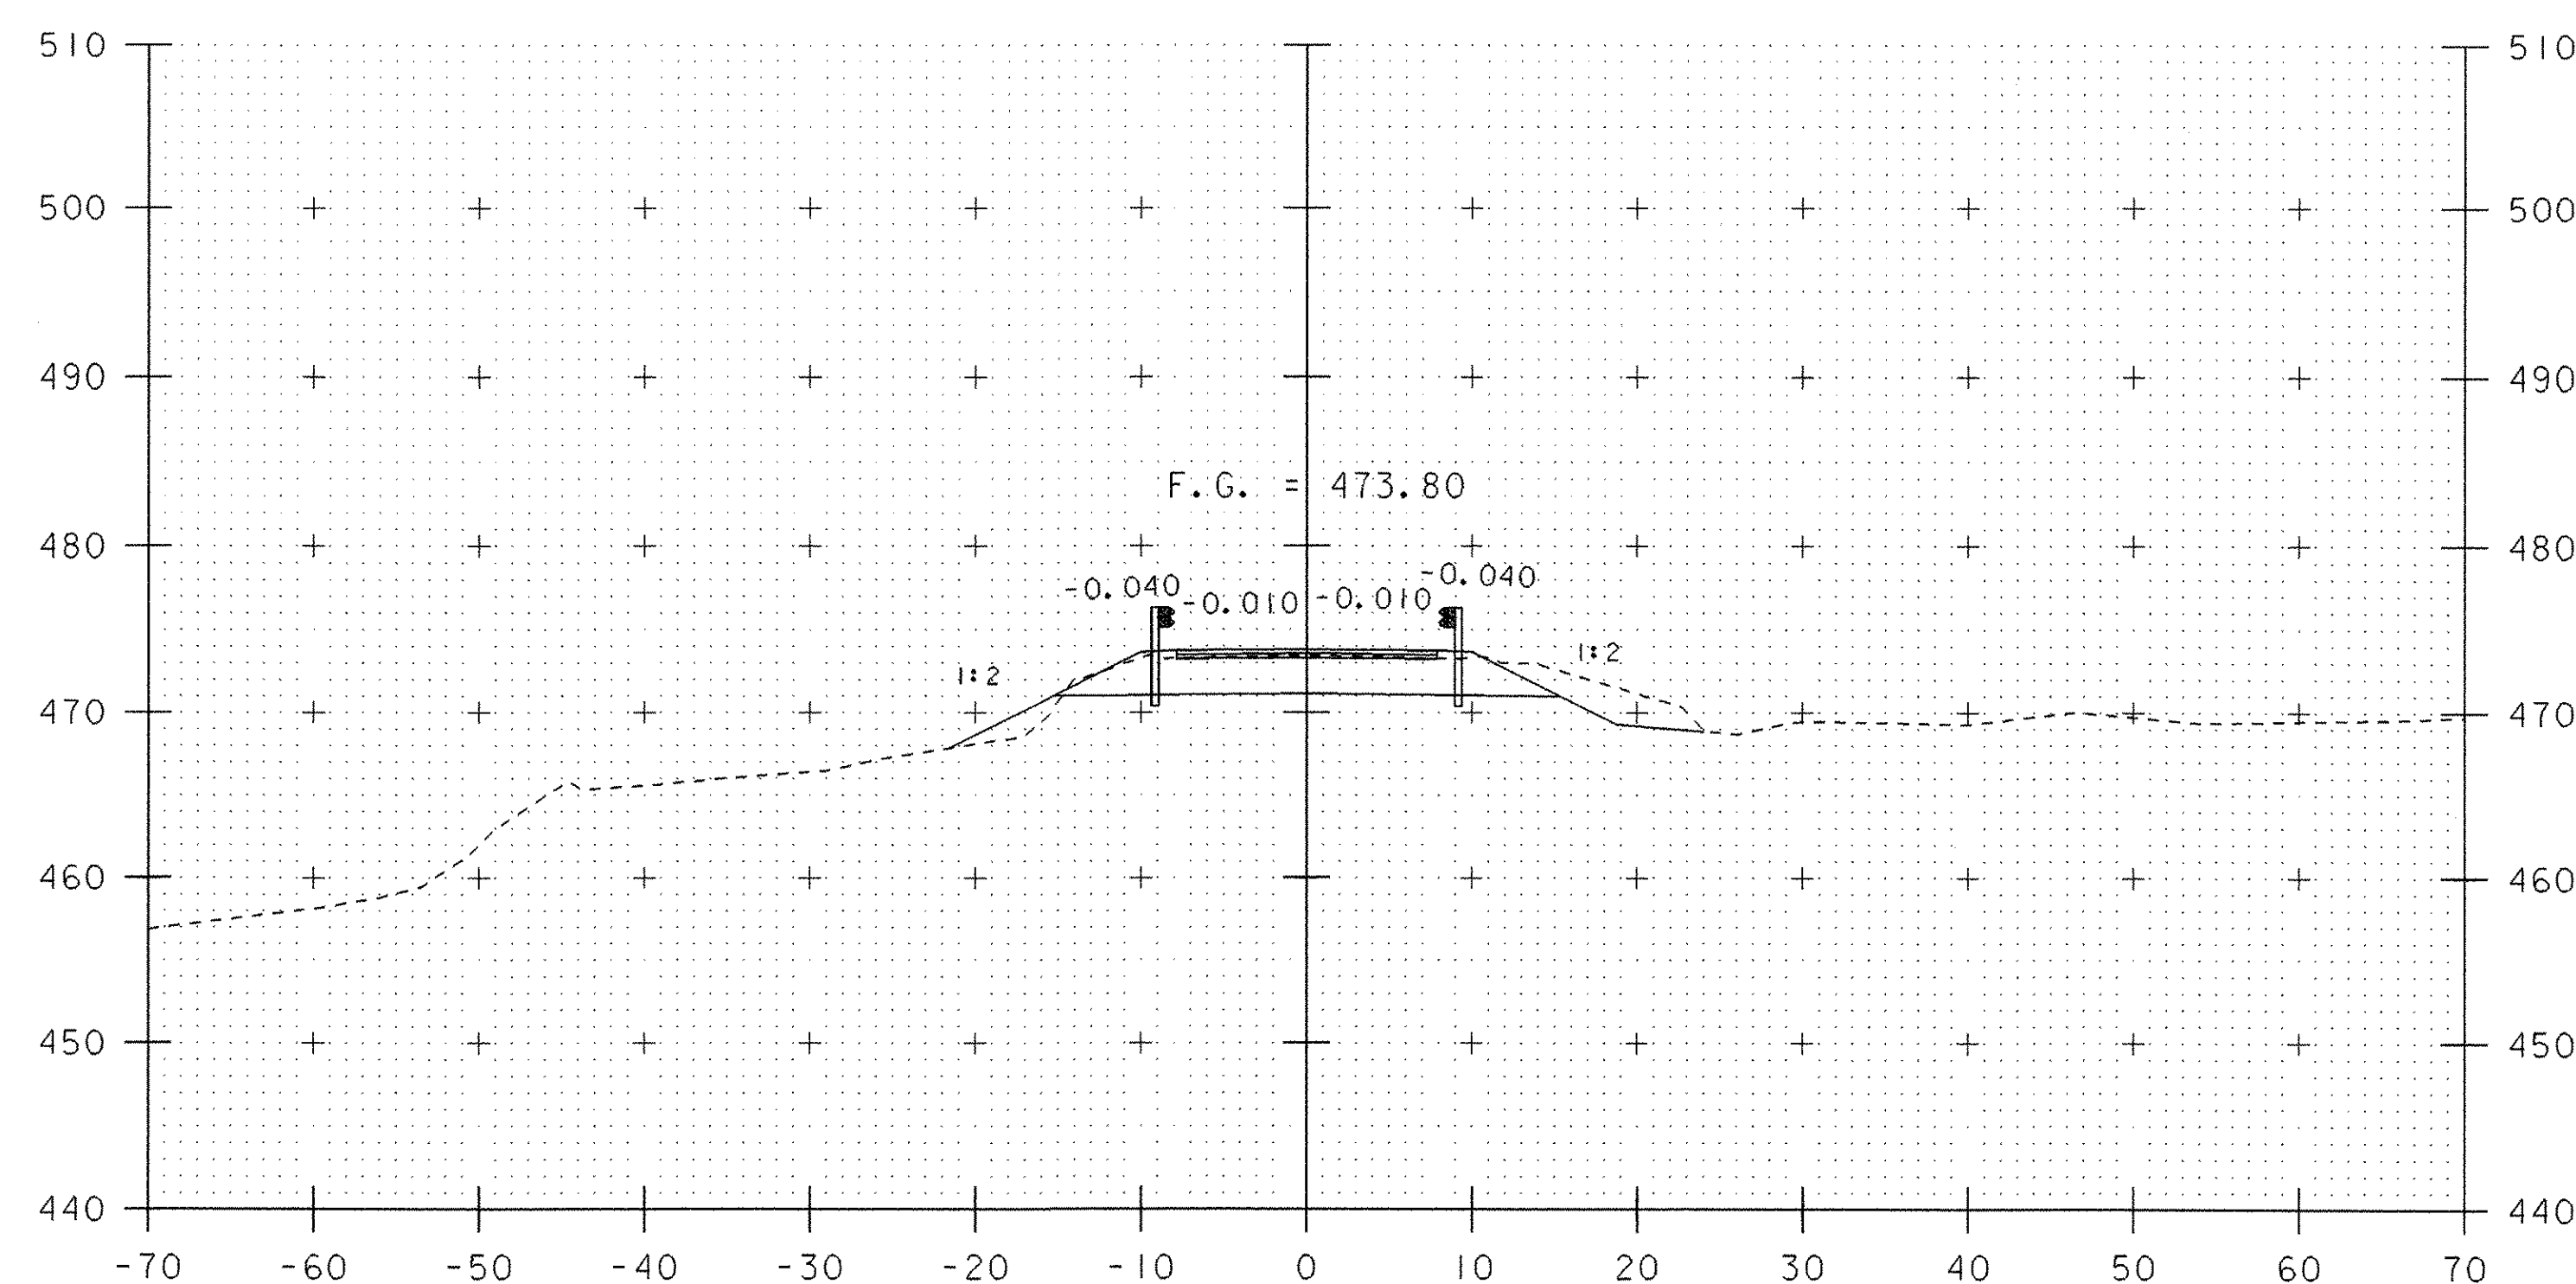


STA 2+35.00 BEGIN PROJECT

2+50

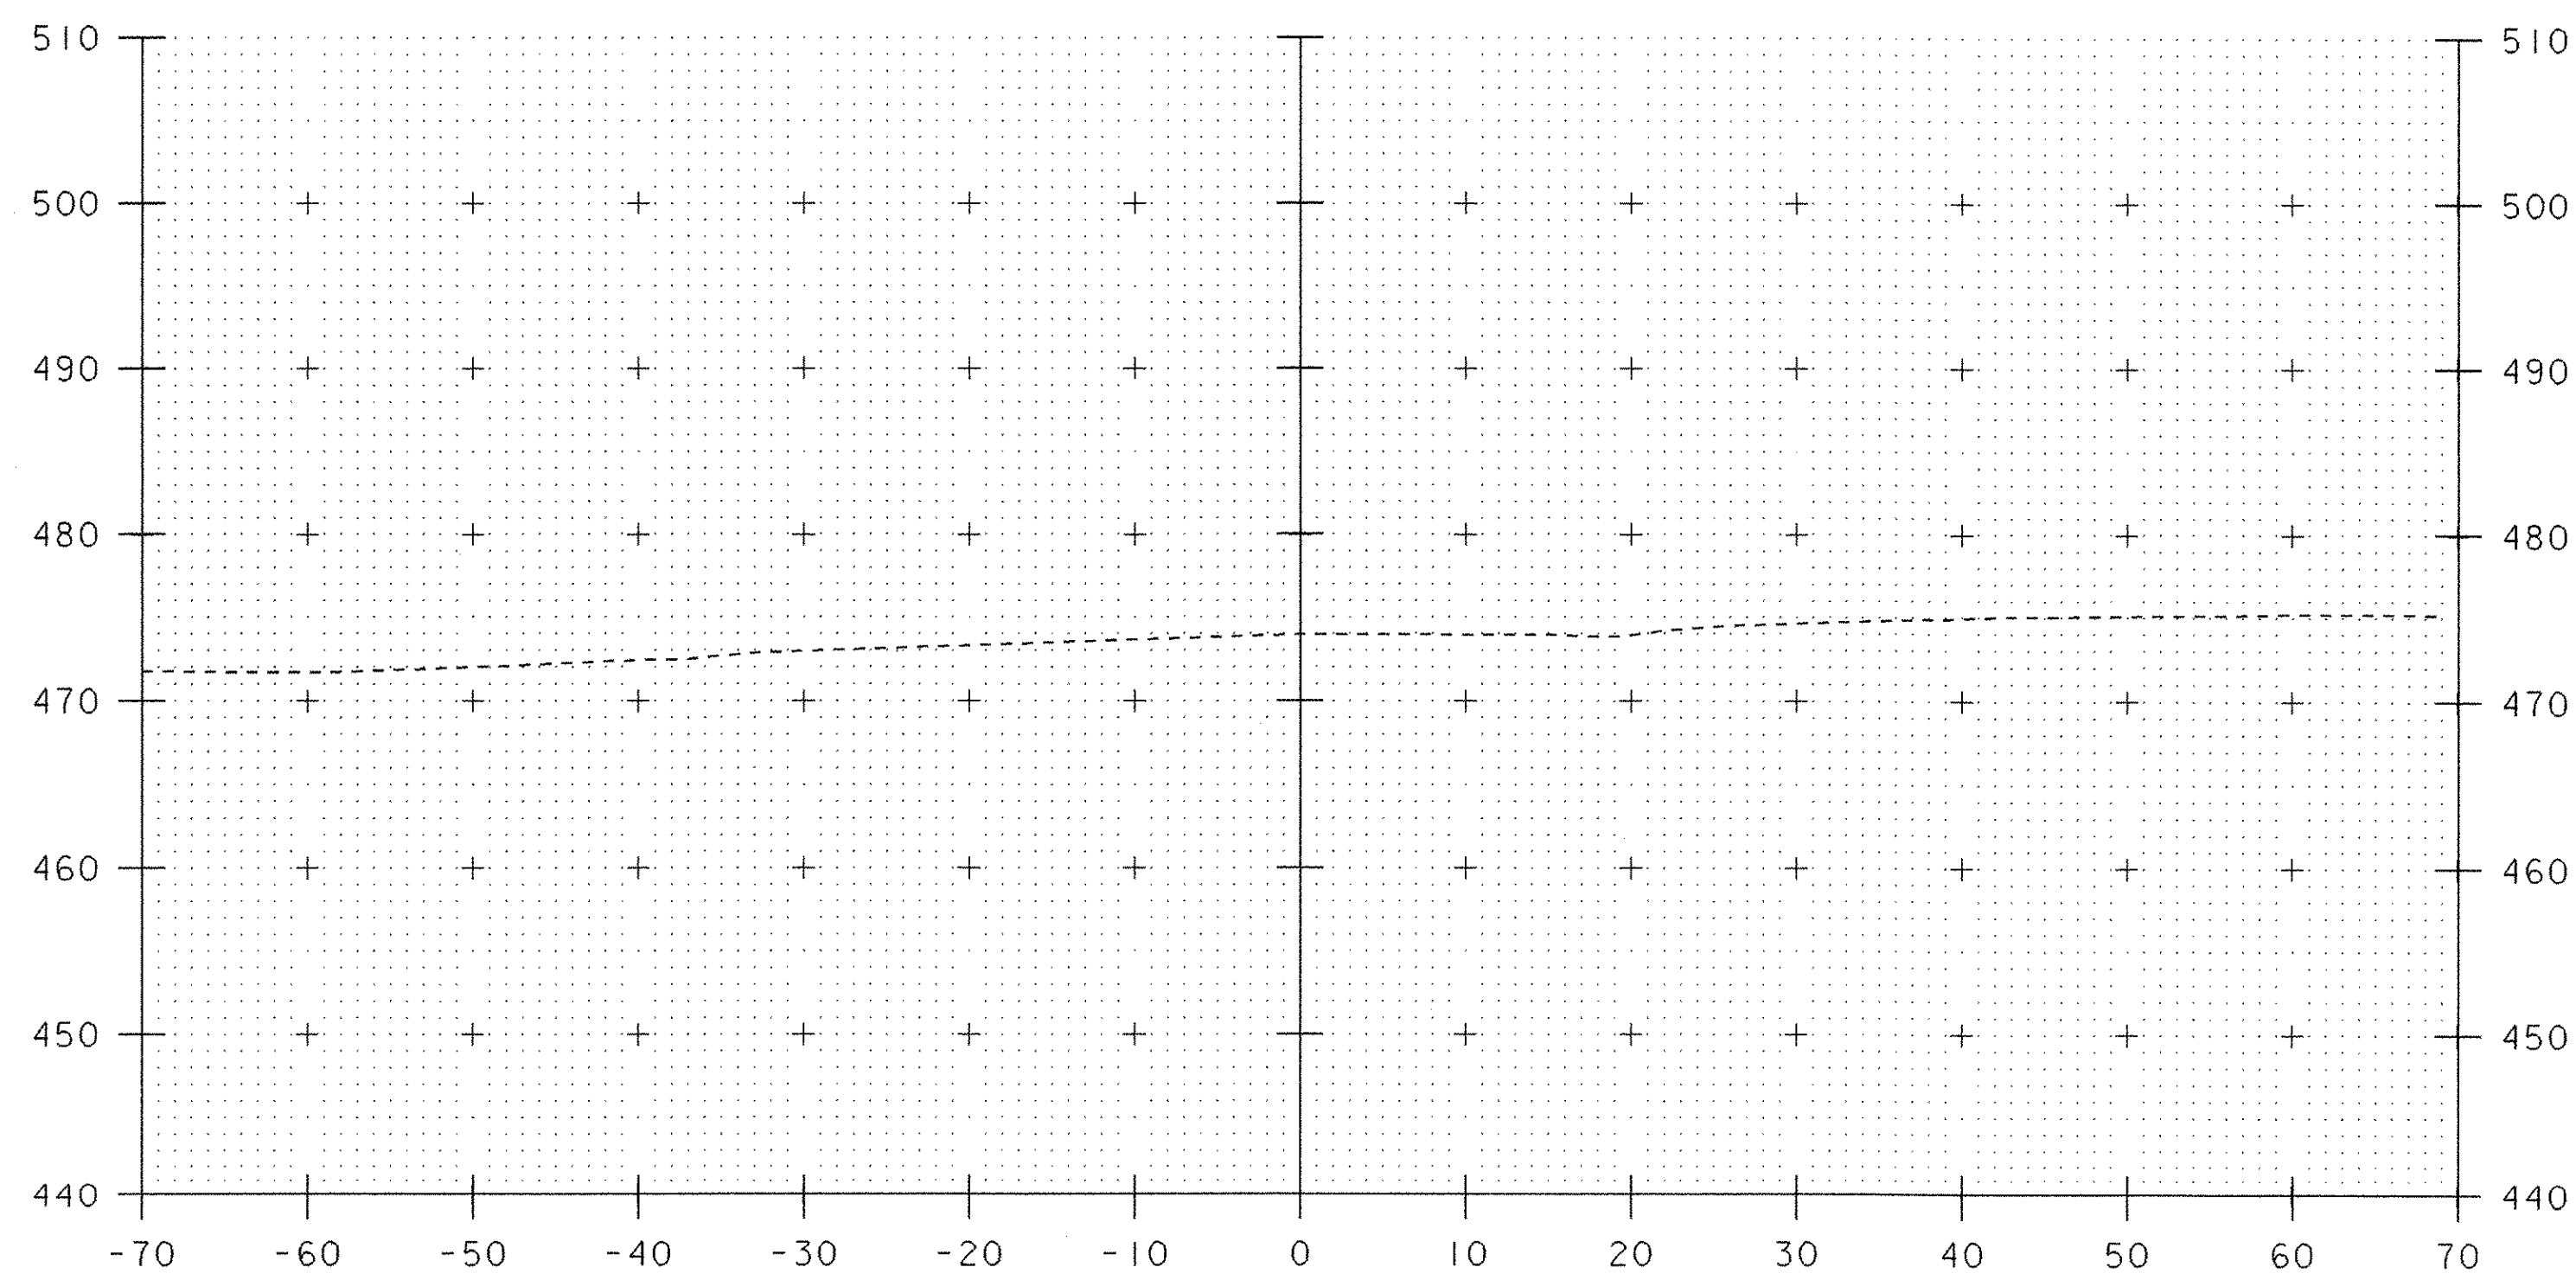


1+00

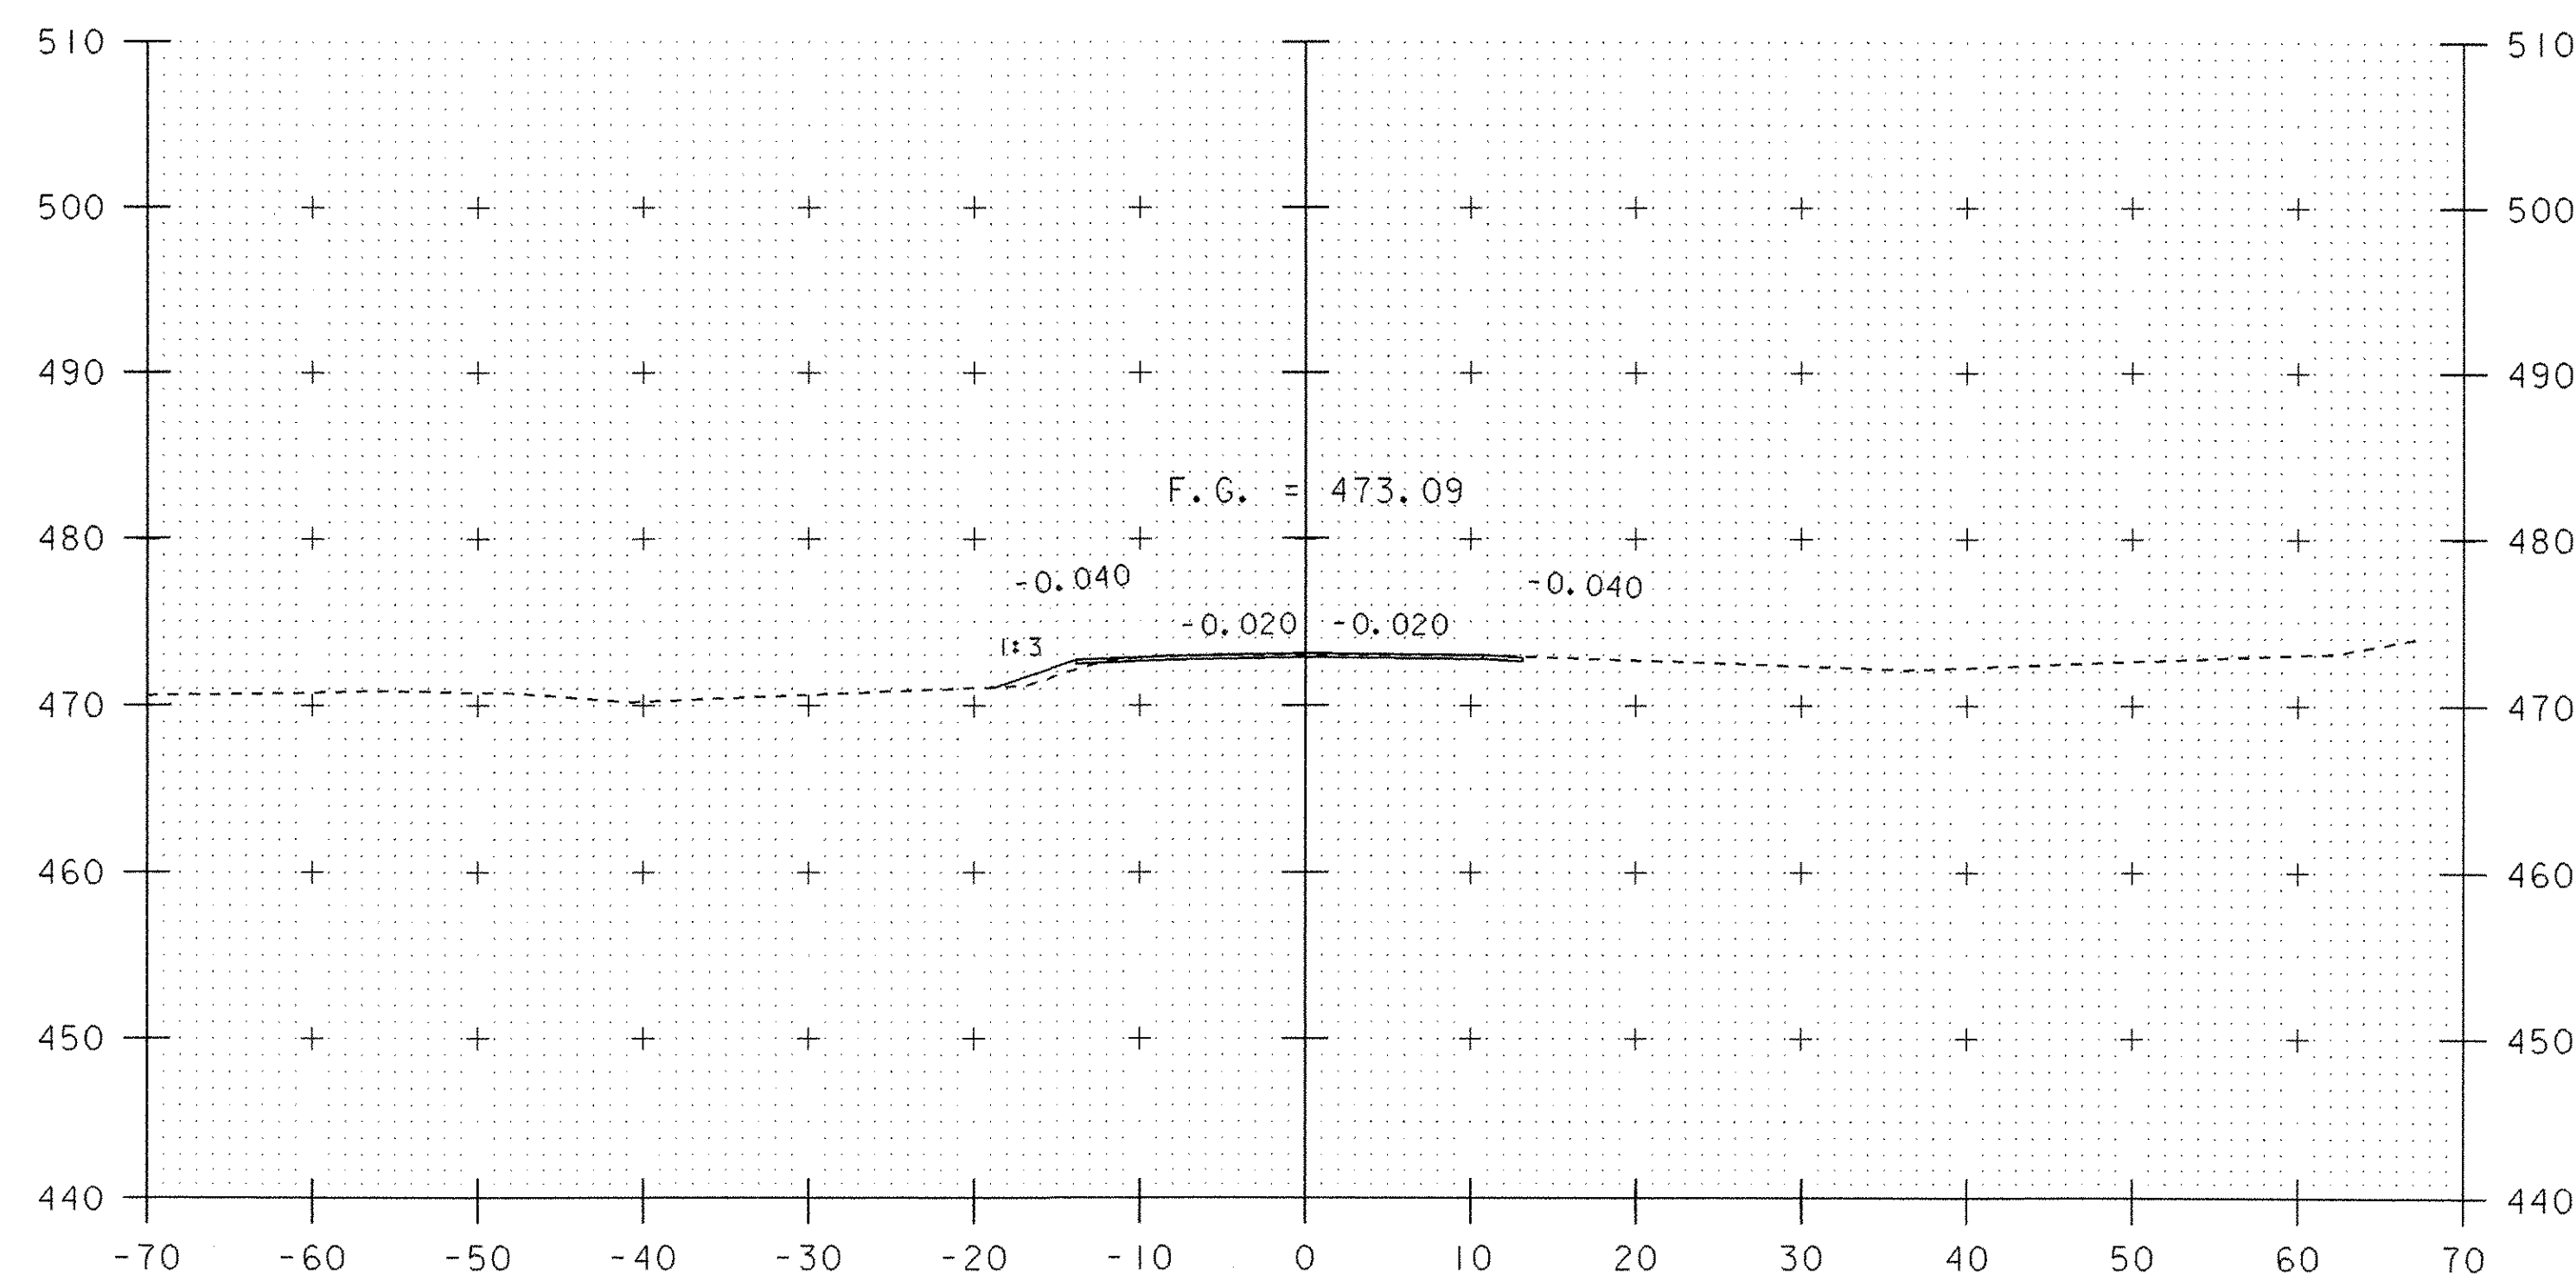

STA 1+75.00 BEGIN APPROACH

2+00

STA. 1+00 TO STA. 2+50

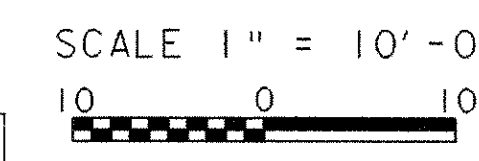

SHEET NAME: MAINLINE SECTIONS STA. 1+00 TO STA. 2+50	
PROJECT NAME: BRADFORD	
PROJECT NUMBER: STP 1447 (28)	
PROJECT LEADER: C.P.WILLIAMS	DRAWN BY: J.WHITE
DESIGNED BY: M.GAGULIC	CHECKED BY: R.S.YOUNG
FILE NAME: 96j286/Str/s96j286xsl.dgn	PLOT DATE: 22-NOV-2006
IPARM FILE NAME: s96j286mxl.l	SHEET 35 OF 63