




5+50

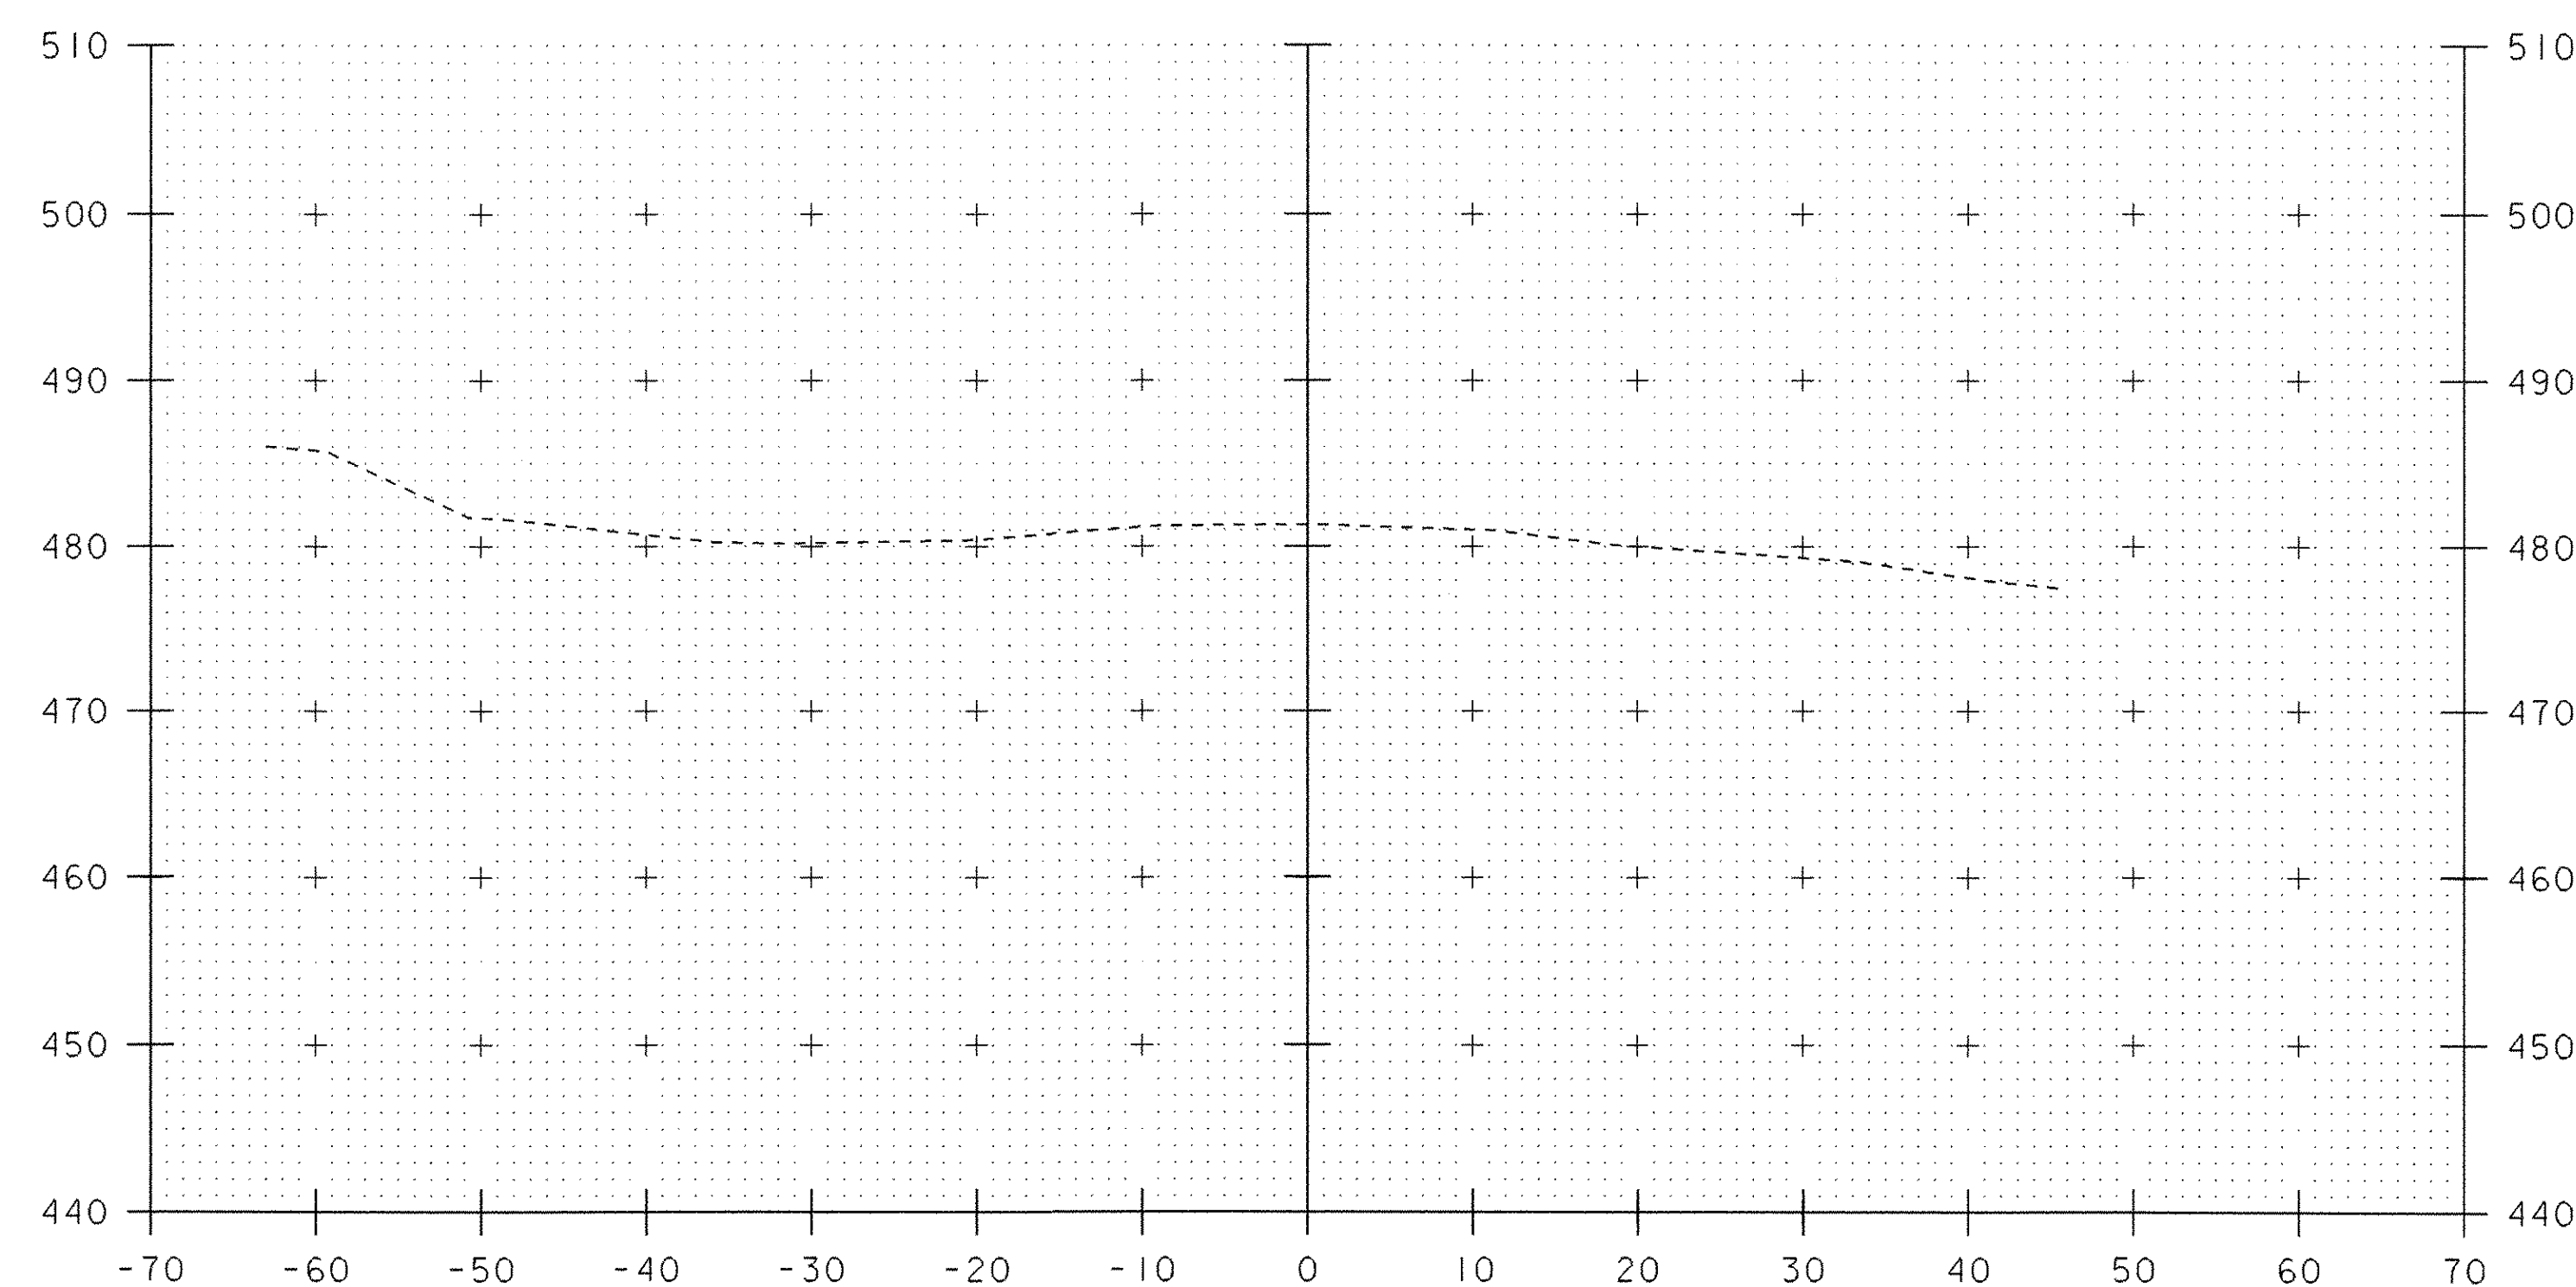

6+11

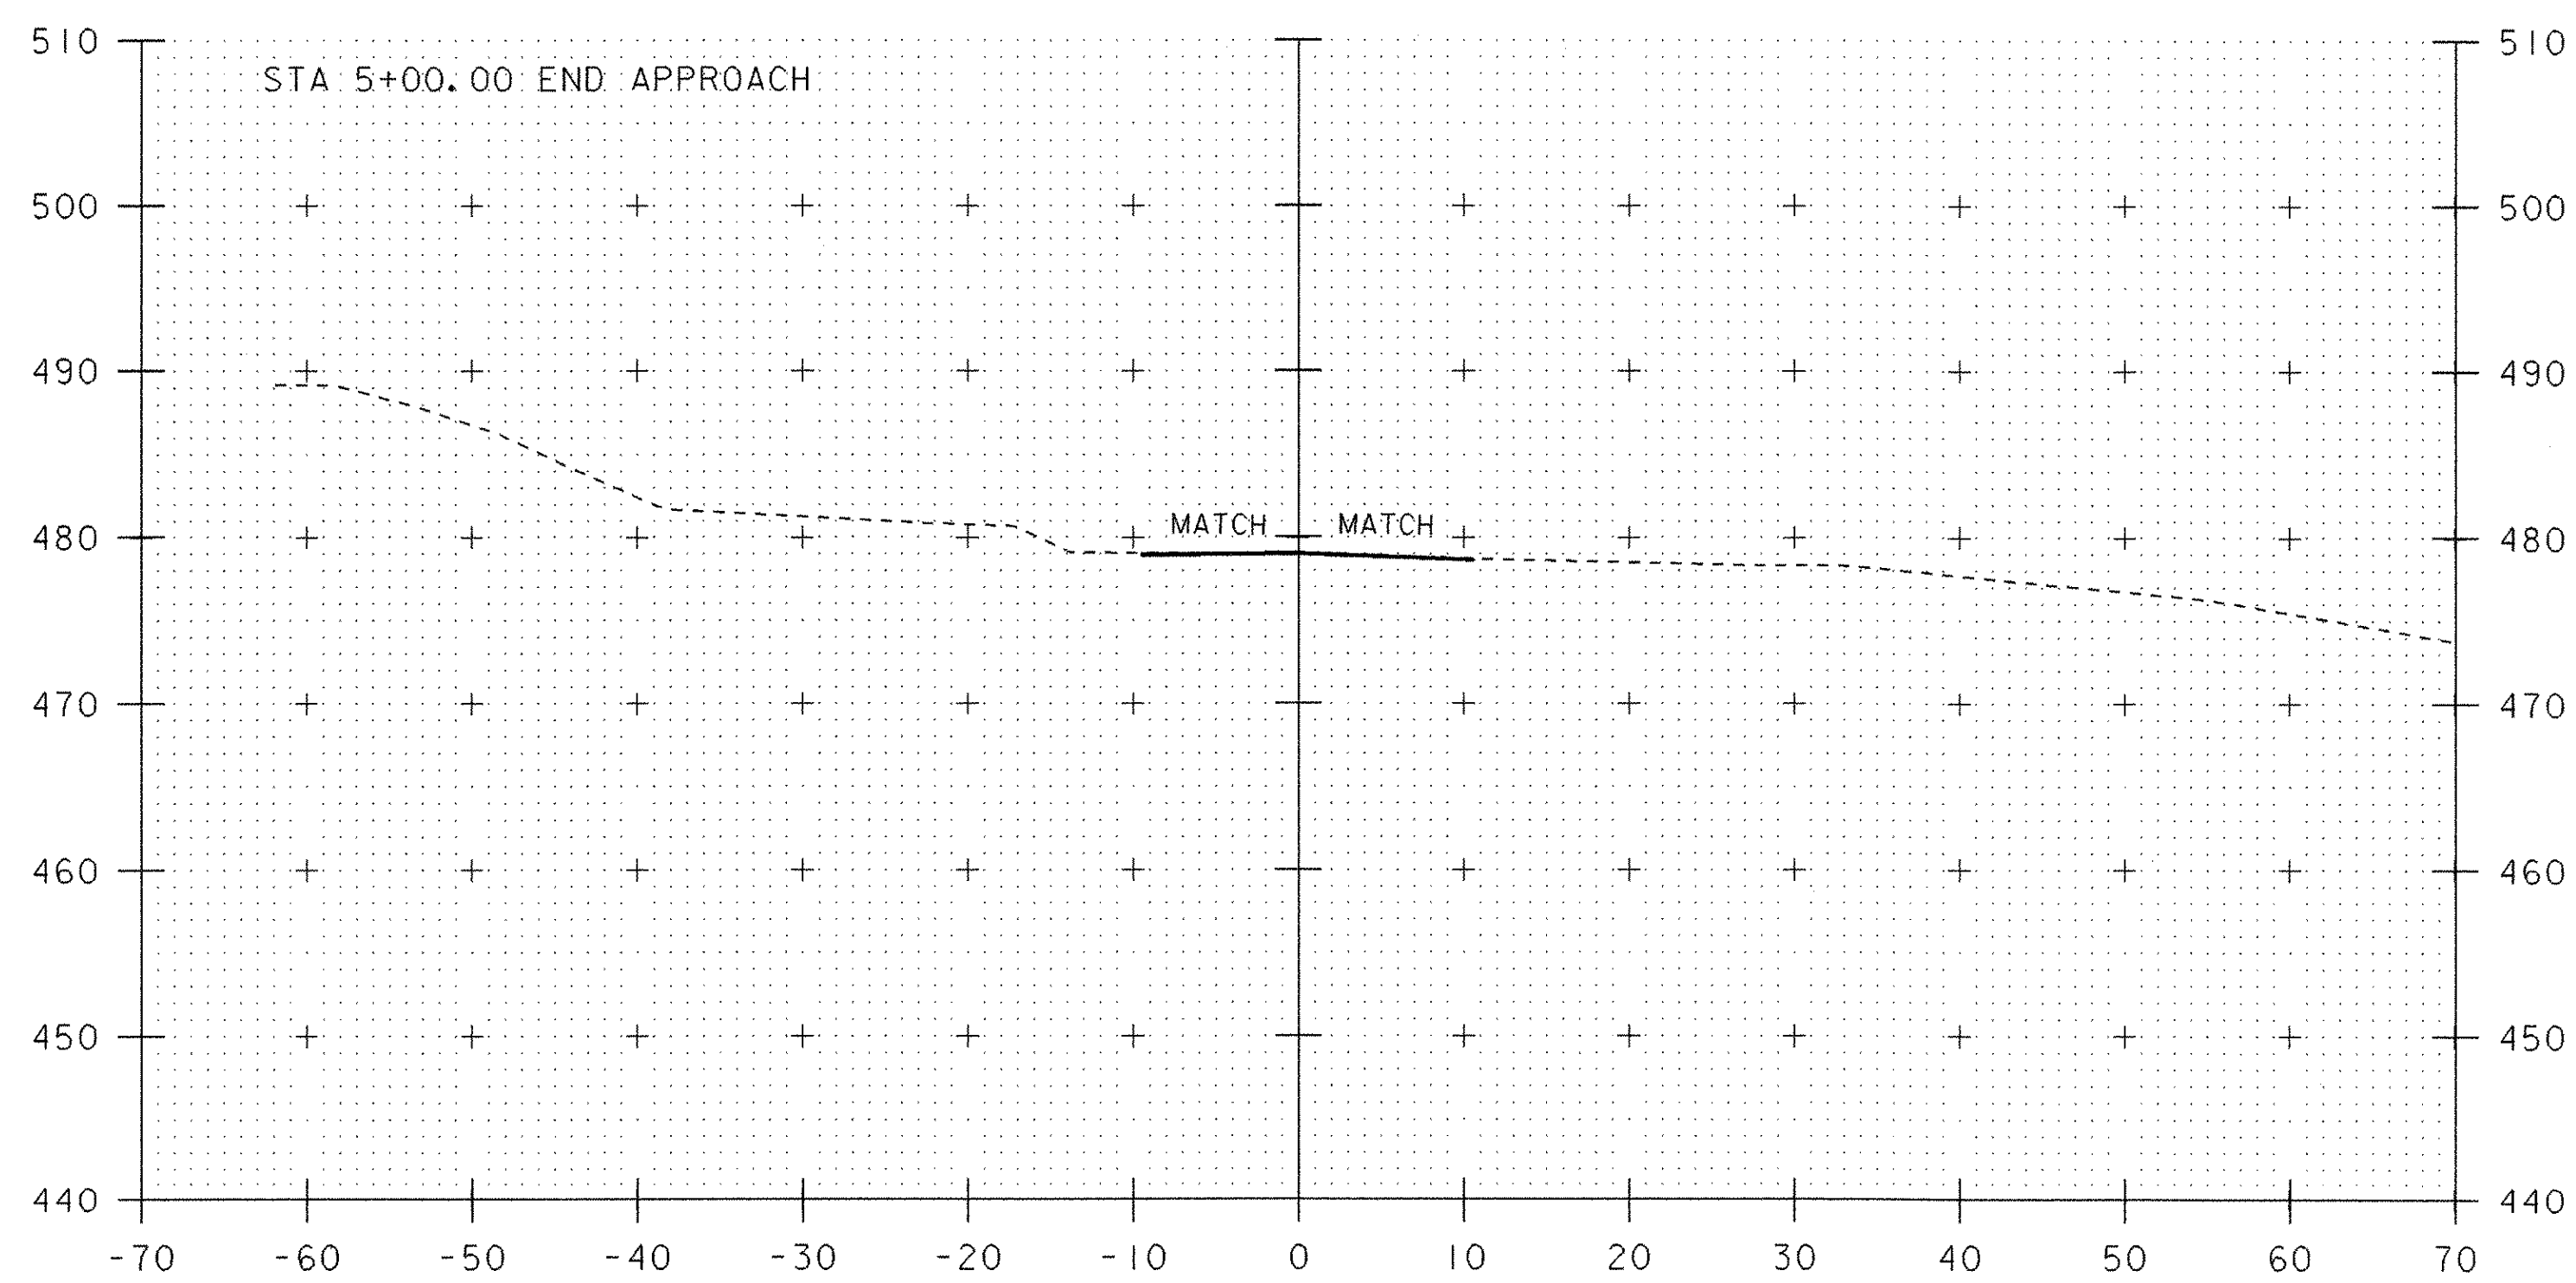

5+00

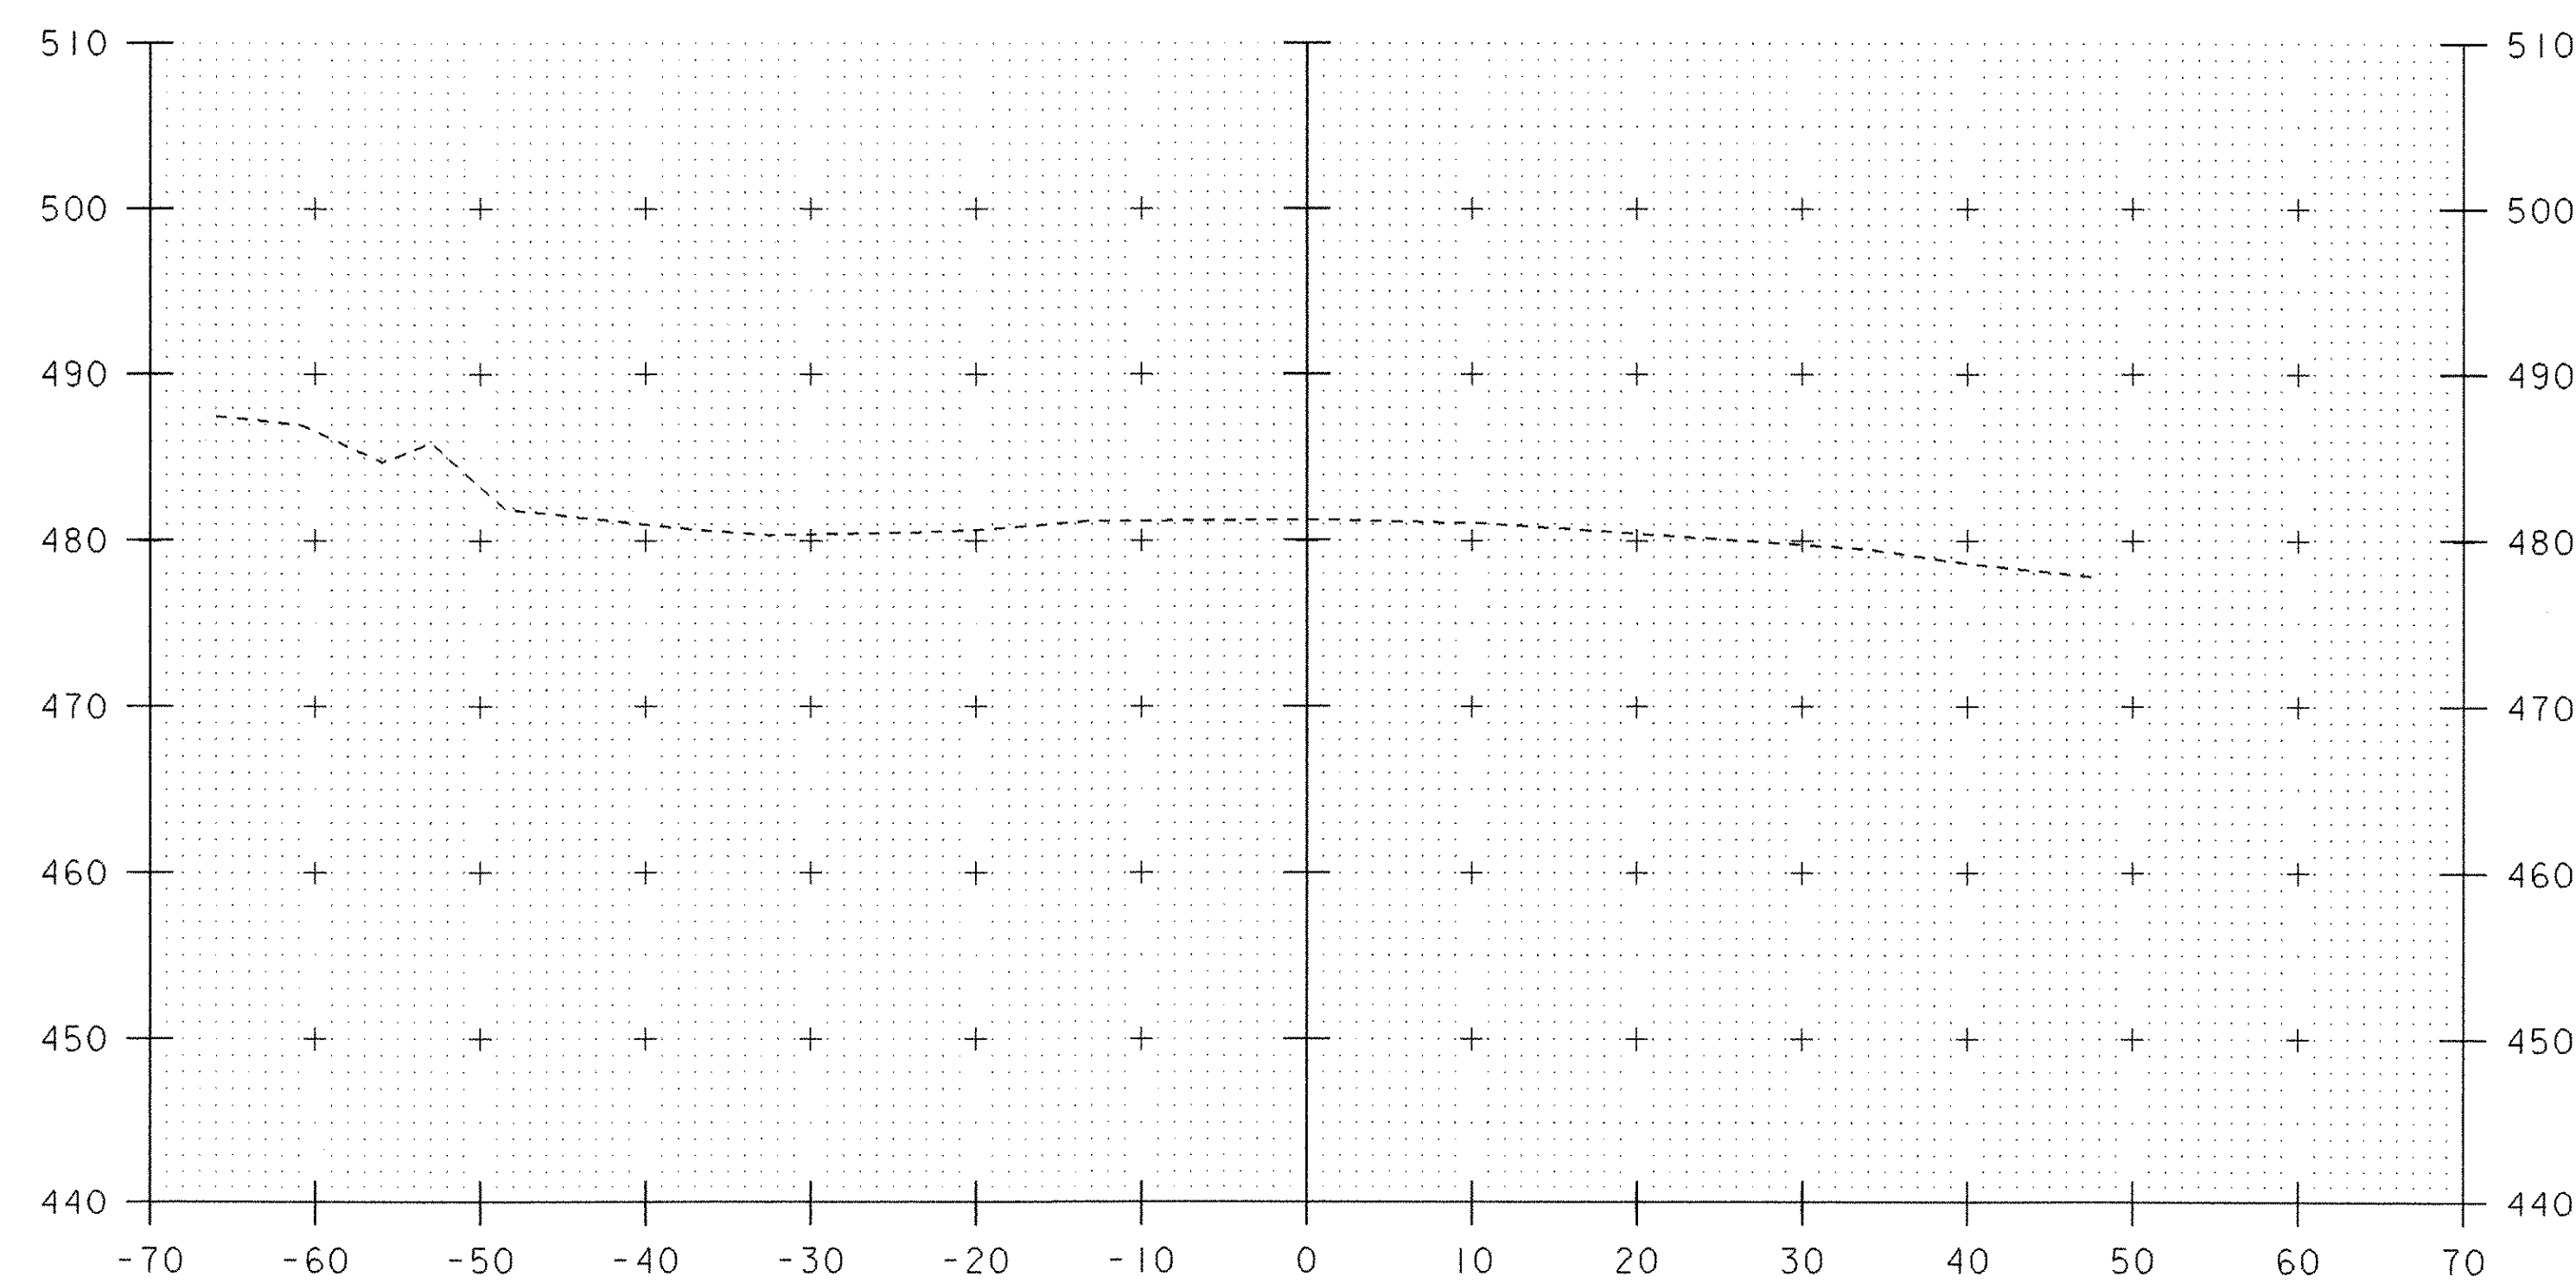

6+00

SHEET NAME: MAINLINE SECTIONS STA. 5+00 TO STA. 6+11	
PROJECT NAME:	BRADFORD
PROJECT NUMBER:	STP 1447 (28)
PROJECT LEADER:	C.P.WILLIAMS
DESIGNED BY:	M.GAGULIC
FILE NAME:	96J286/Str/s96J286xsl.dgn
IPARM FILE NAME:	s96J286mx3.i
DRAWN BY:	J.WHITE
CHECKED BY:	R.S.YOUNG
PLOT DATE:	22-NOV-2006
SHEET	37 OF 63

SCALE 1" = 10' - 0

STA. 5+00 TO STA. 6+11