


STA 19+76.30 LT (ABUTMENT 1)
 BEGIN STONE FILL TYPE III
 BEGIN GEOTEXTILE UNDER STONE FILL
 BEGIN GRUBBING MATERIAL
 BEGIN UNCLASSIFIED CHANNEL EXCAVATION

19+80

STA 19+78.50 RT (ABUTMENT 2)
 BEGIN STONE FILL TYPE III
 BEGIN GRUBBING MATERIAL
 BEGIN GEOTEXTILE UNDER STONE FILL
 BEGIN UNCLASSIFIED CHANNEL EXCAVATION

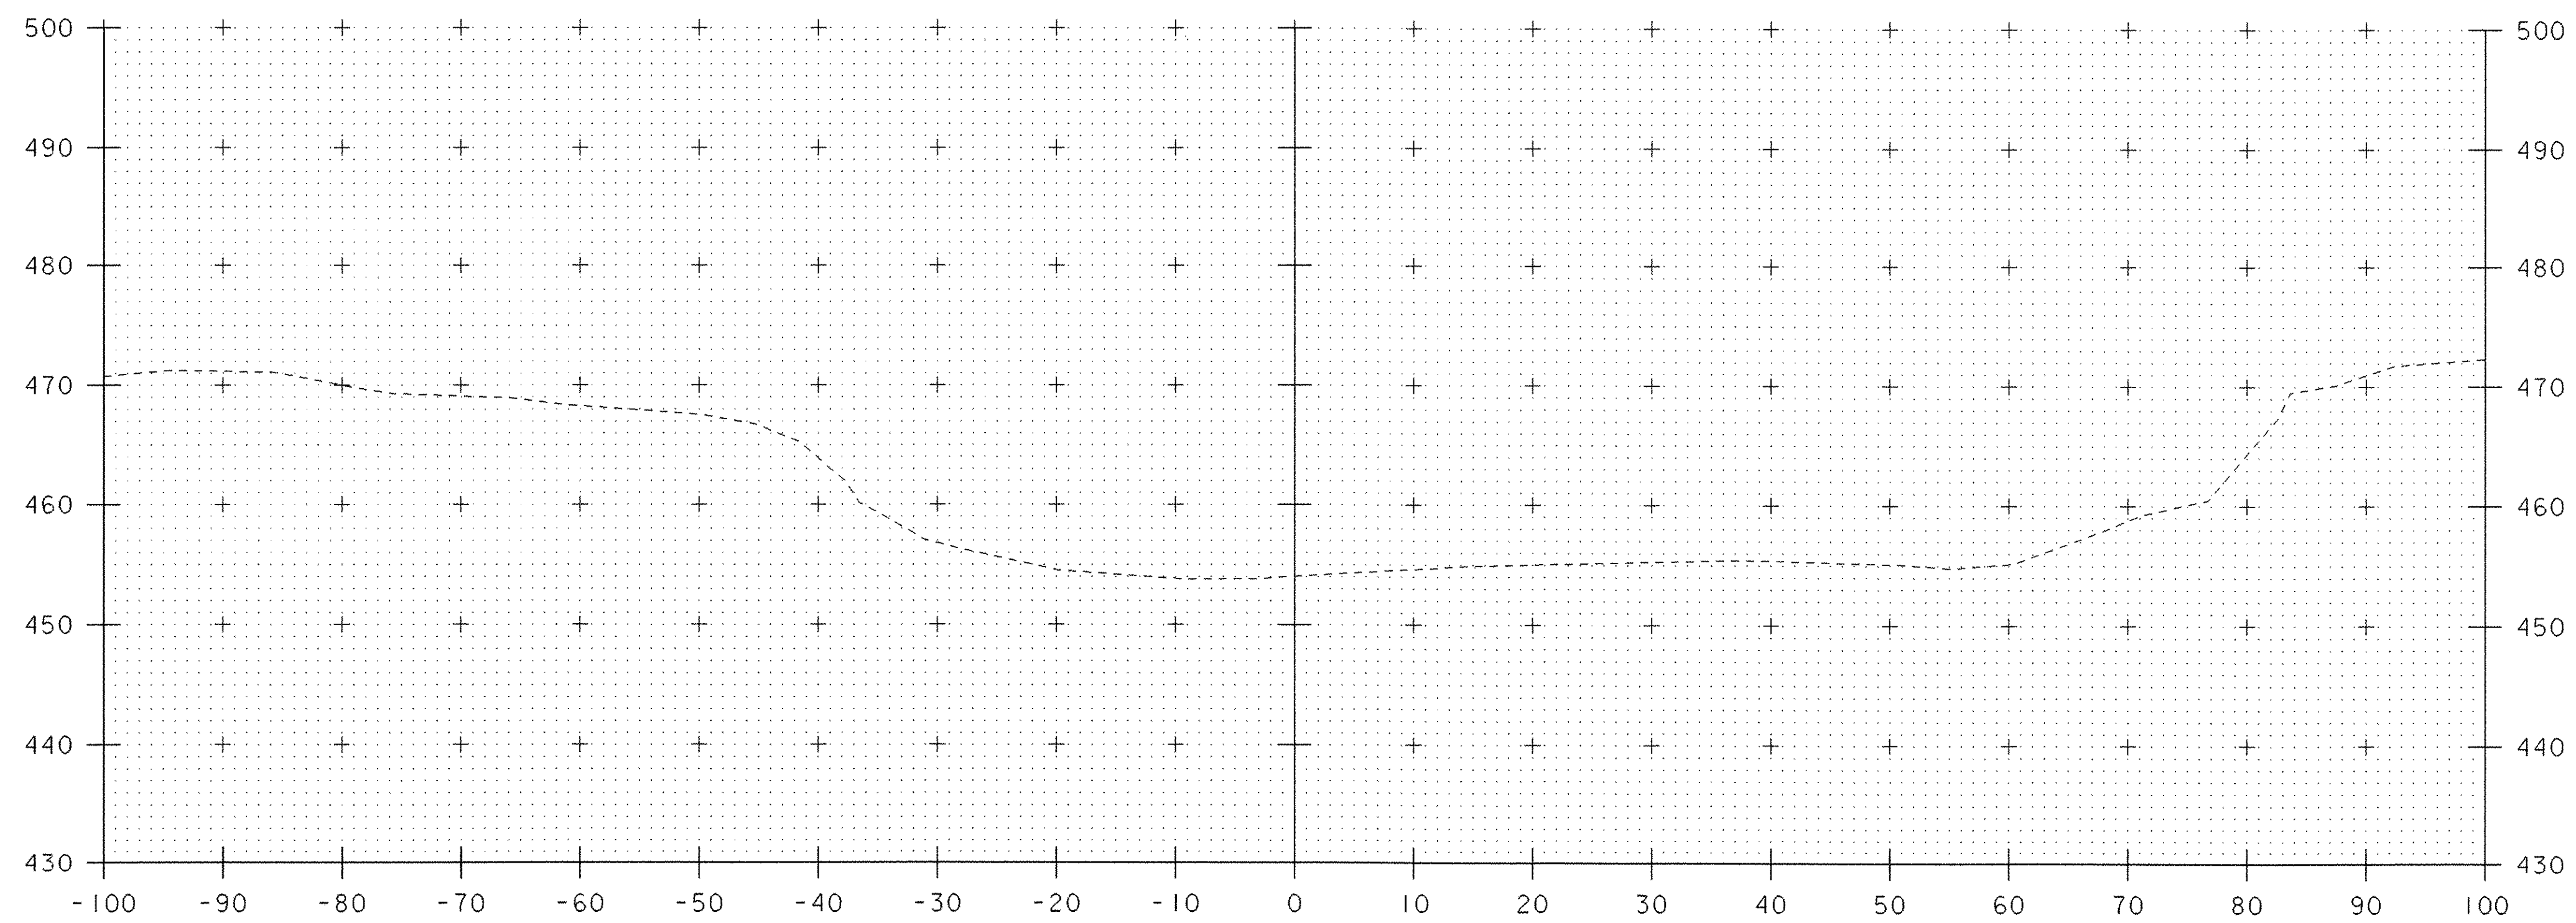

19+60

SHEET NAME: CHANNEL SECTIONS STA. 19+60 TO STA. 19+80	
PROJECT NAME: BRADFORD	
PROJECT NUMBER: STP 1447 (28)	
PROJECT LEADER: C.P.WILLIAMS	DRAWN BY: J. WHITE
DESIGNED BY: M. GAGULIC	CHECKED BY: R.S.YOUNG
FILE NAME: 96j286/Str/s96j286xsl.dgn	PLOT DATE: 22-NOV-2006
IPARM FILE NAME: s96j286chx3.i	SHEET 39 OF 63

SCALE 1" = 10'-0"
 10 0 10

STA. 19+60 TO STA. 19+80