



20+00

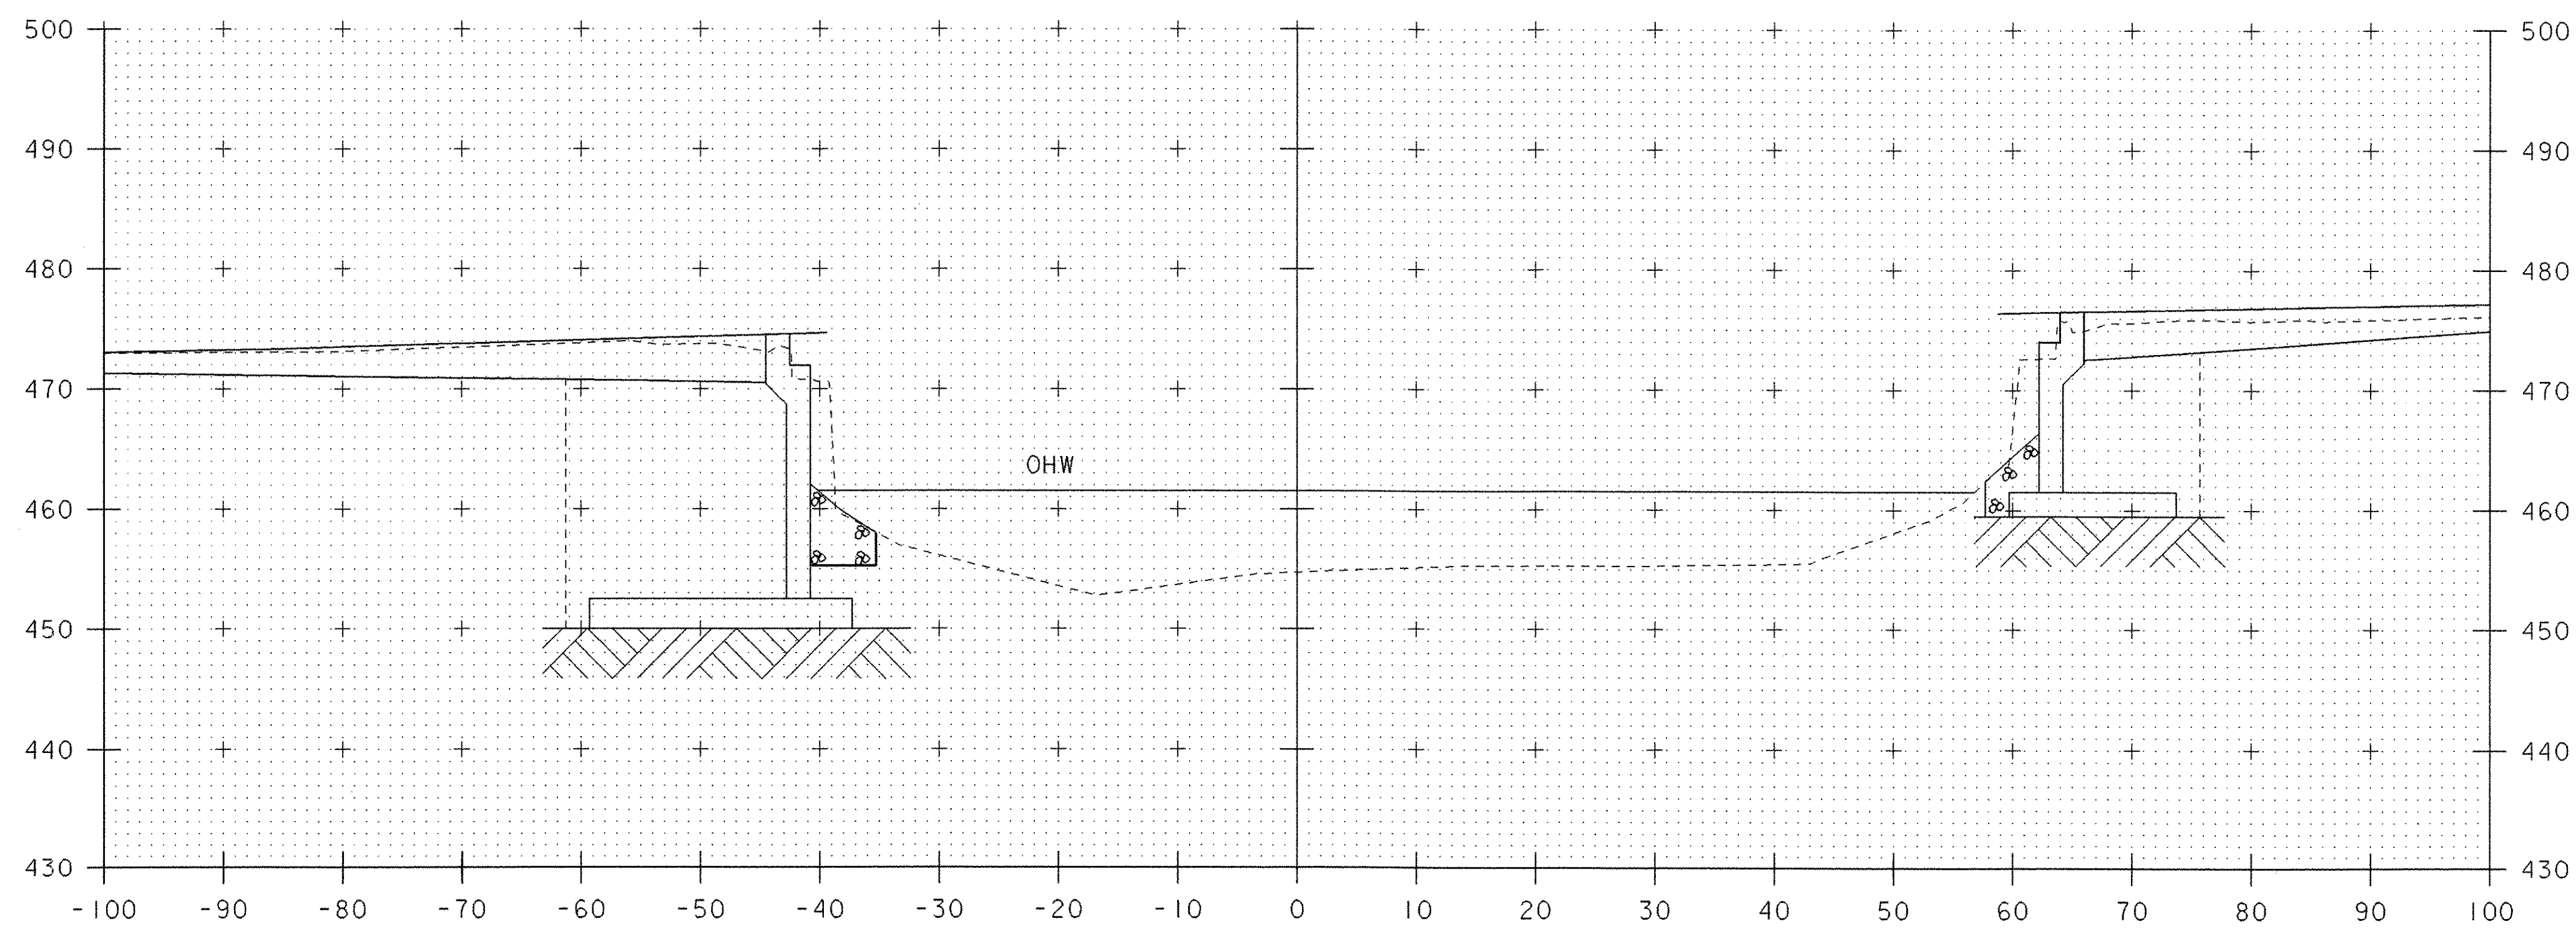

19+90

STA. 19+90 TO STA. 20+00

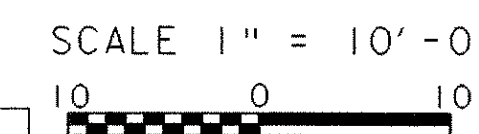

SHEET NAME: CHANNEL SECTIONS STA. 19+90 TO STA. 20+00	
PROJECT NAME: BRADFORD	
PROJECT NUMBER: STP 1447 (28)	
PROJECT LEADER: C.P.WILLIAMS	DRAWN BY: J. WHITE
DESIGNED BY: M. GAGULIC	CHECKED BY: R.S.YOUNG
FILE NAME: 96j286/Str/s96j286xsl.dgn	PLOT DATE: 22-NOV-2006
IPARM FILE NAME: s96j286chx3.i	SHEET 40 OF 63