



STA 20+24.00 LT (ABUTMENT 1)
 END STONE FILL TYPE III
 END GEOTEXTILE UNDER STONE FILL
 END GRUBBING MATERIAL
 END UNCLASSIFIED CHANNEL EXCAVATION

STA 20+24.90 RT (ABUTMENT 2)
 END STONE FILL TYPE III
 END GEOTEXTILE UNDER STONE FILL
 END UNCLASSIFIED CHANNEL EXCAVATION

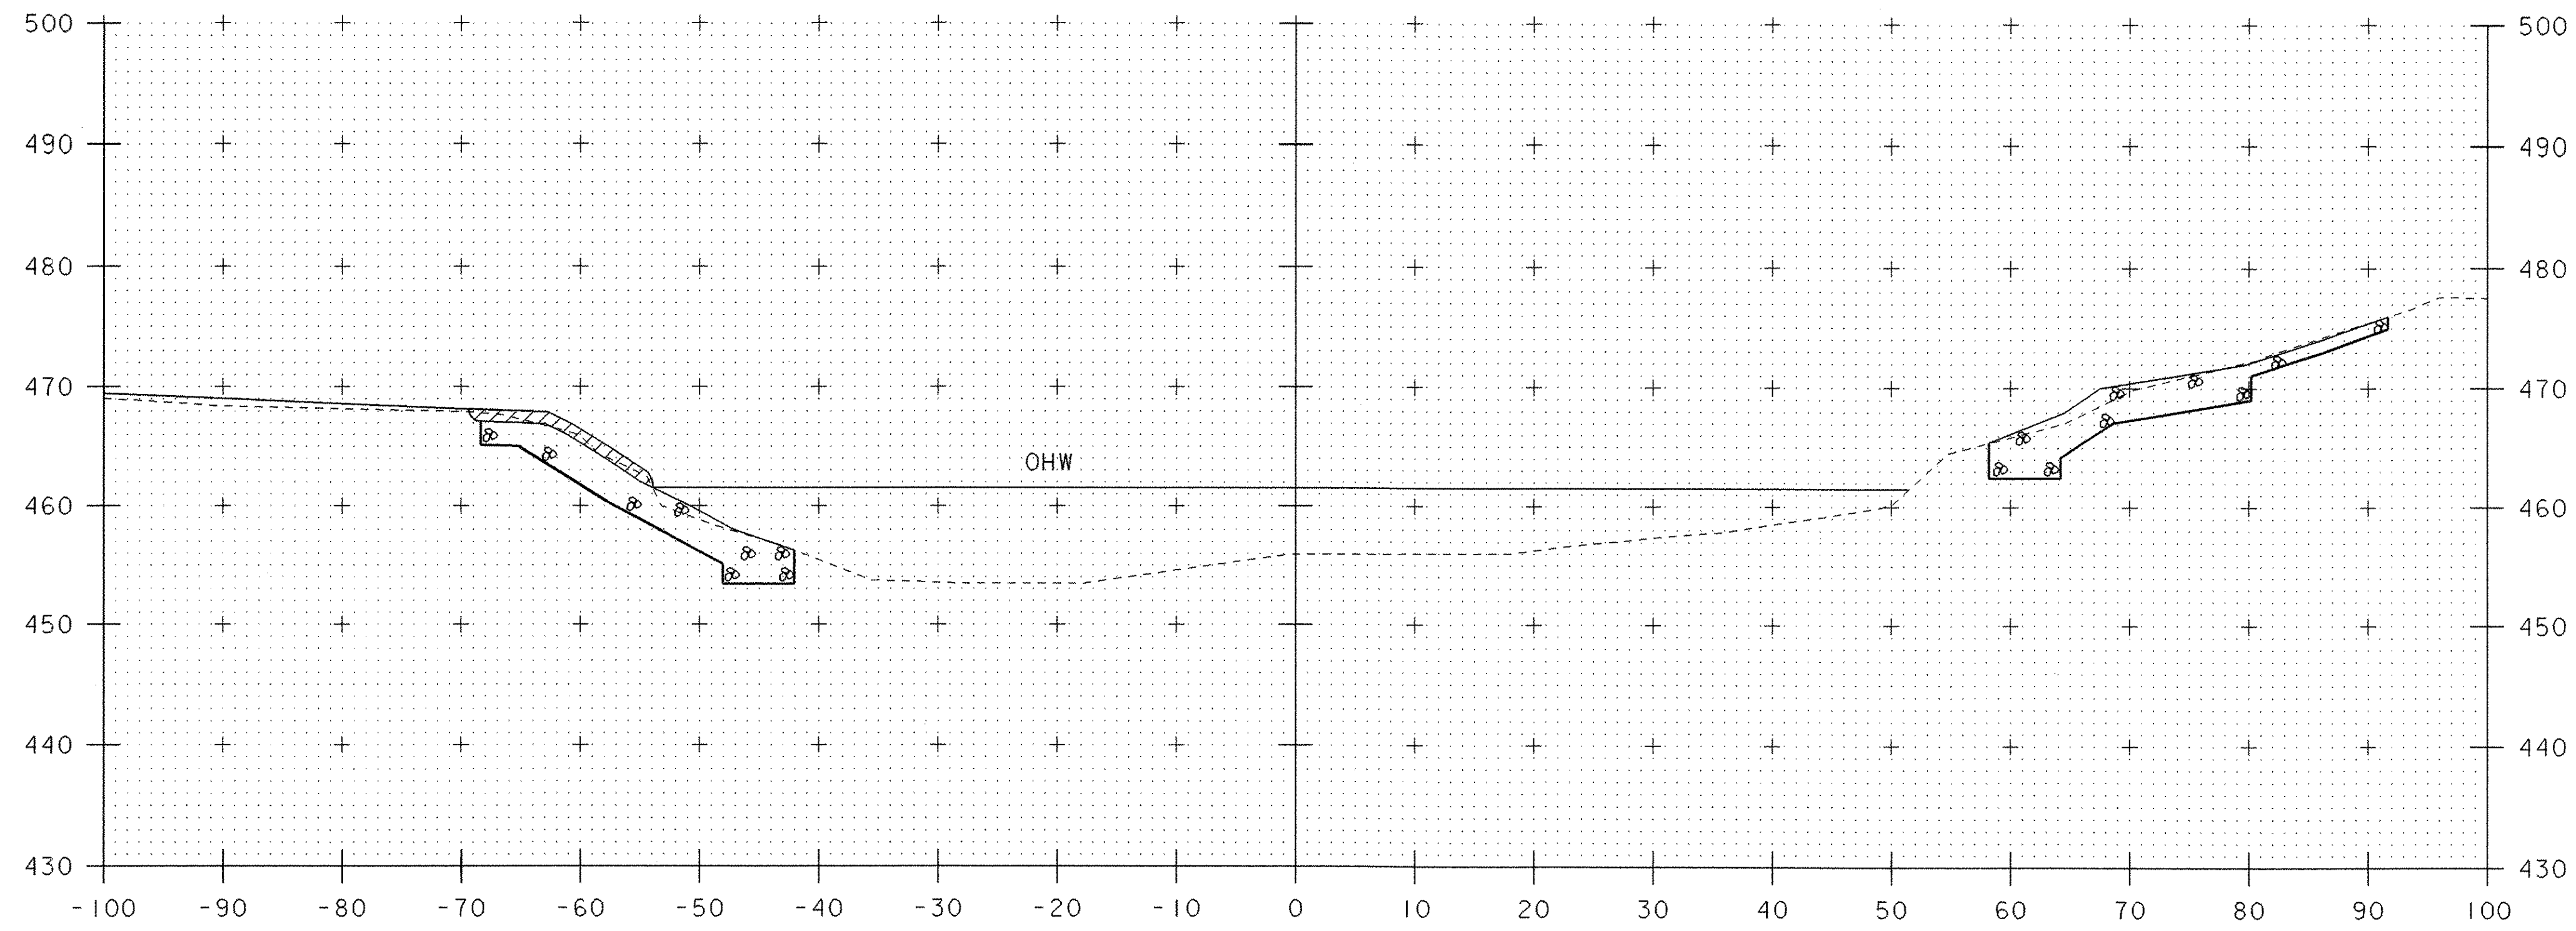

20+20

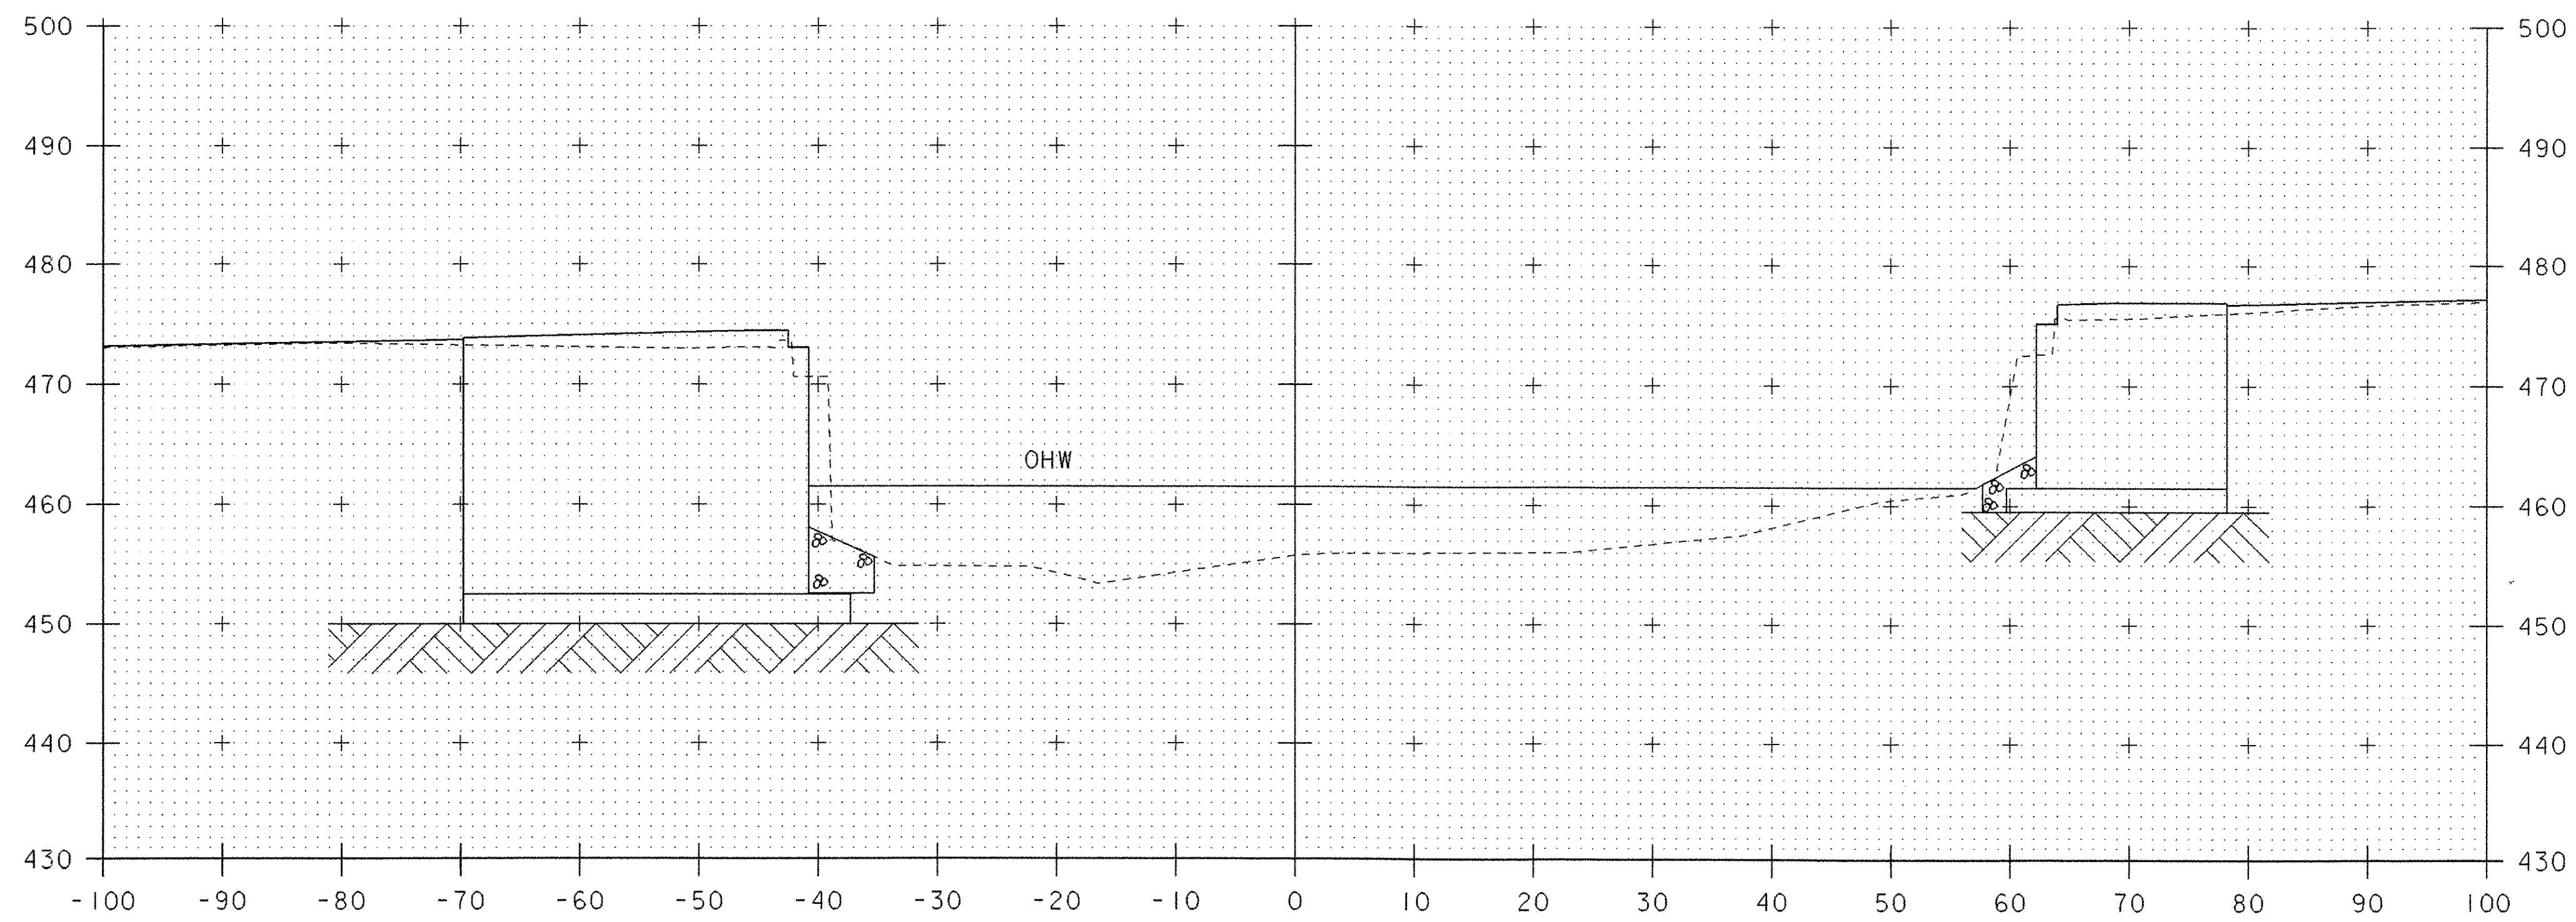

20+10

STA. 20+10 TO STA. 20+20



SHEET NAME: CHANNEL SECTIONS STA. 20+10 TO STA. 20+20

PROJECT NAME: BRADFORD
 PROJECT NUMBER: STP 1447 (28)

PROJECT LEADER: C.P.WILLIAMS
 DESIGNED BY: M. GAGULIC
 FILE NAME: 96j286/Str/s96j286xsl.dgn
 IPARM FILE NAME: s96j286chx4.i

DRAWN BY: J. WHITE
 CHECKED BY: R.S.YOUNG
 PLOT DATE: 22-NOV-2006
 SHEET 41 OF 63