



SEE SHEET 2 FOR INDEX OF SHEETS AND LIST OF STANDARDS

STATE OF VERMONT AGENCY OF TRANSPORTATION

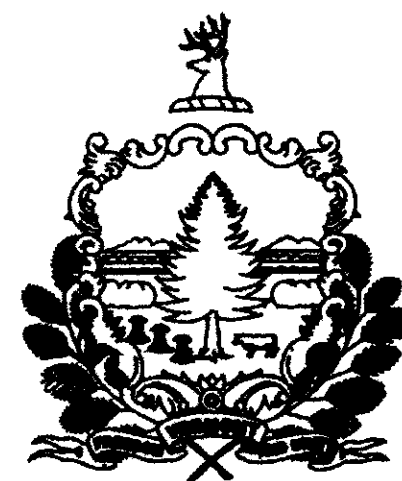

PROPOSED IMPROVEMENT BRIDGE PROJECT TOWN OF MONTGOMERY COUNTY OF FRANKLIN T.H. 27 (CLASS 3) BRIDGE NO. 34

MONTGOMERY BHO 1448(23)


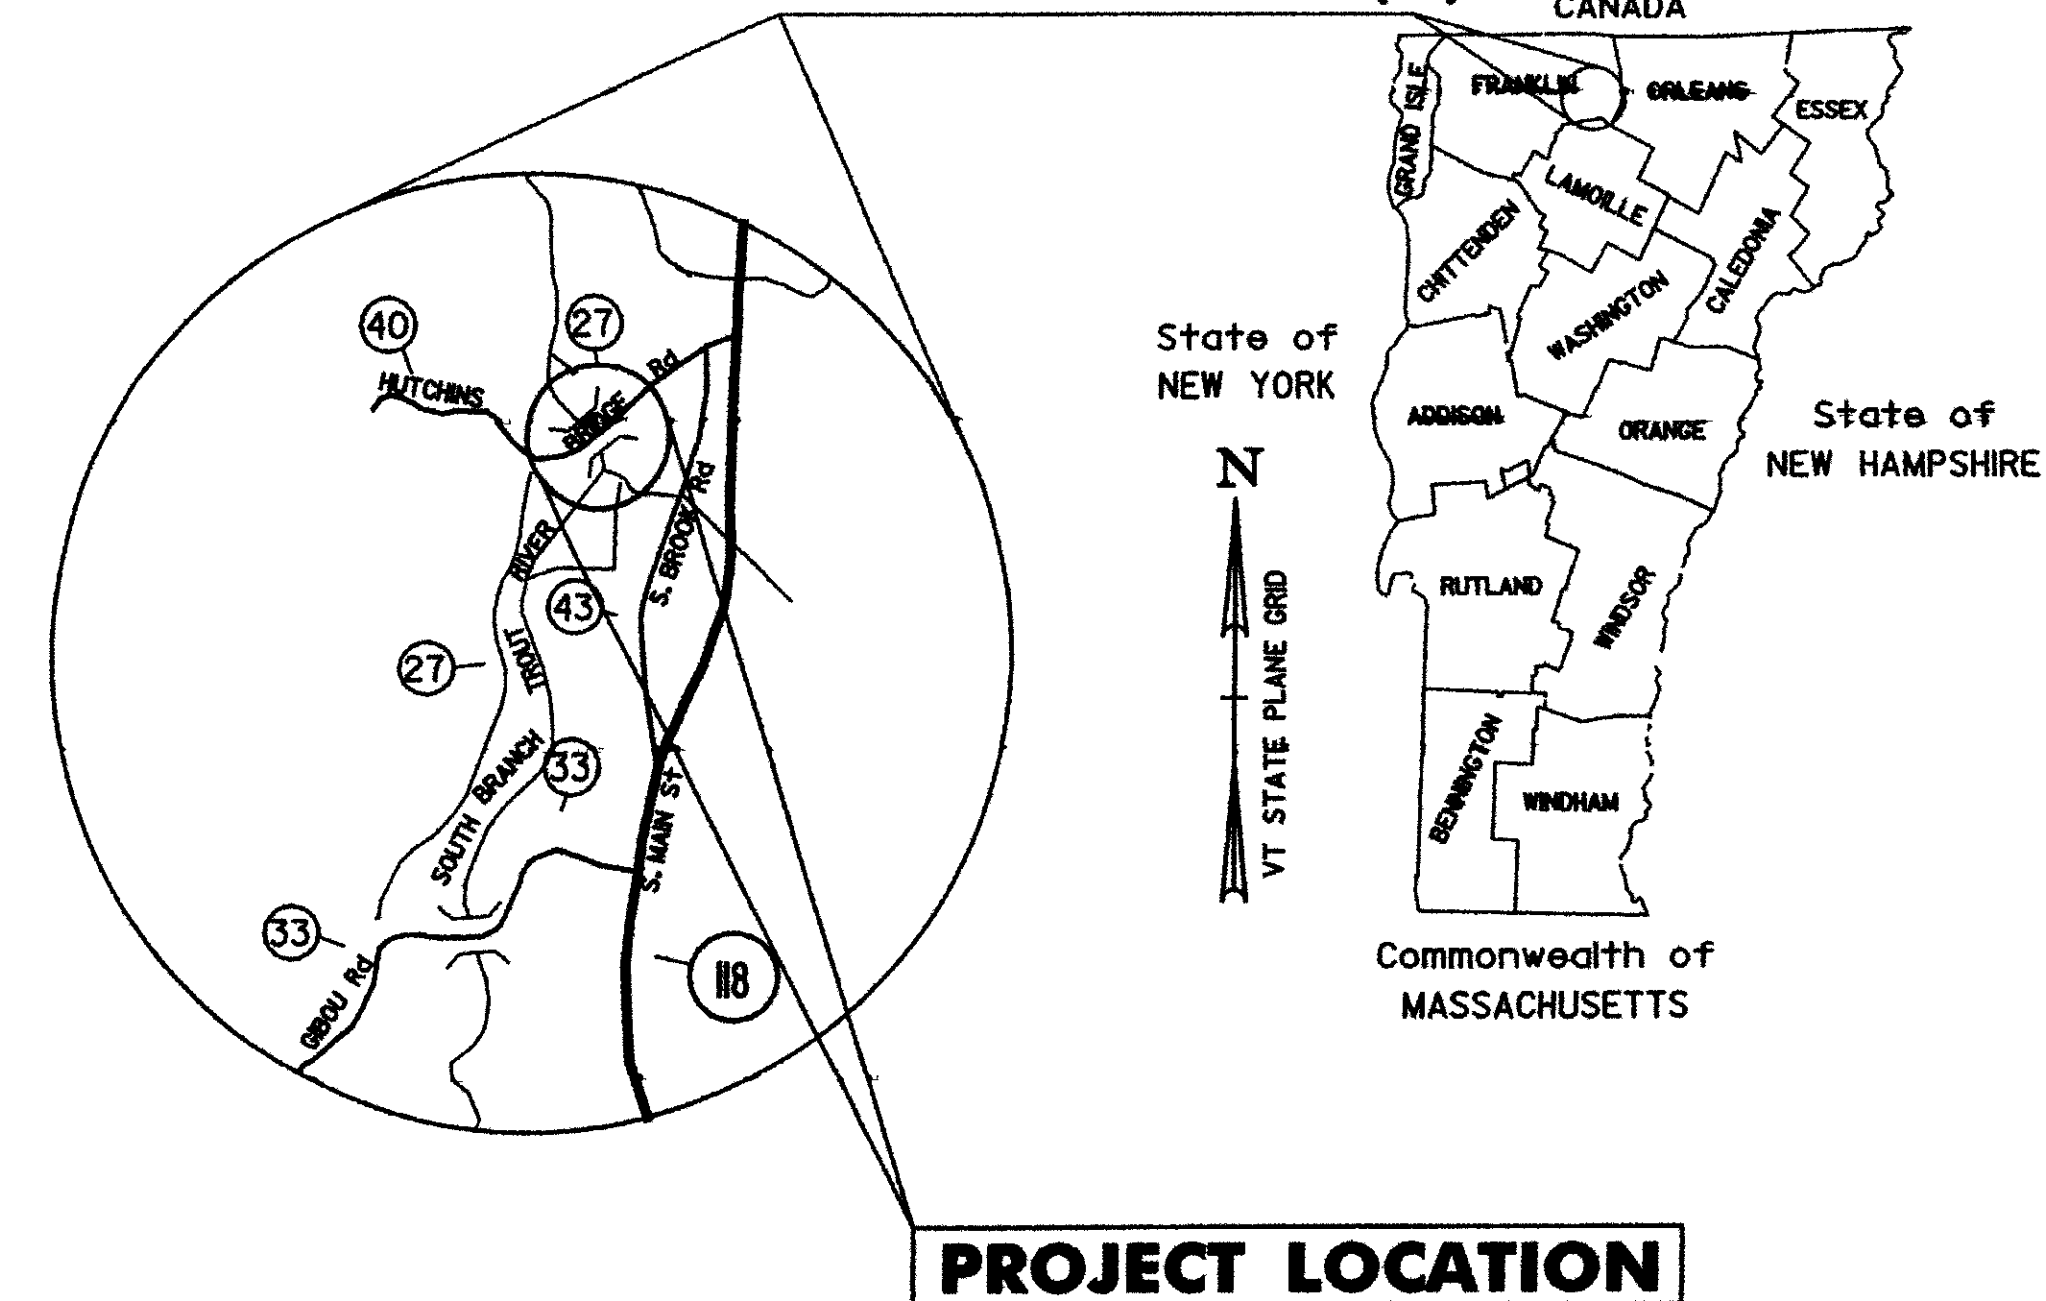


RECORD PLANS	
CONTRACTOR	ALPINE CONSTRUCTION, LLC - SCHUYLERVILLE, NY
RESIDENT ENGINEER	JEFF COTA
CONSTRUCTION BEGAN	SEPTEMBER 15, 2008
CONSTRUCTION COMPLETE	NOVEMBER 23, 2009
RECORD PLANS BY	JEFF COTA & NICK GARBACIK
I HEREBY CERTIFY THAT ALL THE CONSTRUCTION REQUIRED BY THIS SET OF DRAWINGS HAS BEEN ACCOMPLISHED AS INDICATED HEREIN	
BY	RESIDENT ENGINEER
DATE	11/11/09
NOTE: Any further information concerning final quantities, amounts or other details relative to this project may be found at Central Files in the electronic archives	

PROJECT LOCATION: ON T.H. 27 BEGINNING APPROXIMATELY 0.16 MILES WEST OF ITS INTERSECTION WITH VT ROUTE 118 AND EXTENDING EASTERLY FOR 268 FEET.


PROJECT DESCRIPTION: REHABILITATION OF THE HUTCHINS COVERED BRIDGE CONSISTS OF REPLACING THE DETERIORATED BRIDGE MEMBERS, INSTALLATION OF NEW SIDING, CONSTRUCTION OF FOUR (4) NEW WINGWALLS, SUBSTRUCTURE REPAIRS AND RECONSTRUCTION, INSTALLATION OF APPROACH RAILING, RECONSTRUCTION OF ROADWAY APPROACHES, CONSTRUCTION AND REMOVAL OF TEMPORARY DETOUR BRIDGE UPSTREAM OF EXISTING COVERED BRIDGE.

LENGTH OF STRUCTURE: 73.50 FEET (END OF DECK TO END OF DECK)
LENGTH OF ROADWAY: 194.54 FEET
LENGTH OF PROJECT: 268.04 FEET

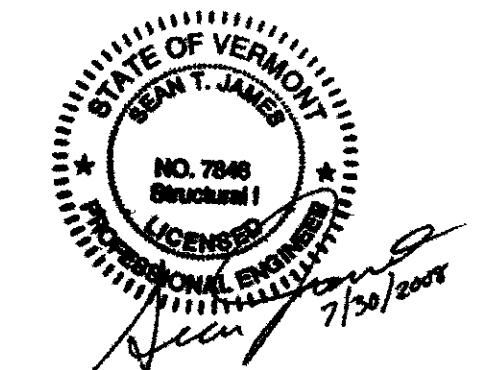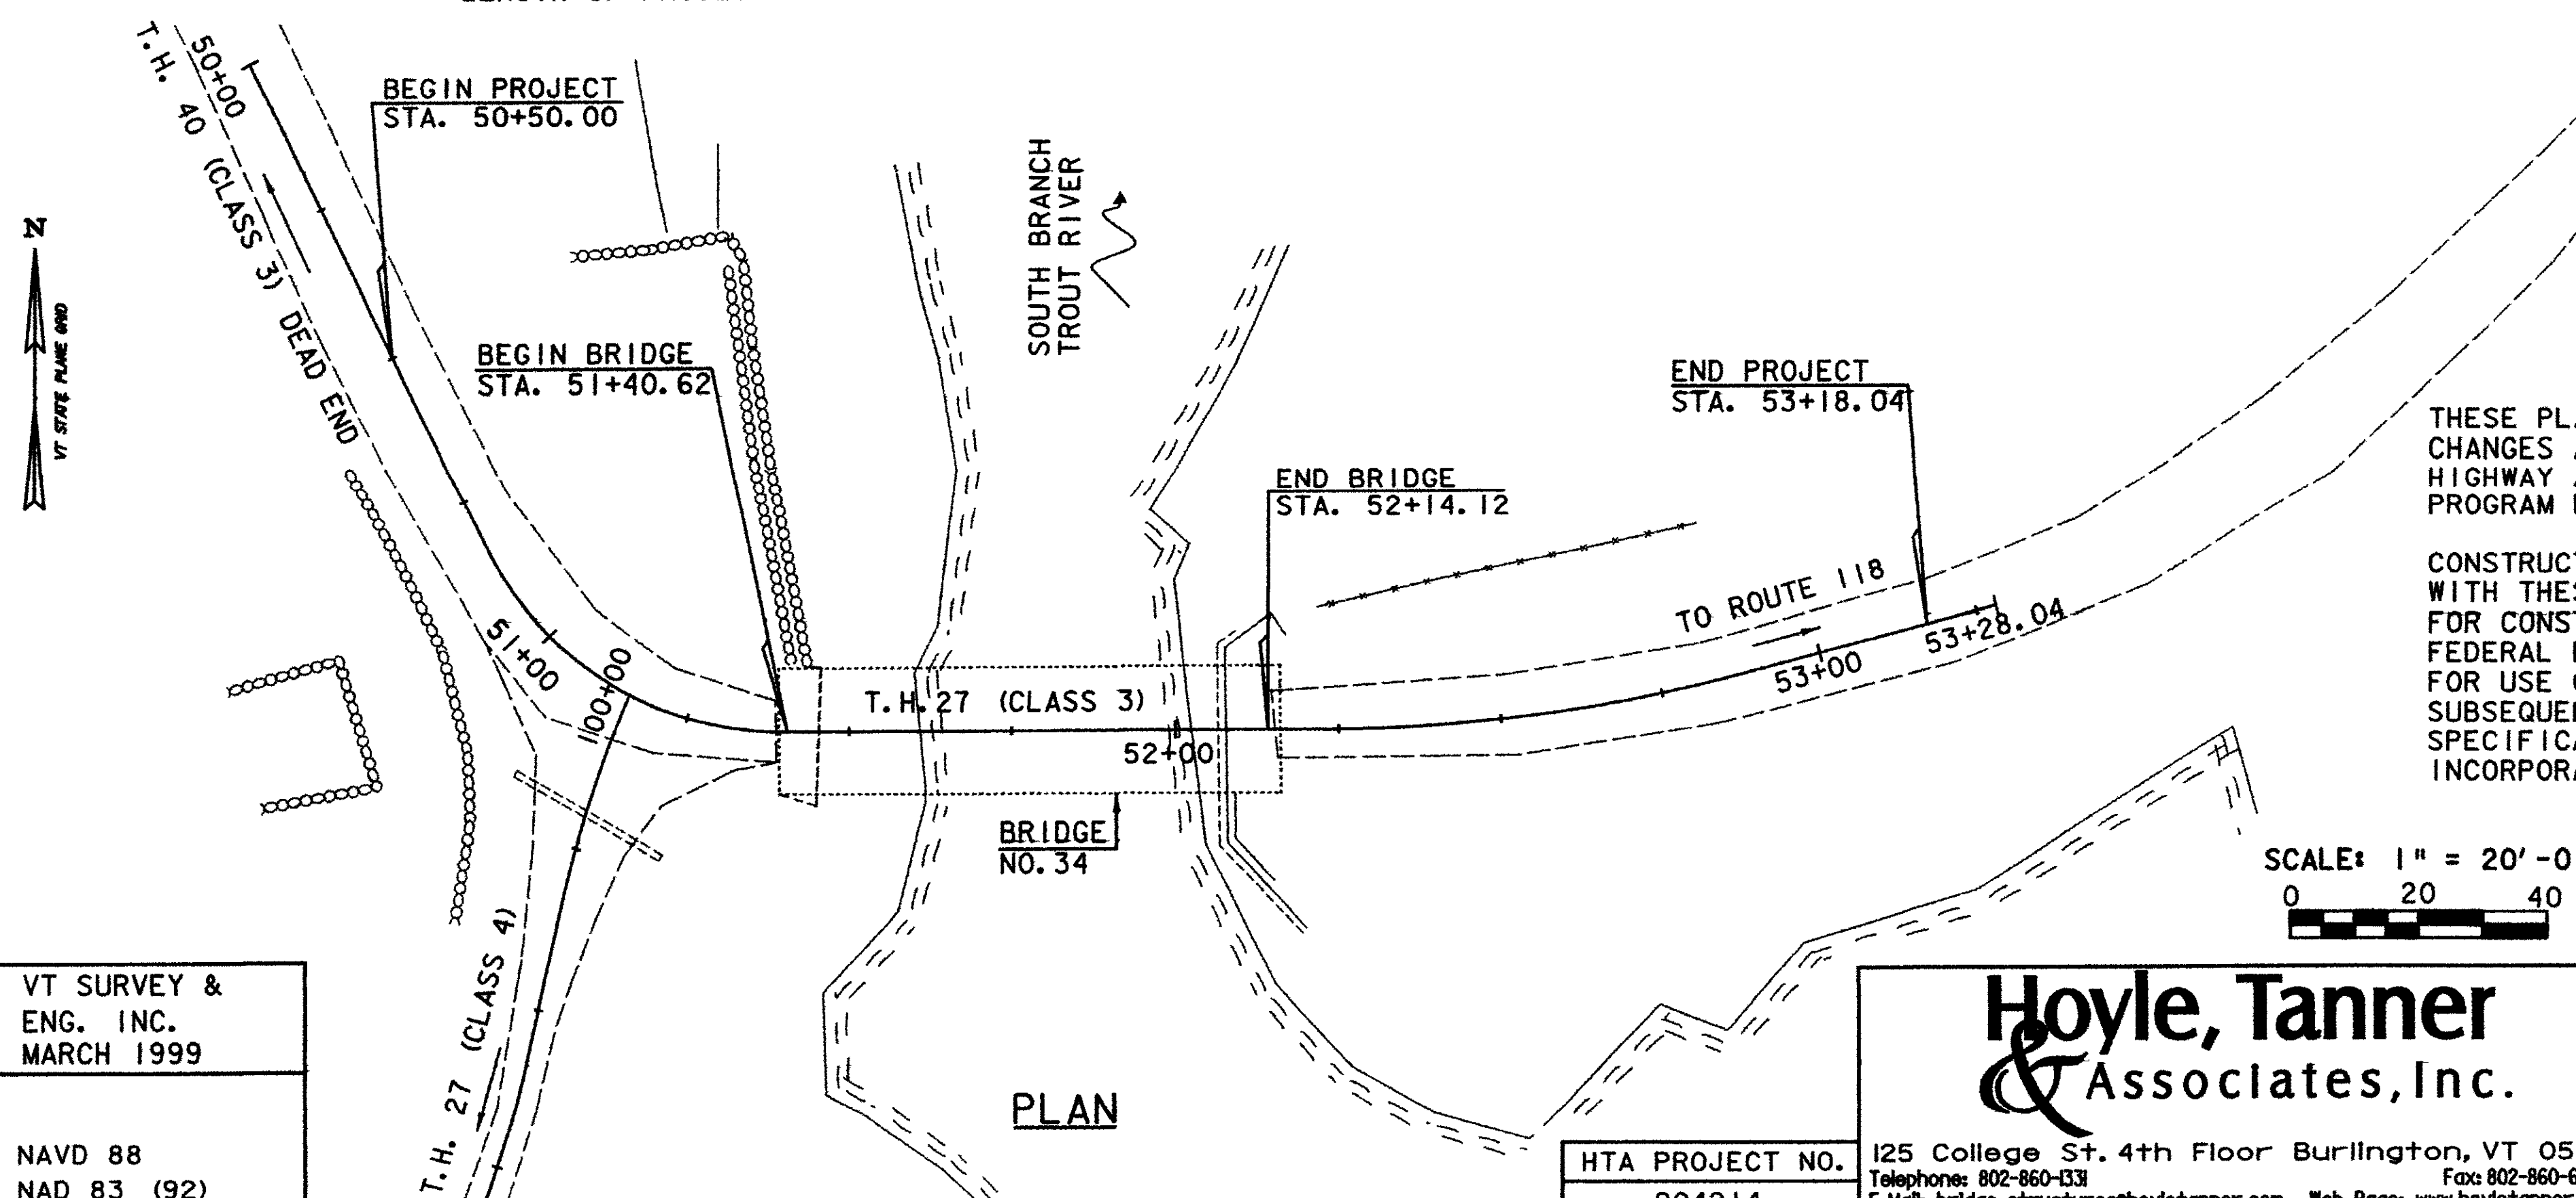

THESE PLANS ARE SUBJECT TO SUCH ENGINEERING CHANGES AS MAY BE REQUIRED BY THE FEDERAL HIGHWAY ADMINISTRATION OR THE DIRECTOR OF PROGRAM DEVELOPMENT.

CONSTRUCTION IS TO BE CARRIED ON IN ACCORDANCE WITH THESE PLANS AND THE STANDARD SPECIFICATIONS FOR CONSTRUCTION DATED 2006, AS APPROVED BY THE FEDERAL HIGHWAY ADMINISTRATION ON JUNE 15, 2006 FOR USE ON THIS PROJECT, INCLUDING ALL SUBSEQUENT REVISIONS AND SUCH REVISED SPECIFICATIONS AND SPECIAL PROVISIONS AS ARE INCORPORATED IN THESE PLANS.

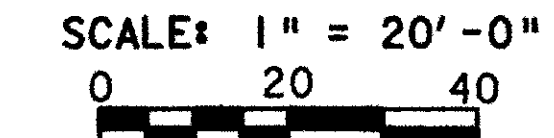

CONVENTIONAL SYMBOLS	
COUNTY LINE	
TOWN LINE	
LIMITS OF ACCESS	
POINT OF ACCESS	
FENCE LINE	
STONE WALL	
TRAVELED WAY	
GUARD RAIL	
RAILROAD	
SURVEY LINE	
CULVERT	
POWER POLE	
TELEPHONE POLE	
TREES	
CONTROL OF ACCESS	
PROPERTY LINE	
R.O.W. TAKING LINE	
SLOPE RIGHTS	
TOP OF CUT	
TOE OF SLOPE	

SURVEYED BY : VT SURVEY & ENG. INC.
 SURVEYED DATE : MARCH 1999
 DATUM
 VERTICAL NAVD 88
 HORIZONTAL NAD 83 (92)

HTA PROJECT NO. 904214
 Hoyle, Tanner & Associates, Inc.
 125 College St. 4th Floor Burlington, VT 05401
 Telephone: 802-860-1333 Fax: 802-860-6499
 E-Mail: bridge-structures@hoyletanner.com Web Page: www.hoyletanner.com

DIRECTOR OF PROGRAM DEVELOPMENT
 APPROVED: DATE: 9-1-09
 PROJECT MANAGER : J.H. WEAVER
 PROJECT NAME : MONTGOMERY
 PROJECT NUMBER : BHO 1448 (23)
 SHEET 1 OF 54 SHEETS