




BEGIN TEMP. DETOUR
 END APPROACH
 STA. 10+52.50

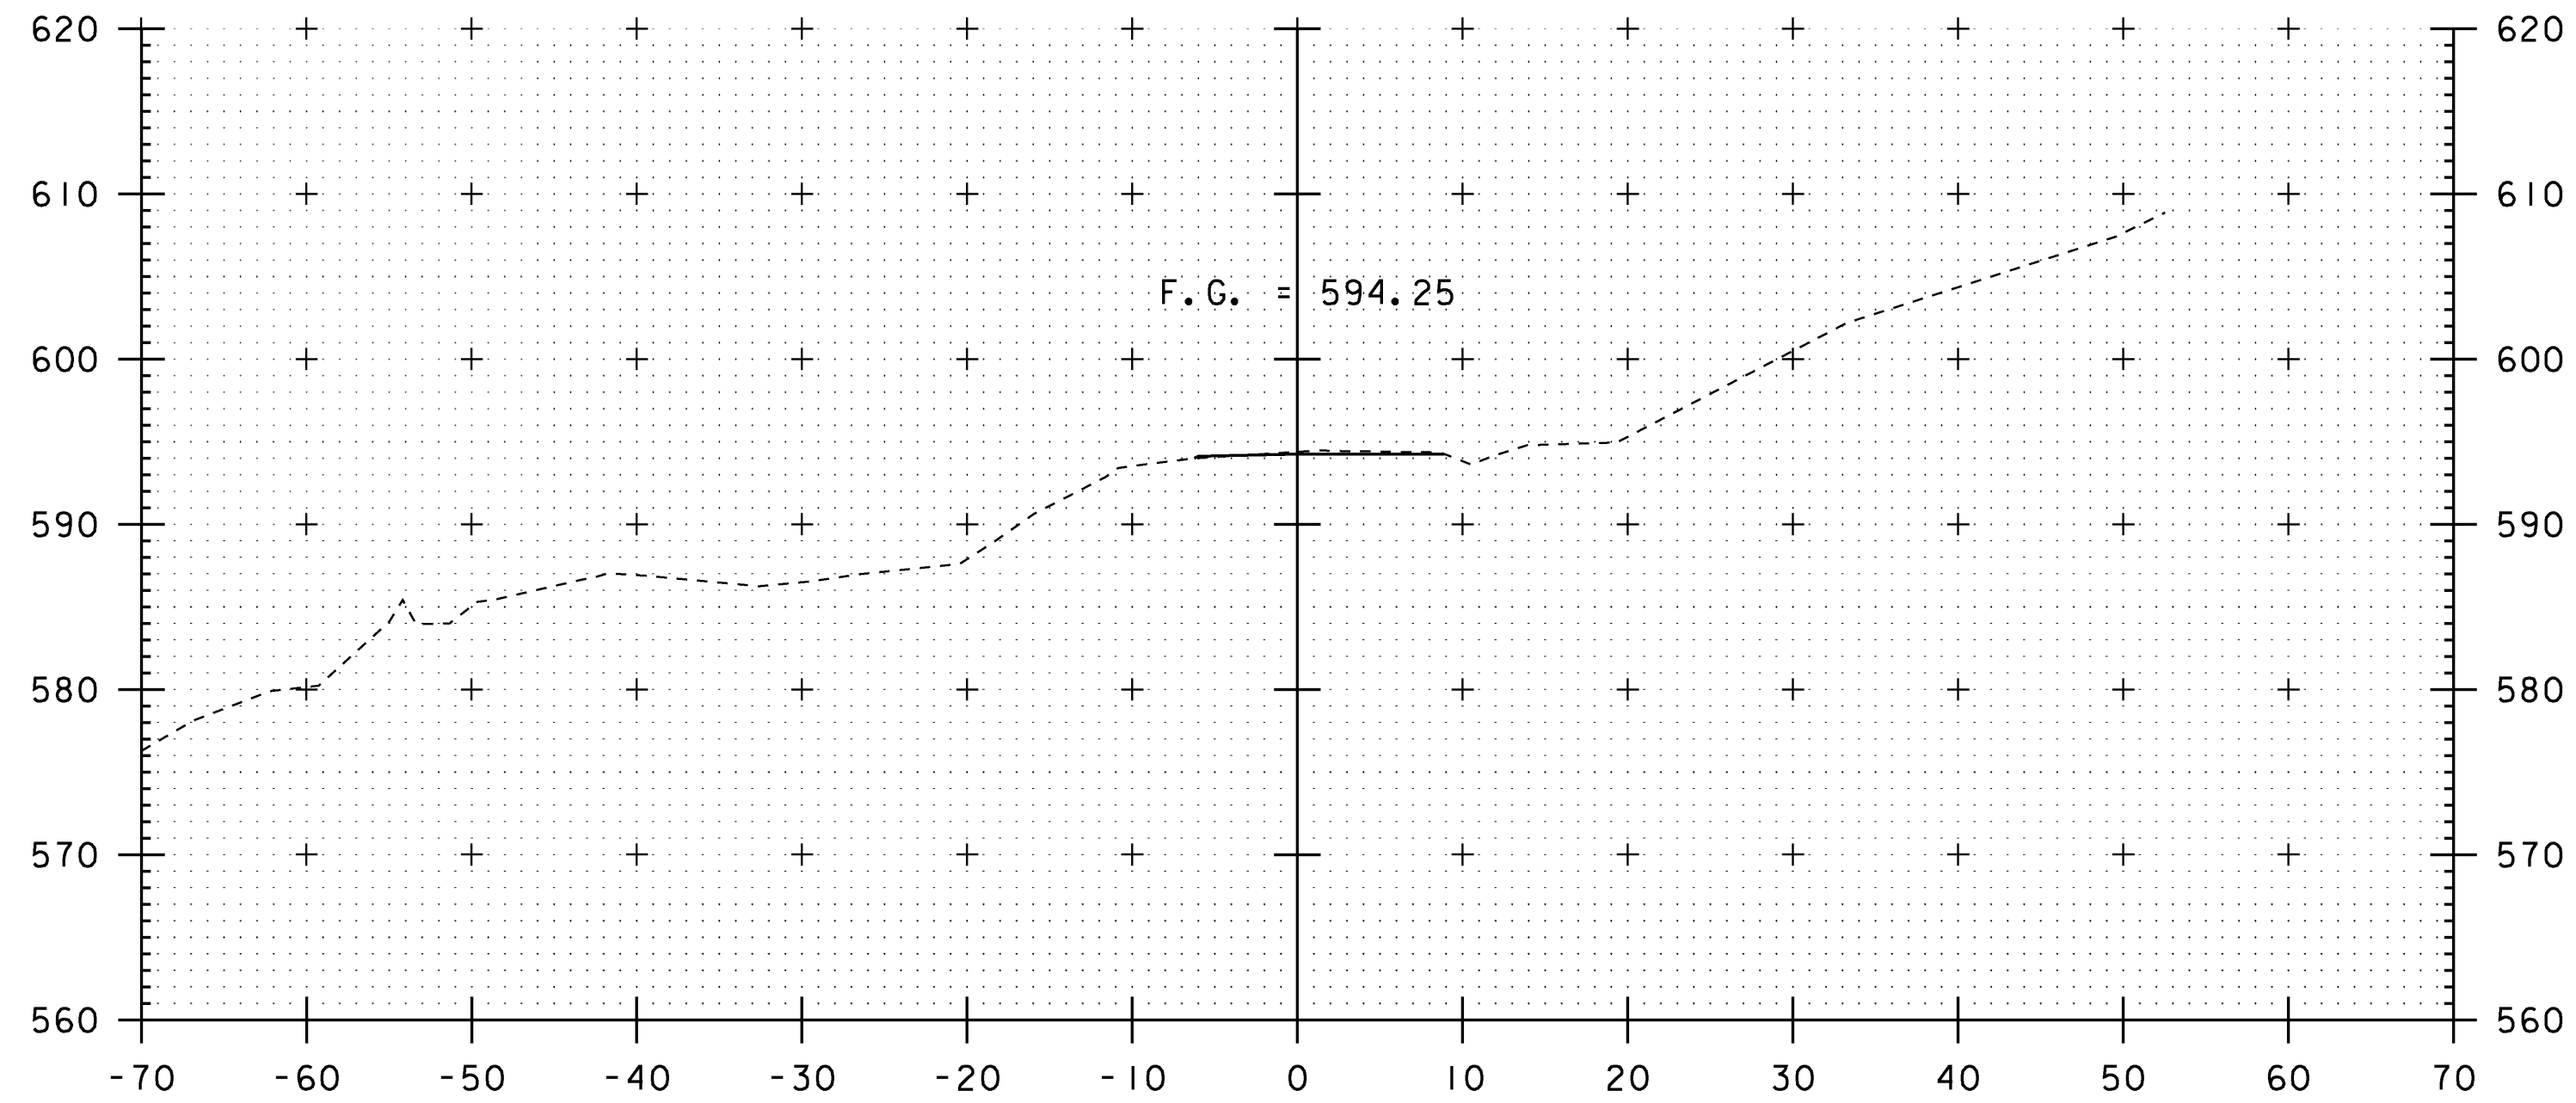


10+50

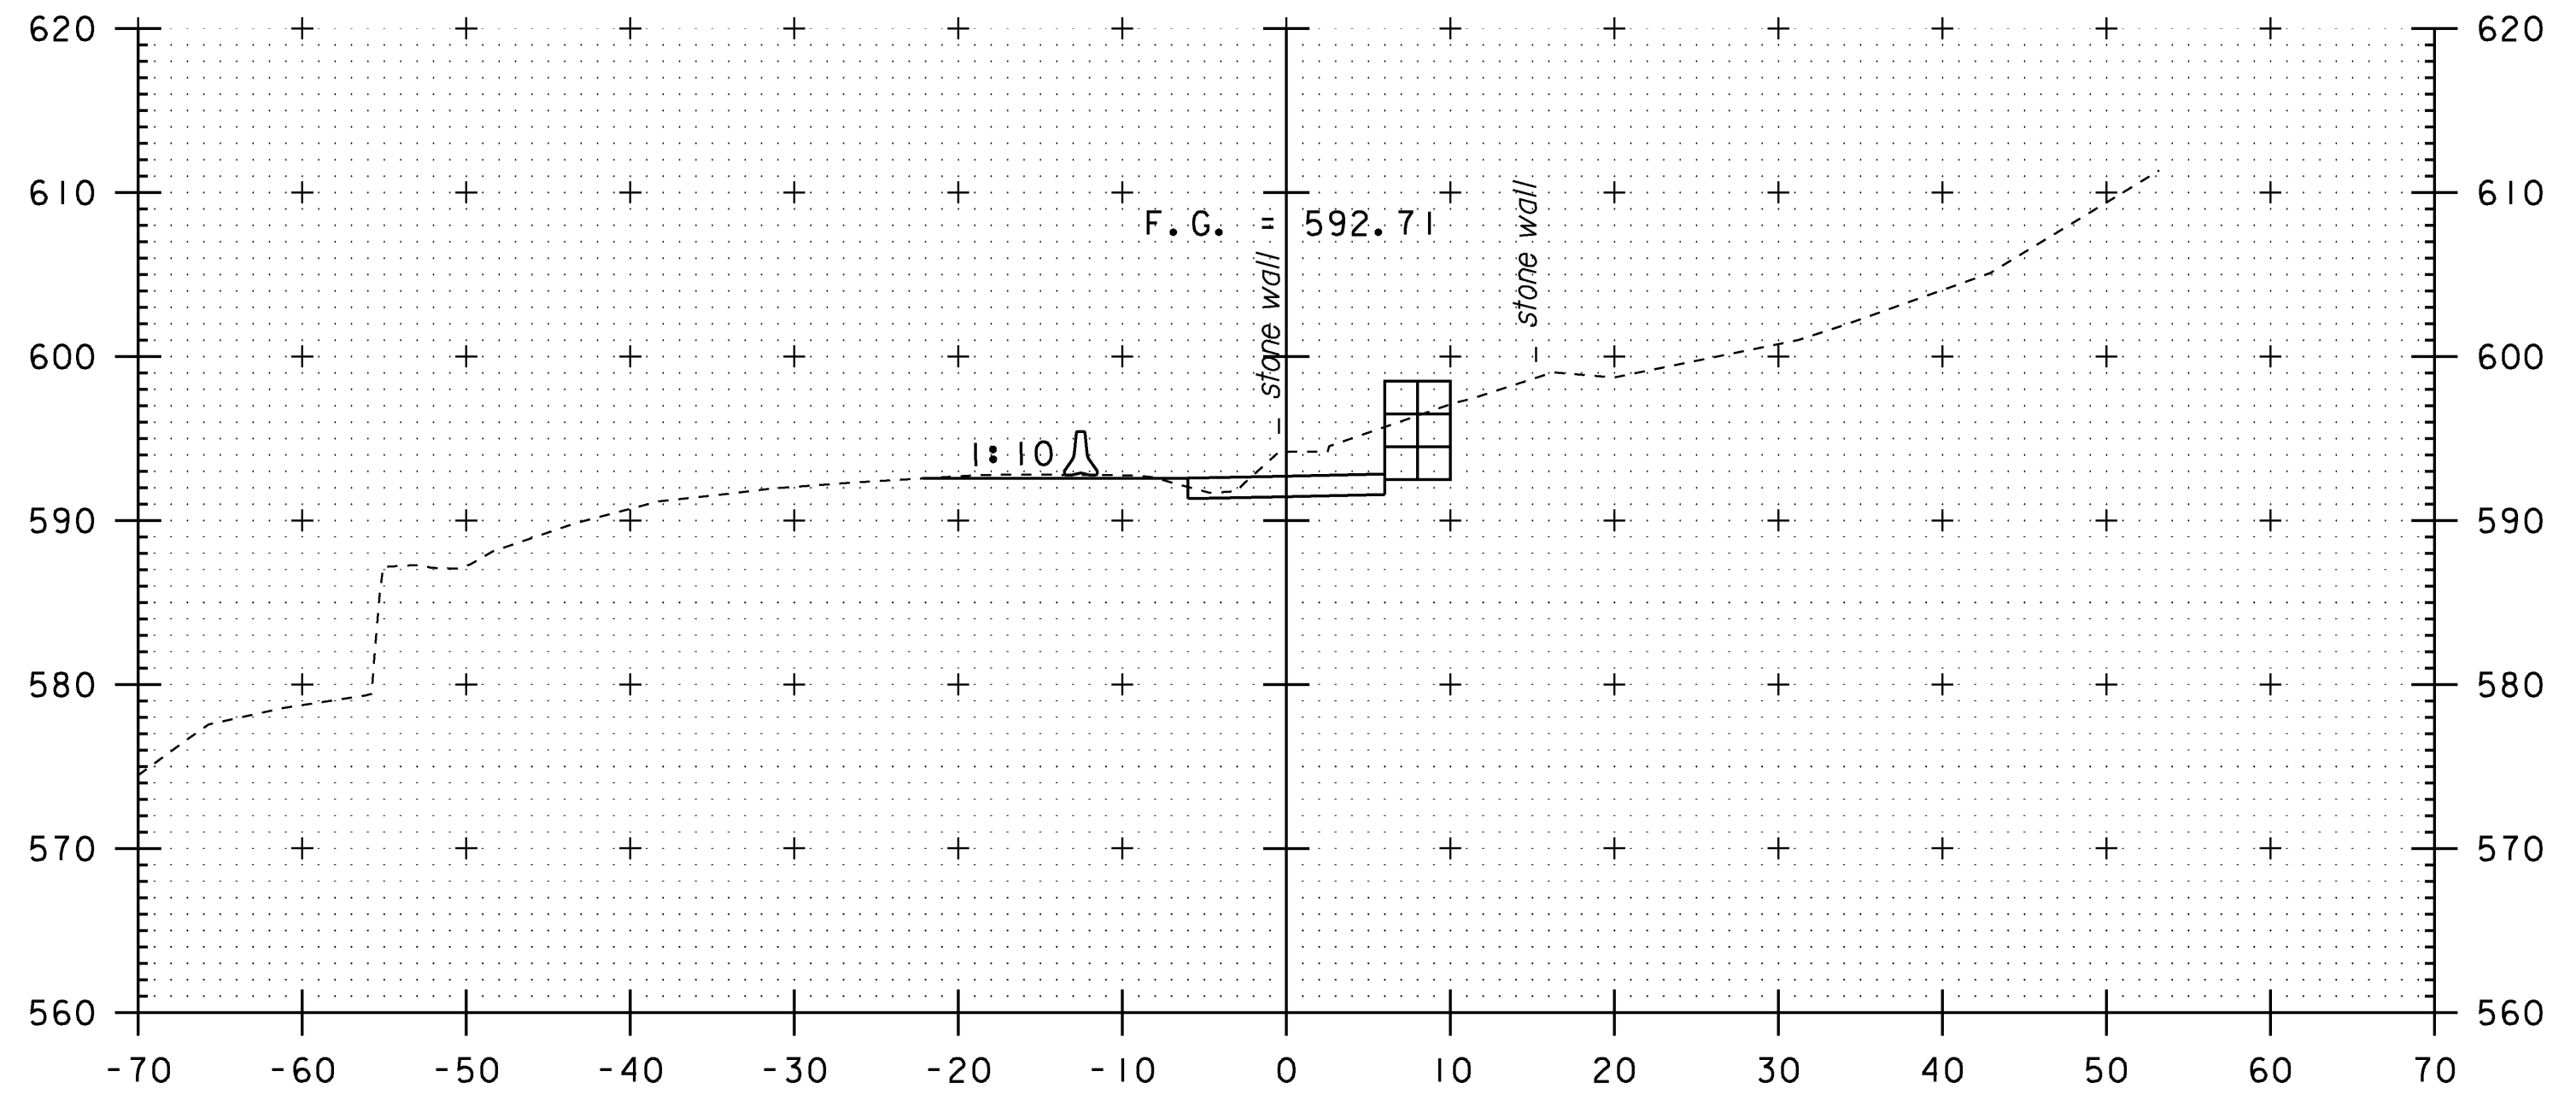

11+00

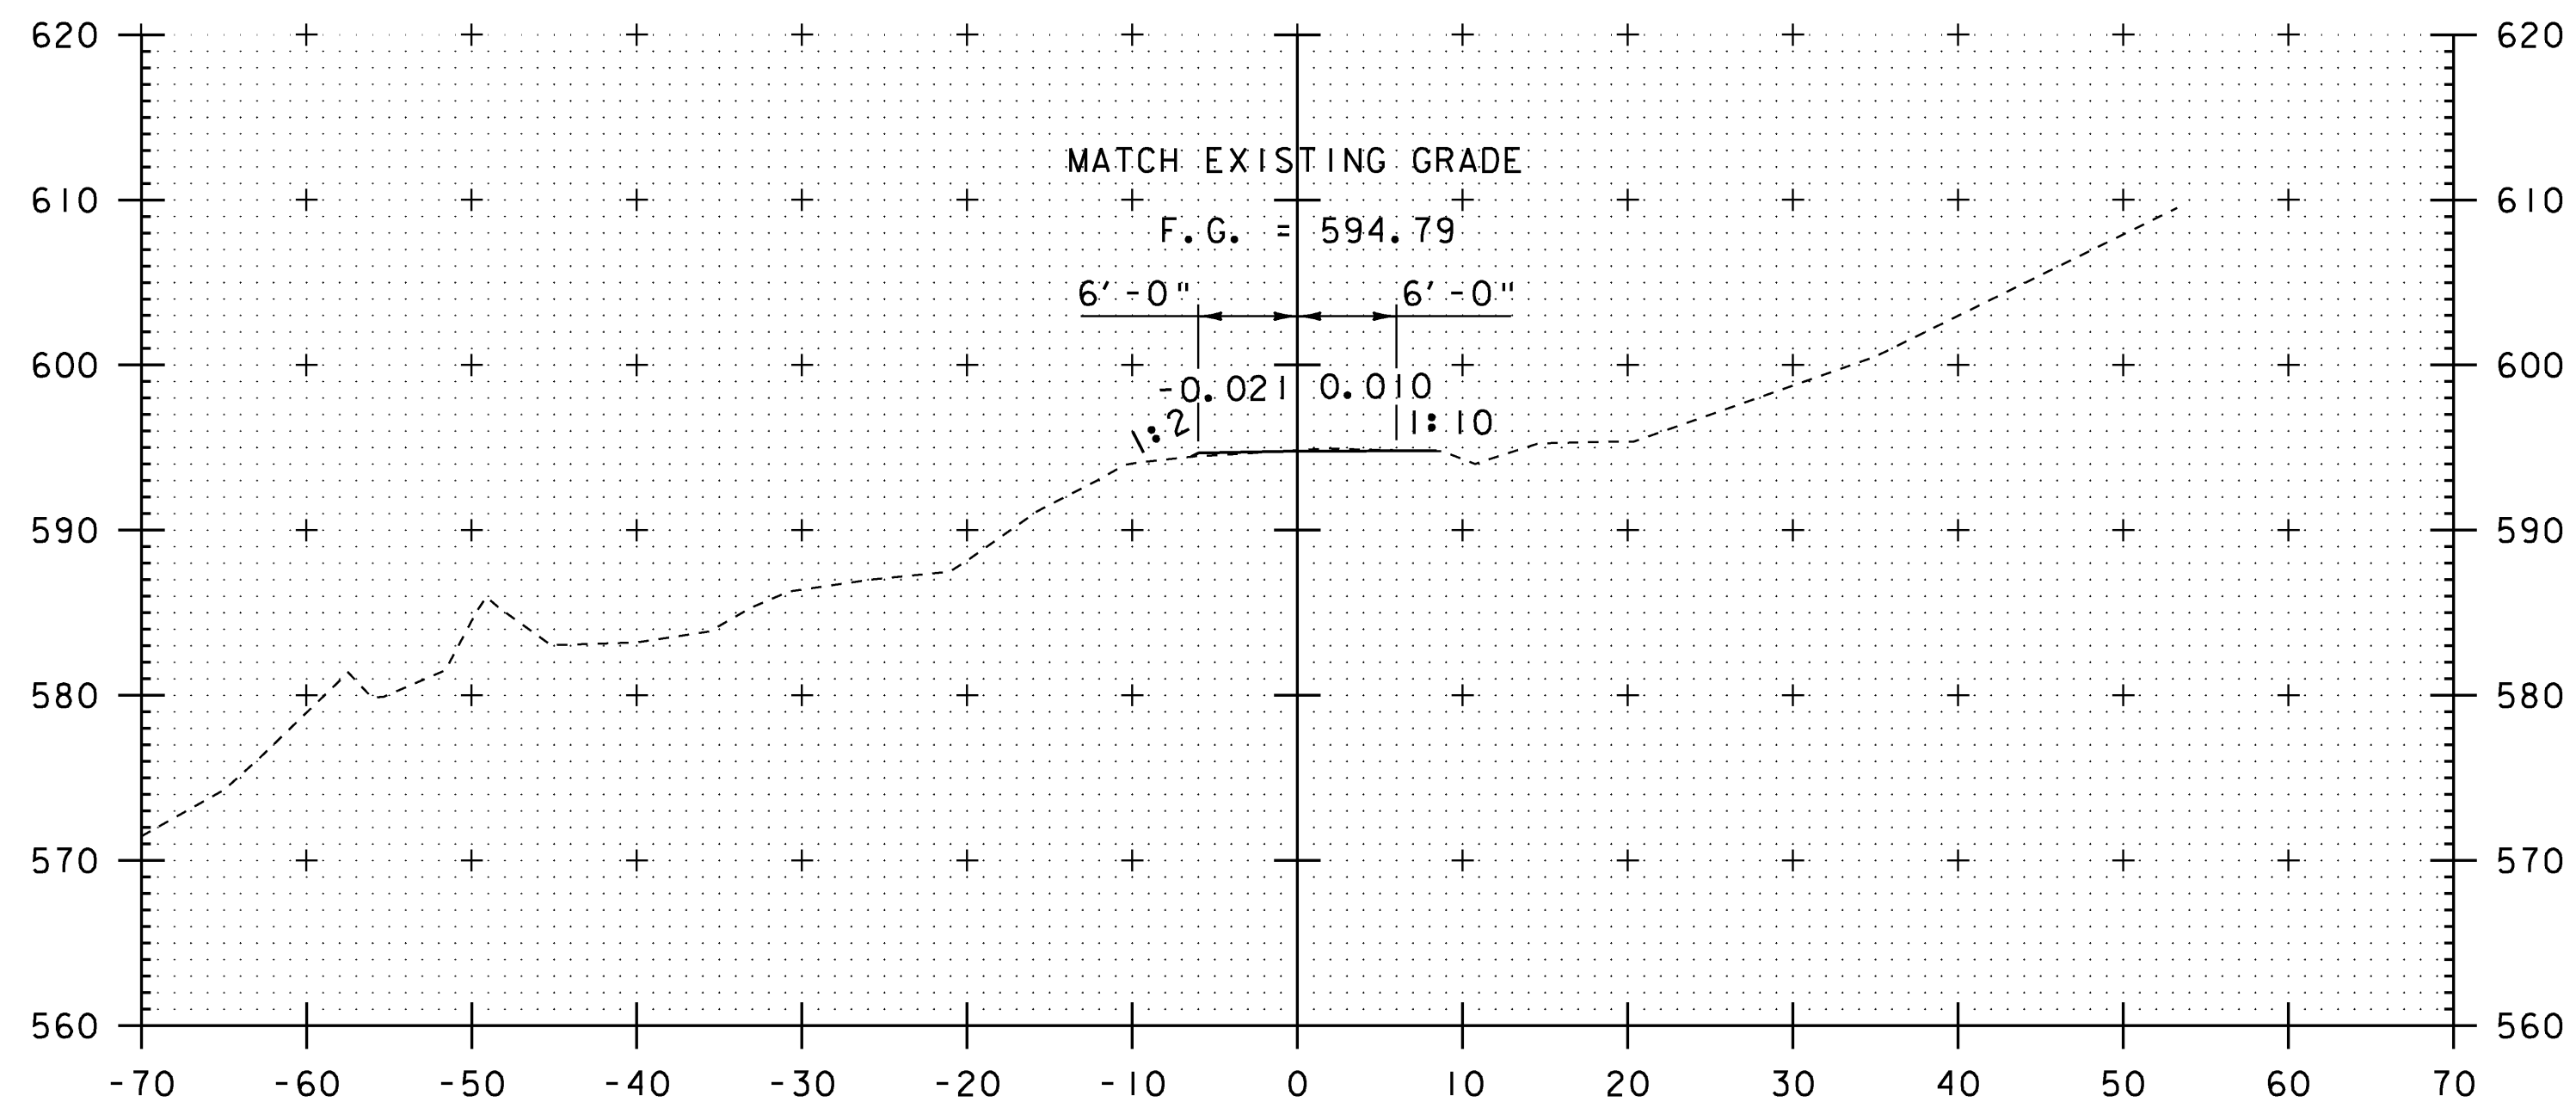

10+40
 BEGIN APPROACH

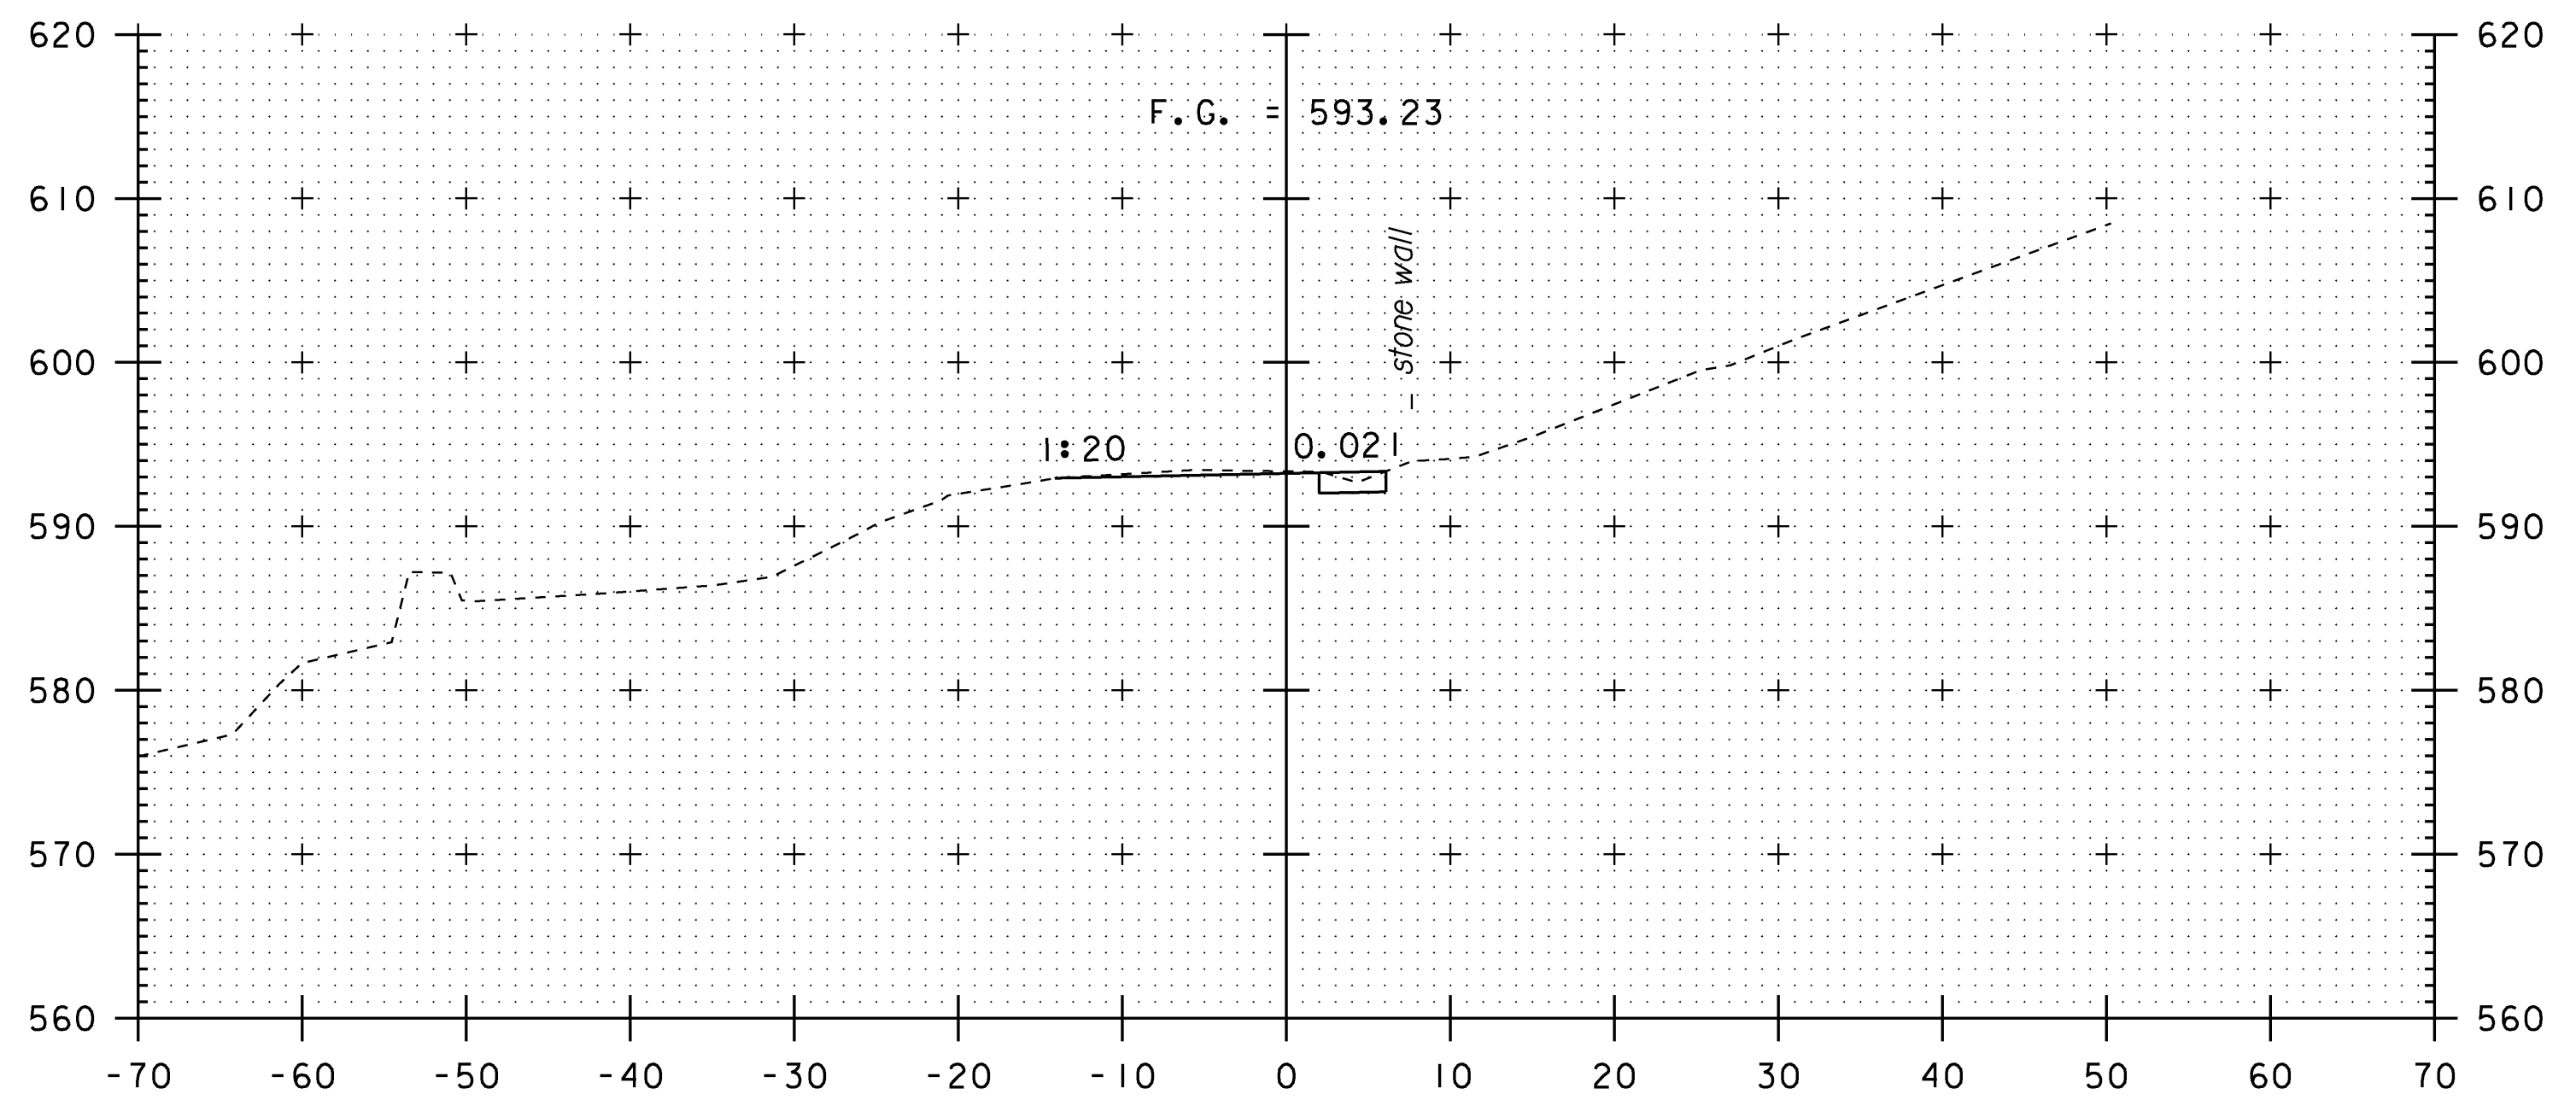

10+75

STA. 10+40 - STA. 11+00

SCALE: 1" = 10'-0"
 10 0 10

MODEL	
HTA PROJECT NO.	904214

Hoyle, Tanner & Associates, Inc.

PROJECT NAME: MONTGOMERY
 PROJECT NUMBER: BHO 1448(23)

FILE NAME: Z96J302detour.xsl.dgn
 PROJECT LEADER: J.H.WEAVER
 DESIGNED BY: J.BICJA

PLOT DATE: 8/1/2008
 DRAWN BY: J.B.McQUAID
 CHECKED BY: S.T.JAMES
 SHEET 45 OF 54

TEMP. DETOUR CROSS SECTIONS (1 OF 4)