



END TEMP. DETOUR  
 BEGIN APPROACH  
 STA. 13+54.55

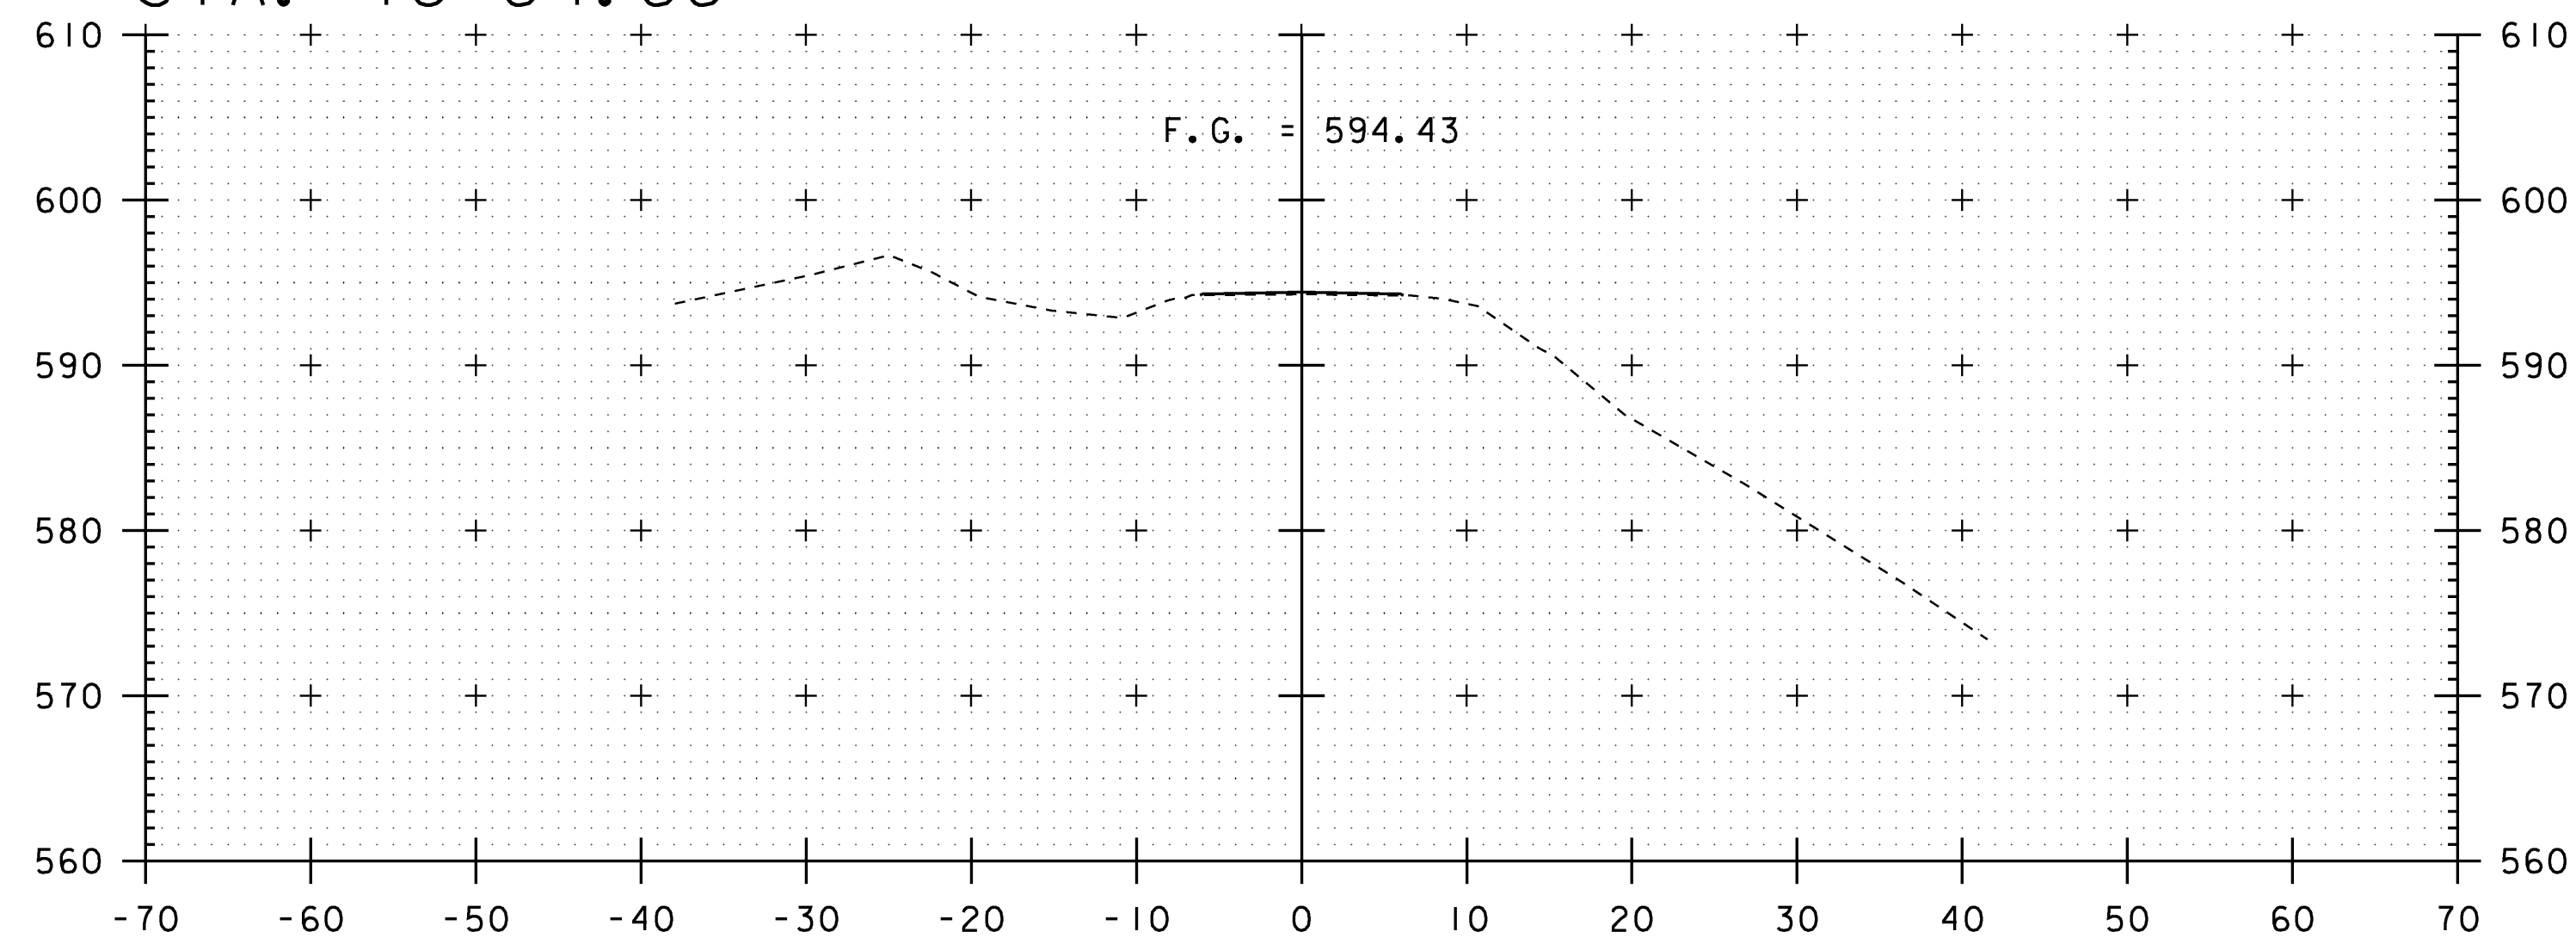


13+50

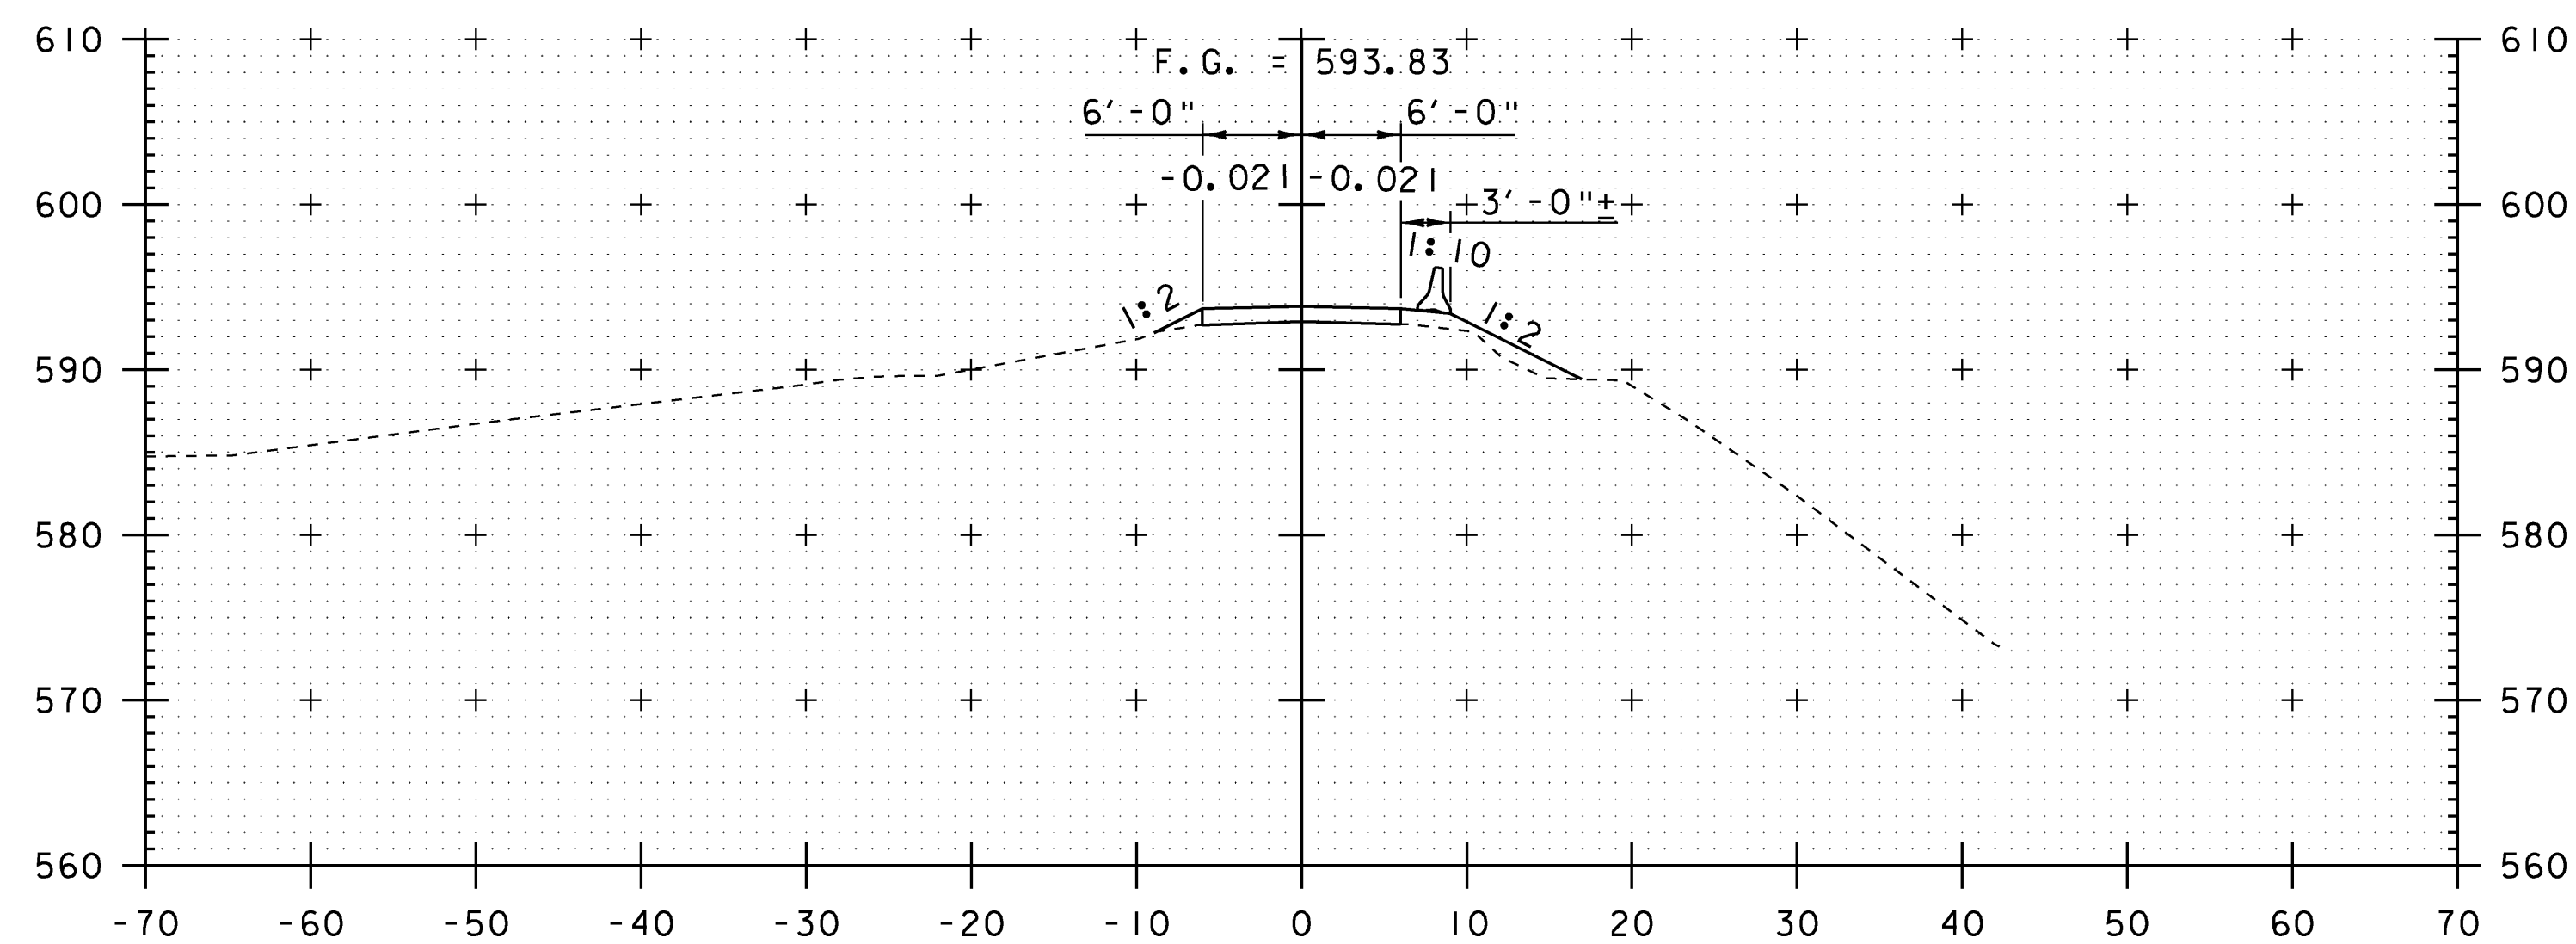

13+25

END APPROACH  
 STA. 13+67.05

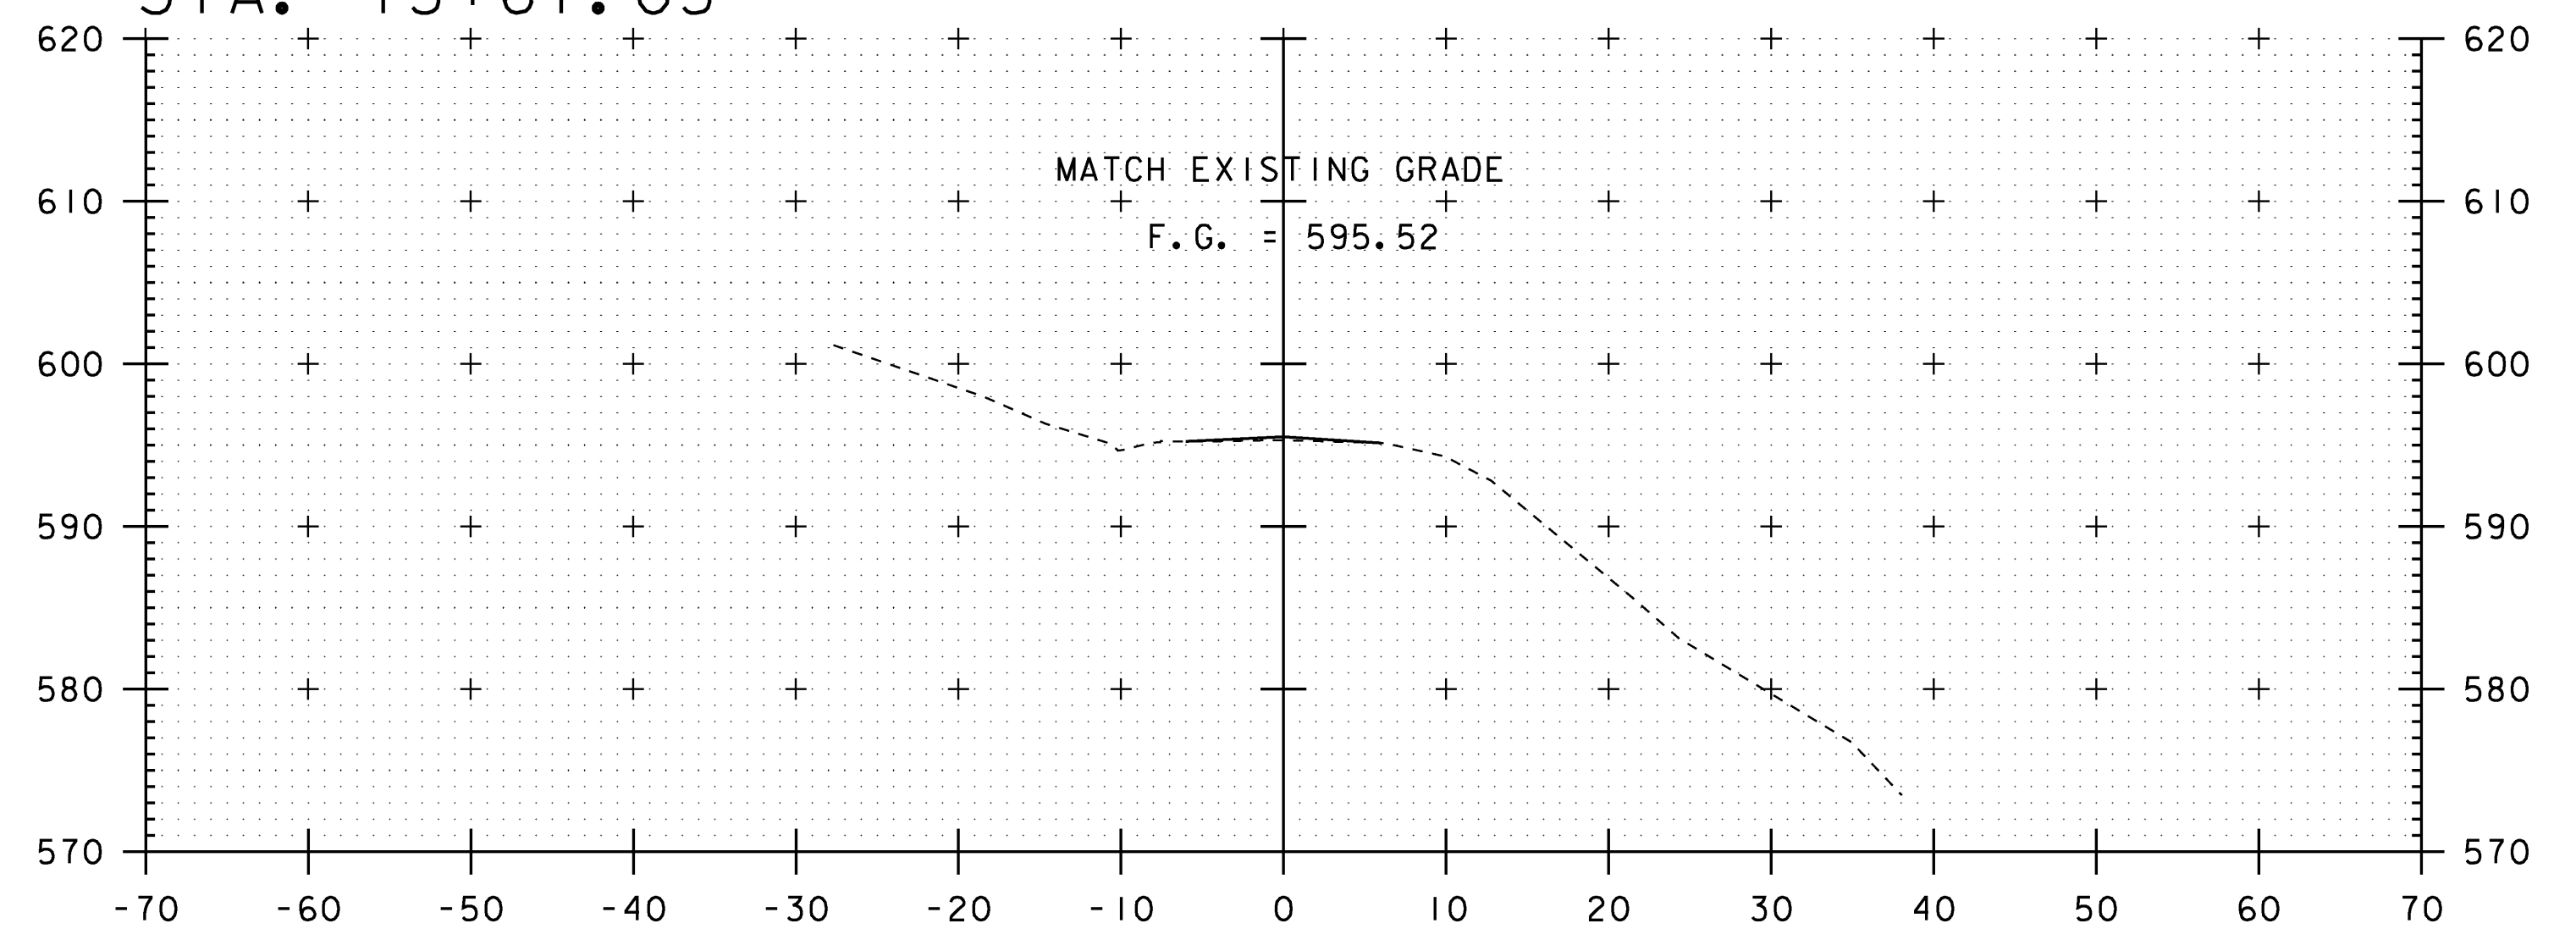

13+67

STA. 13+25 - STA. 13+67

SCALE: 1" = 10'-0"  
 10 0 10

MODEL	4
HTA PROJECT NO.	904214

Hoyle, Tanner & Associates, Inc.

PROJECT NAME:	MONTGOMERY	FILE NAME:	Z96J302detourxs4.dgn	PLOT DATE:	8/1/2008
PROJECT NUMBER:	BHO 1448(23)	PROJECT LEADER:	J.H.WEAVER	DRAWN BY:	J.B.McQUAID
		DESIGNED BY:	J.BICJA	CHECKED BY:	S.T.JAMES
<b>TEMP. DETOUR CROSS SECTIONS (4 OF 4)</b>				SHEET	48 OF 54