




50+50
BEGIN PROJECT
END APPROACH

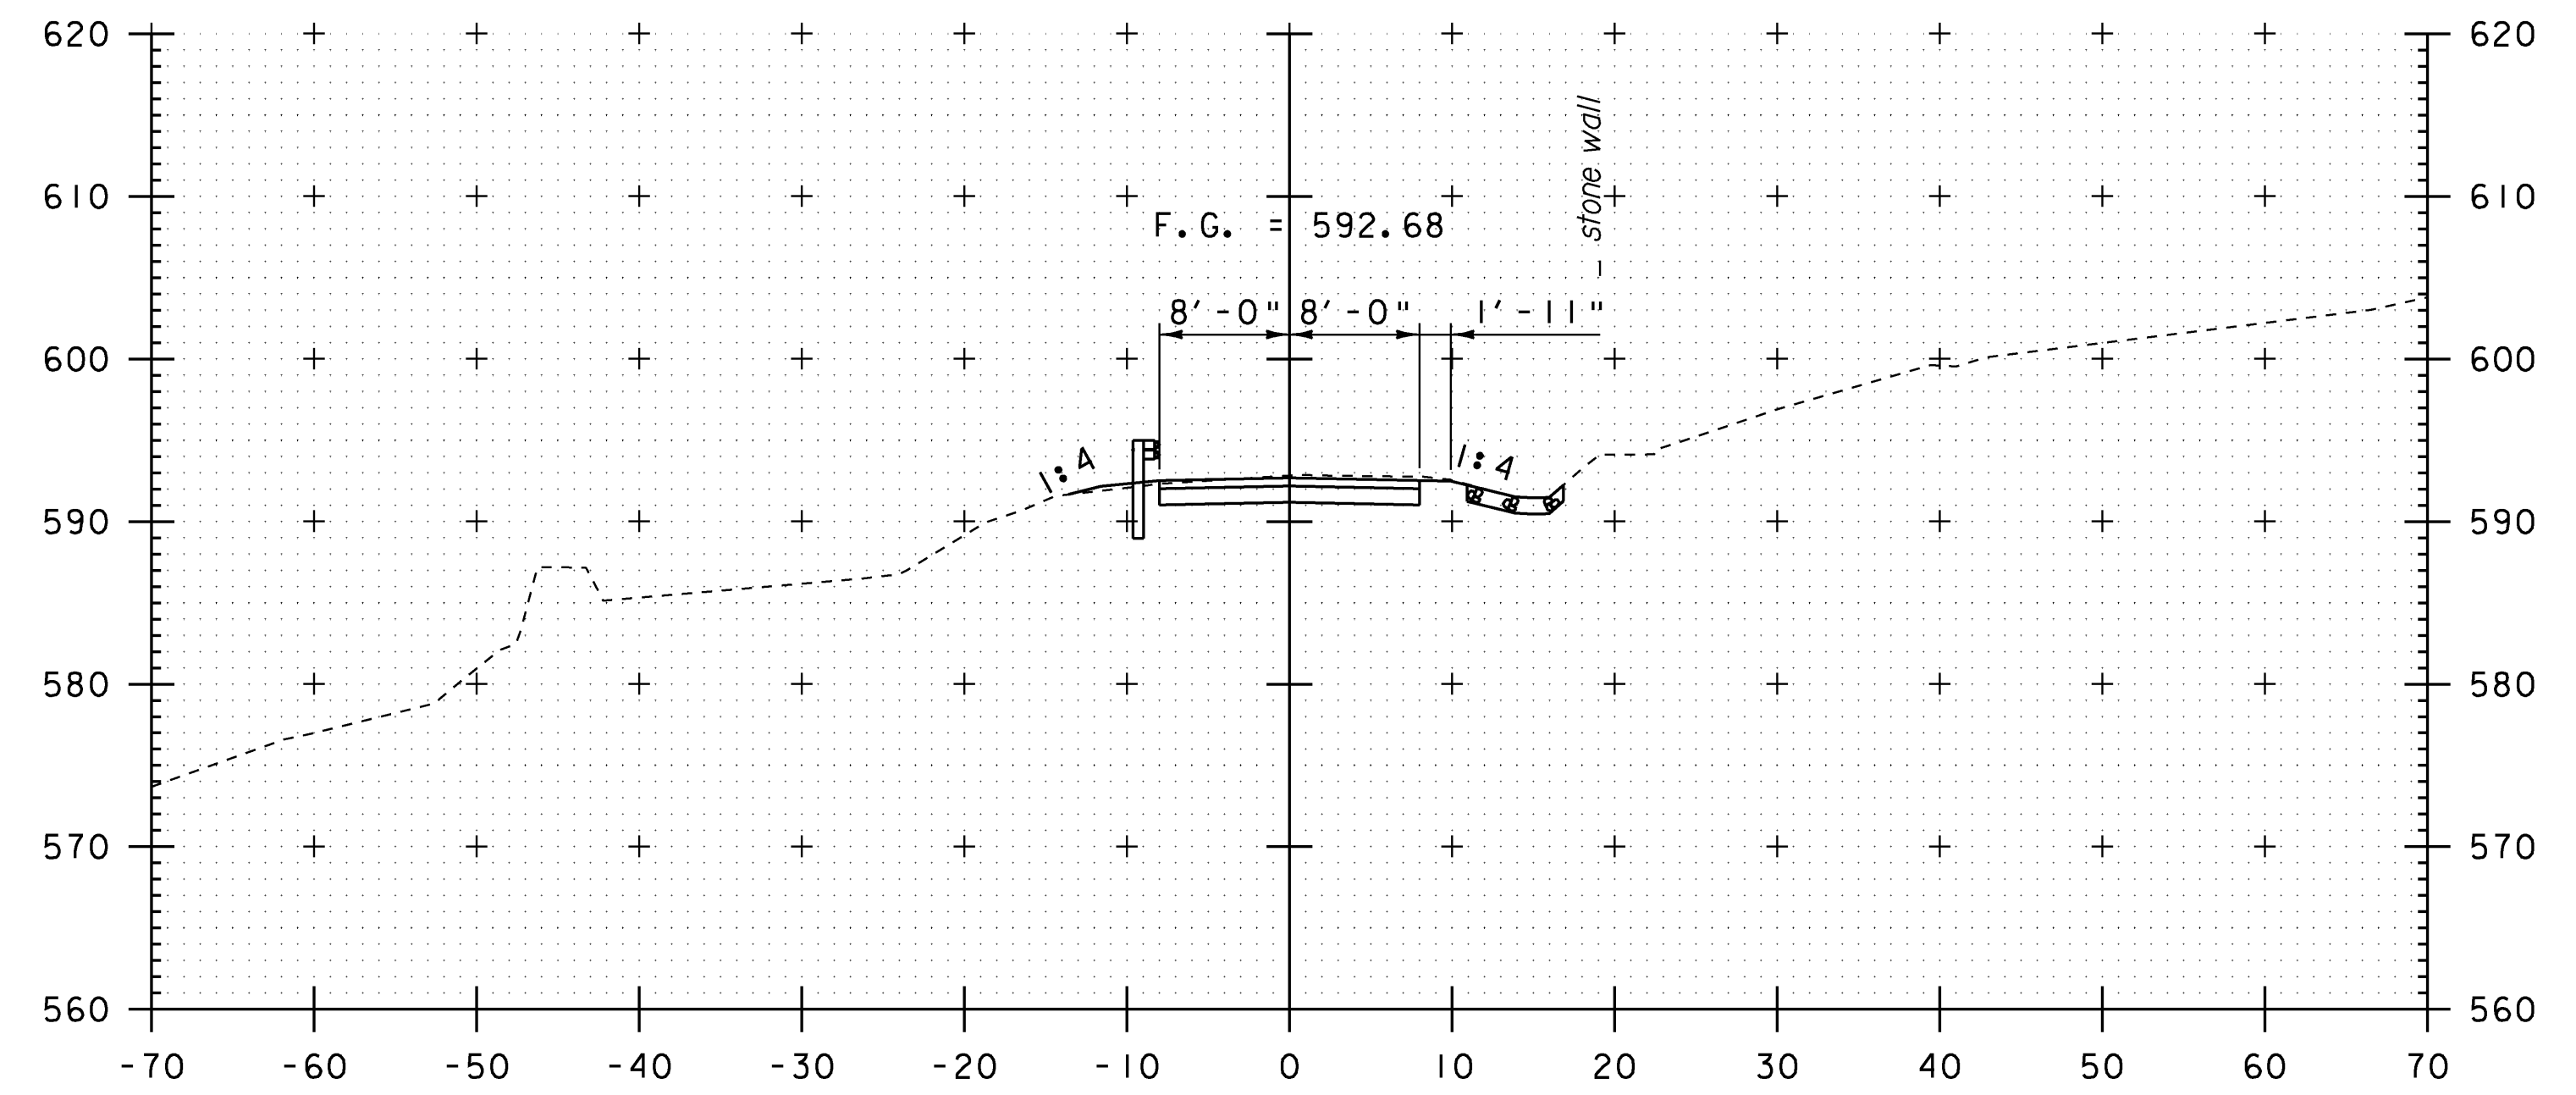

51+00

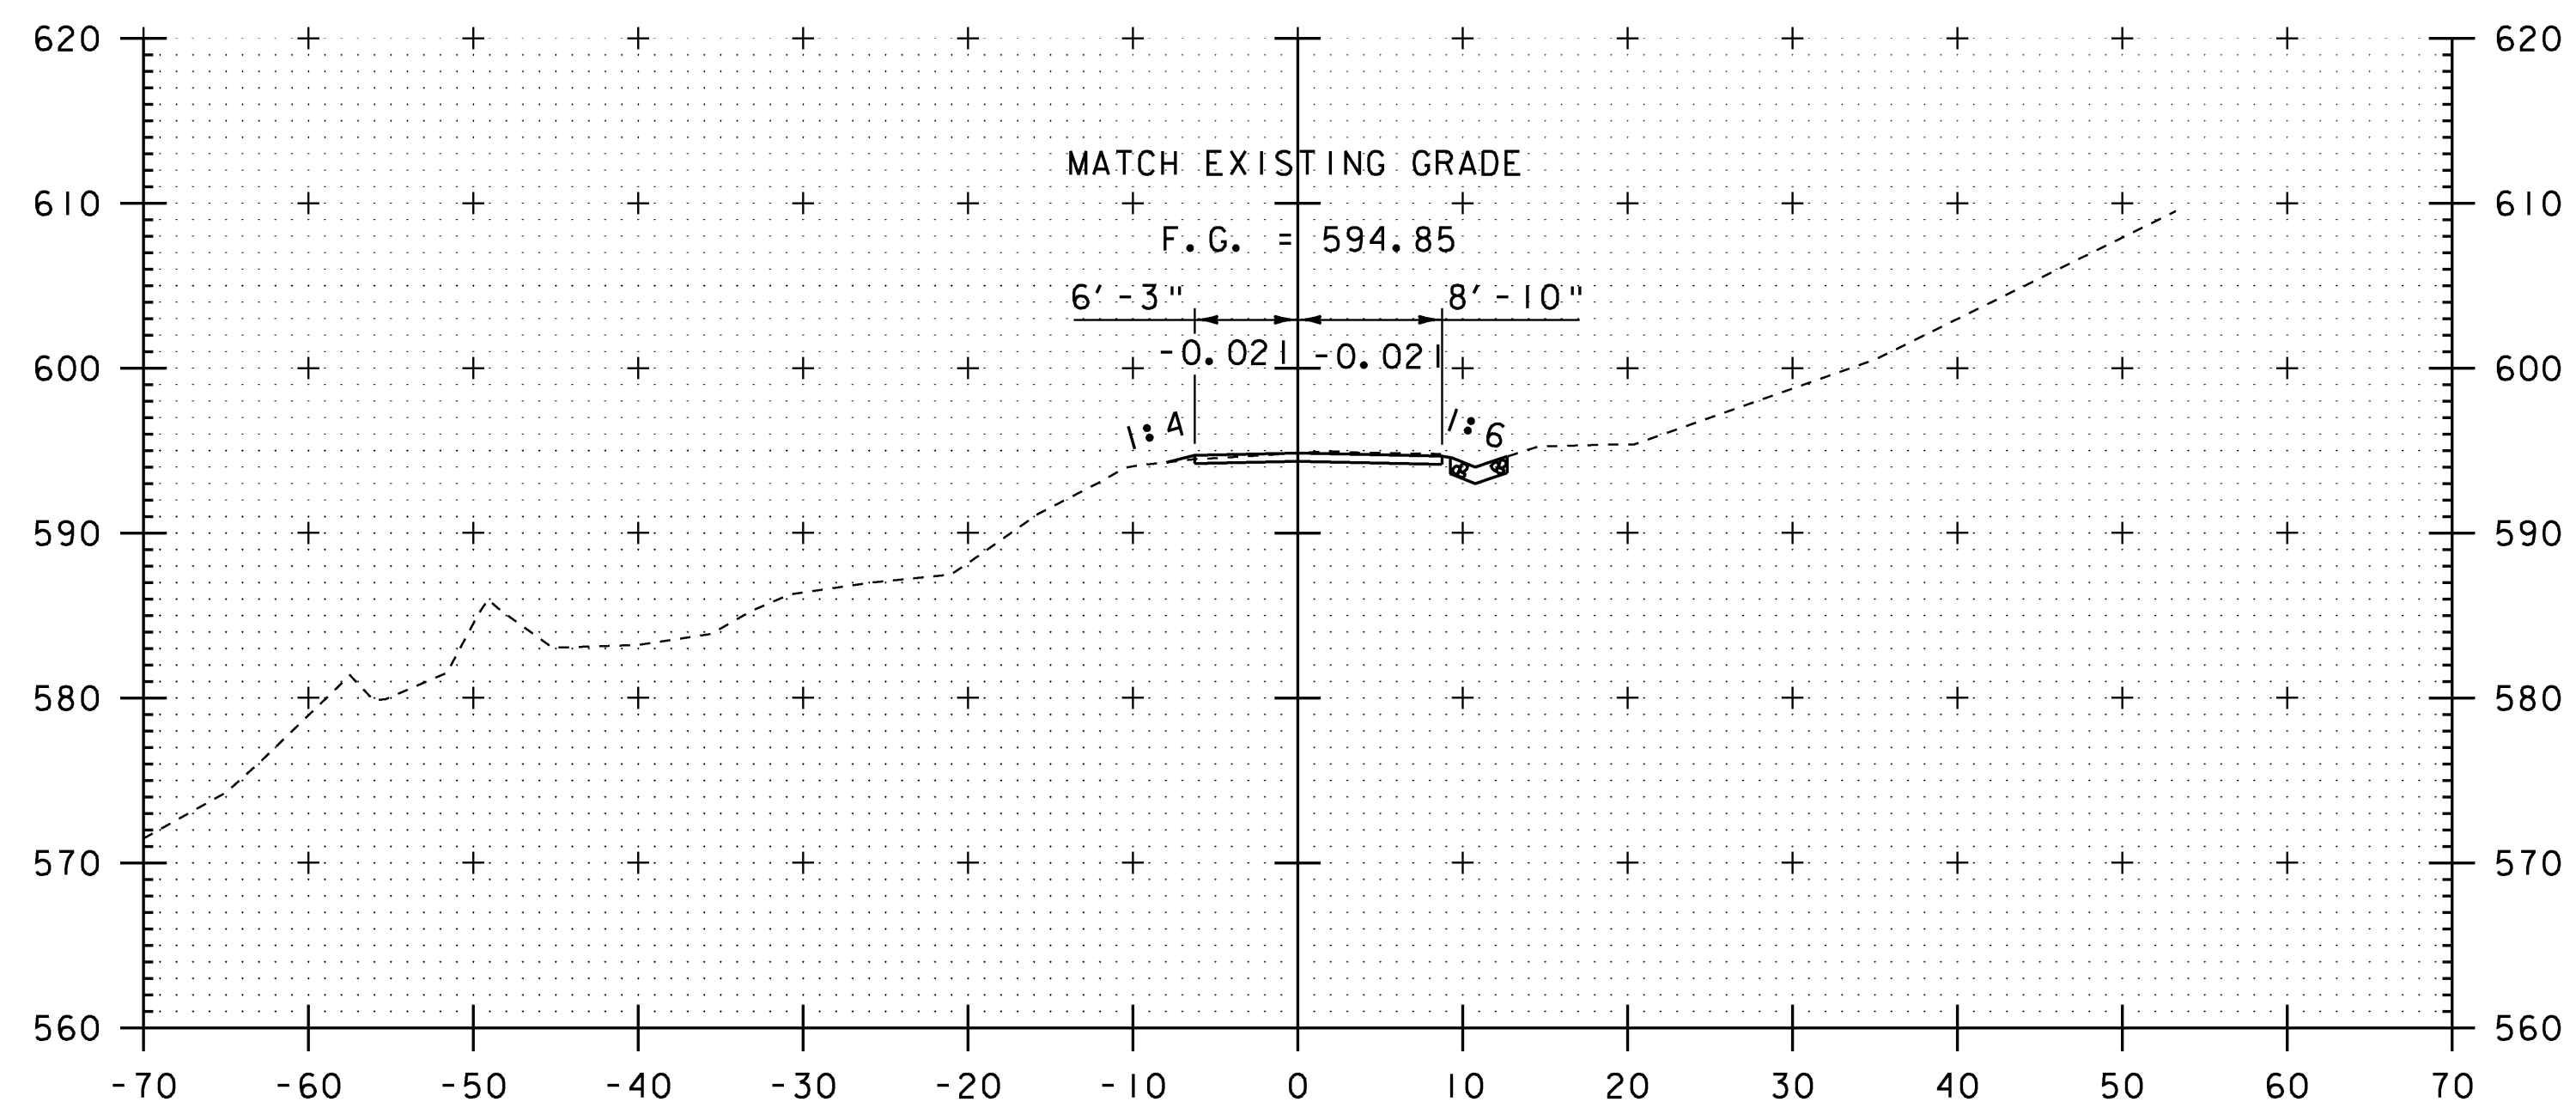

50+40
BEGIN APPROACH

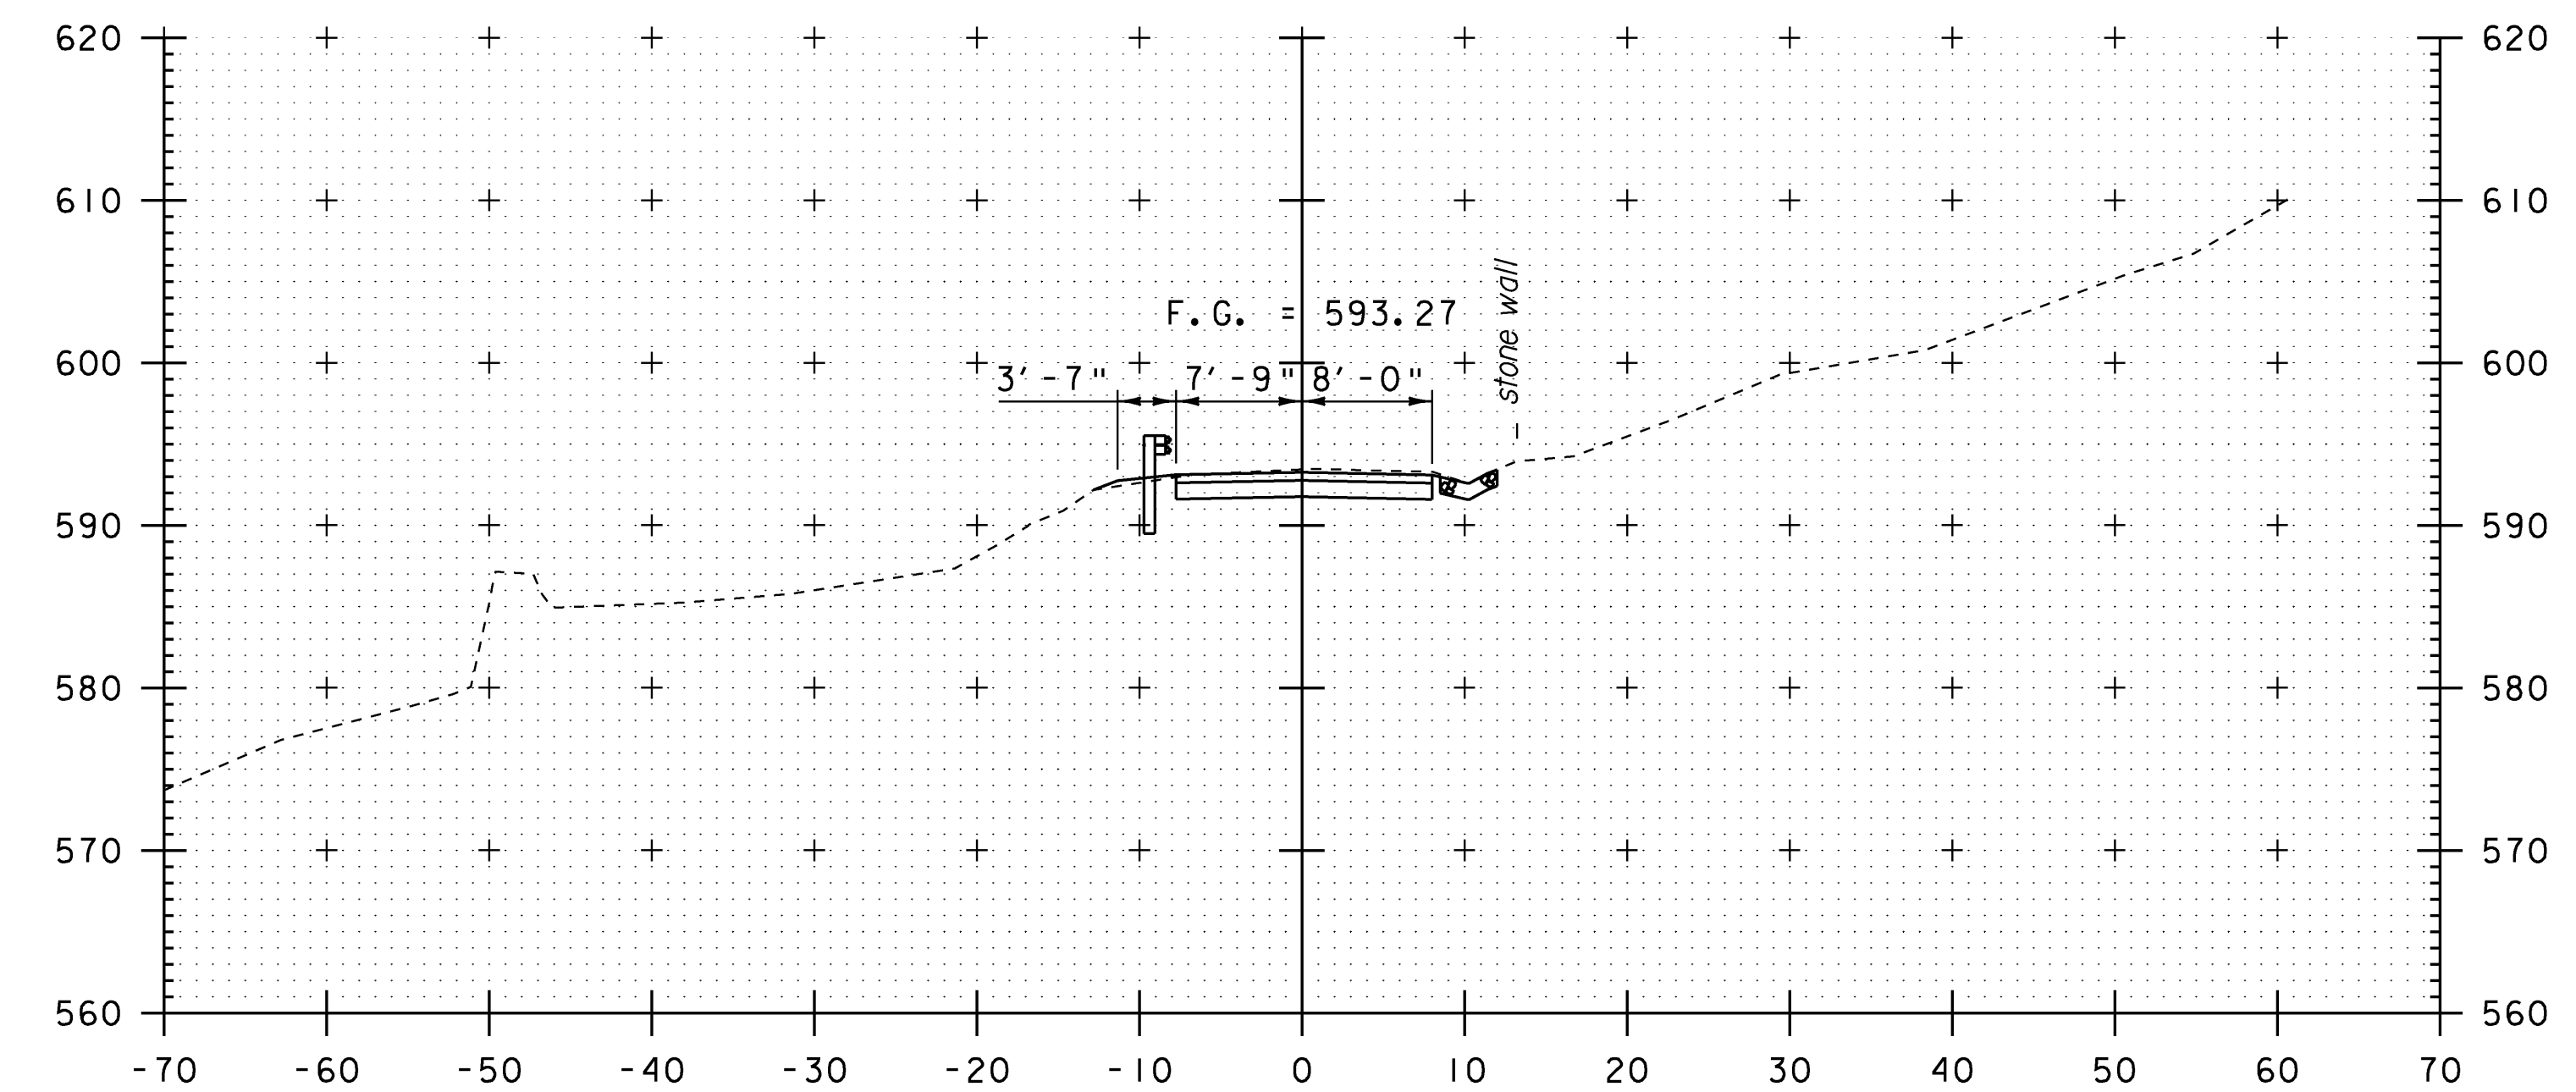

50+75

STA. 50+40 - STA. 51+00

SCALE: 1" = 10'-0"
10 0 10

MODEL
5040 to 5100
HTA PROJECT NO.
904214

Hoyle, Tanner & Associates, Inc.

PROJECT NAME: MONTGOMERY
PROJECT NUMBER: BHO 1448(23)
FILE NAME: Z96J302XSI.dgn
PROJECT LEADER: J.H.WEAVER
DESIGNED BY: J.BICJA
T.H. 27 CROSS SECTIONS (1 OF 4)

PLOT DATE: 8/1/2008
DRAWN BY: J.B.McQUAID
CHECKED BY: S.T.JAMES
SHEET 49 OF 54