



52+16

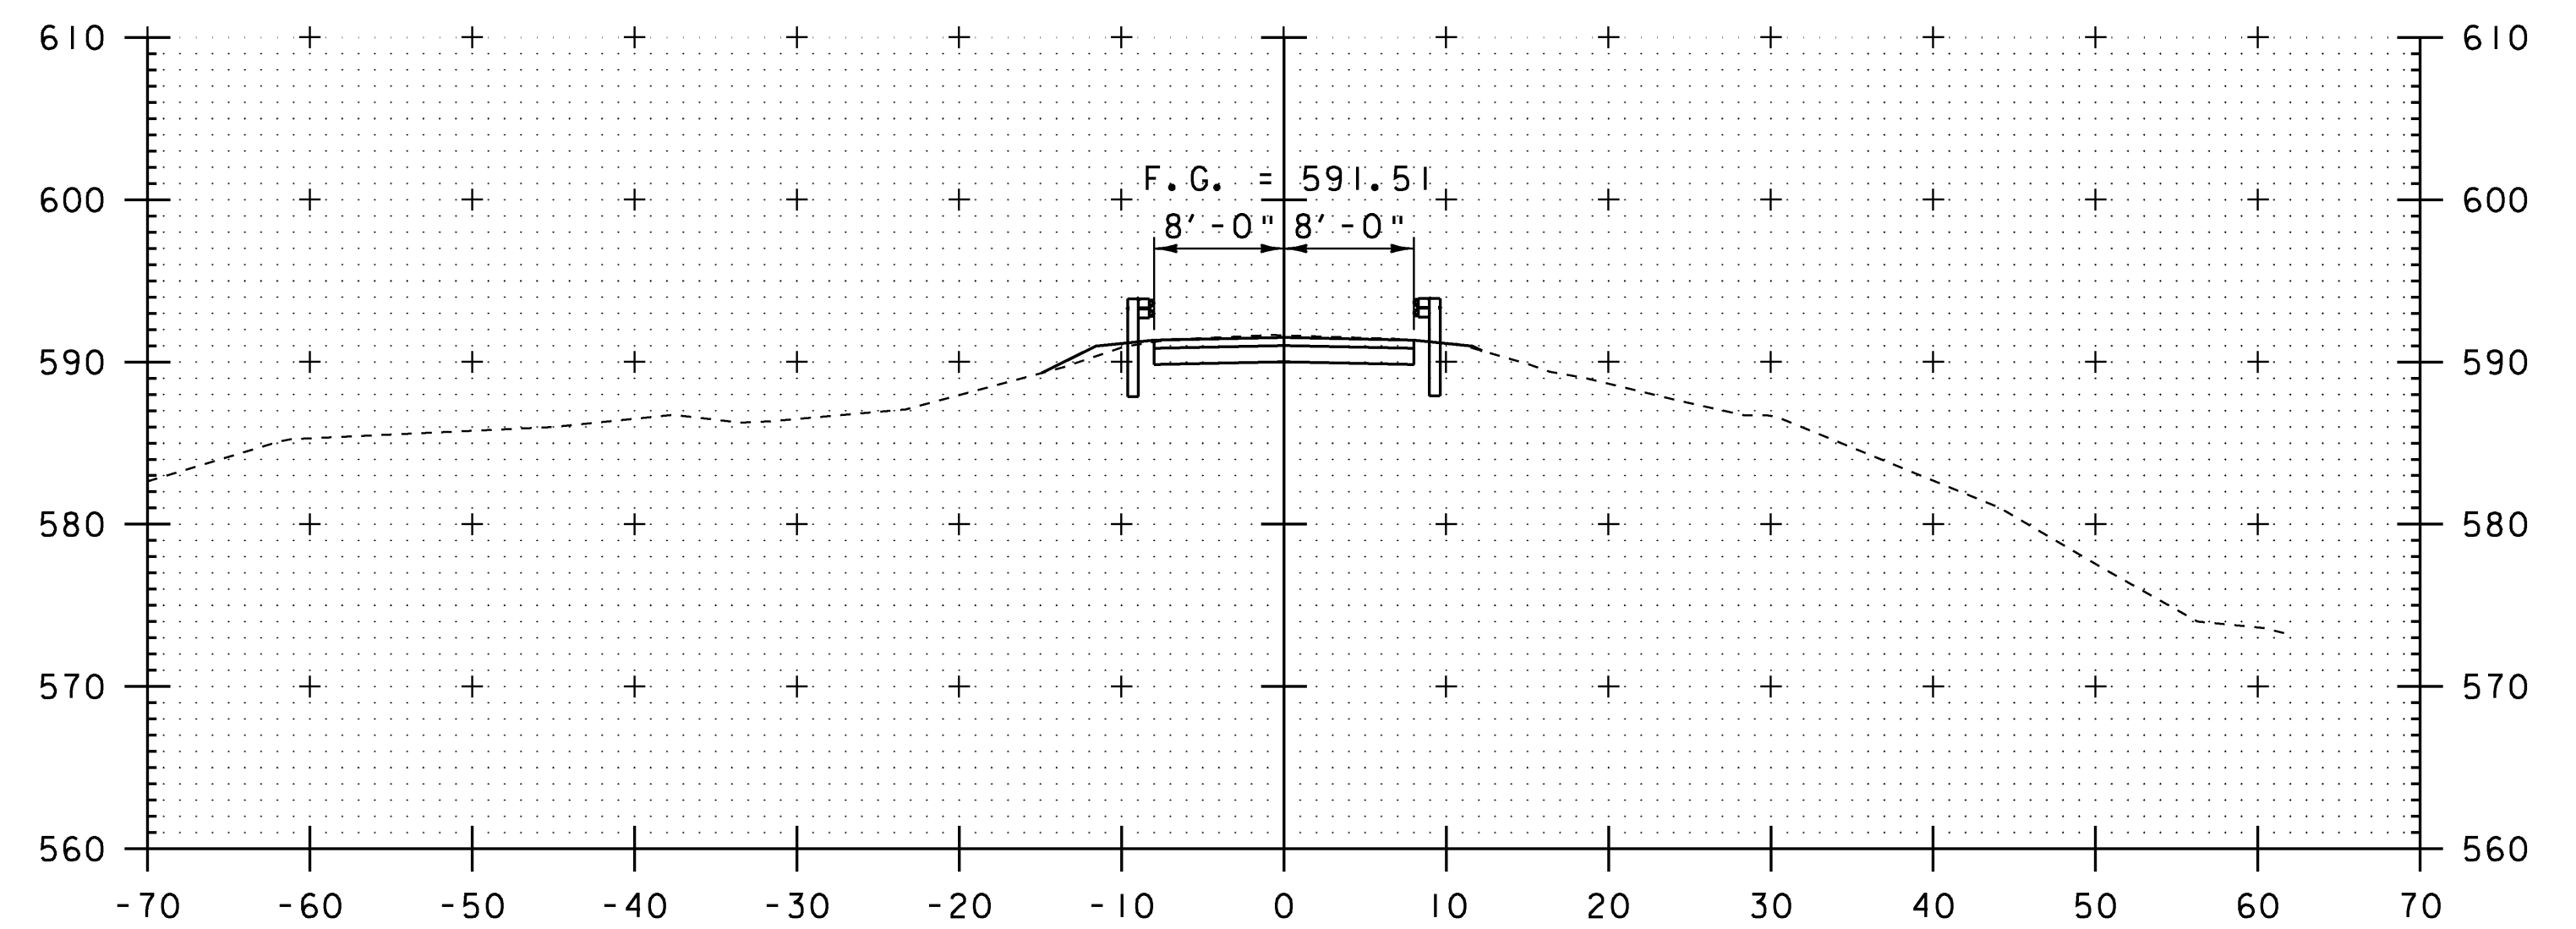


52+50

END BRIDGE
STA. 52+14.12

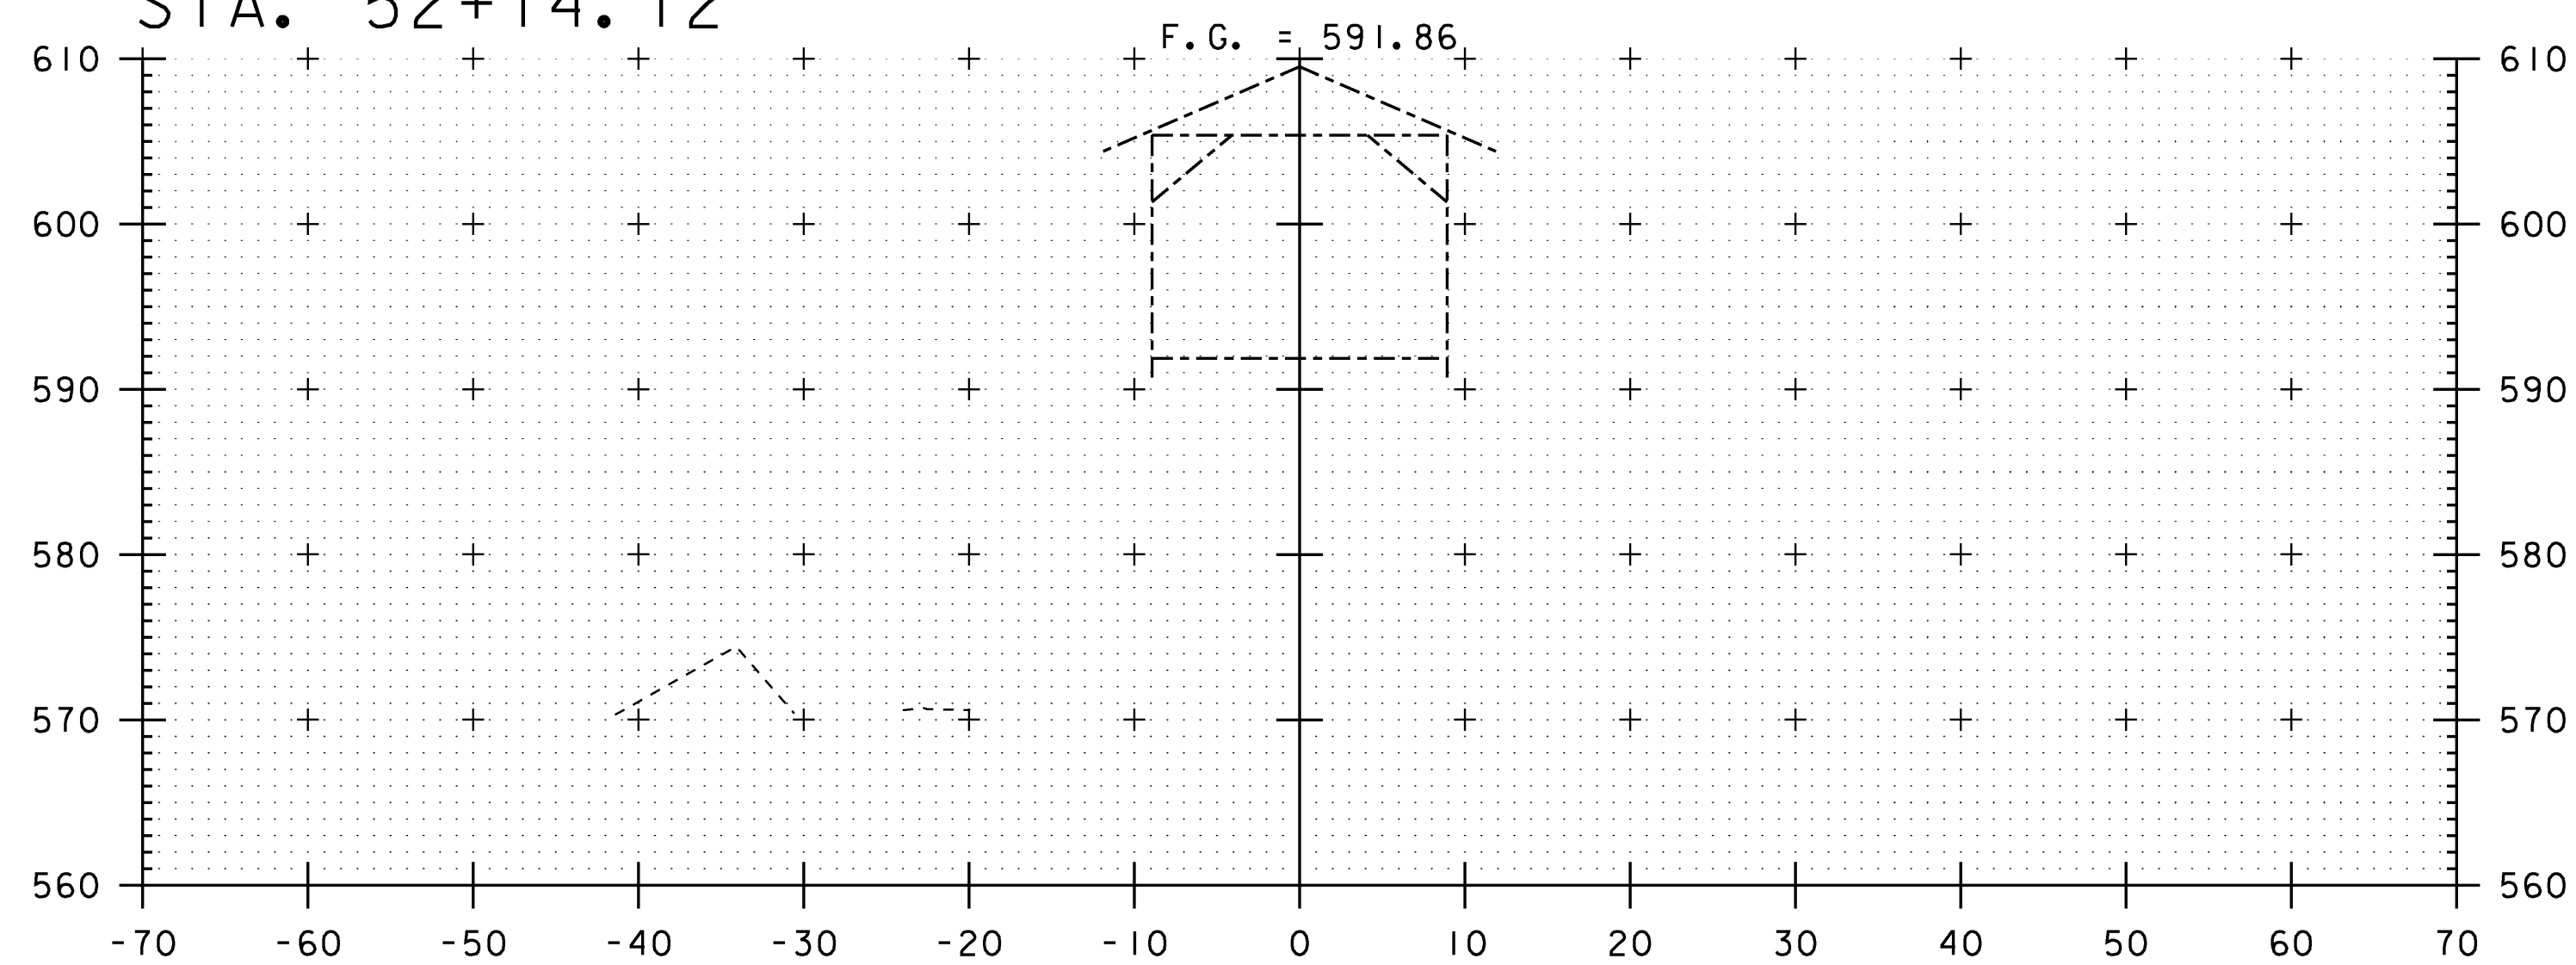

52+00

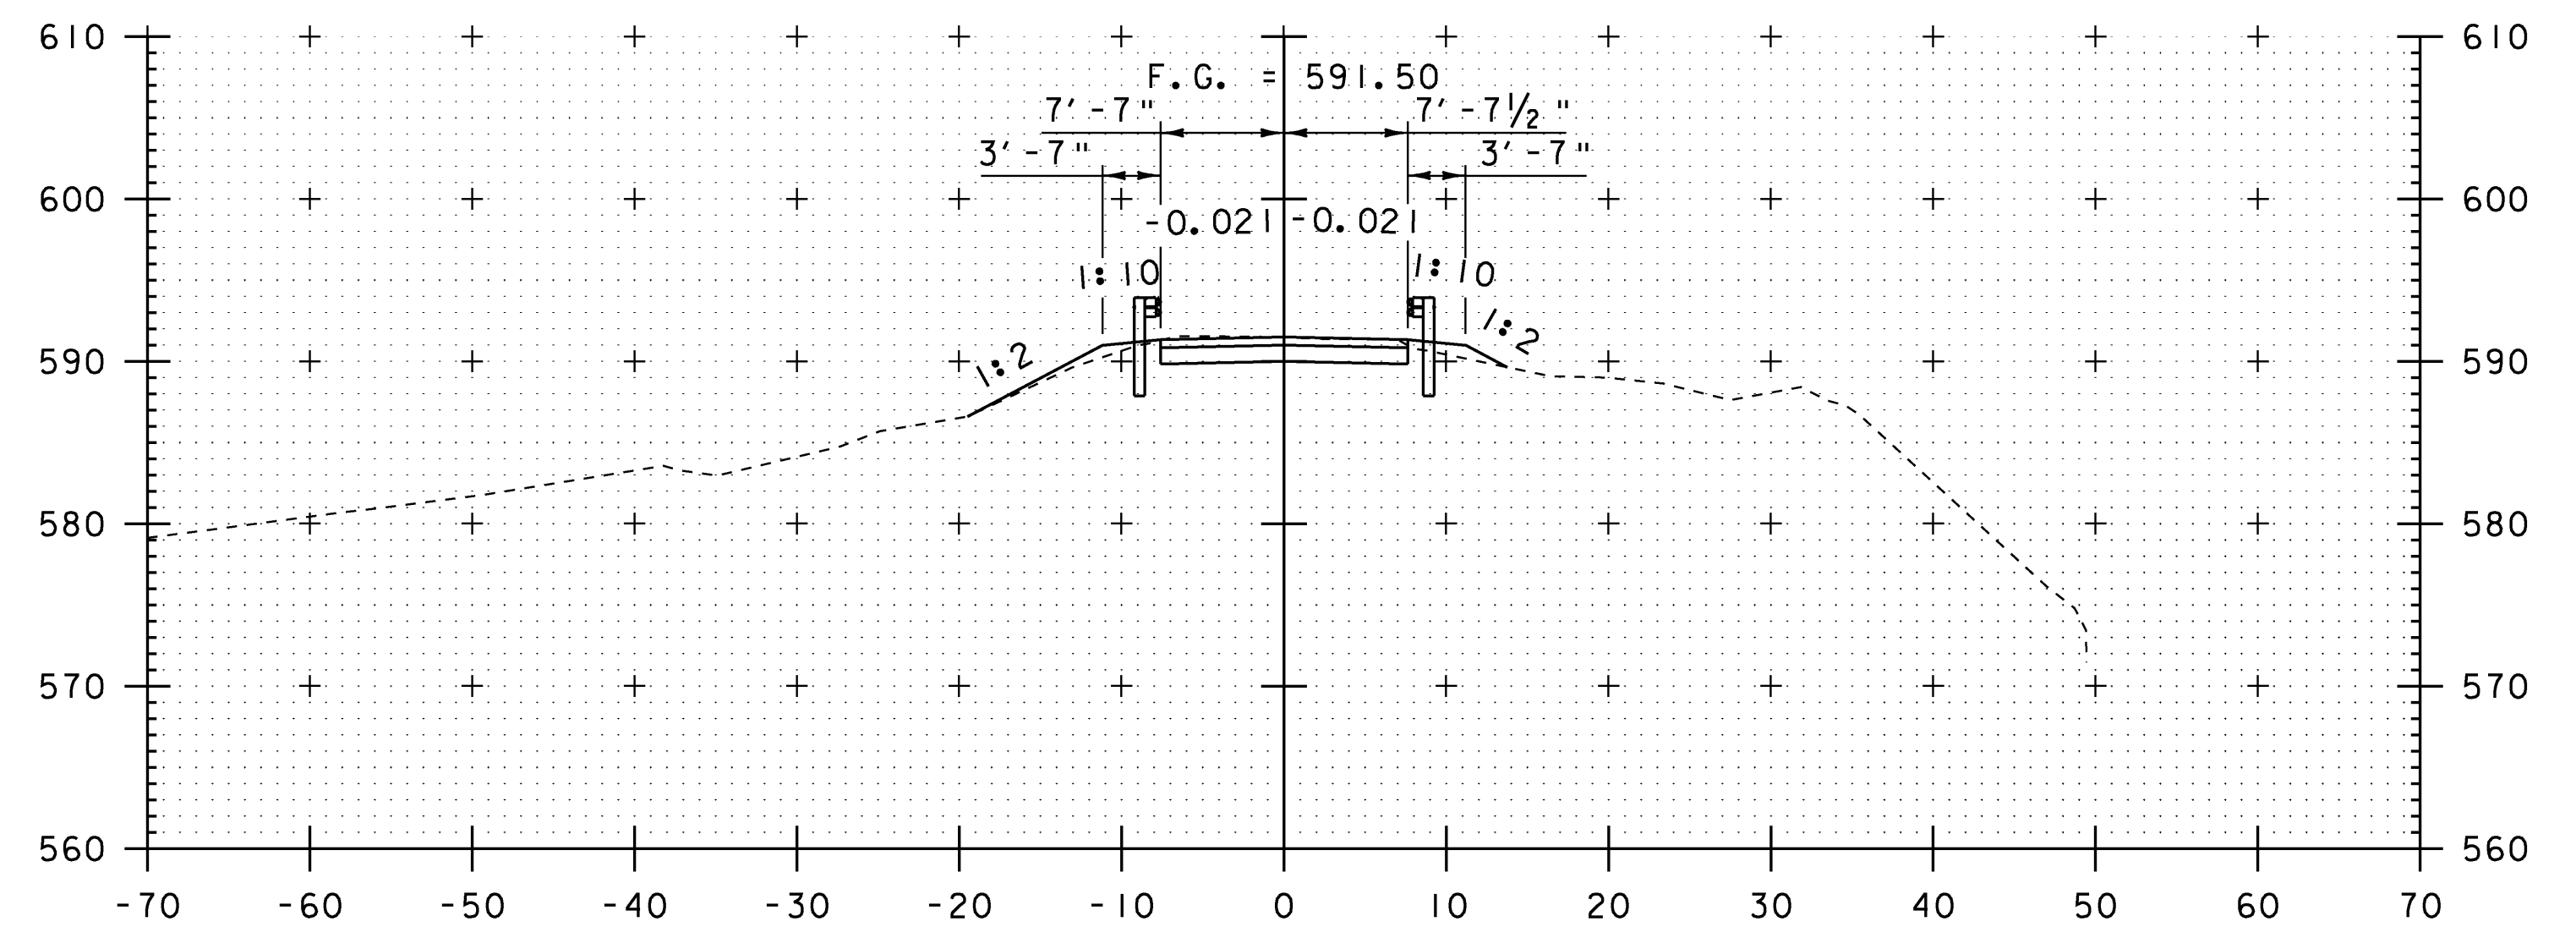

52+25

STA. 52+00 - STA. 52+50

SCALE: 1" = 10'-0"
10 0 10

MODEL
5216 TO 5275
HTA PROJECT NO.
904214

PROJECT NAME: MONTGOMERY
PROJECT NUMBER: BHO 1448(23)

FILE NAME: Z96J302XS3.dgn
PROJECT LEADER: J.H.WEAVER
DESIGNED BY: J.BICJA
T.H. 27 CROSS SECTIONS (3 OF 4)

PLOT DATE: 8/1/2008
DRAWN BY: J.B.McQUAID
CHECKED BY: S.T.JAMES
SHEET 51 OF 54

Hoyle, Tanner & Associates, Inc.