




53+00

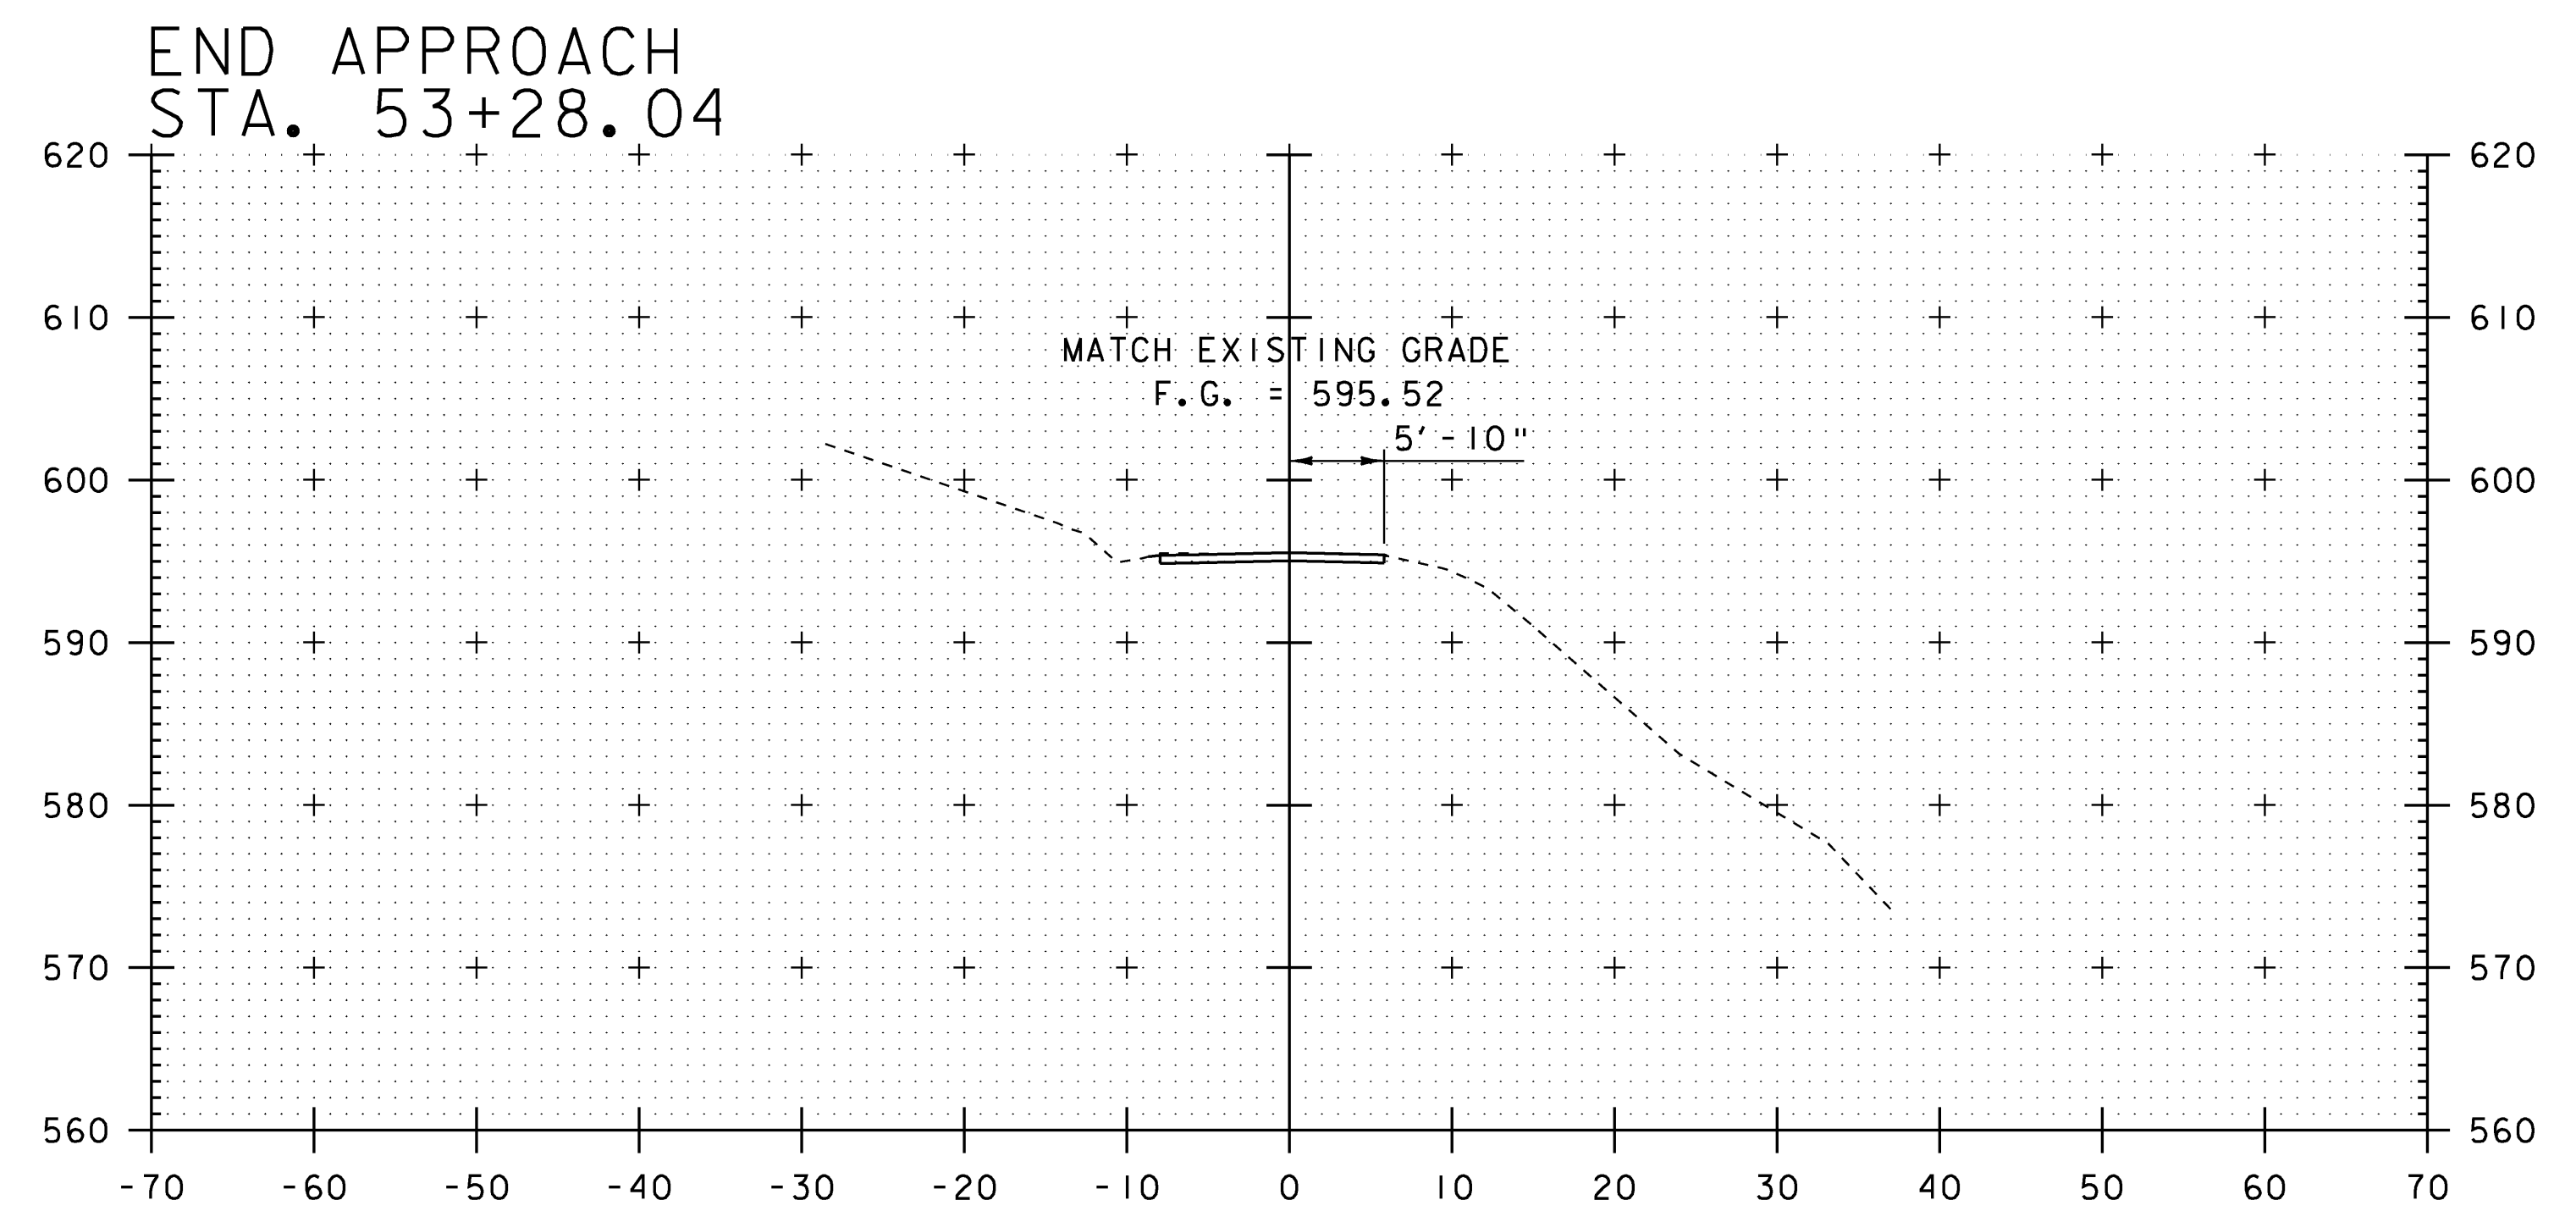

53+28

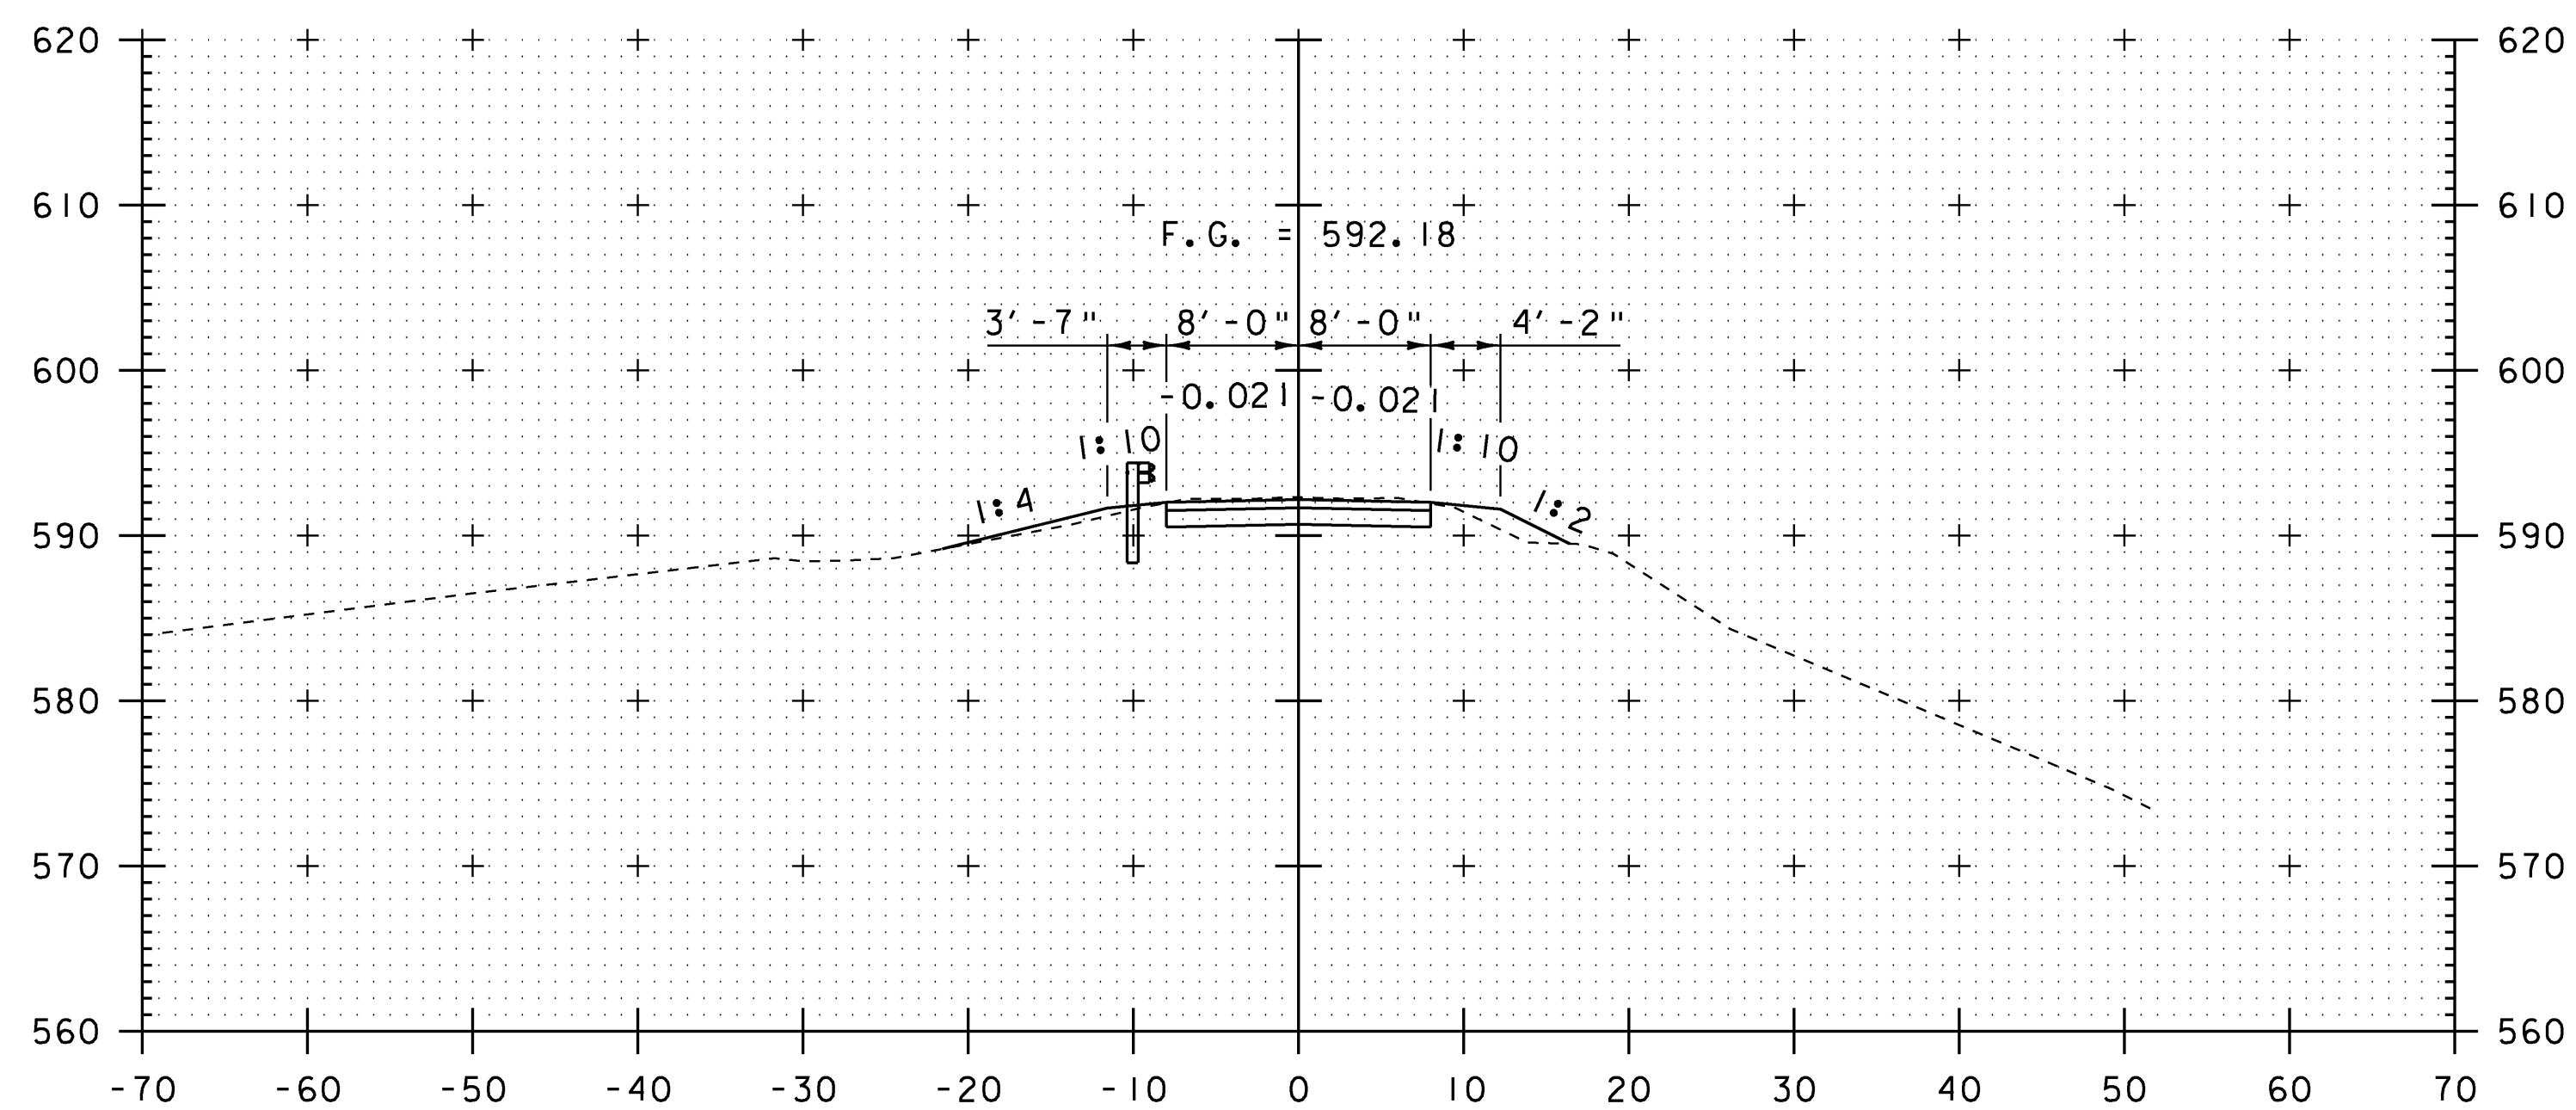


52+75

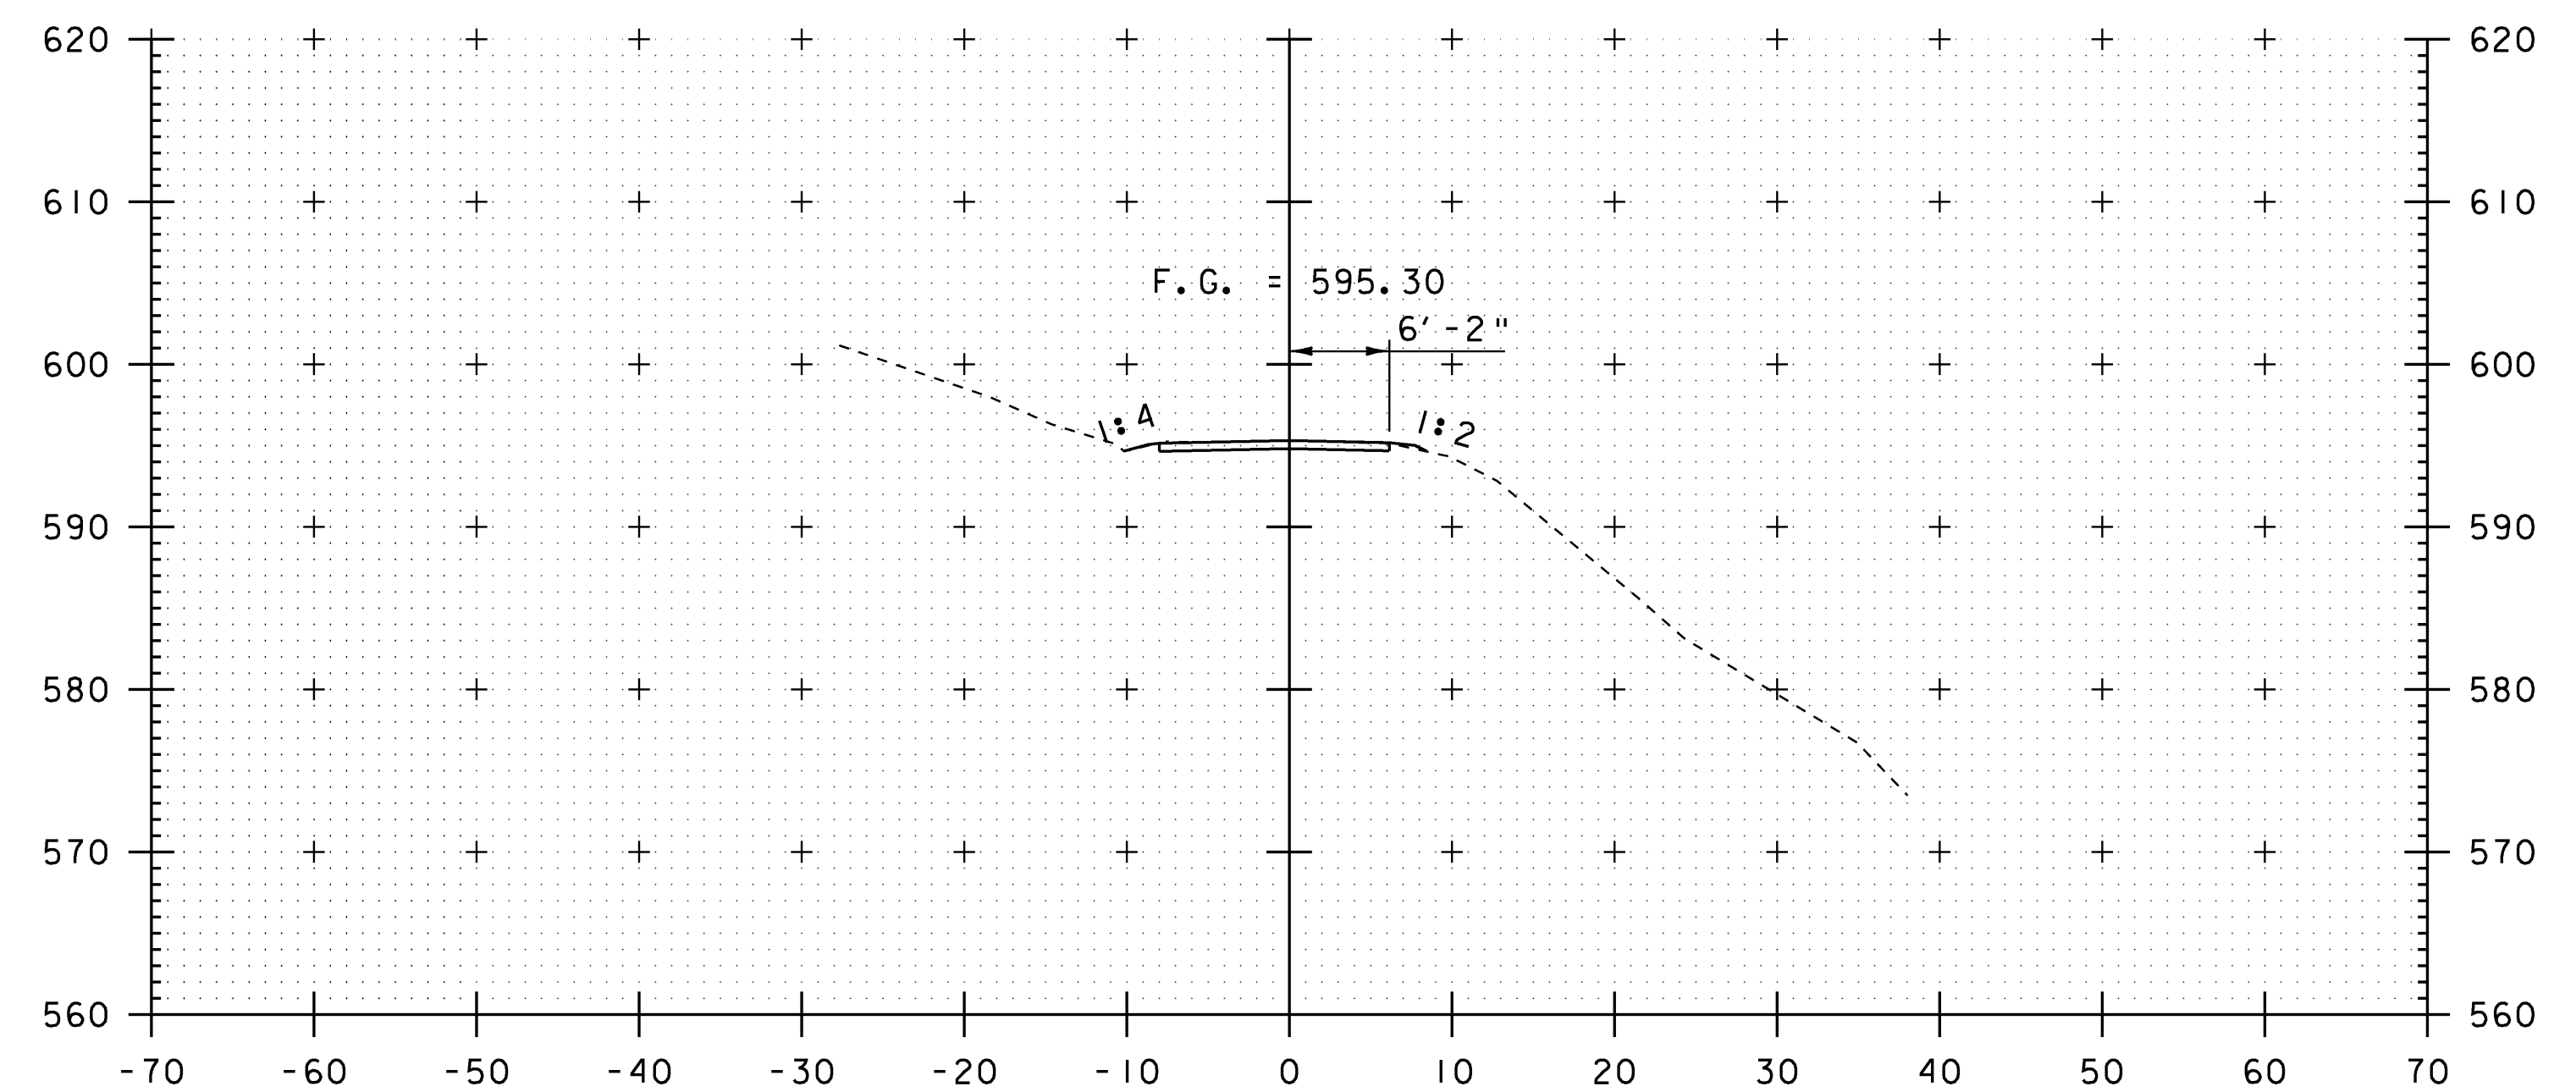

53+25

END PROJECT
BEGIN APPROACH
STA. 53+18.04

STA. 52+75 - STA. 53+28

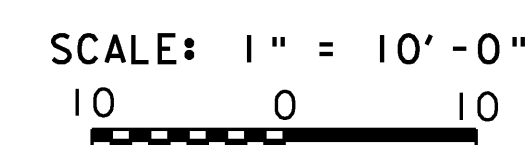

Hoyle, Tanner & Associates, Inc.

MODEL
5300 TO 5328
HTA PROJECT NO.
904214

PROJECT NAME: MONTGOMERY
PROJECT NUMBER: BHO 1448(23)
FILE NAME: Z96J302XS4.dgn
PROJECT LEADER: J.H.WEAVER
DESIGNED BY: J.BICJA
T.H. 27 CROSS SECTIONS (4 OF 4)

PLOT DATE: 8/1/2008
DRAWN BY: J.B.McQUAID
CHECKED BY: S.T.JAMES
SHEET 52 OF 54