



STA. 250+25 RT.  
 END -UNCLASSIFIED CHANNEL EXCAVATION  
 -GEOTEXTILE UNDER STONE FILL  
 -STONE FILL, TYPE IV

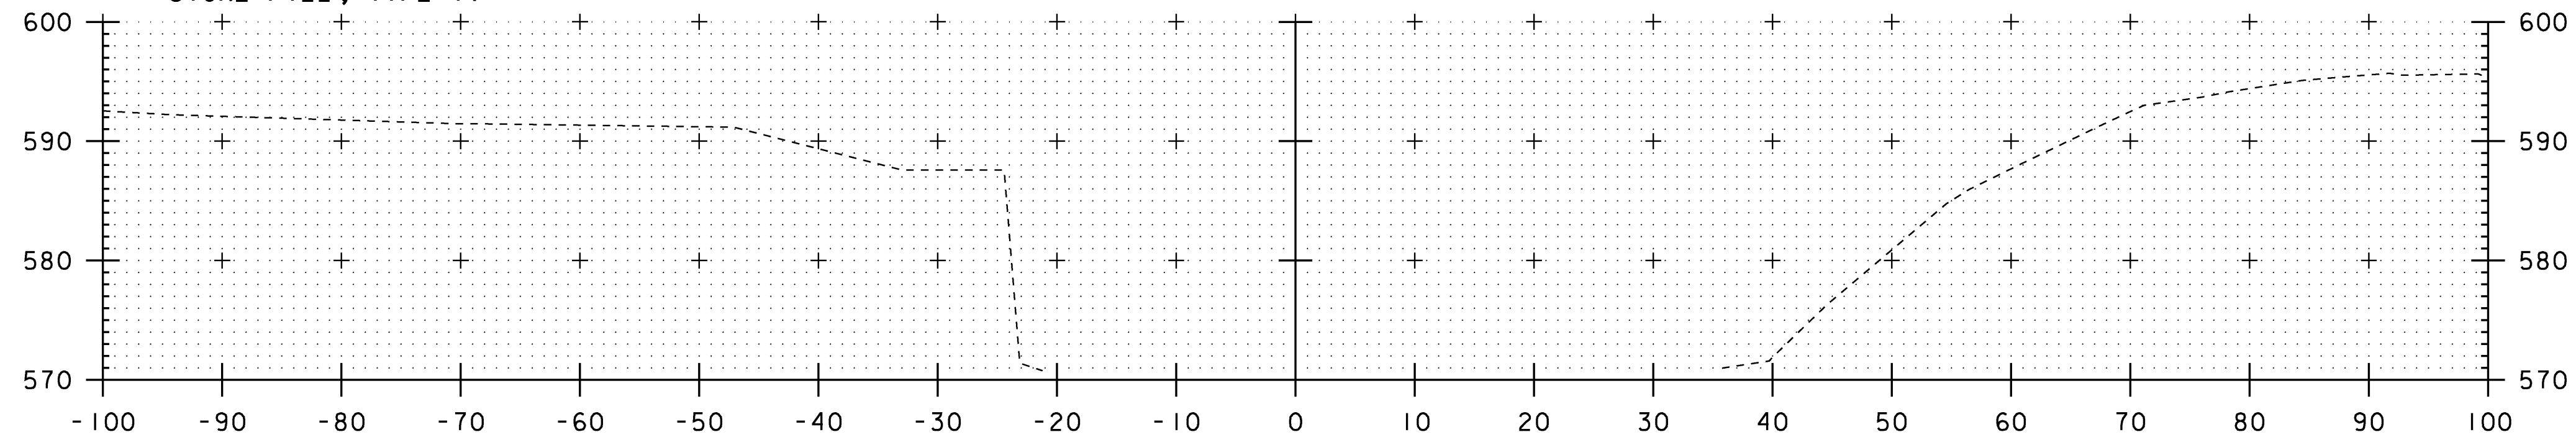


250+25

STA. 250+08 RT.  
 BEGIN -UNCLASSIFIED CHANNEL EXCAVATION  
 -GEOTEXTILE UNDER STONE FILL  
 -STONE FILL, TYPE IV

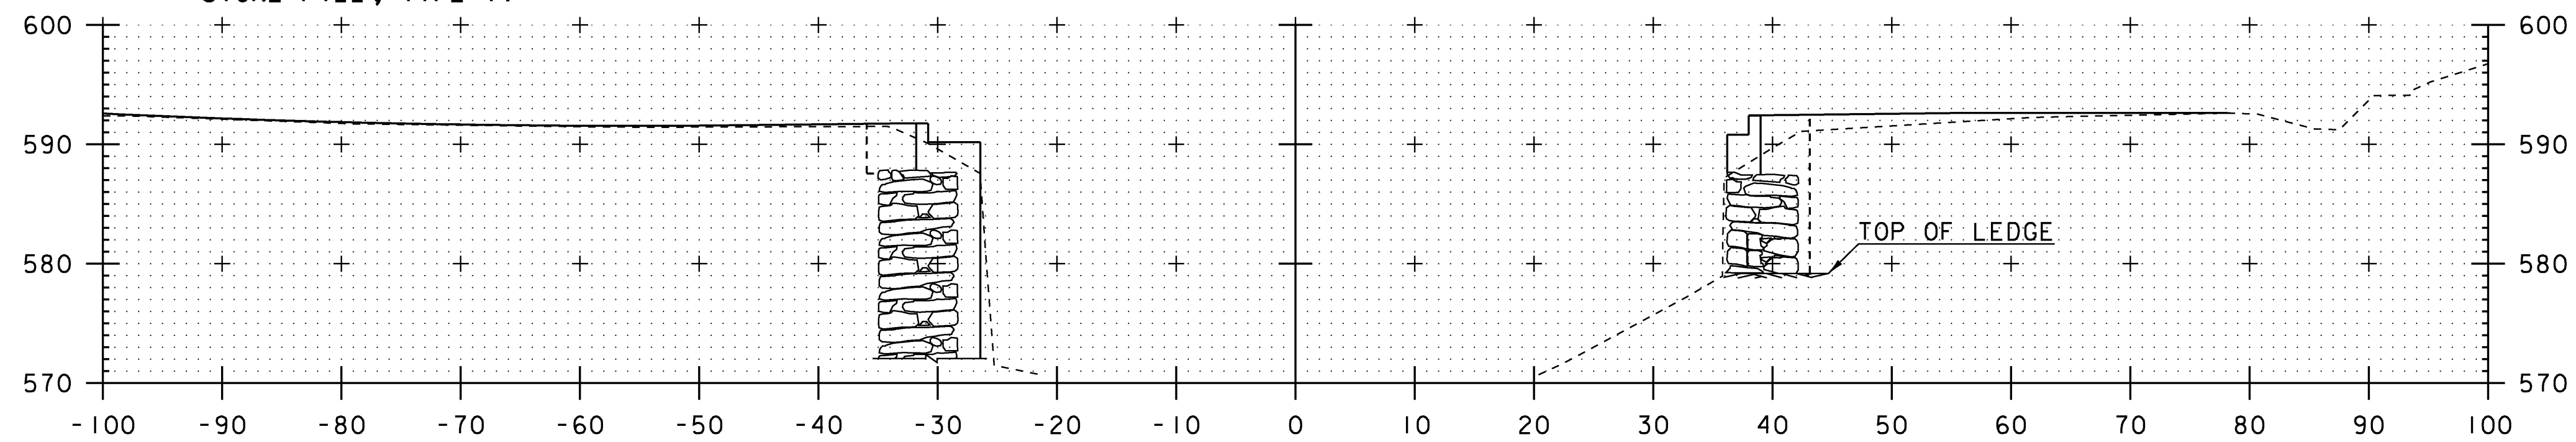

250+00

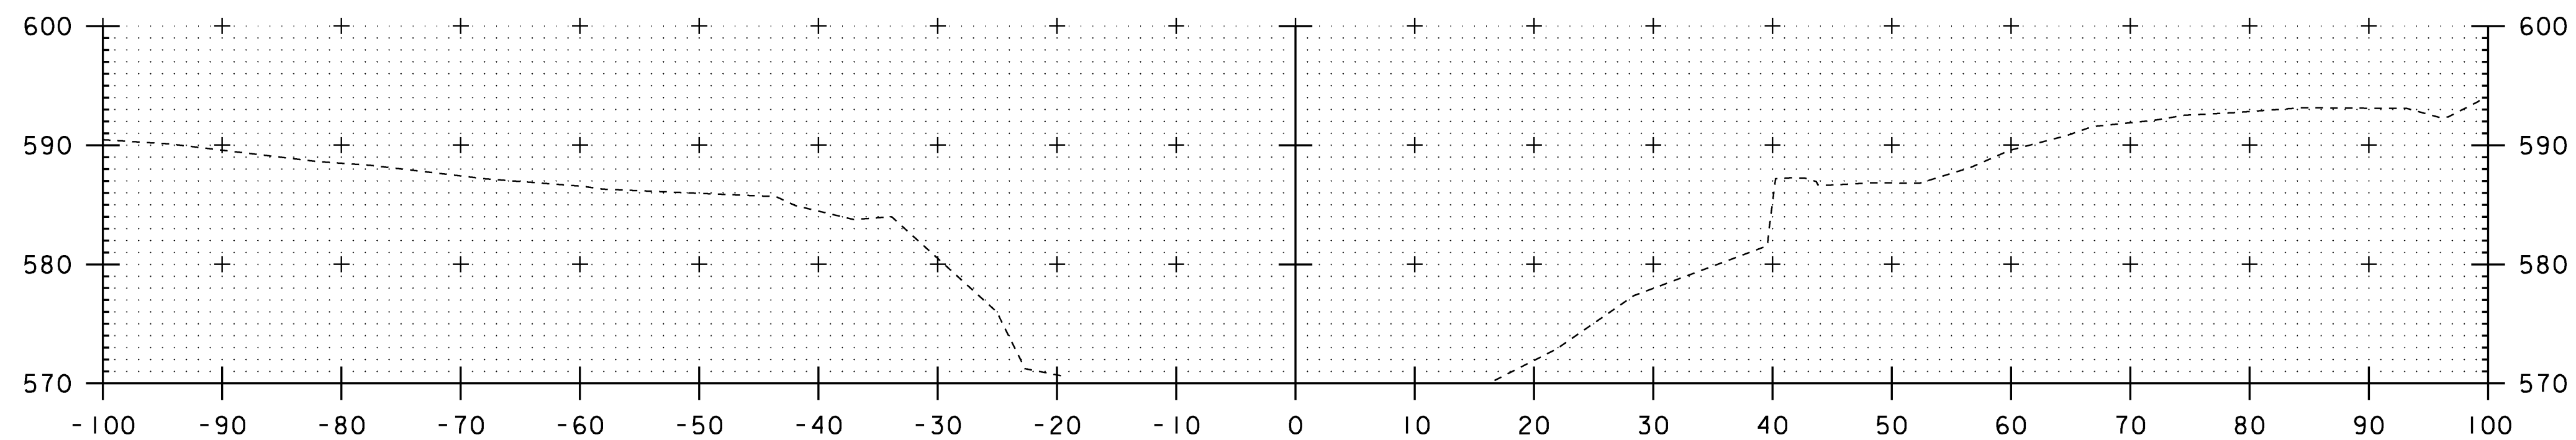

249+75

STA. 249+75 - STA. 250+25

SCALE: 1" = 10'-0"  
 10 0 10

MODEL
5040 to 5100
HTA PROJECT NO.
904214

Hoyle, Tanner & Associates, Inc.

PROJECT NAME: MONTGOMERY  
 PROJECT NUMBER: BHO 1448(23)  
 FILE NAME: Z96J302xs6.dgn  
 PROJECT LEADER: J.H.WEAVER  
 DESIGNED BY: J.BICJA  
**CHANNEL CROSS SECTIONS**

PLOT DATE: 8/1/2008  
 DRAWN BY: J.B.McQUAID  
 CHECKED BY: S.T.JAMES  
 SHEET 54 OF 54