



WINGWALL NO. 3

REPOINT AND RECHINK STONE MASONRY OF EXISTING ABUTMENT AND WINGWALLS, SEE DETAIL ON SHEET 14.


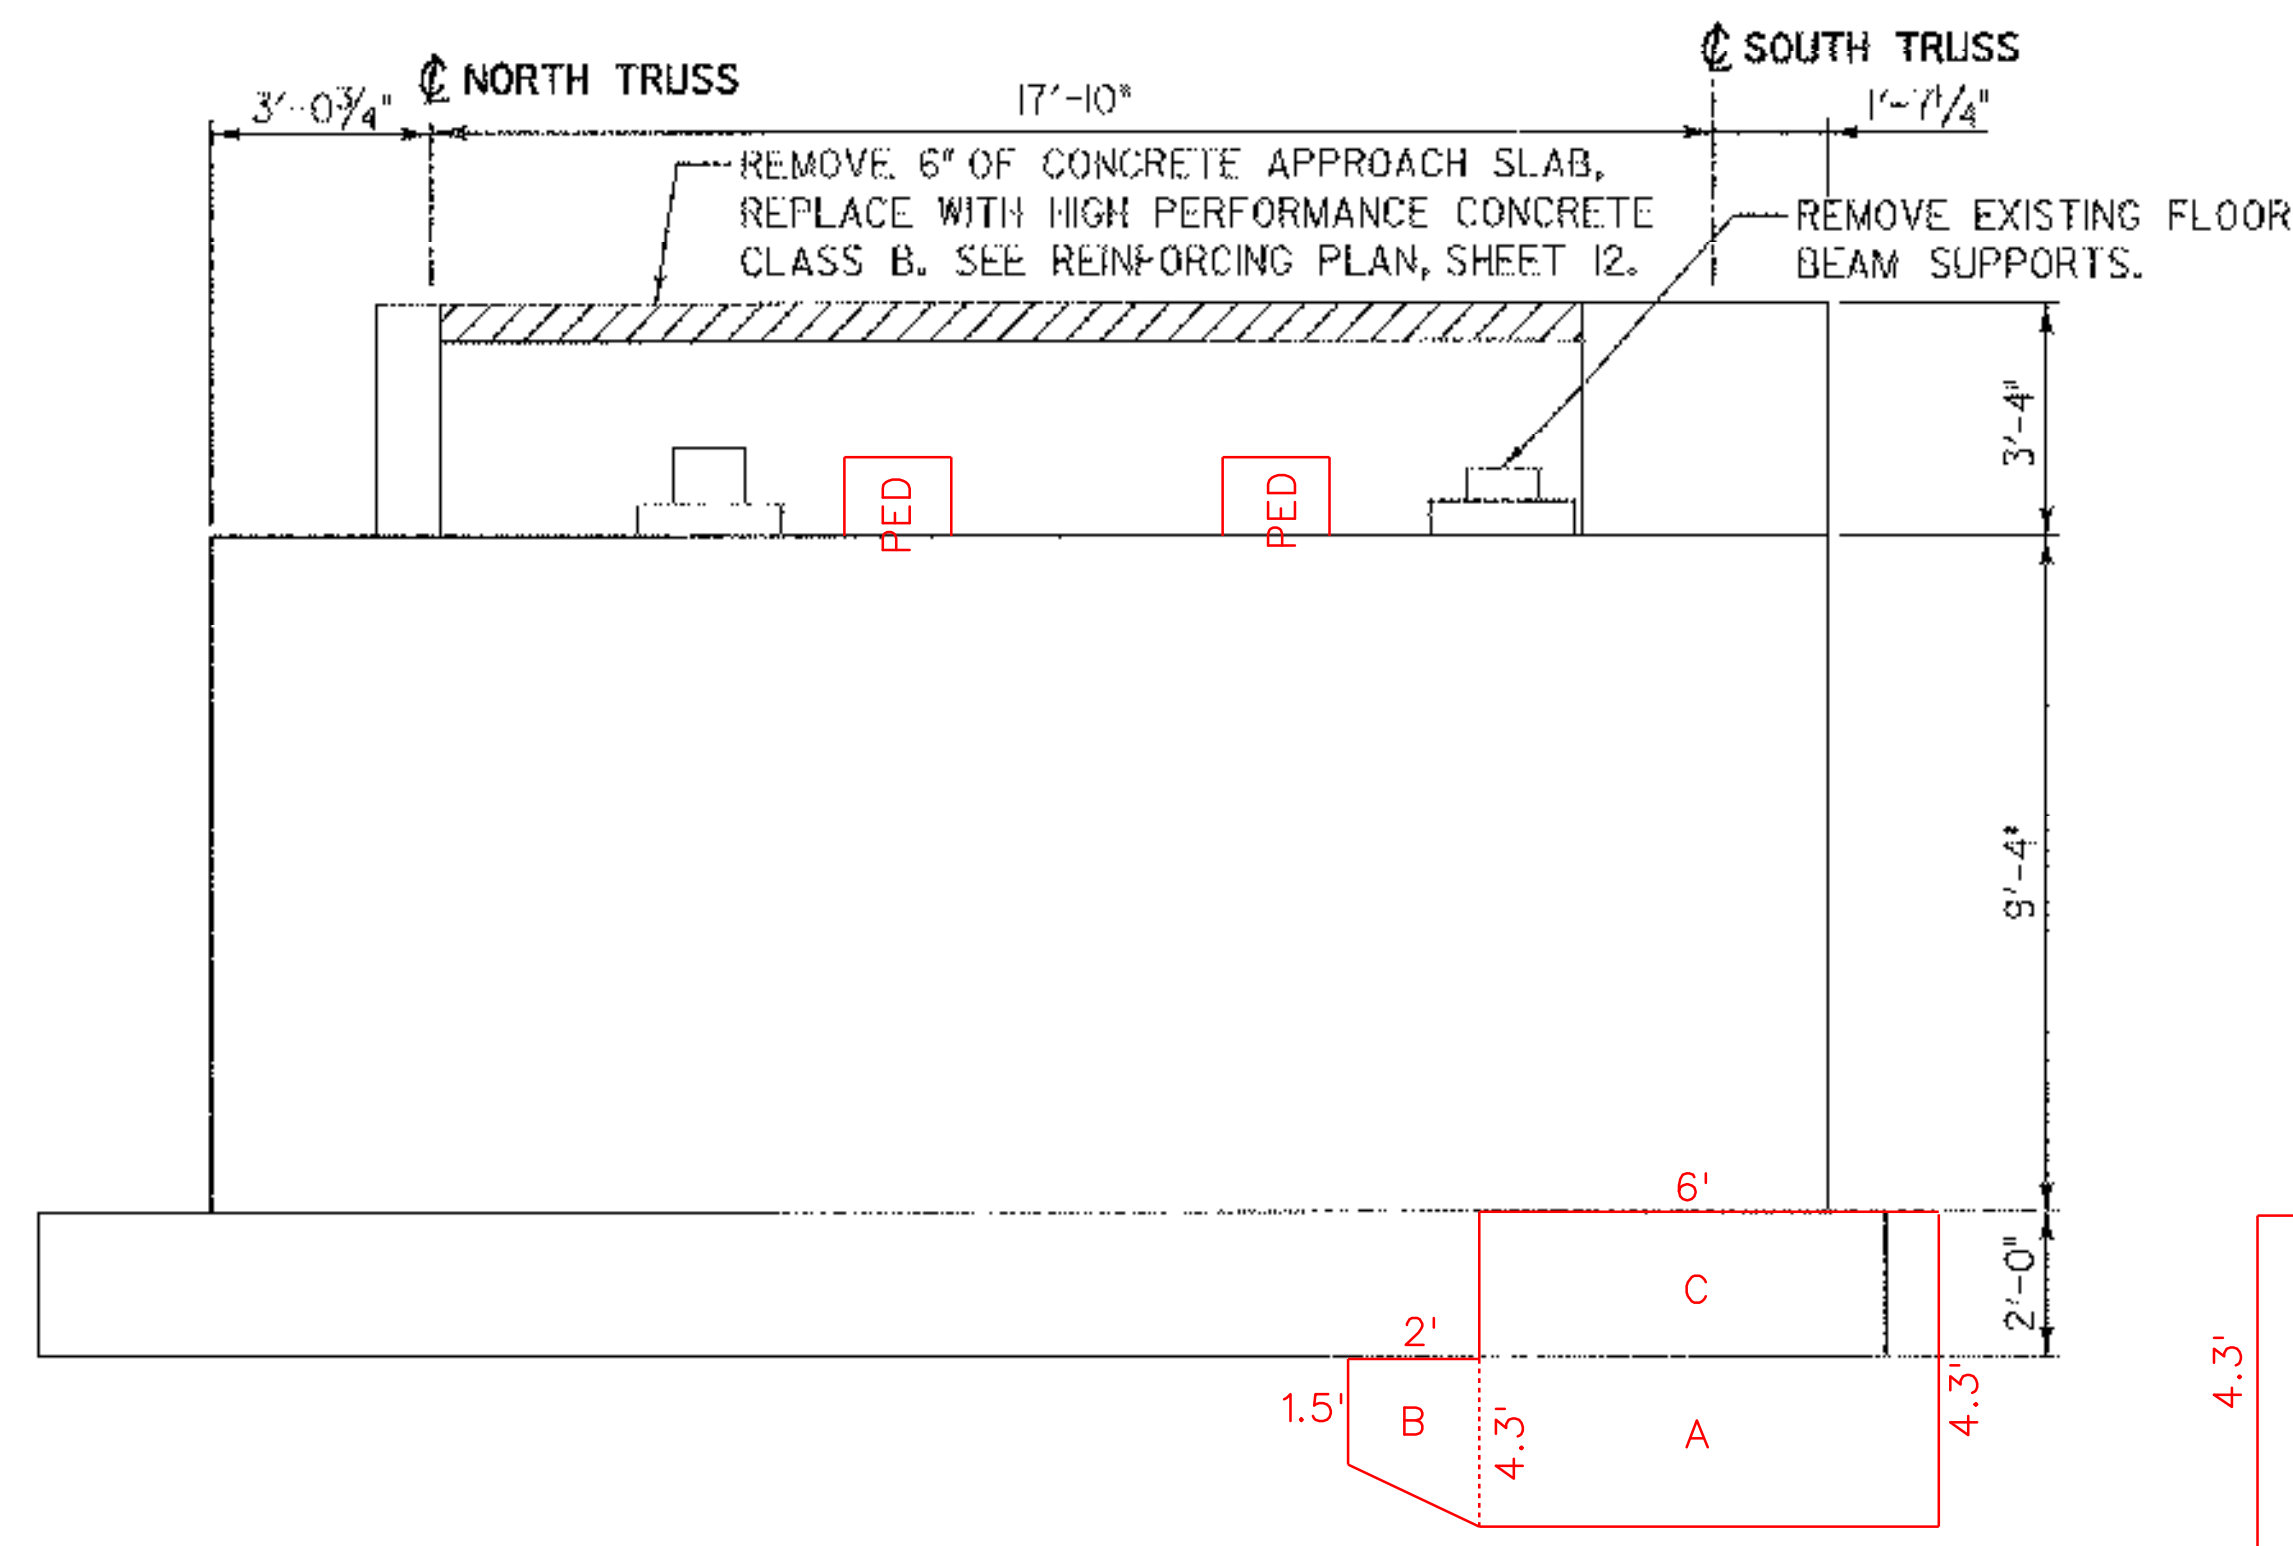


ABUTMENT NO. 2 ELEVATION

SCALE: 3/8" = 1'-0"  
 A= 6X2.3X3.0 = 41.4  
 B= 2X2.9(AVE.)X3.0 = 17.4  
 C= 17.4X0.5X2.0 = 17.4  
 D= 3.4X2.05X0.5 = 3.5  
 E= 4X1.55X3.0 = 18.6  
 F= 4X0.65X2.0 = 5.2  
 103.5=3.83 CY

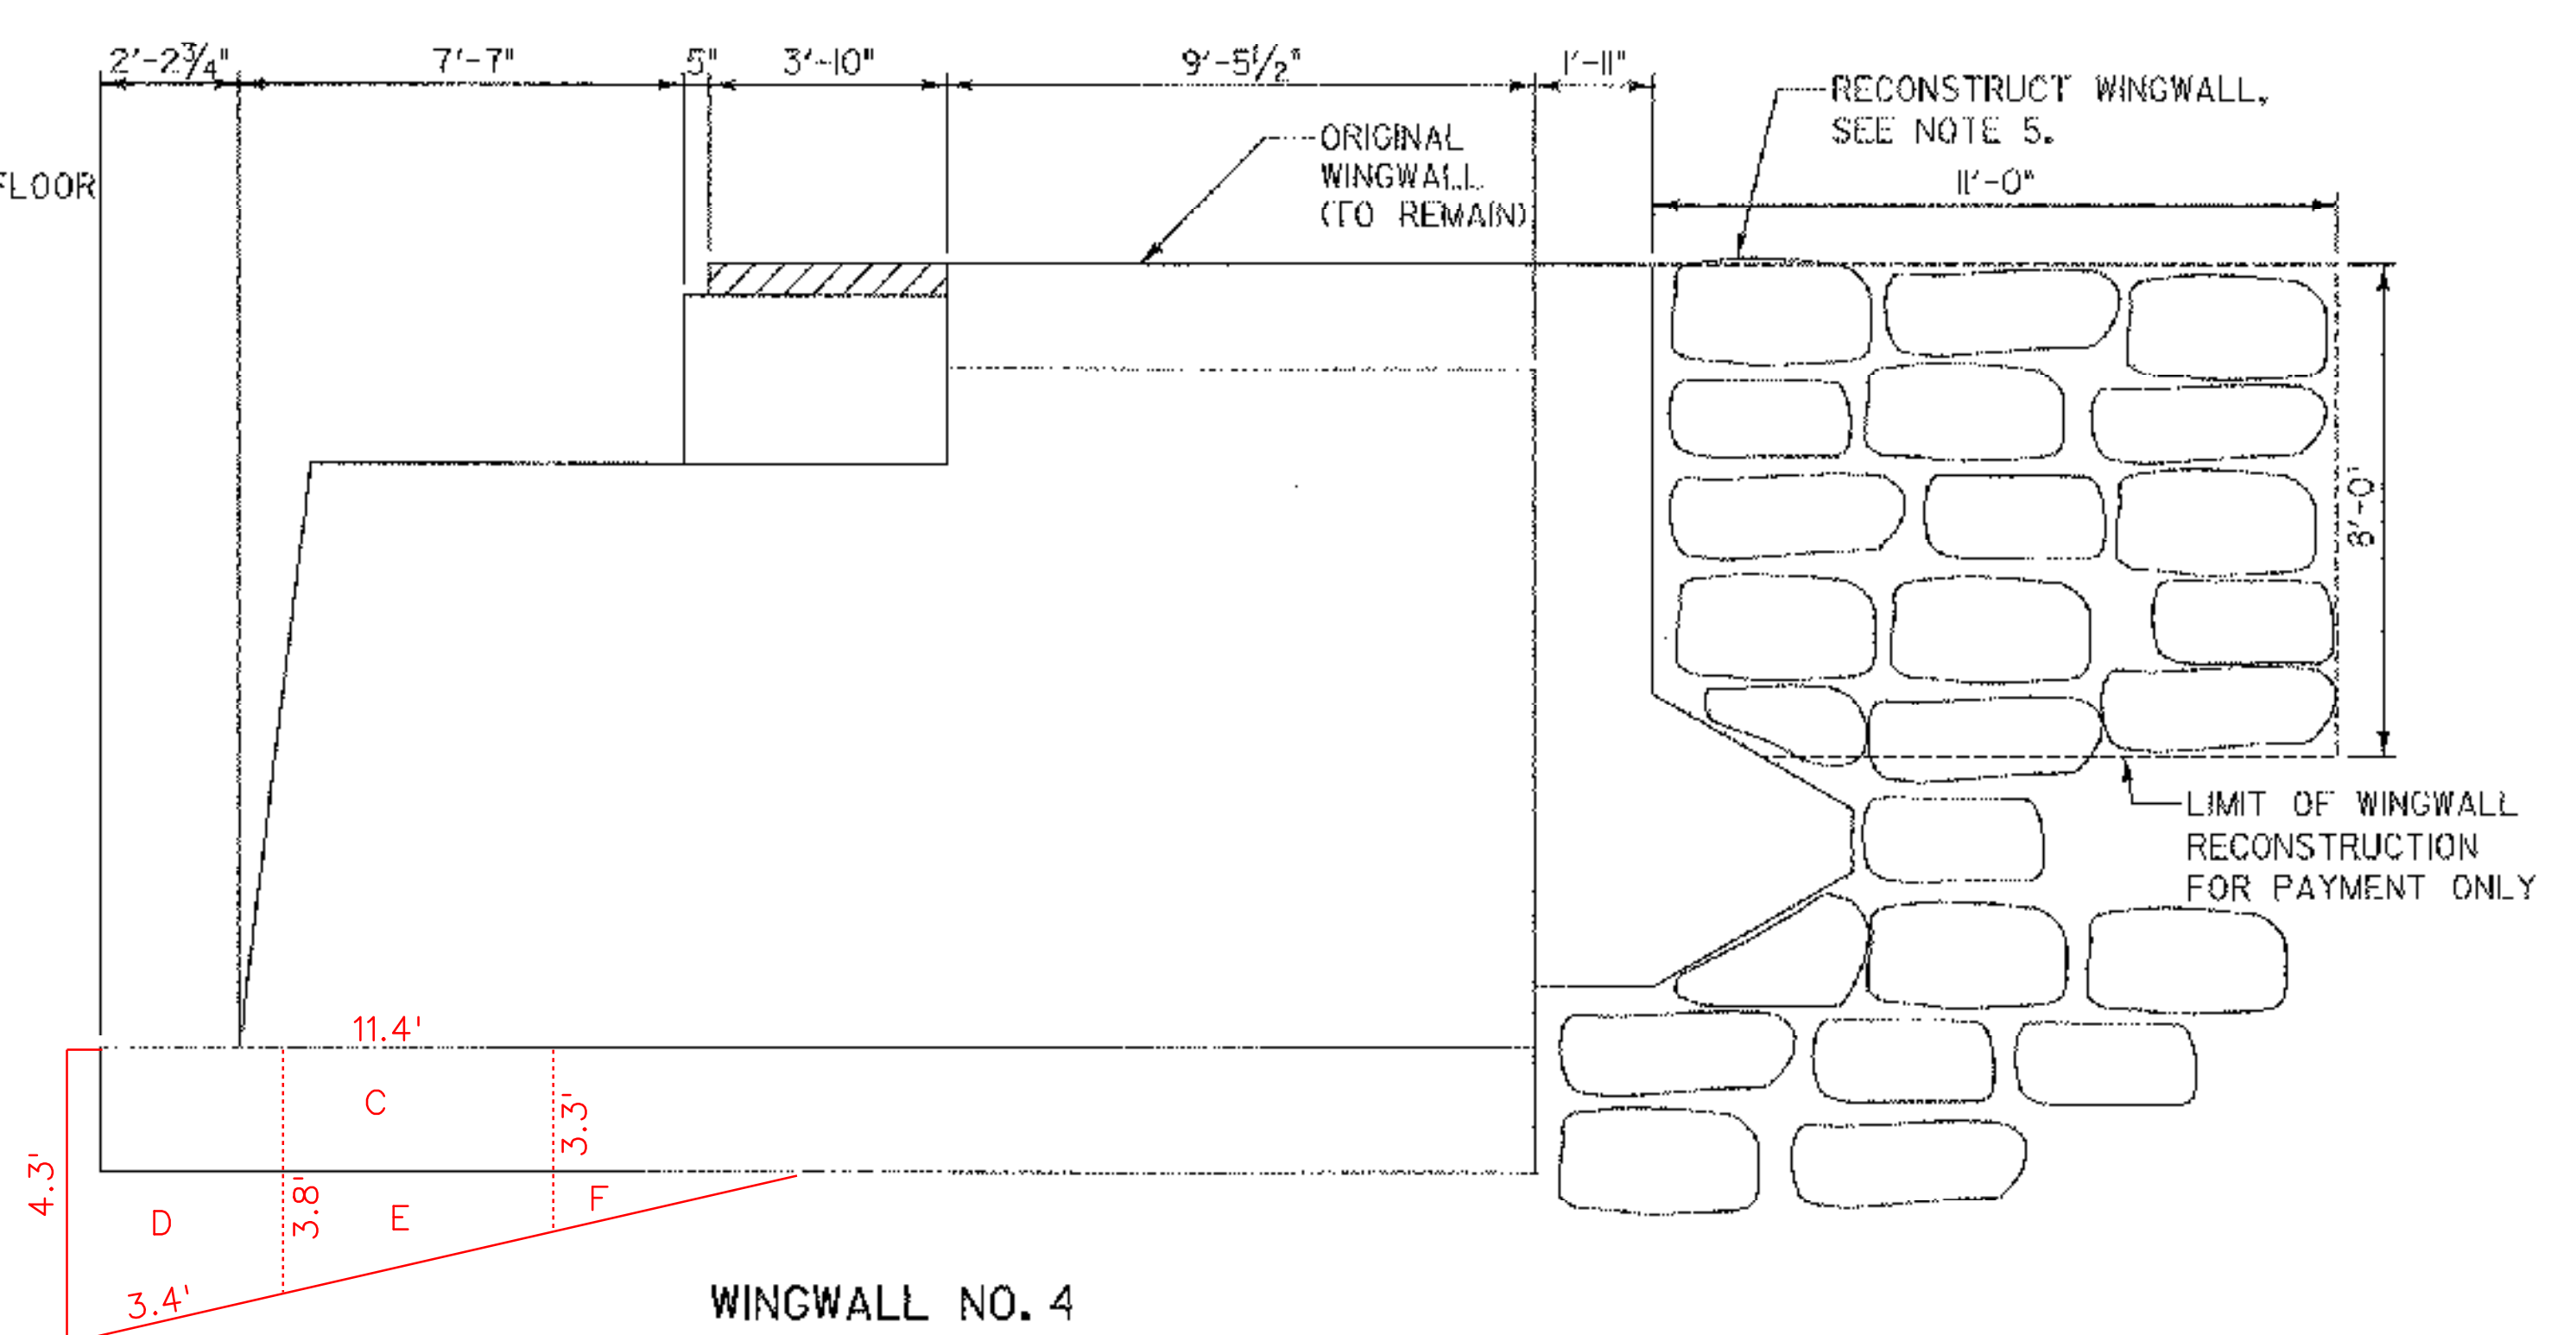

WINGWALL NO. 4

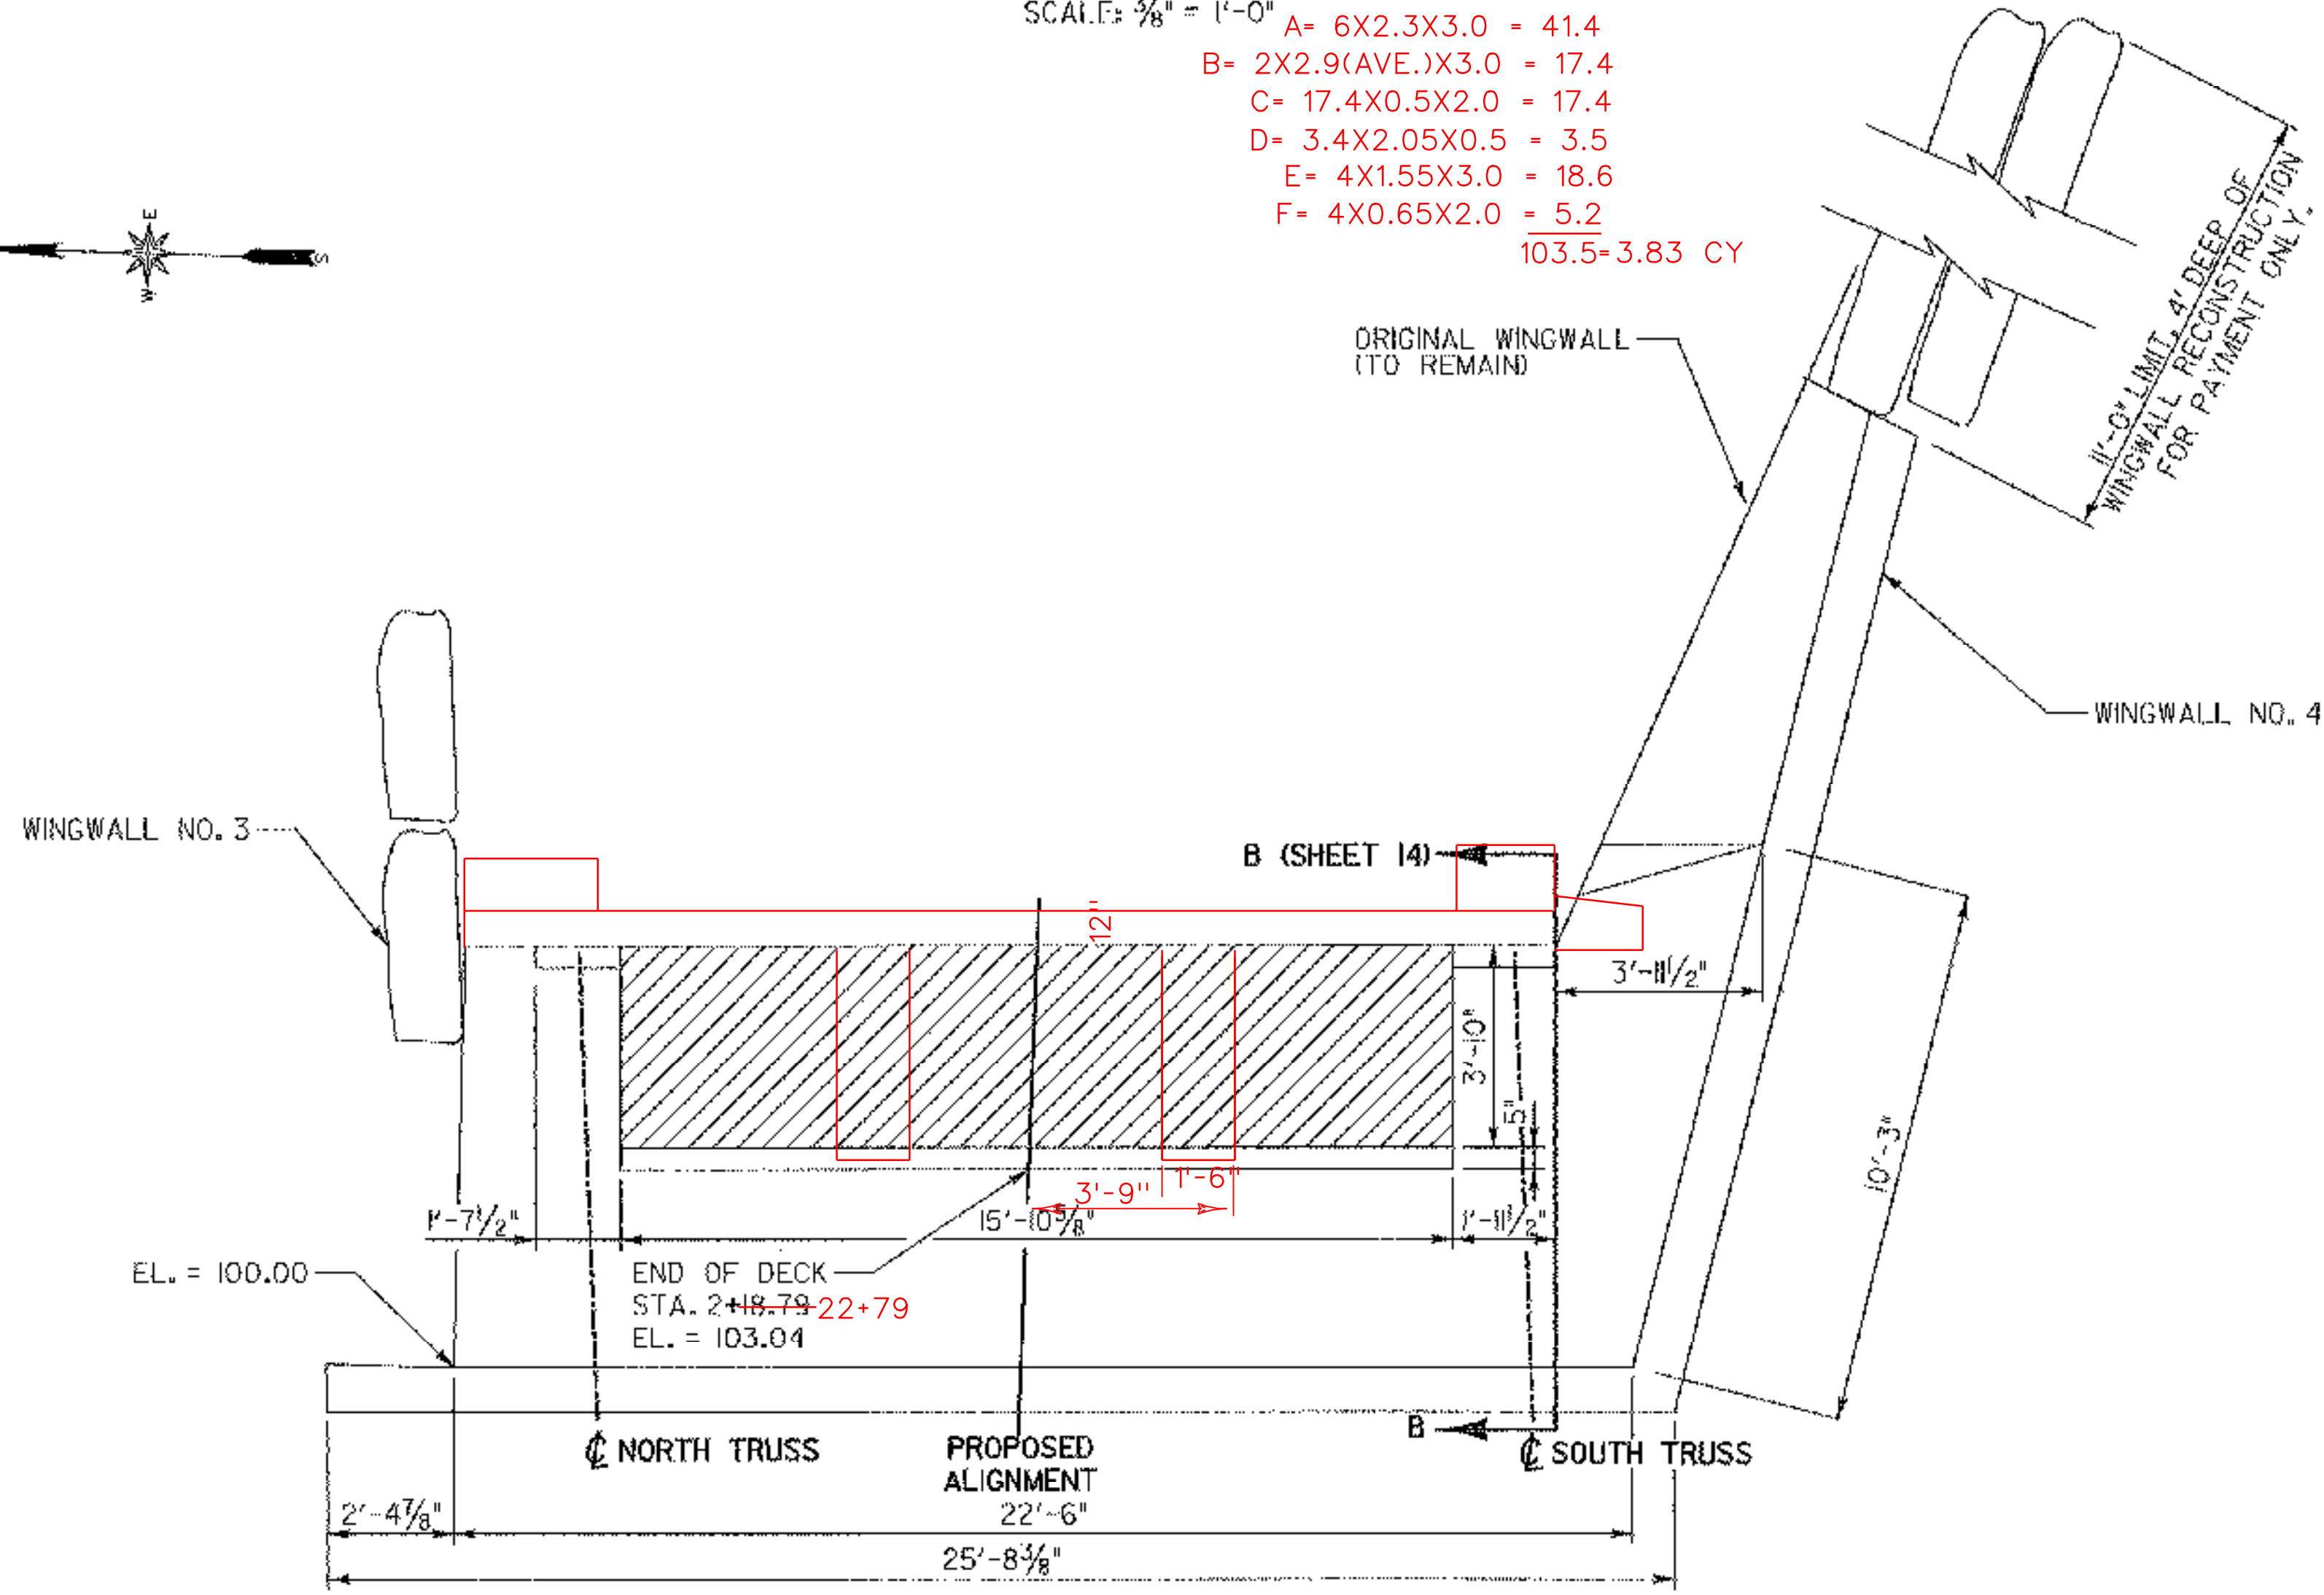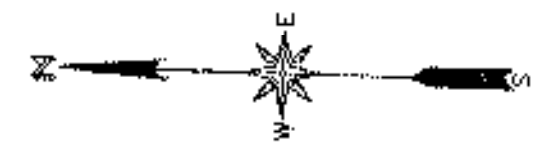

ABUTMENT NO. 2 PLAN

SCALE: 3/8" = 1'-0"

PLAN NOTES:

- SEE SHEETS 12 AND 14 FOR ABUTMENT DETAILS THAT APPLY TO THIS SHEET.
- ALL CONCRETE SHOWN WITH THE EXCEPTION OF THE LIMITS OF REPAIR IS EXISTING.
- APPLY APPROVED WATER REPELLANT TO ALL EXPOSED CONCRETE SURFACES.
- REMOVE ALL VEGETATION AND ACCUMULATED DIRT FROM ABUTMENT AND WINGWALLS (SUBSIDIARY TO ITEM 602.30).
- RECONSTRUCTION OF WINGWALL NO. 4 UNDER ITEM 602.20 (MOD.) SHALL INCLUDE RESETTING OF STONES AND THE ADDITION OF SIMILAR STONES AS REQUIRED TO RETURN THE WALL TO ITS ORIGINAL PLUMB AND TRUE CONDITION. THIS WORK SHALL ALSO INCLUDE ADDING ONE NEW LEVEL OF STONE ALONG THE TOP OF WINGWALL. NEW STONES TO MATCH EXISTING IN APPEARANCE AND SHALL NOT BE LESS THAN 2'x2'x4" IN SIZE. NEW STONES SHALL BE CHINKED FOR GOOD BEARING. REMOVAL OF FILL BEHIND THE WINGWALL WILL BE PAID FOR UNDER ITEM 204.20

LEGEND

/// PROPOSED CONCRETE REPAIR

**HTA**  
 consulting engineers  
 150 Dow Street - Manchester, NH 03103-4221  
 184 South Windward Ave. - Burlington, VT 05401  
 Tel: 603-688-8555 Fax: 603-688-4088  
 Tel: 802-688-1831 Fax: 802-688-6392  
 Web Page: www.hta-engineers.com E-Mail: hta@ht-engineers.com

<b>STATE OF VERMONT AGENCY OF TRANSPORTATION</b>	
Town Of <b>MONTGOMERY</b>	Bridge No. <b>41</b>
Highway No. <b>42</b>	Log Sta. <b>--</b>
<b>COMSTOCK COVERED BRIDGE</b>	
<b>ABUTMENT NO. 2 PLAN &amp; ELEVATION</b>	
Designed By <b>JW. ROCKWELL</b>	Drawn By <b>J.D. GEER</b>
Checked By <b>ST. JAMES</b>	Date <b>F-2003</b>
PROJECT <b>MONTGOMERY</b>	PROJECT NO. <b>BHO 1448(26)</b>
I.G.C. Info. <b>--</b>	<b>Z/304AB2</b>
Bridge Sheet No. <b>13</b>	Sheet <b>13</b> of <b>18</b>