


STATE OF VERMONT AGENCY OF TRANSPORTATION

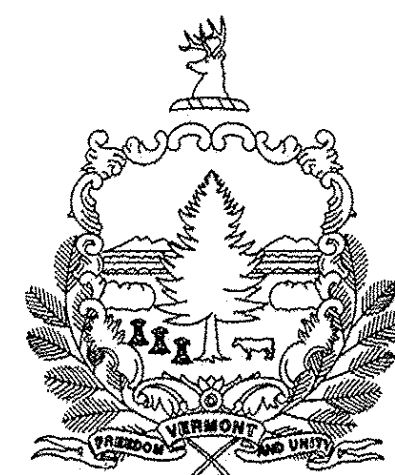


PROPOSED IMPROVEMENT BRIDGE PROJECT TOWN OF MONTGOMERY COUNTY OF FRANKLIN

ROUTE NO : TH 10 CLASS 3 BRIDGE NO : 36

PROJECT LOCATION : LOCATED APPROXIMATELY 0.30 MILES FROM THE INTERSECTION OF TH 10 AND TH 6.

PROJECT DESCRIPTION : REPLACEMENT OF THE EXISTING SUPERSTRUCTURE WITH MINIMAL APPROACH, SUBSTRUCTURE, ROADWAY AND CHANNEL WORK.

LENGTH OF STRUCTURE : 51.00 FEET
 LENGTH OF ROADWAY : 49.00 FEET
 LENGTH OF PROJECT : 100.00 FEET

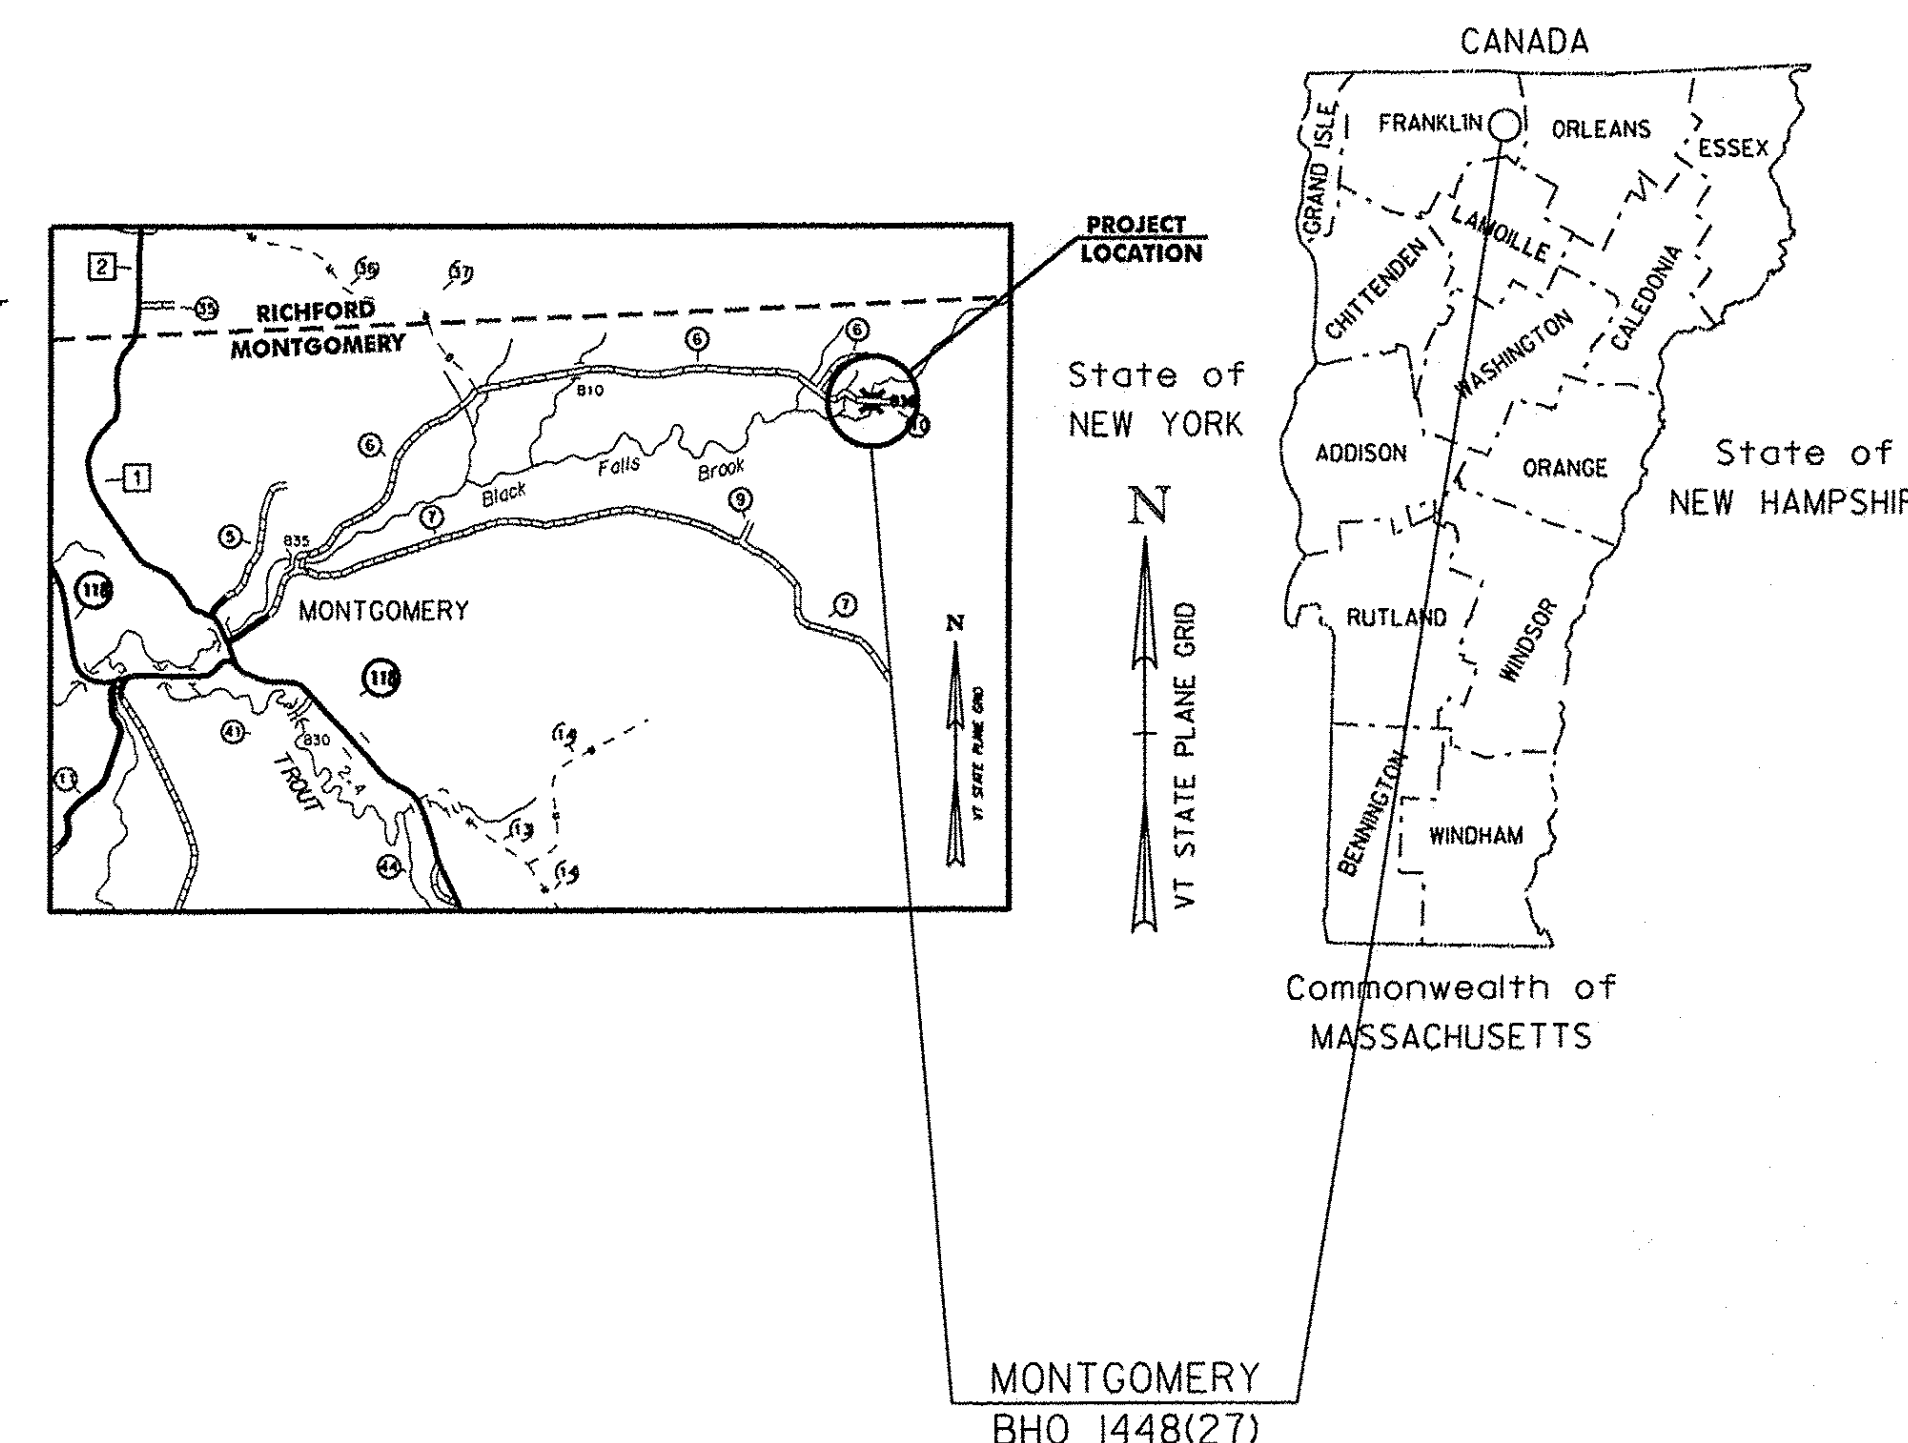


RECORD PLANS	
CONTRACTOR:	A.L. ST. ONGE CONTRACTOR, INC. - MONTGOMERY, VT
RESIDENT ENGINEER:	JEFF COTA
CONSTRUCTION BEGAN:	JULY 14, 2014
CONSTRUCTION COMPLETE:	AUGUST 25, 2014
RECORD PLANS BY:	JEFF COTA & CRAIG PIERCE
I HEREBY CERTIFY THAT ALL THE CONSTRUCTION REQUIRED BY THIS SET OF DRAWINGS HAS BEEN ACCOMPLISHED AS INDICATED HEREIN.	
BY	RESIDENT ENGINEER
DATE	7/6/16
NOTE: Any further information concerning final quantities, amounts or other details relative to this project may be found at Central Files in the electronic archives.	

QUALITY ASSURANCE PROGRAM: LEVEL 2

CONVENTIONAL SYMBOLS	
COUNTY LINE	
TOWN LINE	
LIMITS OF ACCESS	
POINT OF ACCESS	
FENCE LINE	
STONE WALL	
TRAVELED WAY	
GUARD RAIL	
RAILROAD	
SURVEY LINE	
CULVERT	
POWER POLE	
TELEPHONE POLE	
TREES	
CONTROL OF ACCESS	
PROPERTY LINE	
R.O.W. TAKING LINE	
SLOPE RIGHTS	
TOP OF CUT	
TOE OF SLOPE	

SURVEYED BY : R. D. GILMAN
 SURVEYED DATE : 10-20-1998

DATUM
 VERTICAL : NAVD 88
 HORIZONTAL : NAVD 83 (96)

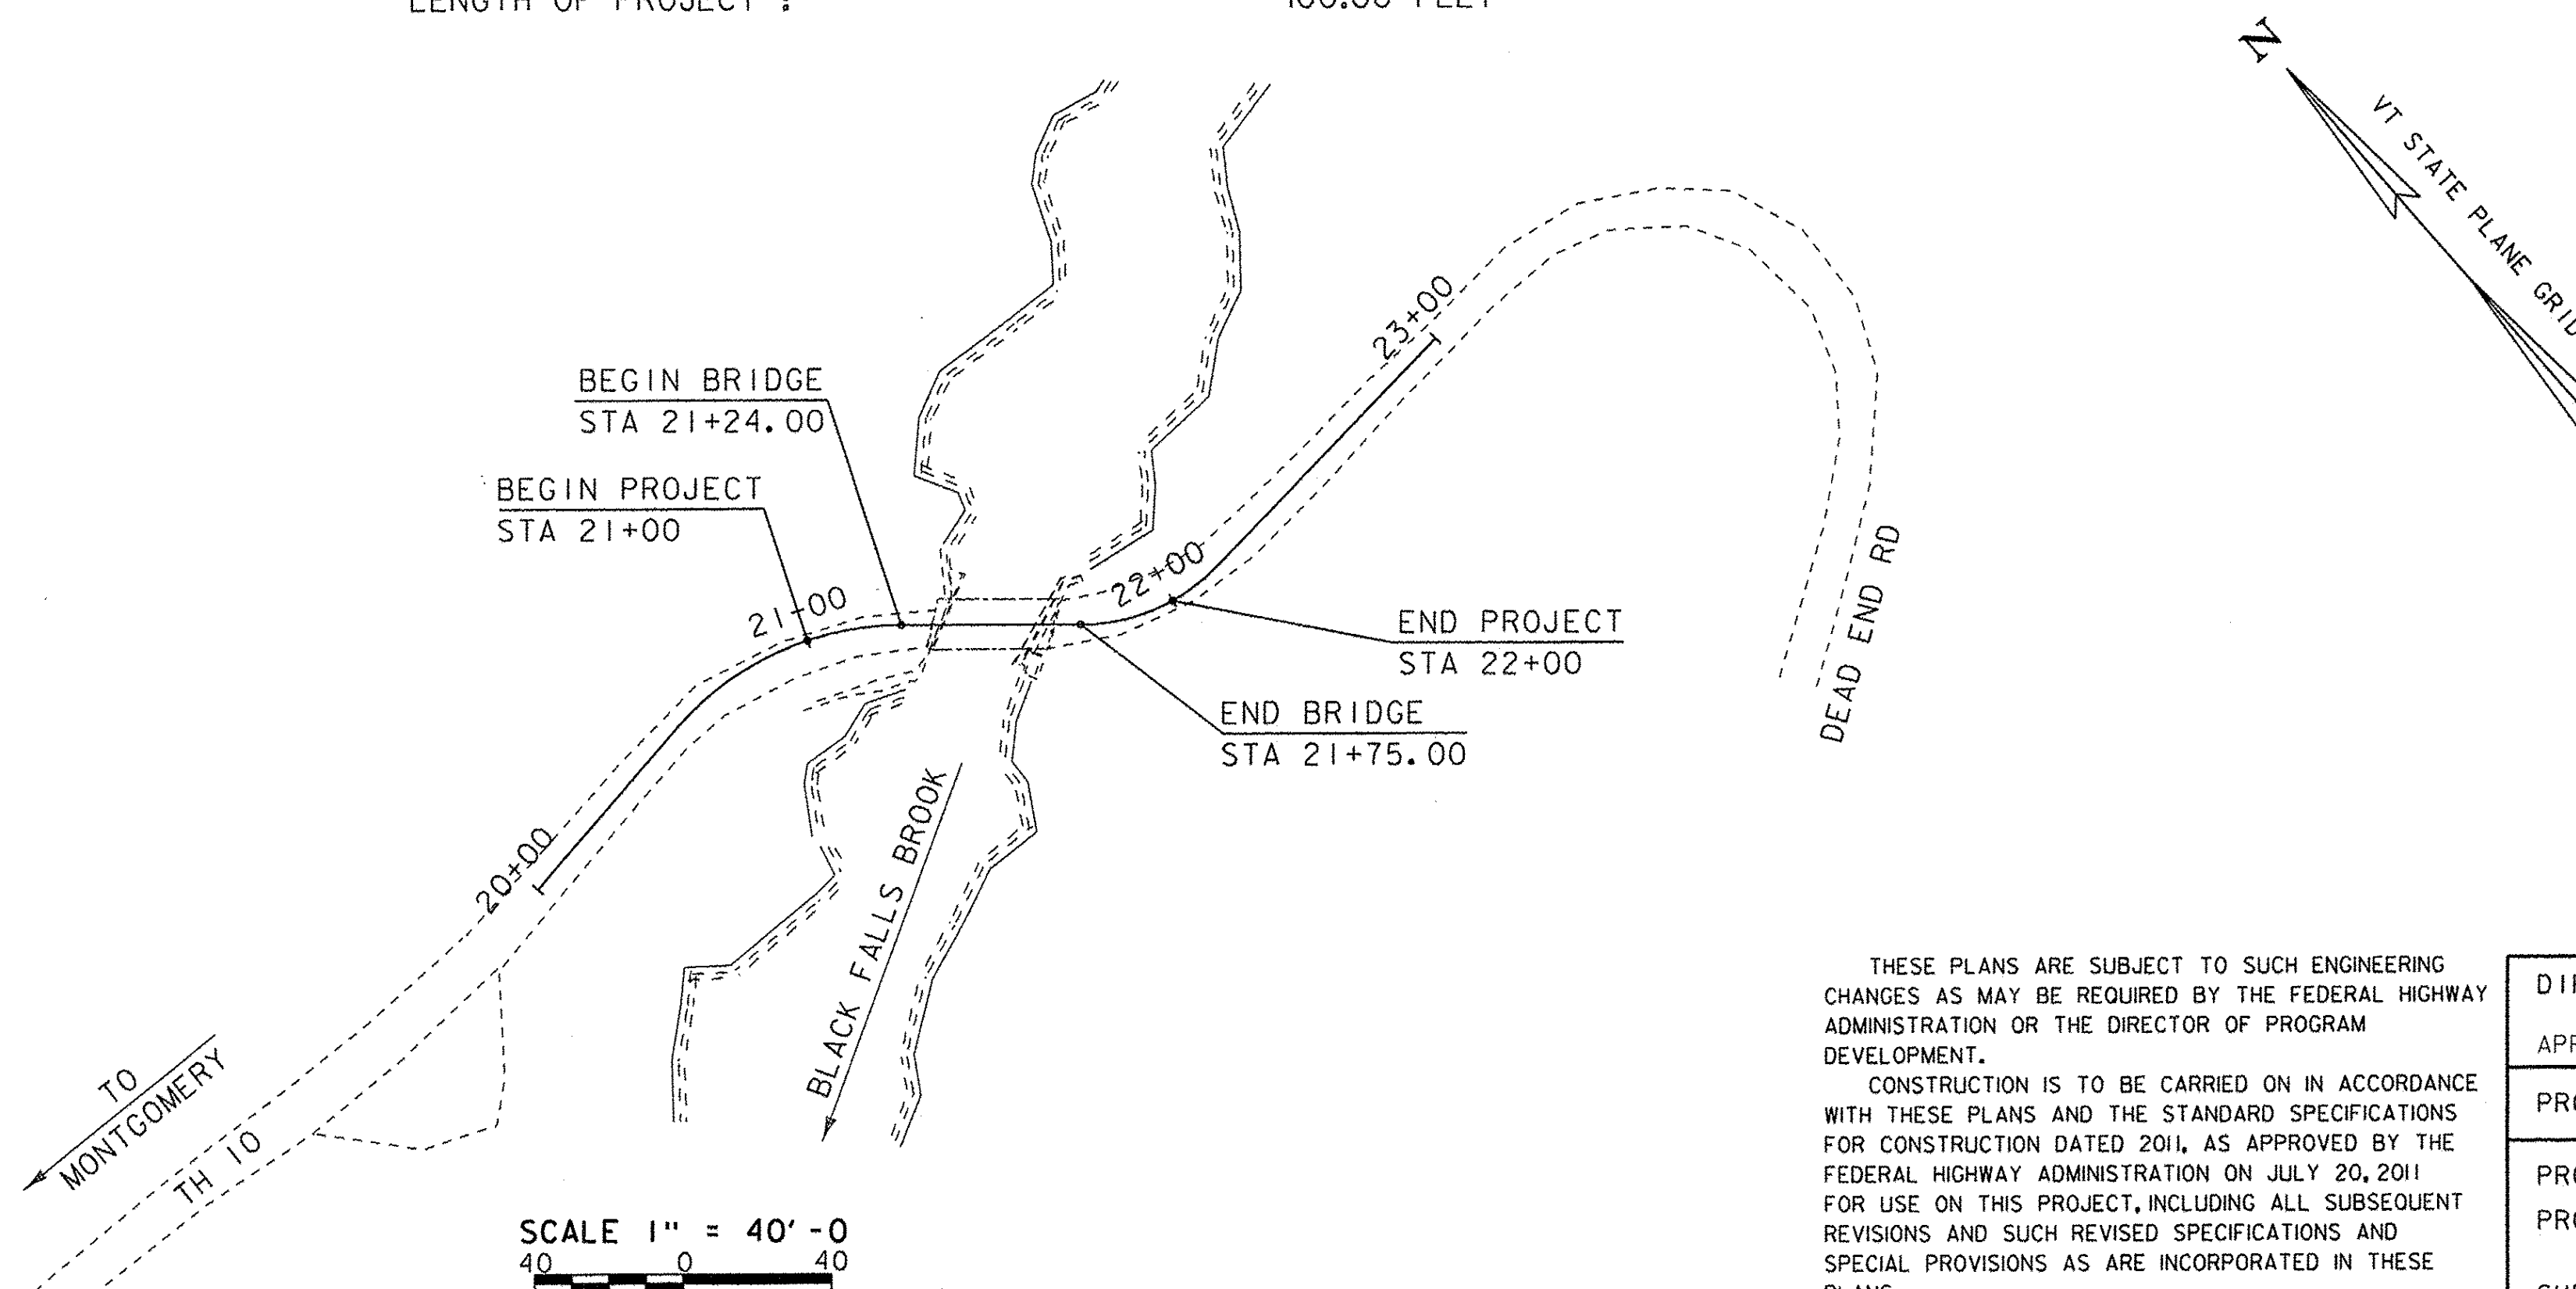

THESE PLANS ARE SUBJECT TO SUCH ENGINEERING CHANGES AS MAY BE REQUIRED BY THE FEDERAL HIGHWAY ADMINISTRATION OR THE DIRECTOR OF PROGRAM DEVELOPMENT.

CONSTRUCTION IS TO BE CARRIED ON IN ACCORDANCE WITH THESE PLANS AND THE STANDARD SPECIFICATIONS FOR CONSTRUCTION DATED 2011, AS APPROVED BY THE FEDERAL HIGHWAY ADMINISTRATION ON JULY 20, 2011 FOR USE ON THIS PROJECT, INCLUDING ALL SUBSEQUENT REVISIONS AND SUCH REVISED SPECIFICATIONS AND SPECIAL PROVISIONS AS ARE INCORPORATED IN THESE PLANS.

DIRECTOR OF PROGRAM DEVELOPMENT
 APPROVED DATE 11/21/13

PROJECT MANAGER : CAROLYN CARLSON, P.E.

PROJECT NAME : MONTGOMERY
 PROJECT NUMBER : BHO 1448 (27)

SHEET 1 OF 30 SHEETS