




20+50

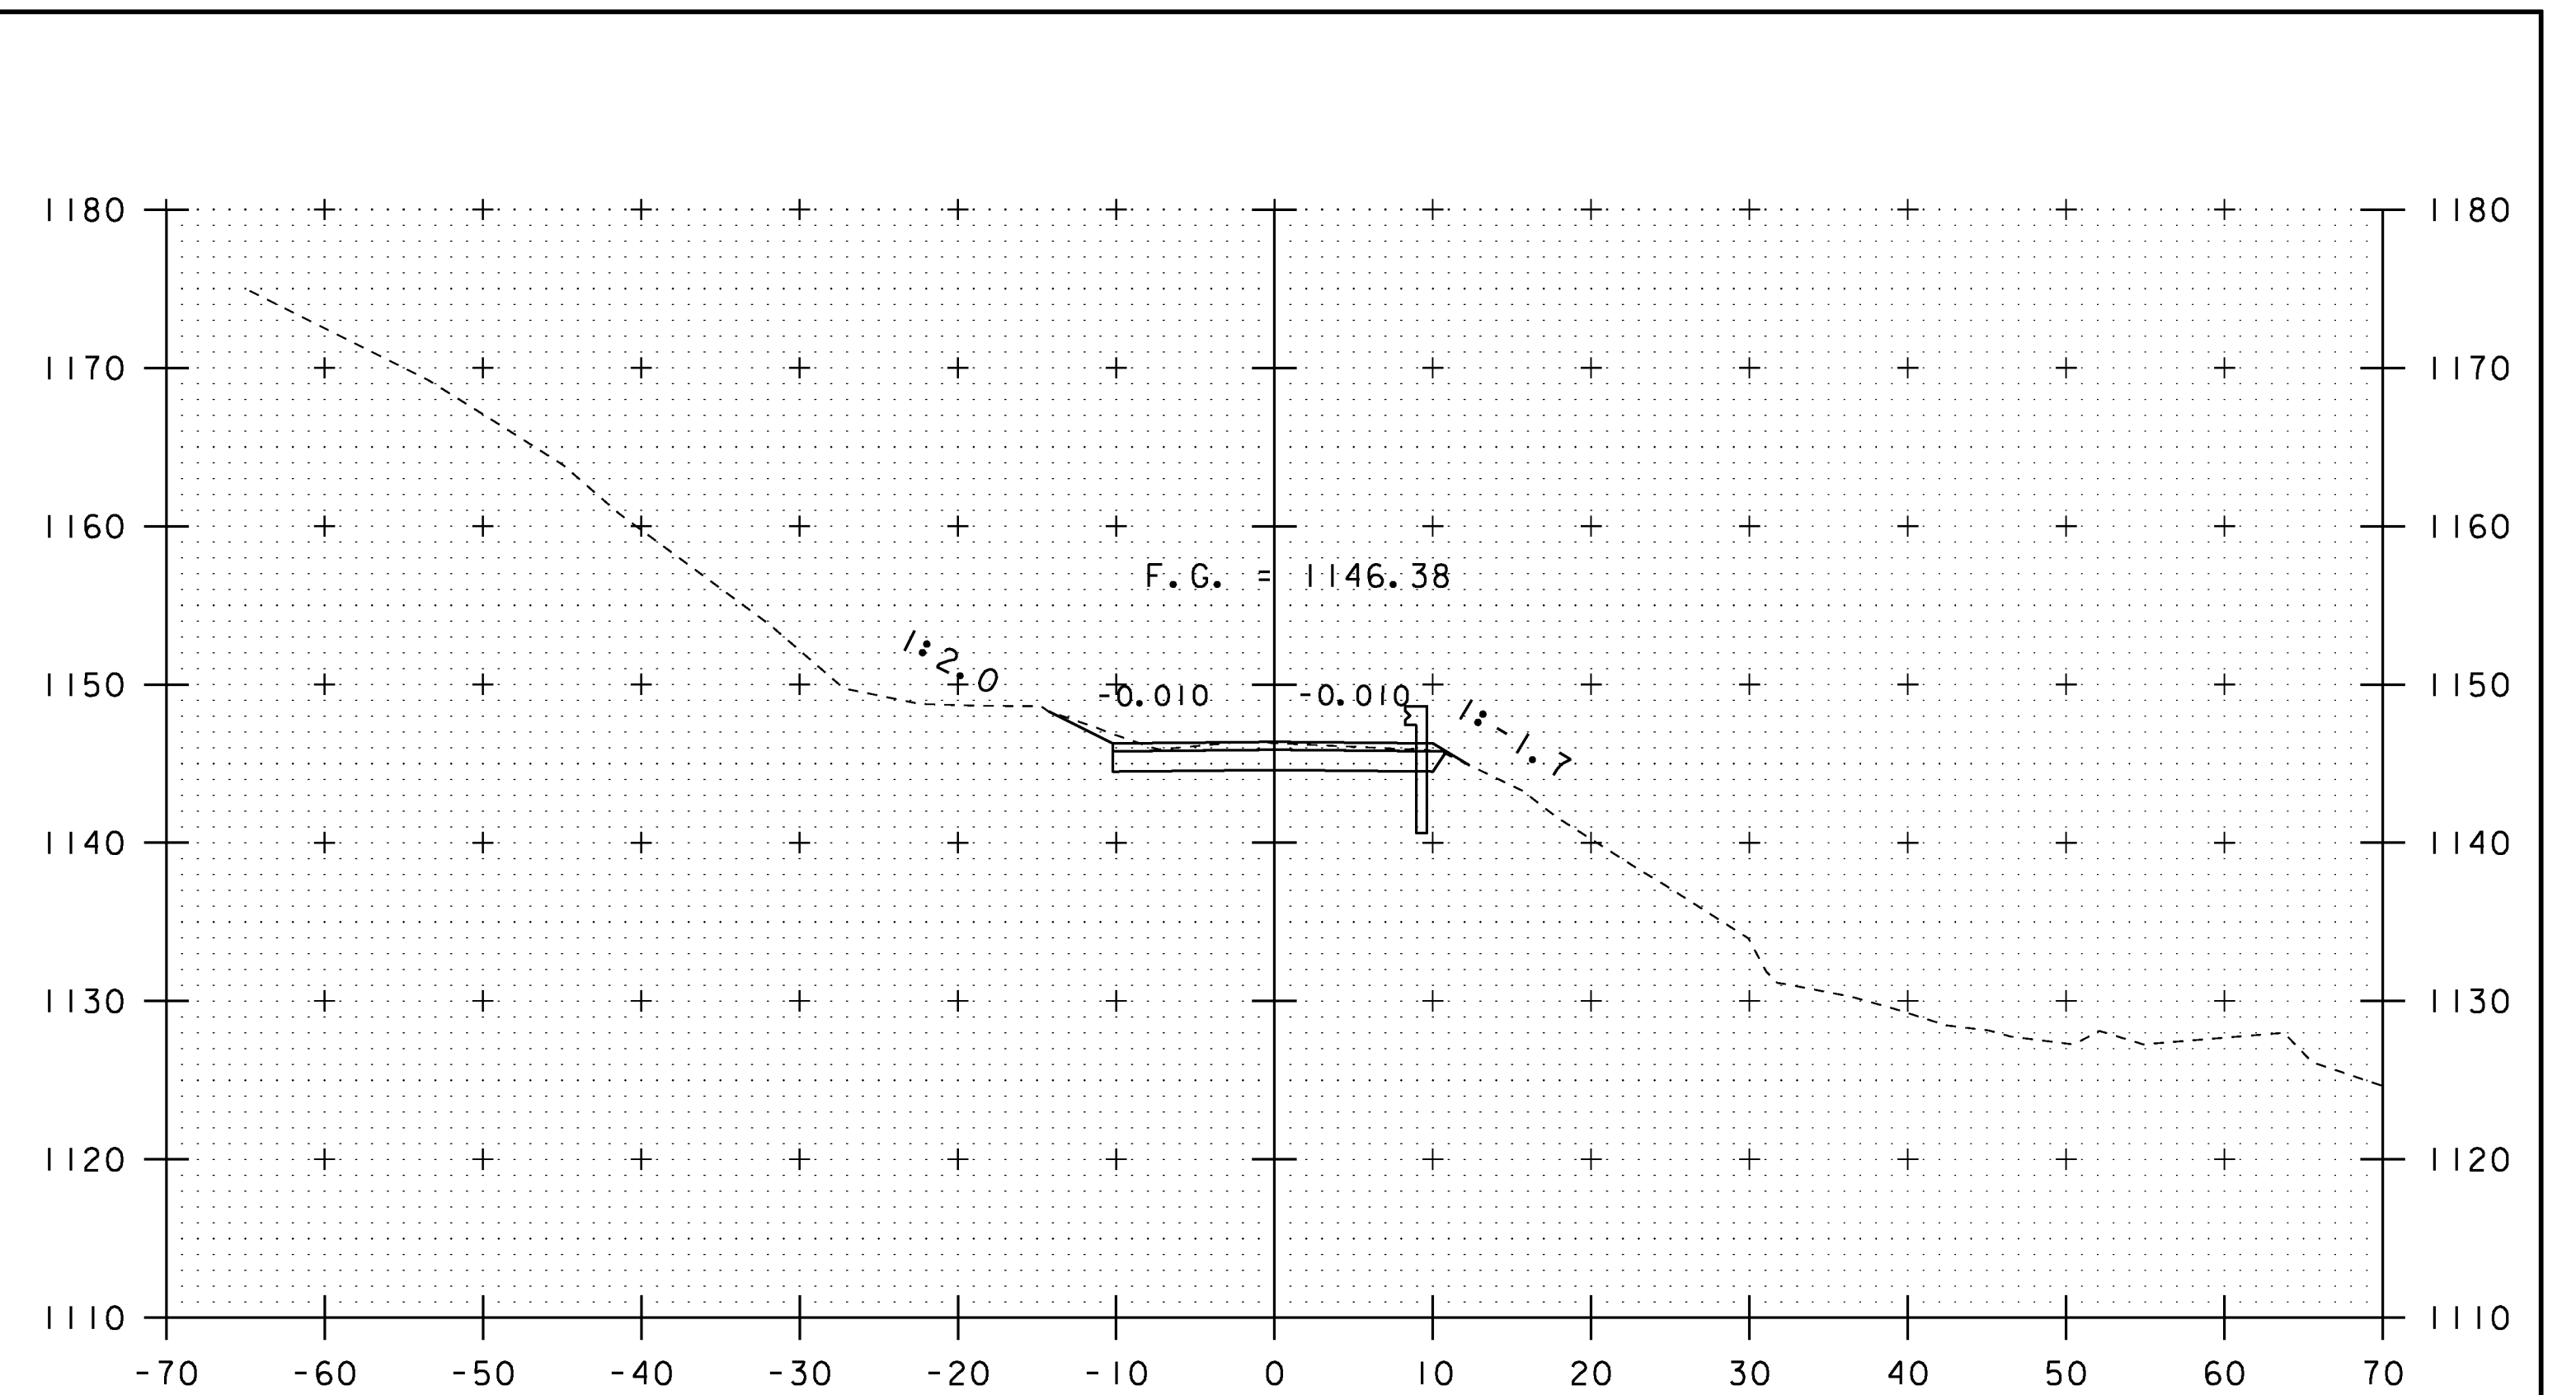

20+88

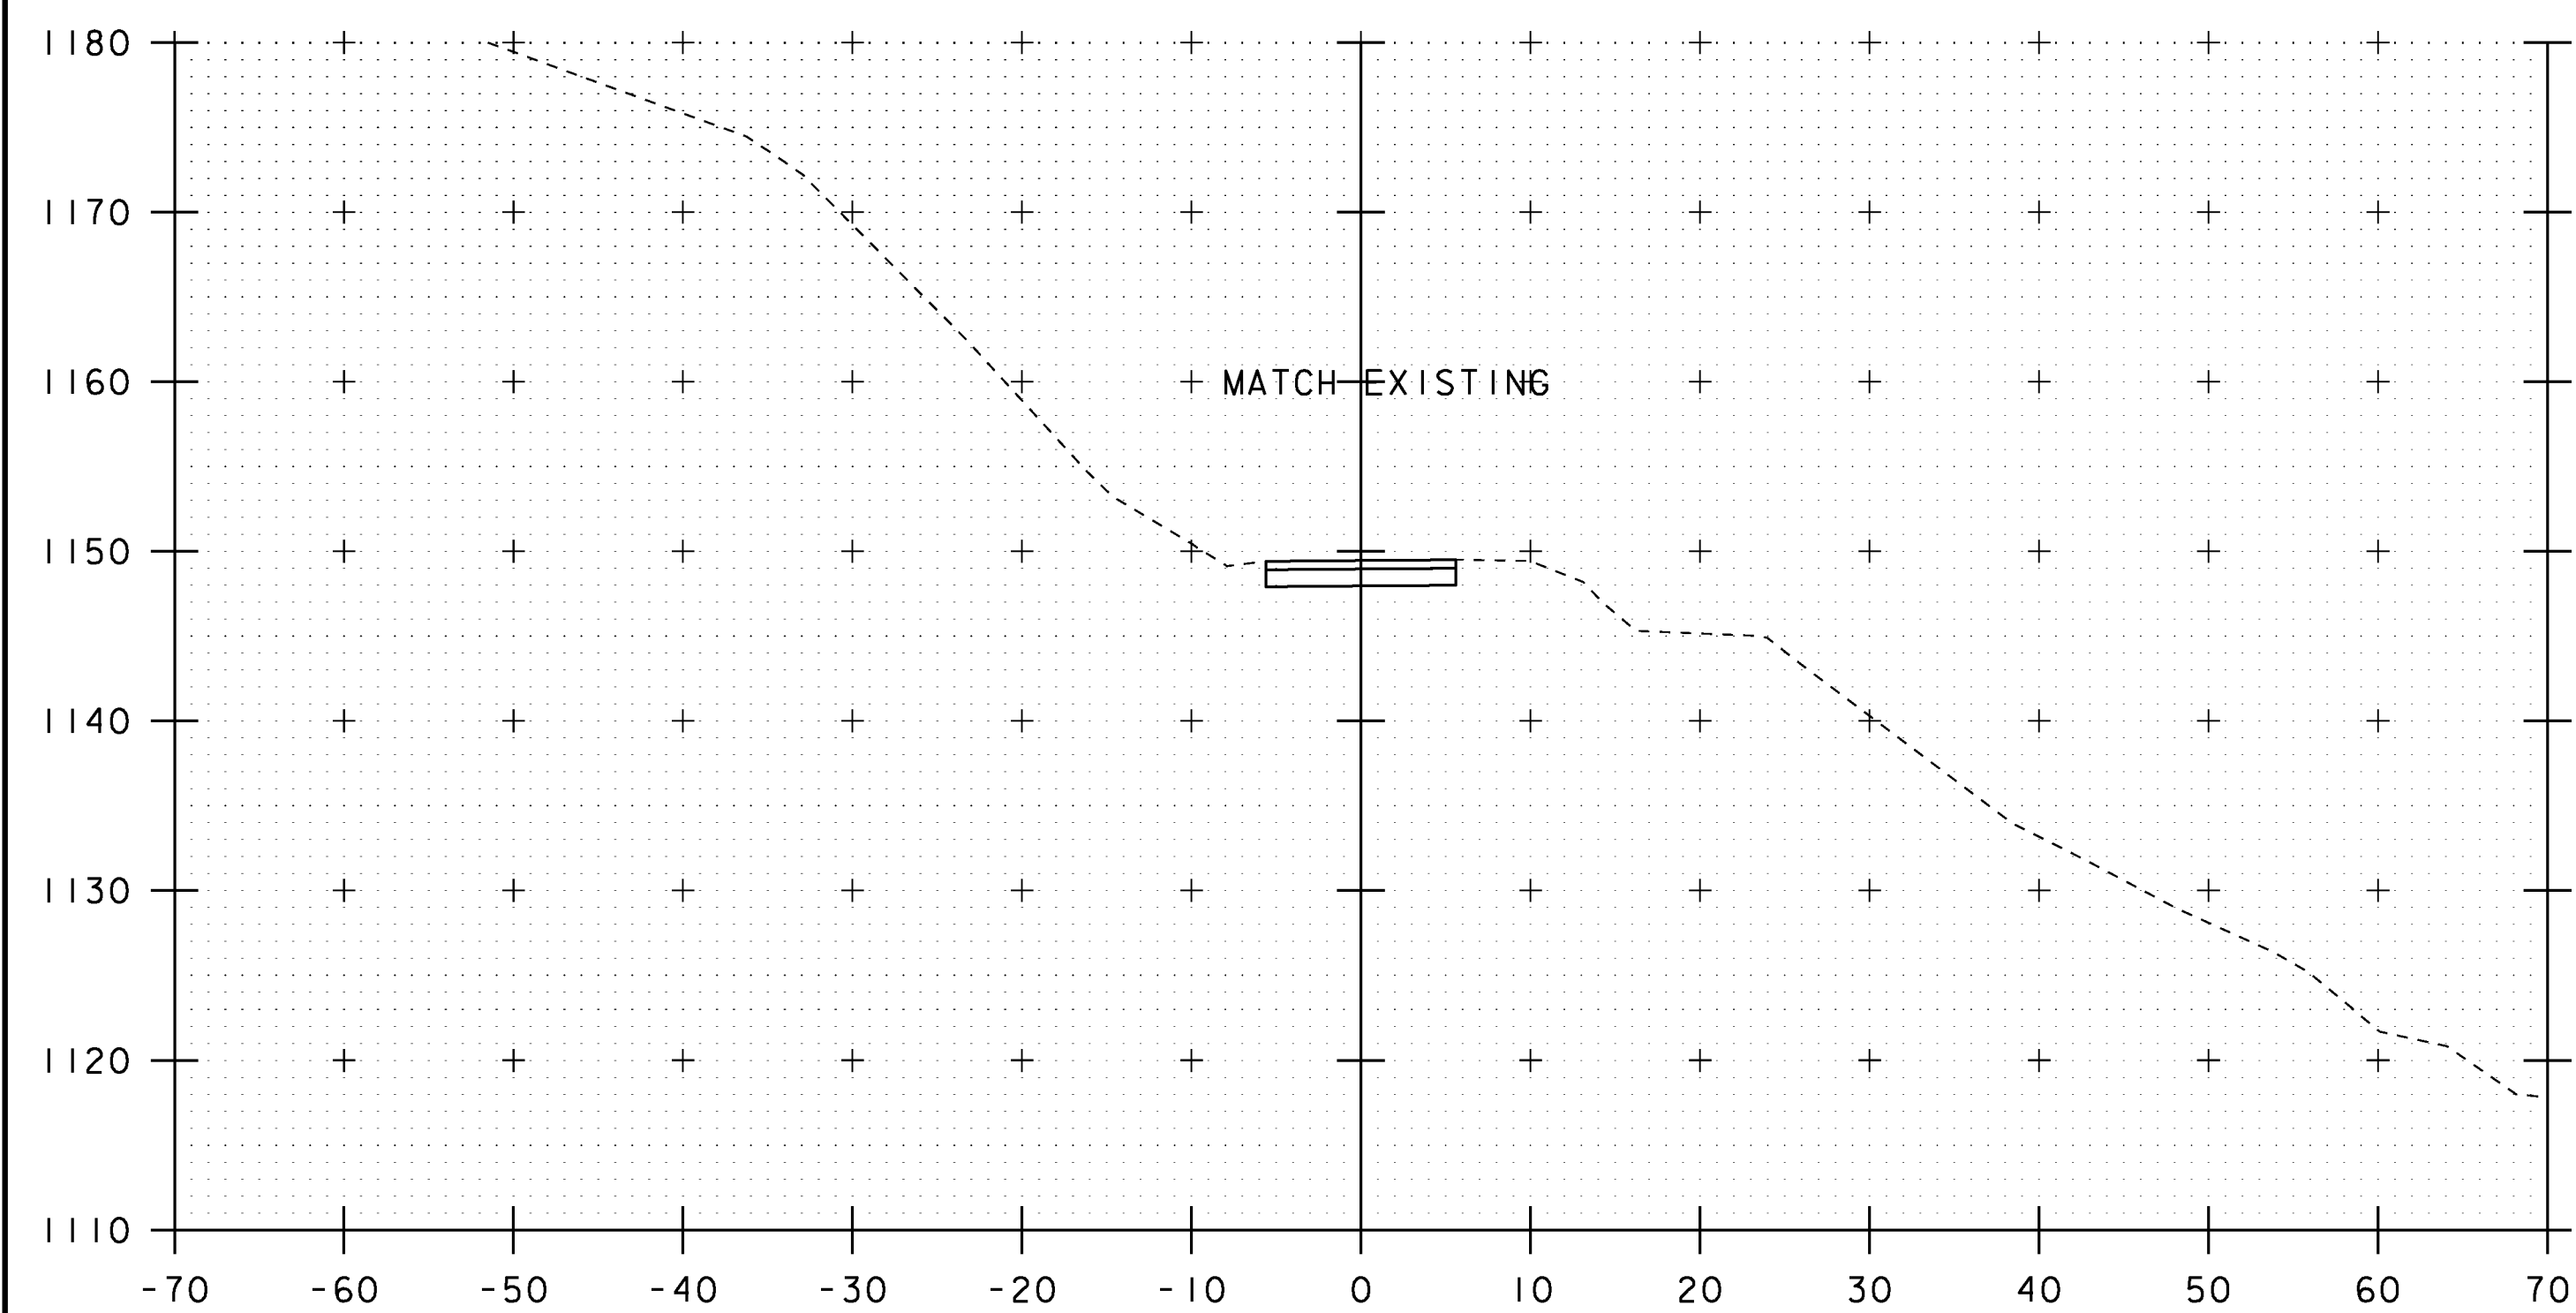

20+25 BEGIN APPROACH

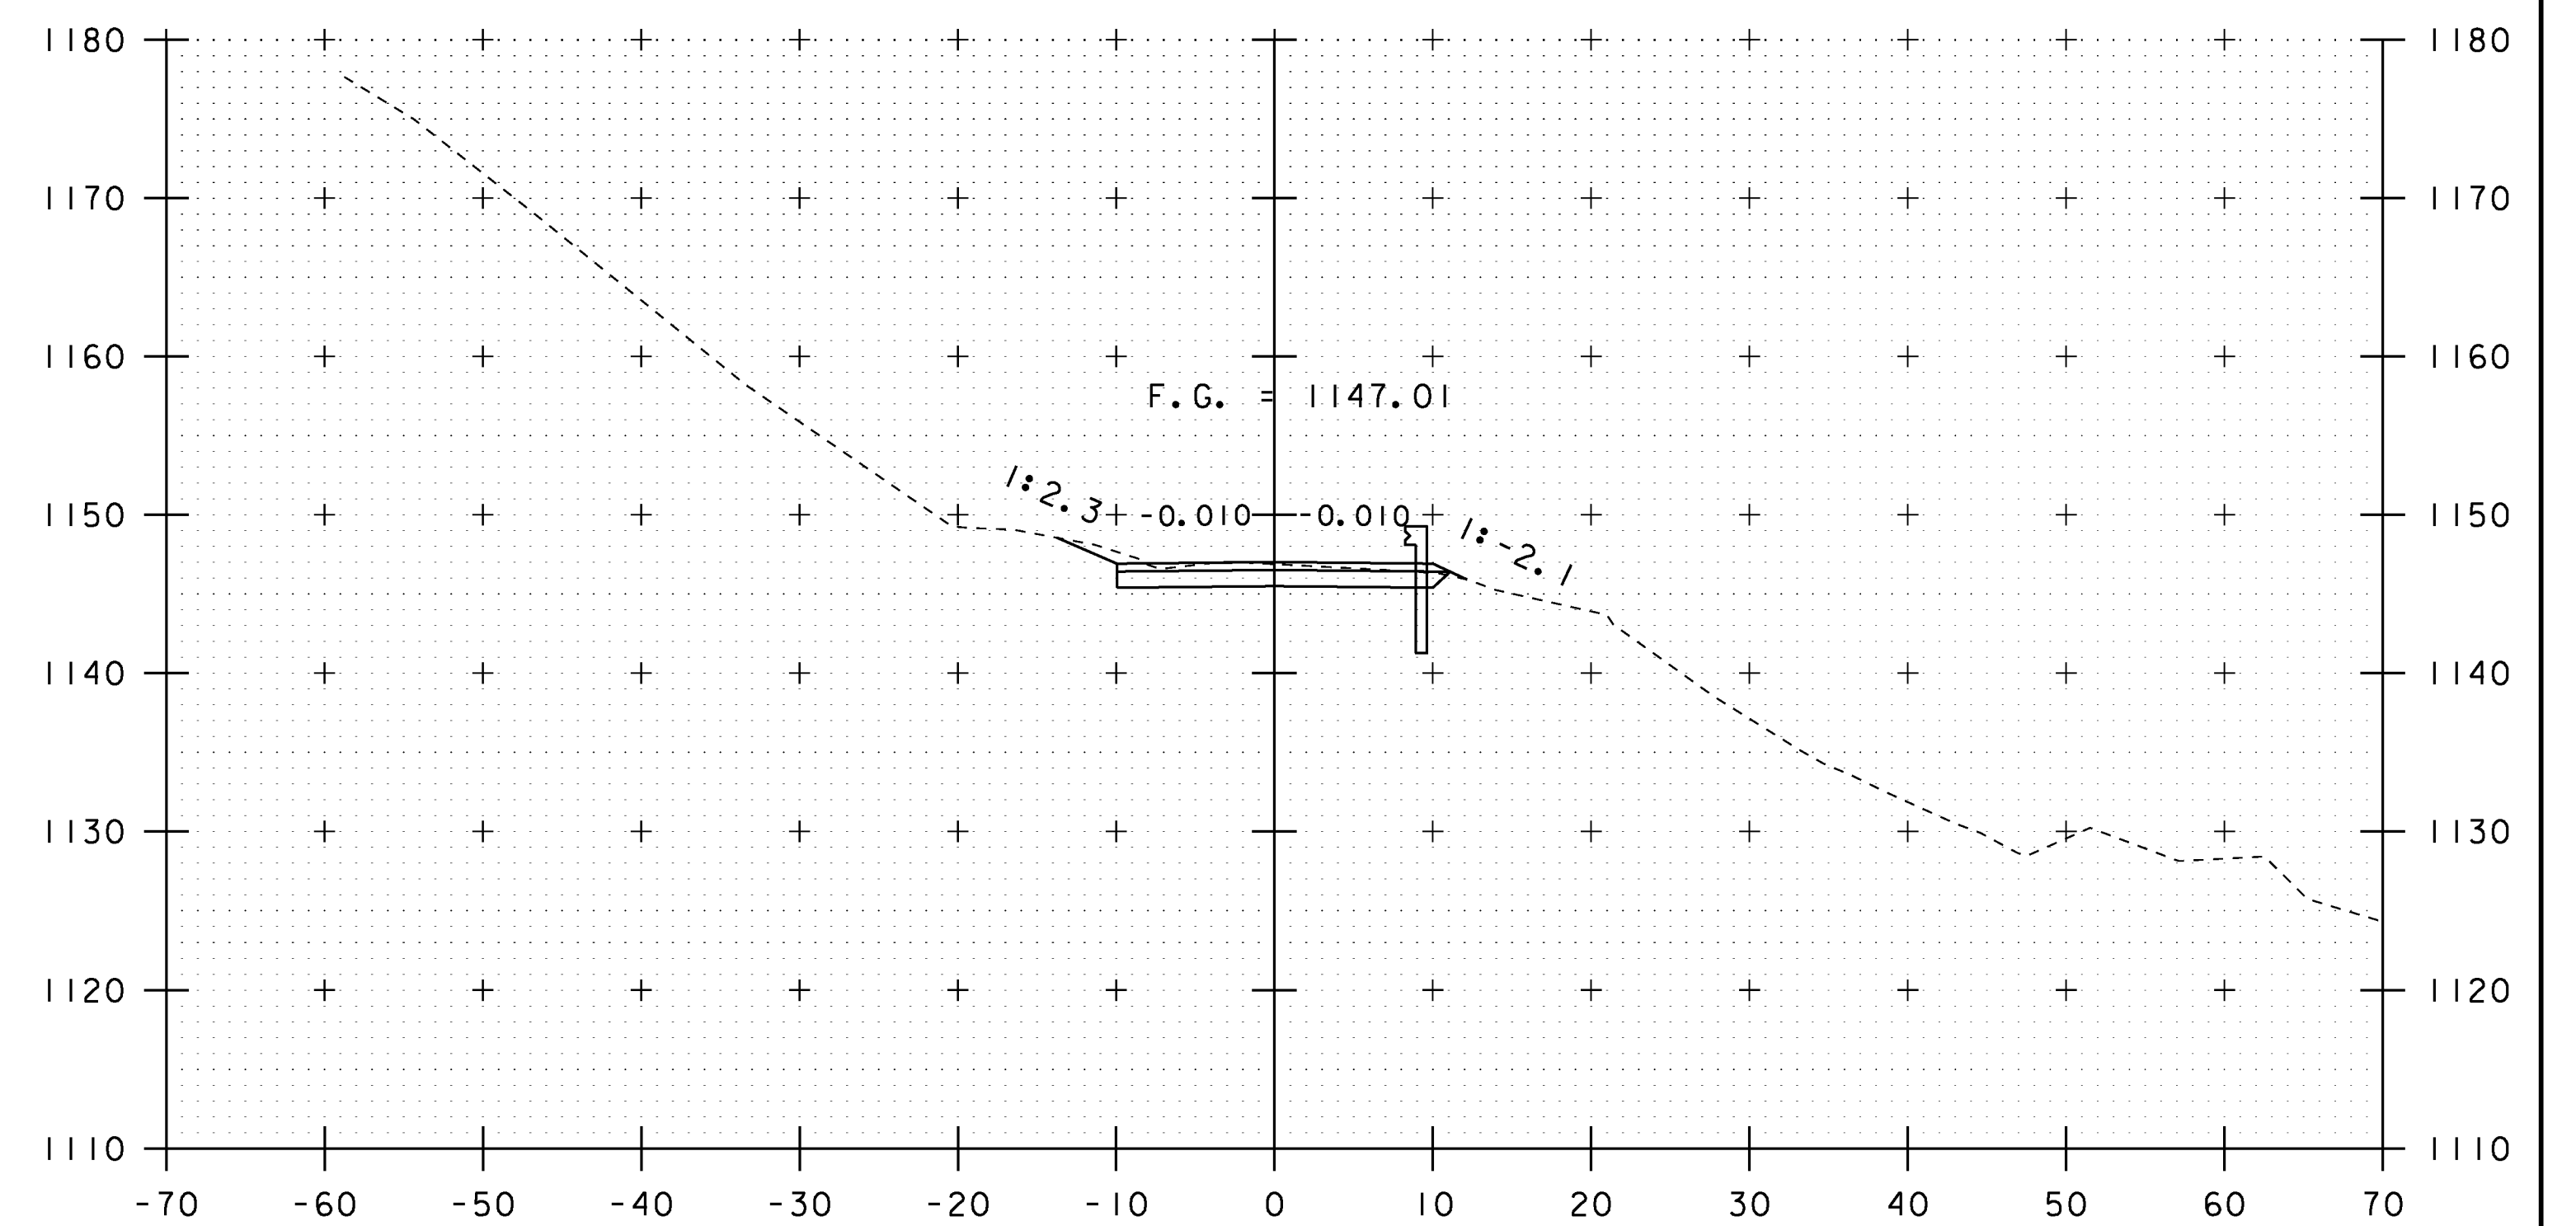

20+75

STA. 20+25 TO STA. 20+88

PROJECT NAME: MONTGOMERY	
PROJECT NUMBER: BHO 1448(27)	
FILE NAME: s96j306xs2.dgn	PLOT DATE: 21-NOV-2013
PROJECT LEADER: C. CARLSON	DRAWN BY: R. PELLETT
DESIGNED BY: H. SALLS	CHECKED BY: J. LACROIX
MAINLINE CROSS SECTIONS I	SHEET 19 OF 30