




21+25 (BEGIN BRIDGE STA 21+24.00)

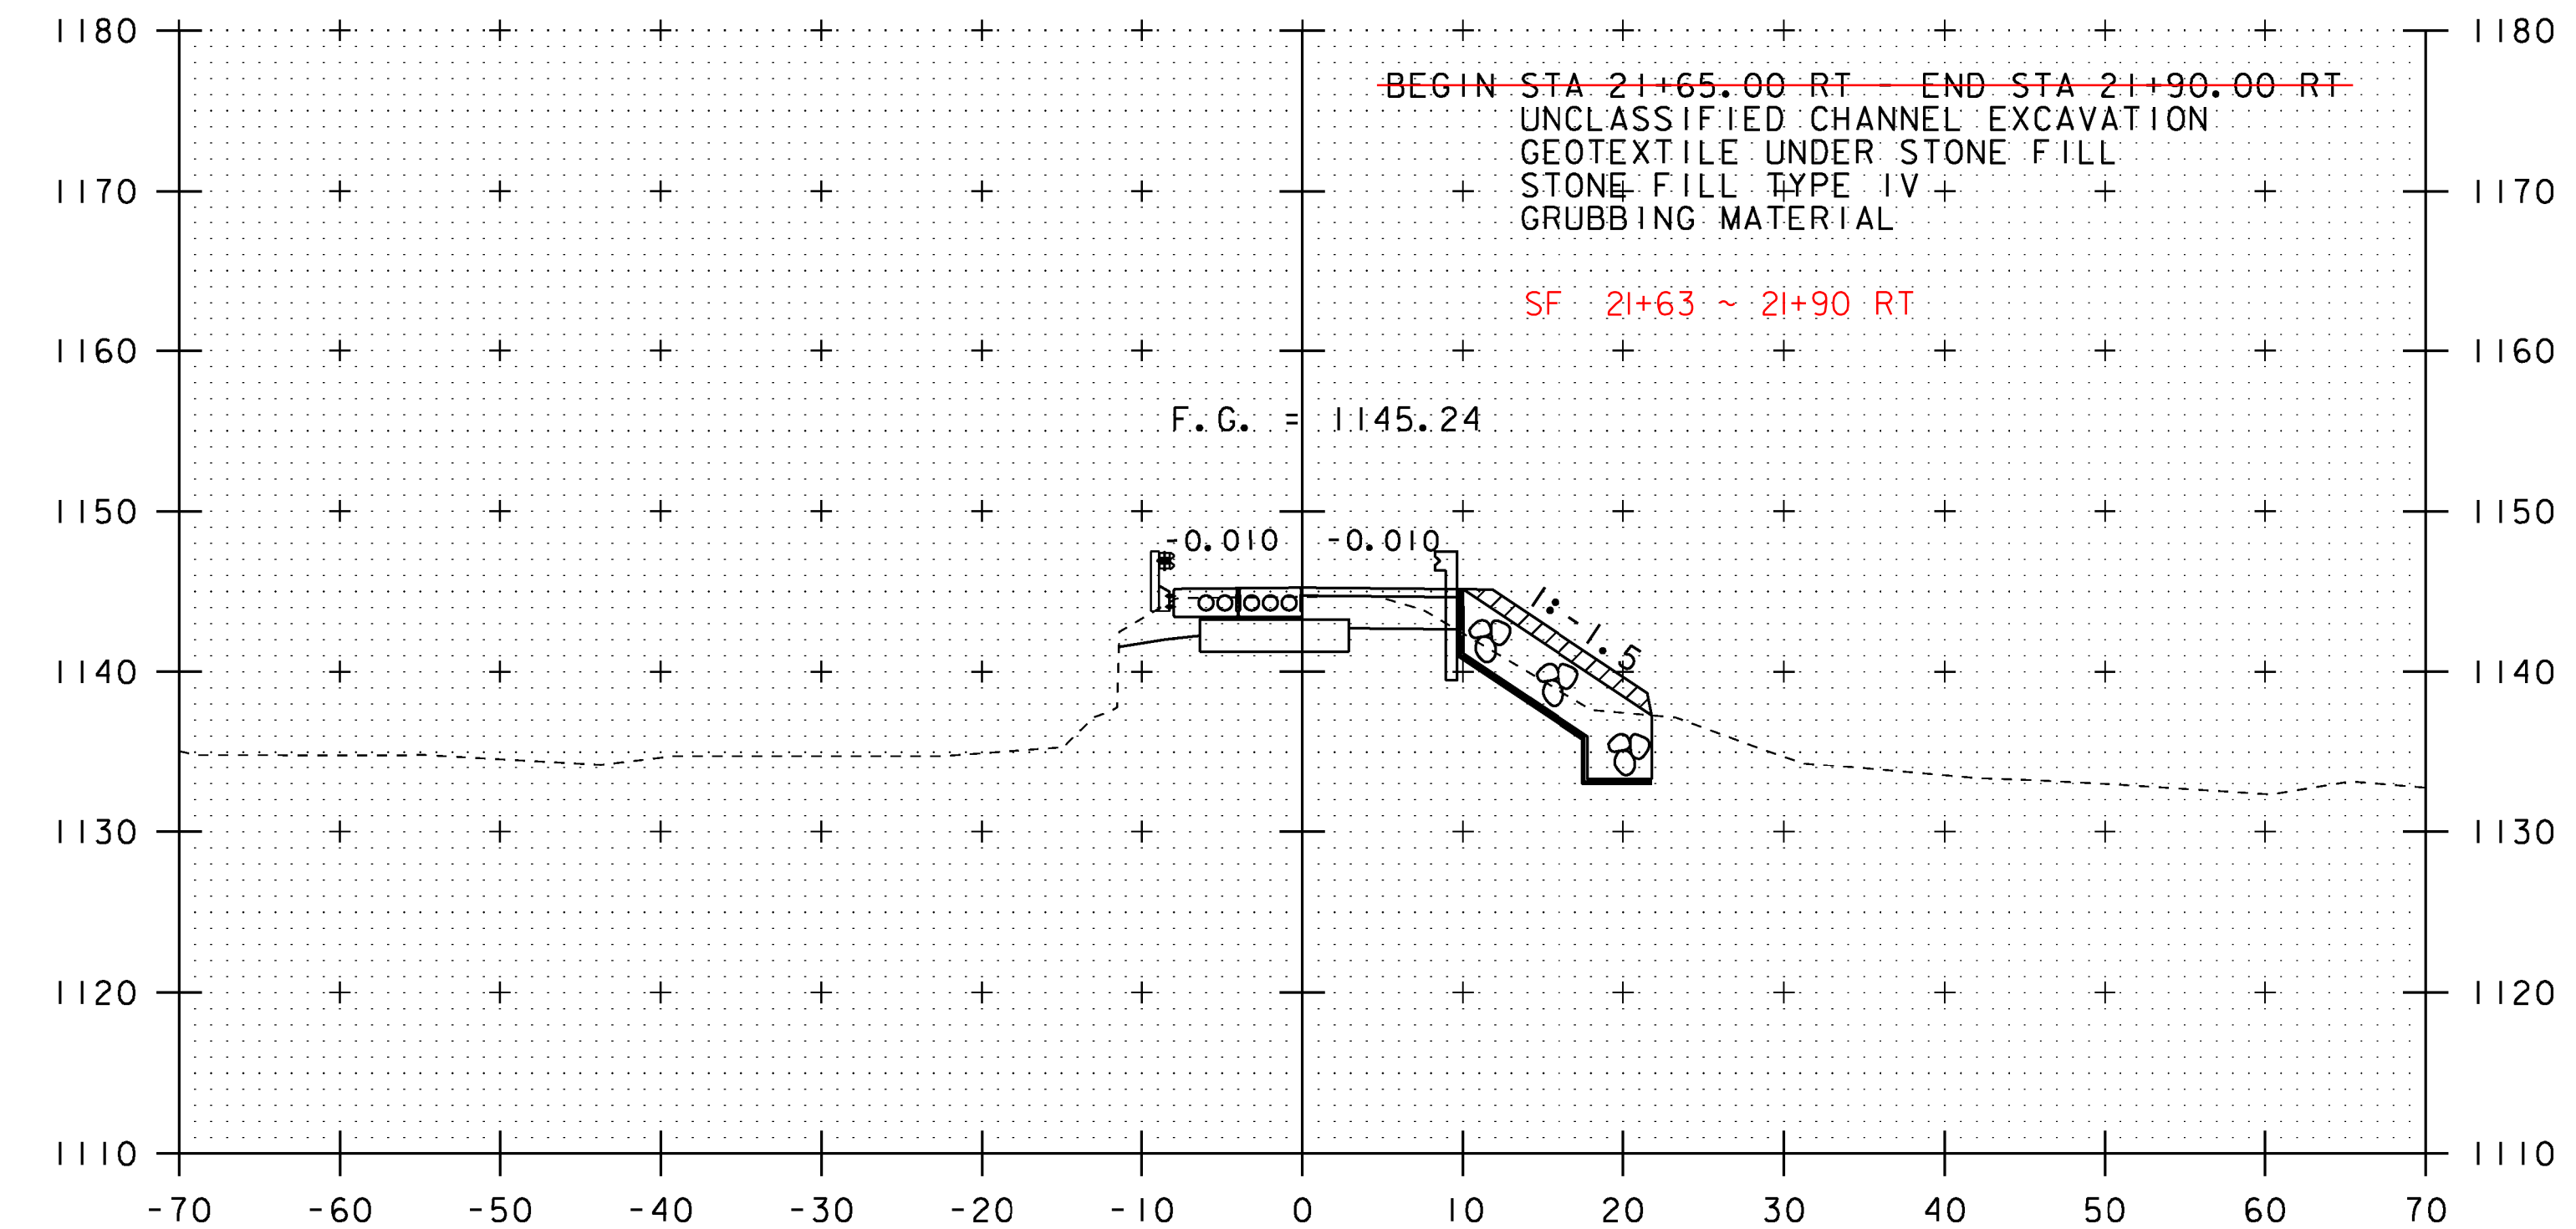

21+75 END BRIDGE

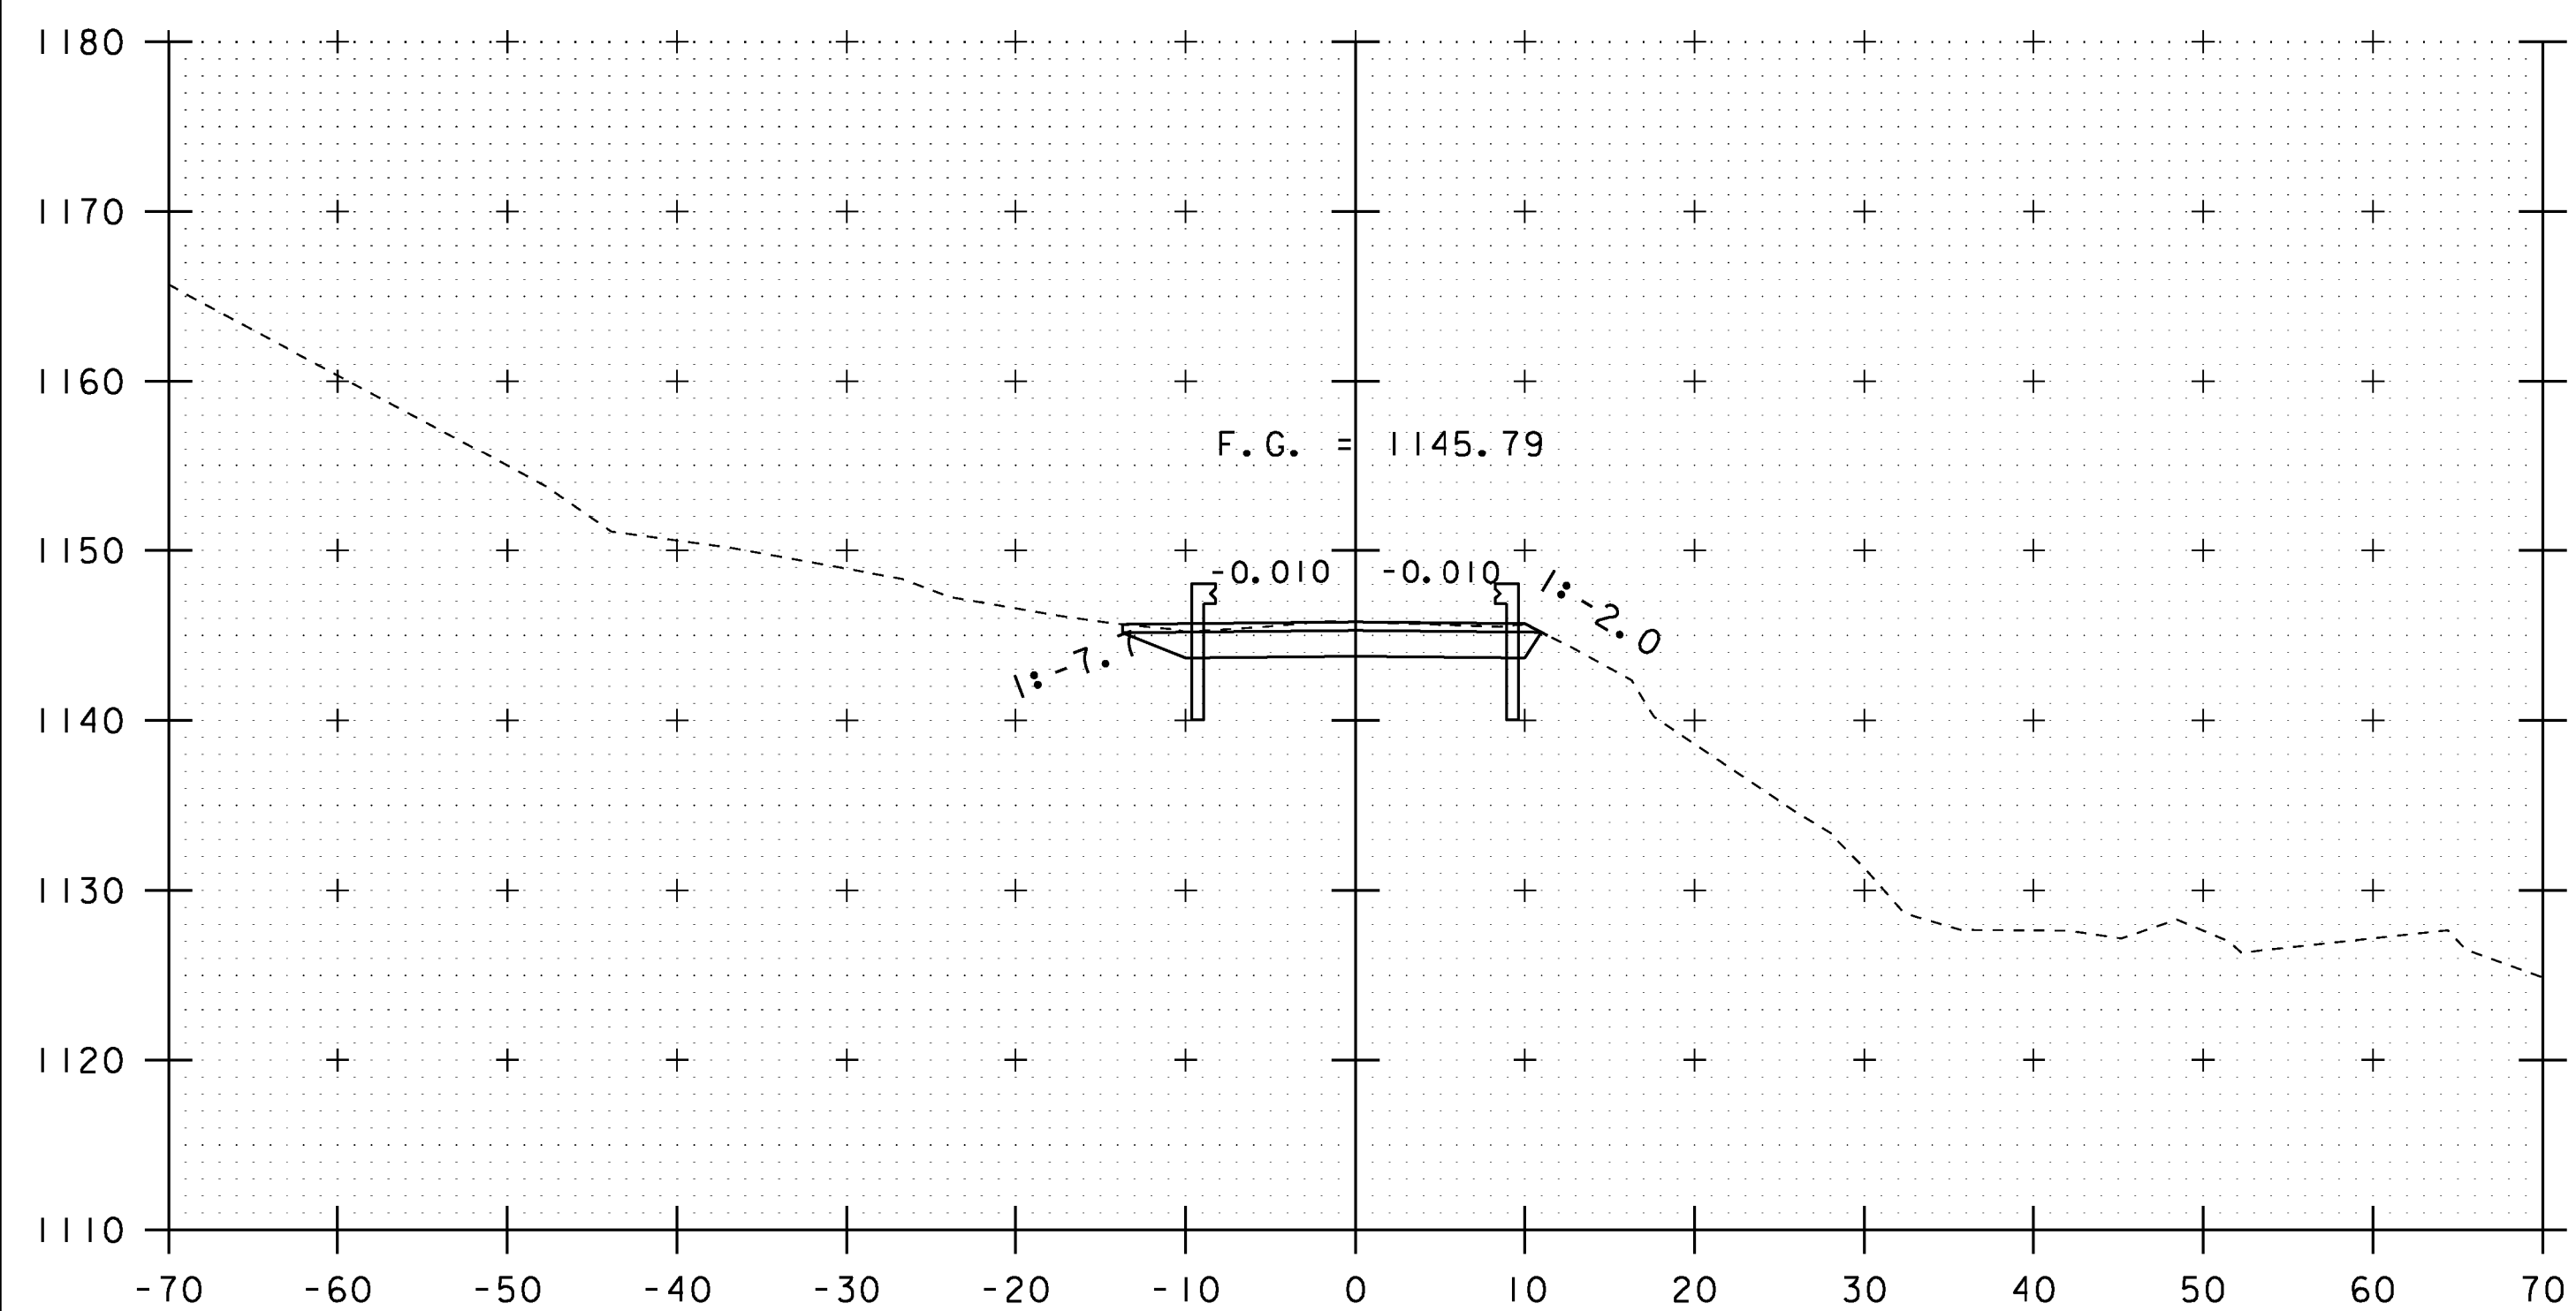

21+00 BEGIN PROJECT

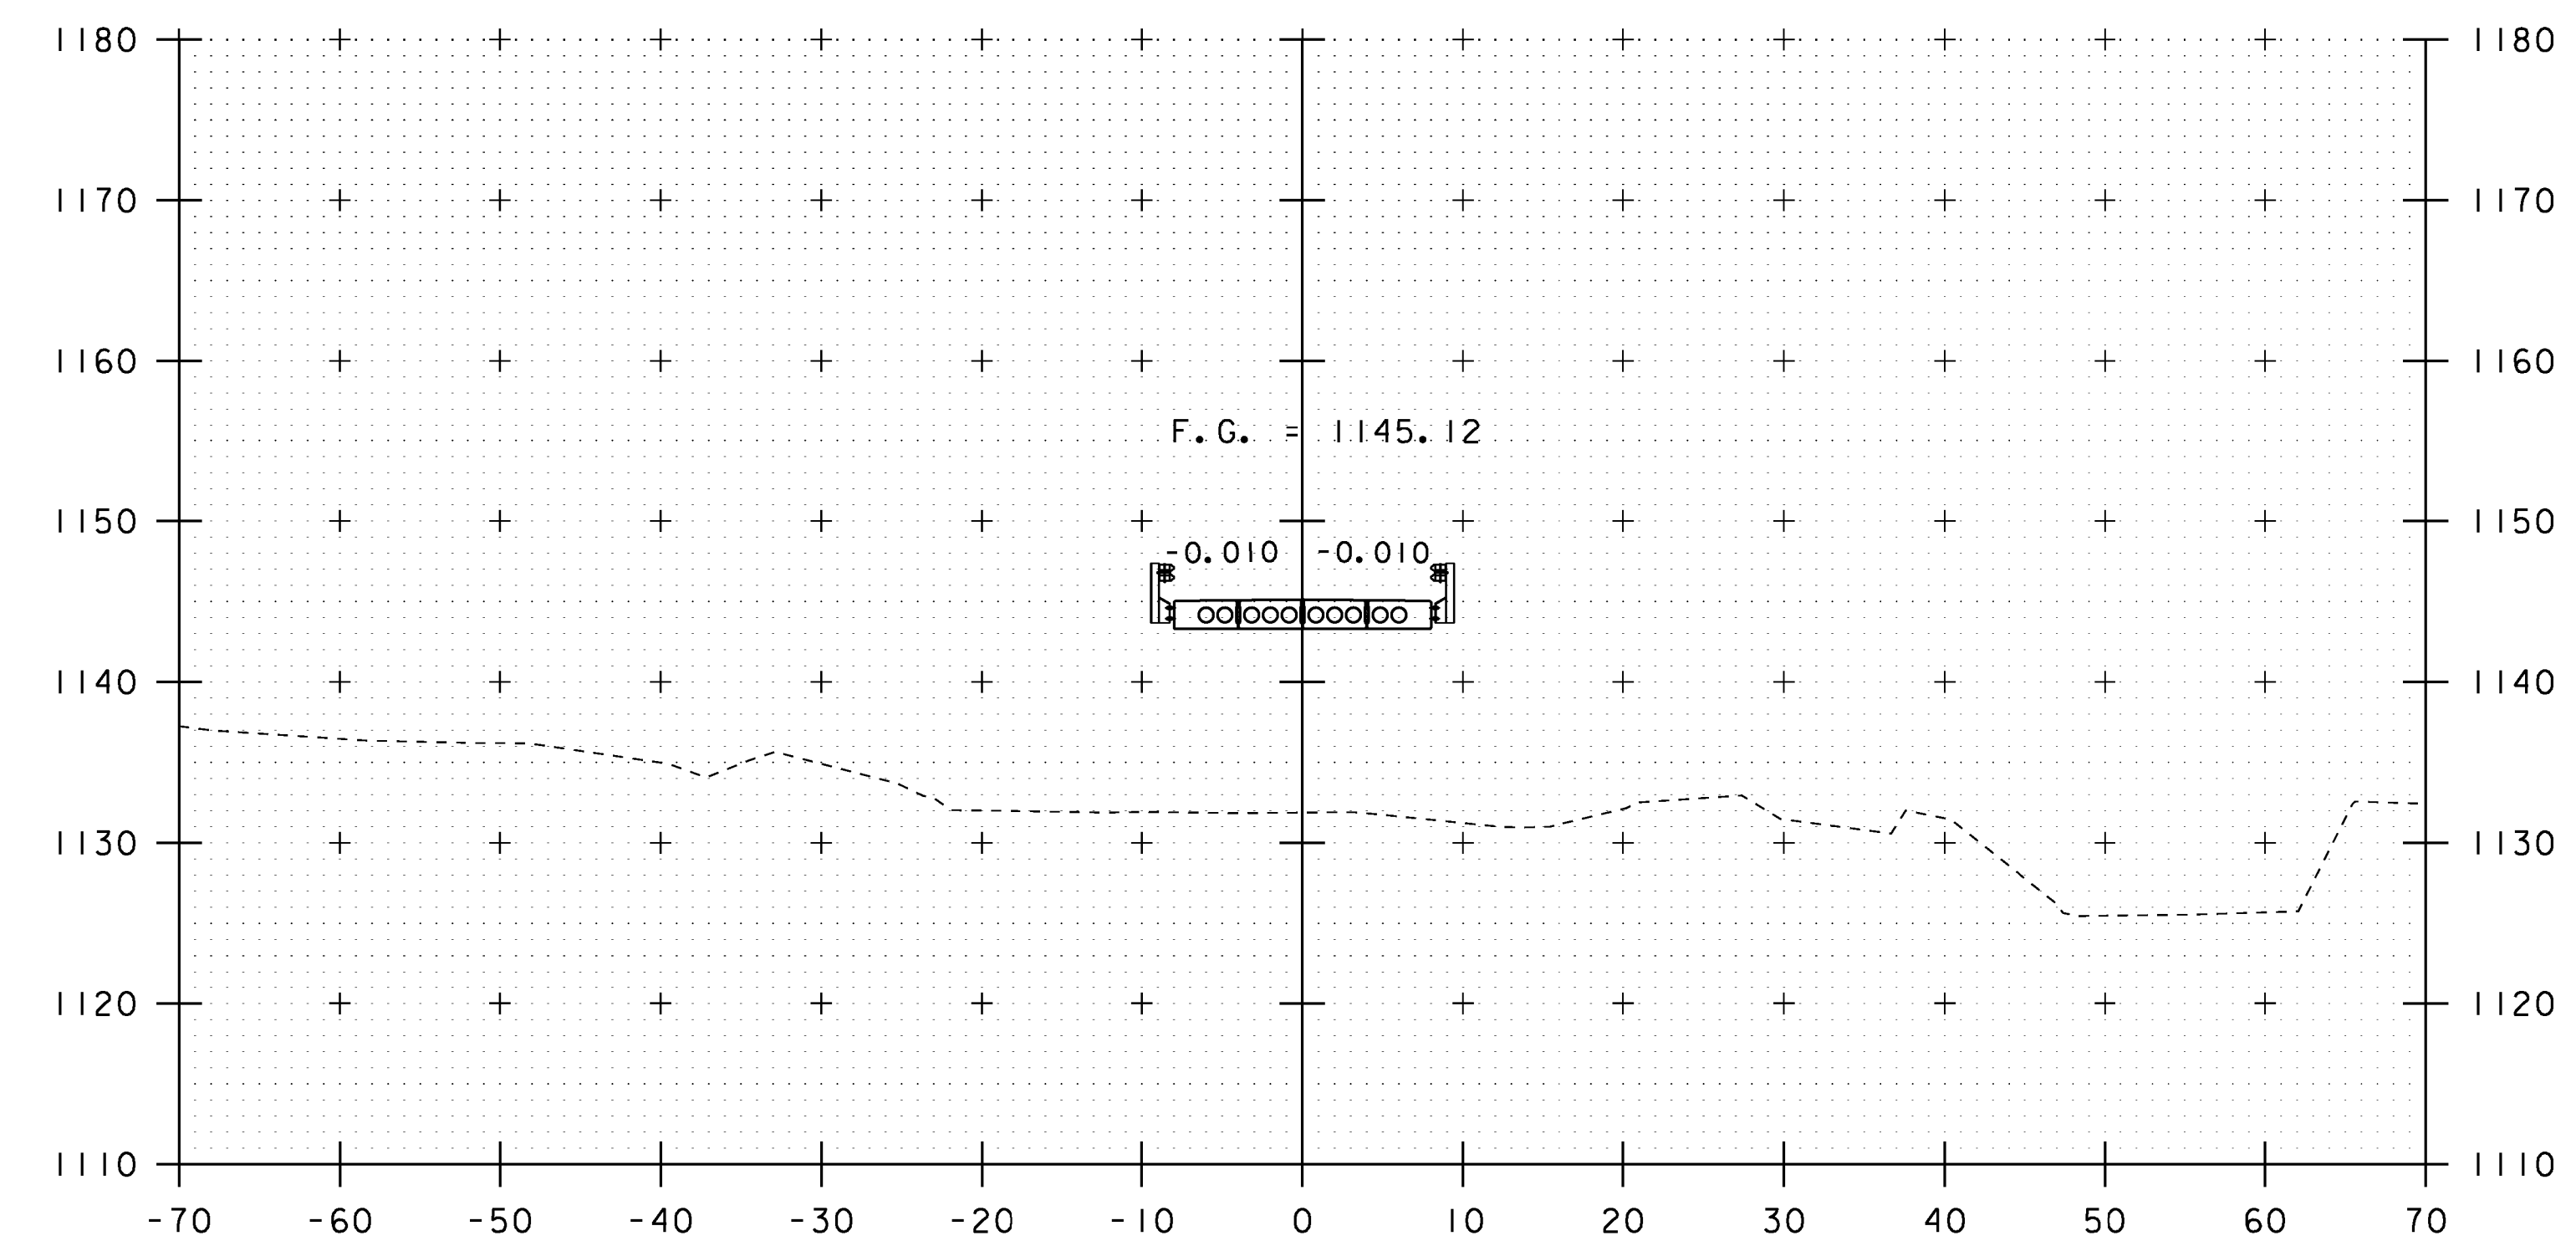

21+50

| | |
|------------------------------|------------------------|
| PROJECT NAME: MONTGOMERY | |
| PROJECT NUMBER: BHO 1448(27) | |
| FILE NAME: s96j306xs2.dgn | PLOT DATE: 21-NOV-2013 |
| PROJECT LEADER: C. CARLSON | DRAWN BY: R. PELLETT |
| DESIGNED BY: H. SALLS | CHECKED BY: J. LACROIX |
| MAINLINE CROSS SECTIONS 2 | SHEET 20 OF 30 |

STA. 21+00 TO STA. 21+75