




6+30

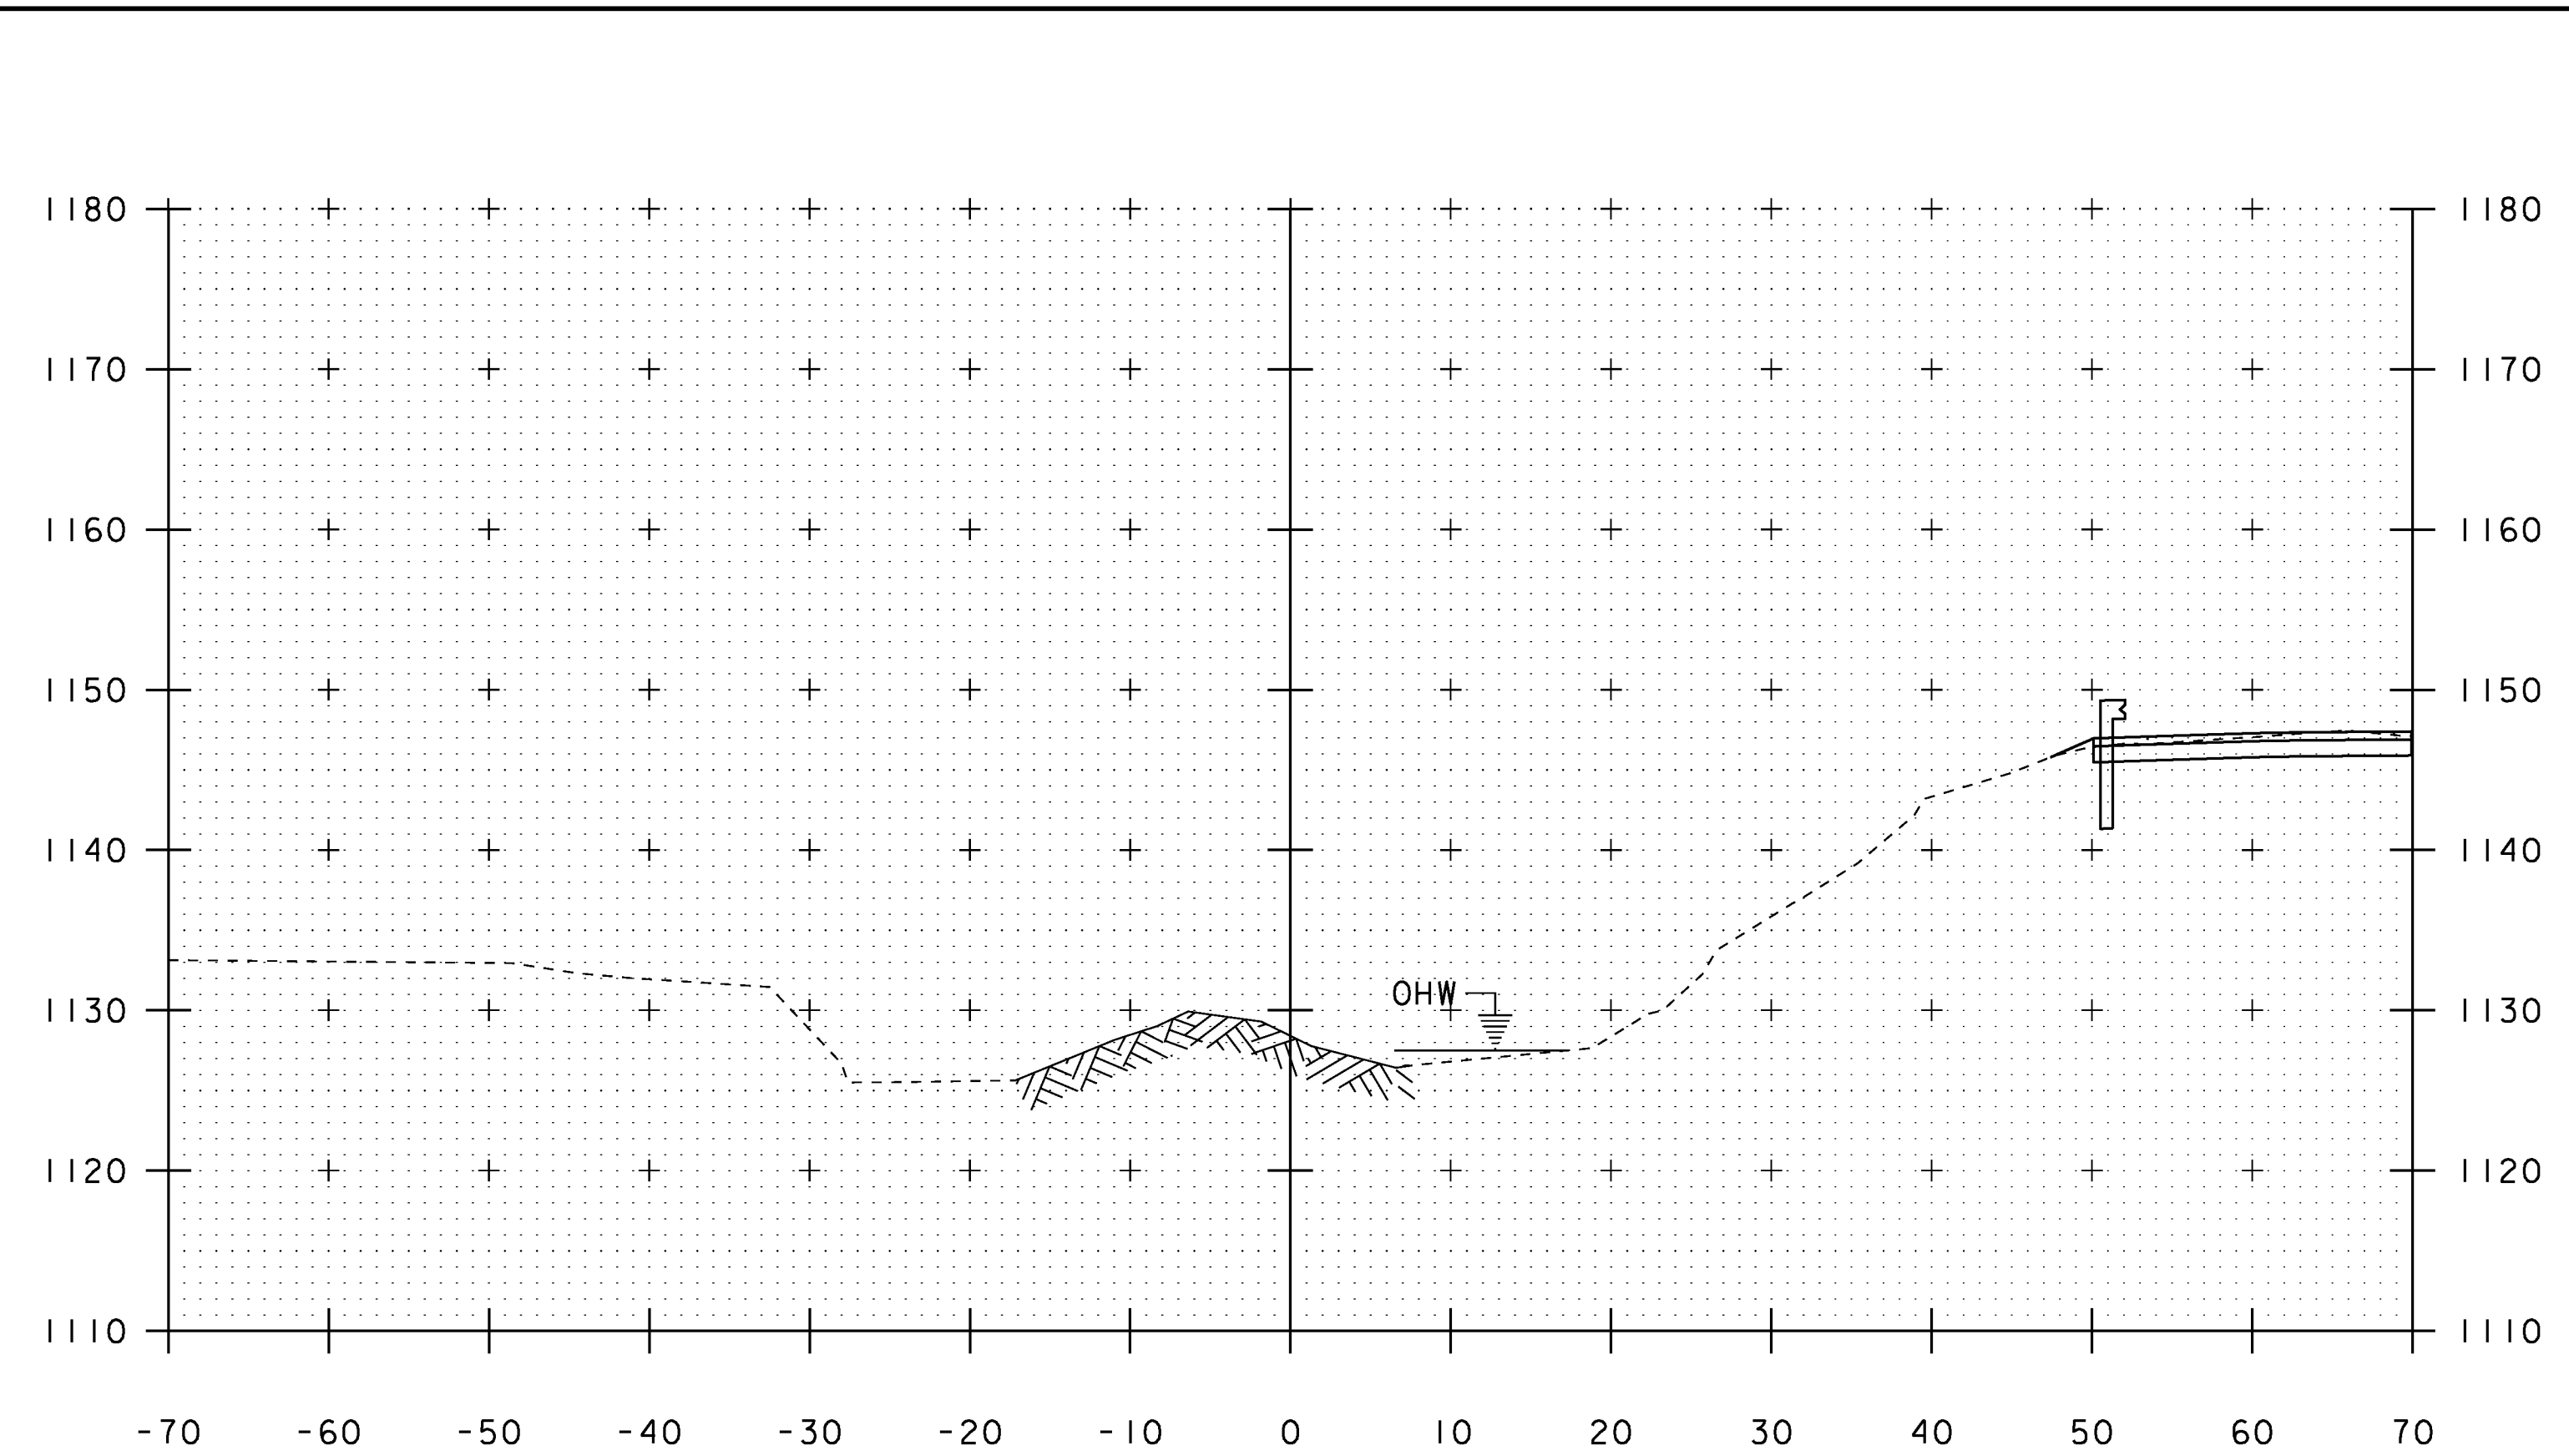

6+50

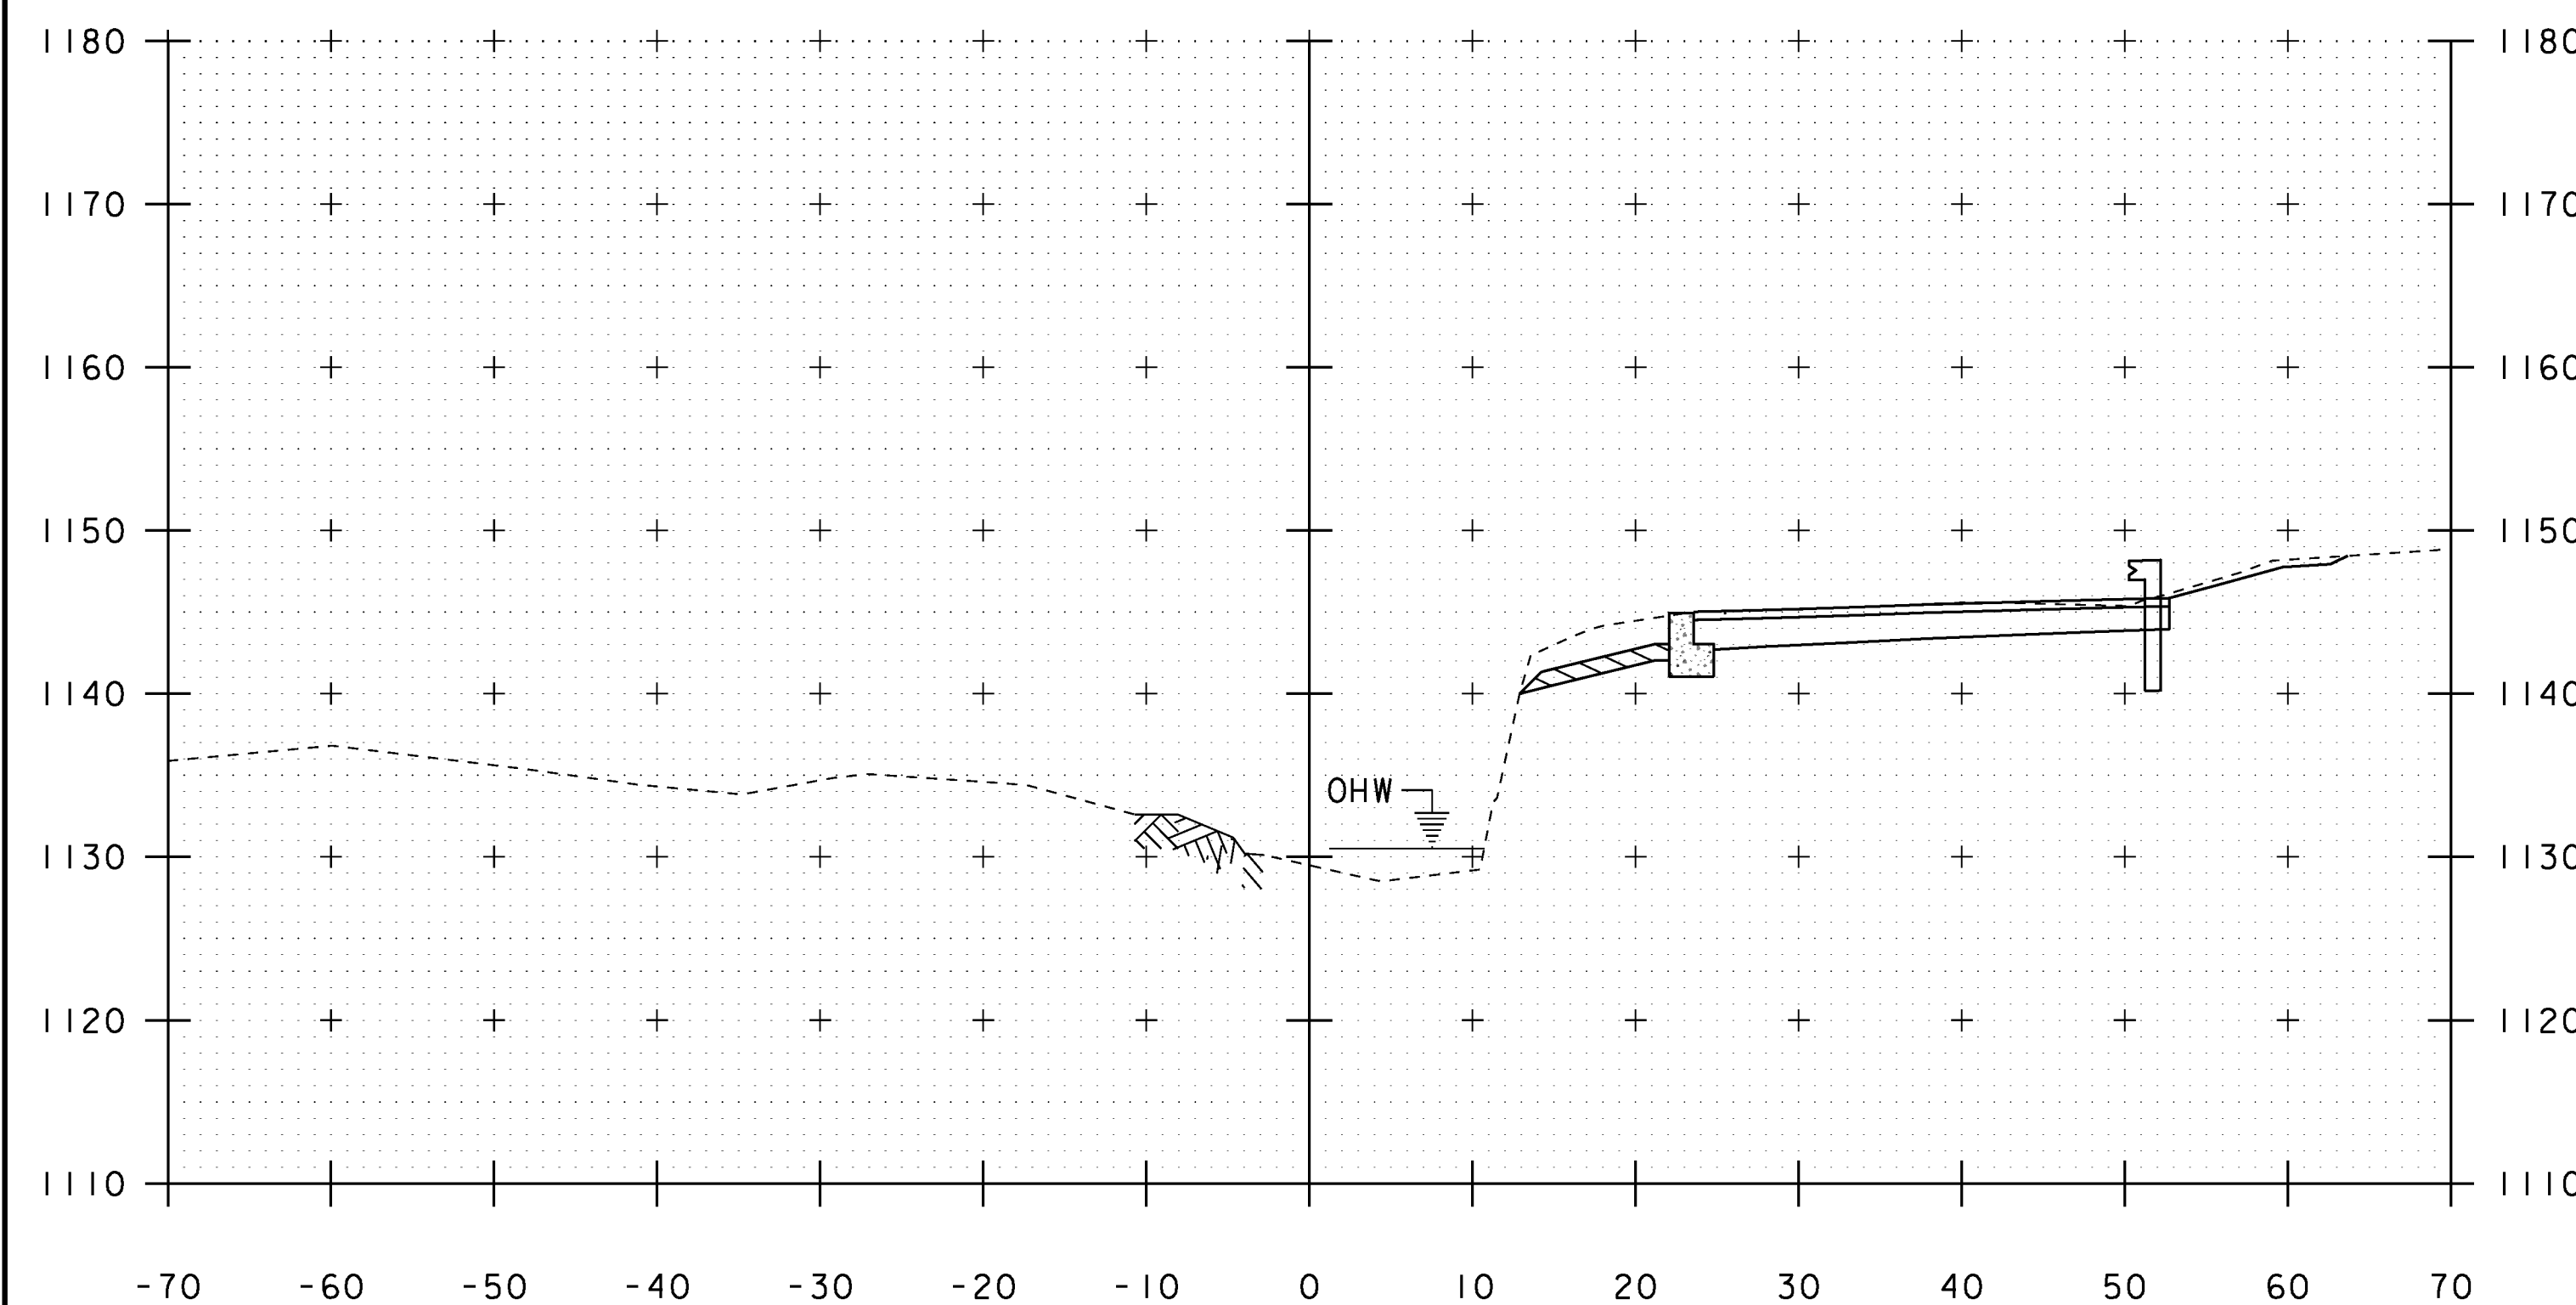

6+20

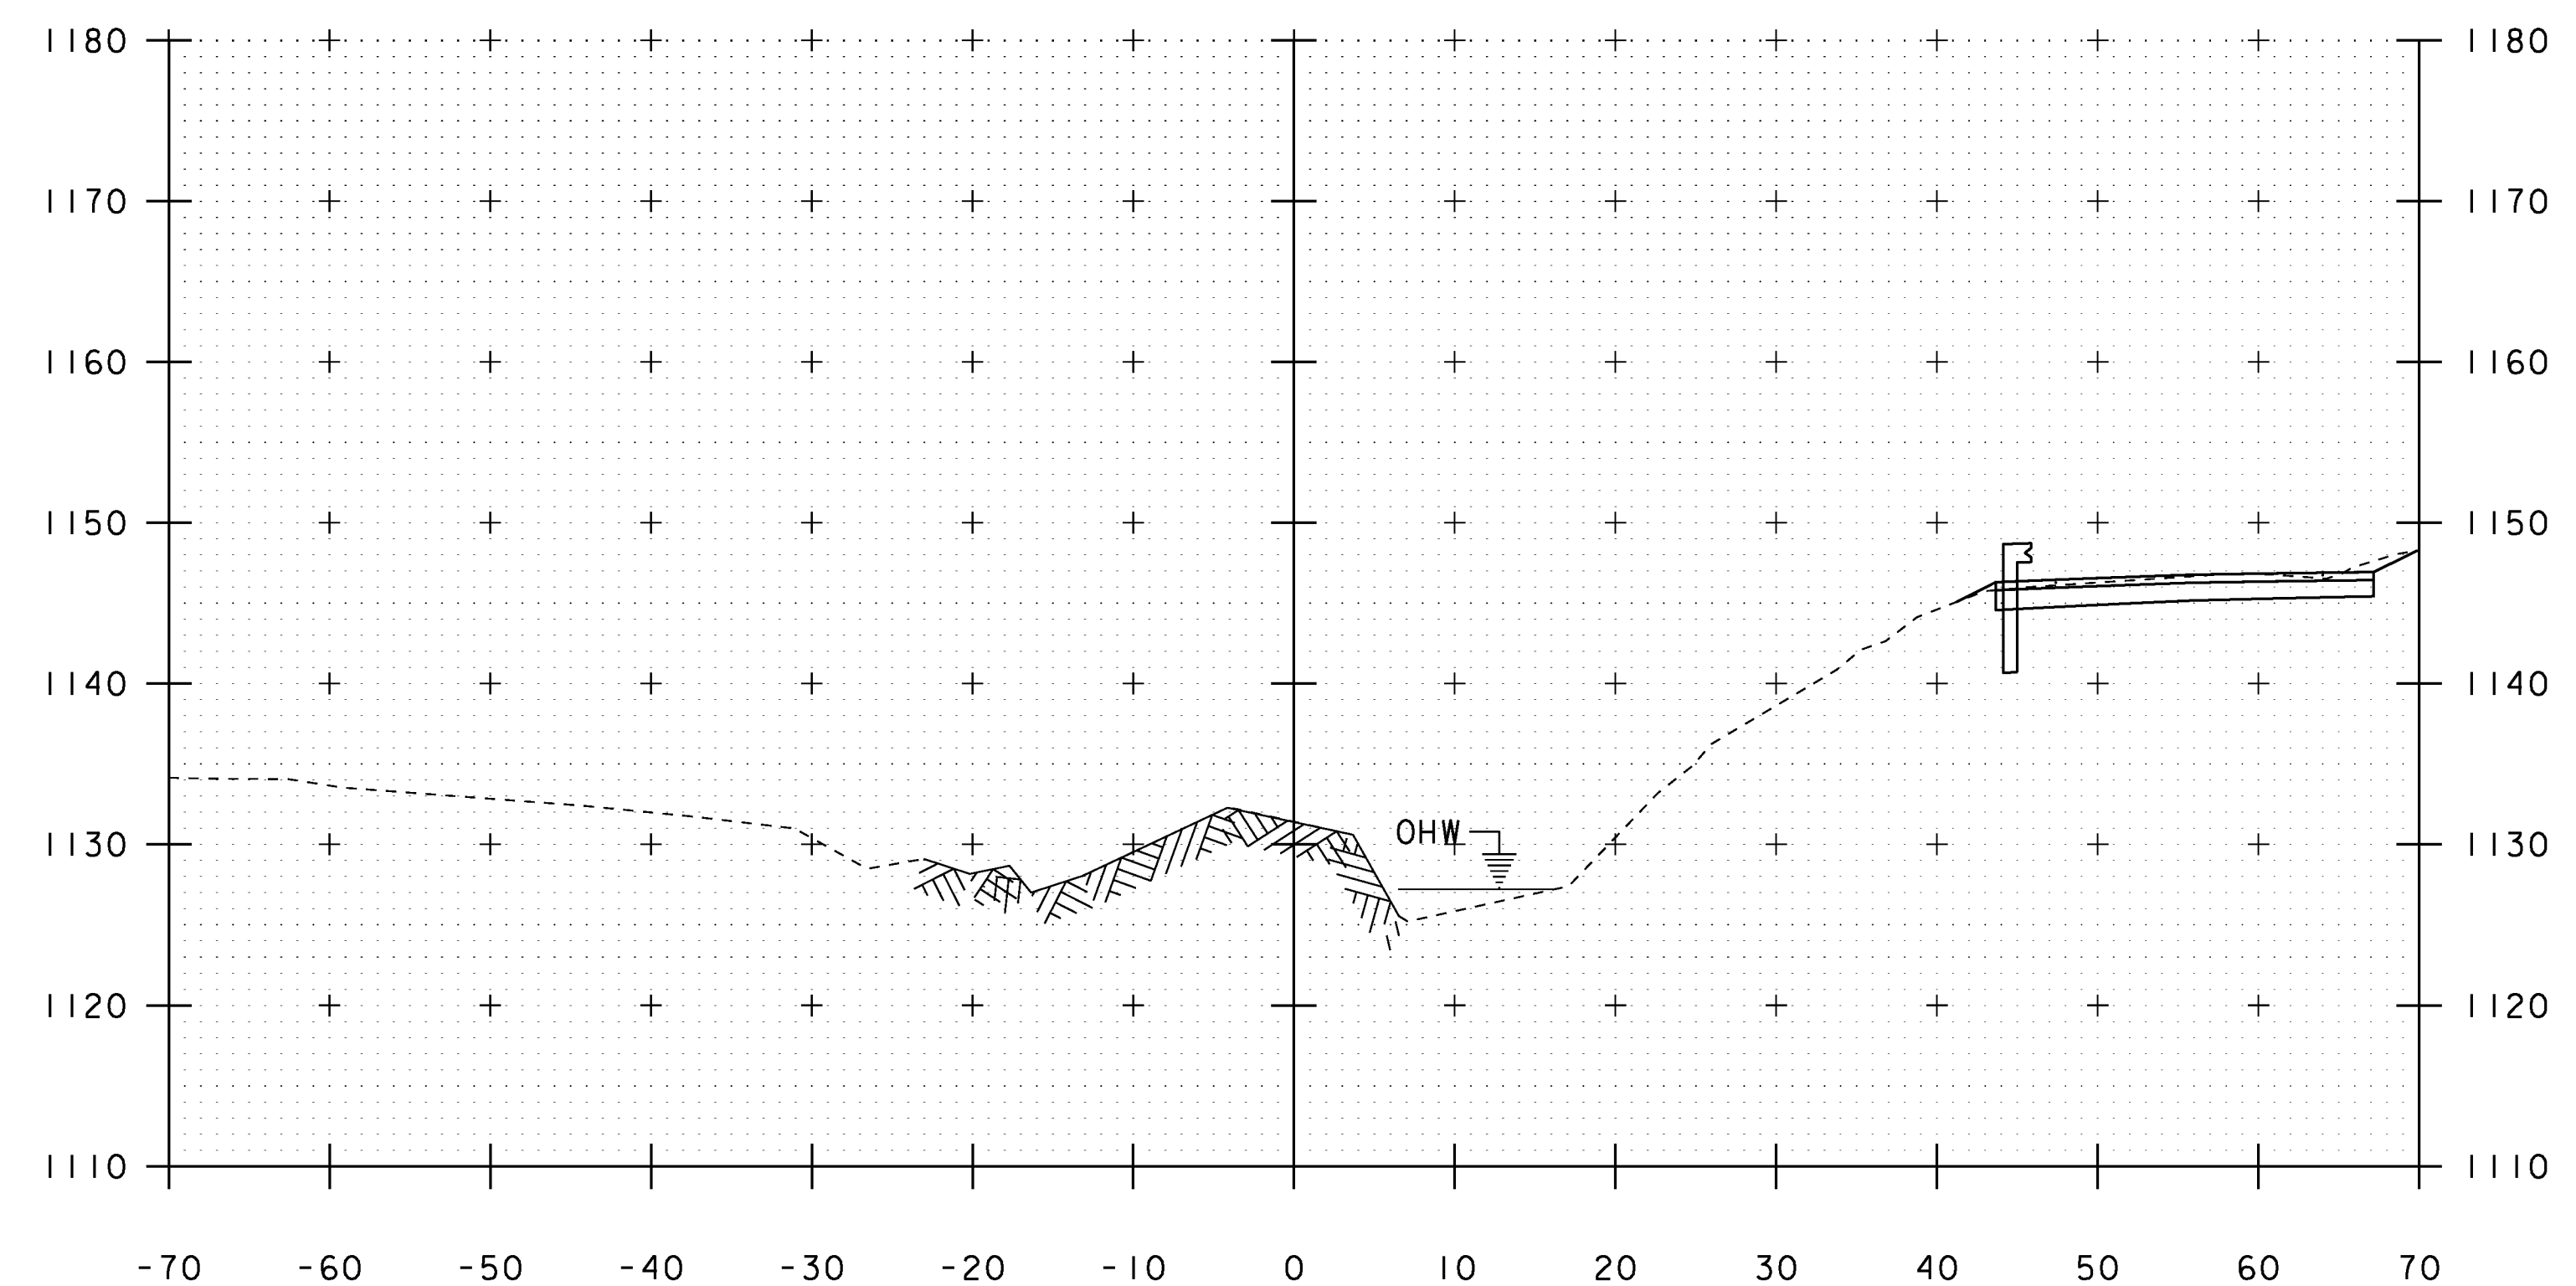

6+40

STA. 6+20 TO STA. 6+50

PROJECT NAME:	MONTGOMERY	PLOT DATE:	21-NOV-2013
PROJECT NUMBER:	BHO 1448(27)	DRAWN BY:	R. PELLETT
FILE NAME:	s96j306xs2.dgn	DESIGNED BY:	H. SALLS
PROJECT LEADER:	C. CARLSON	CHECKED BY:	J. LACROIX
CHANNEL LINE CROSS SECTIONS 3		SHEET	24 OF 30