



MAINLINE PROFILE

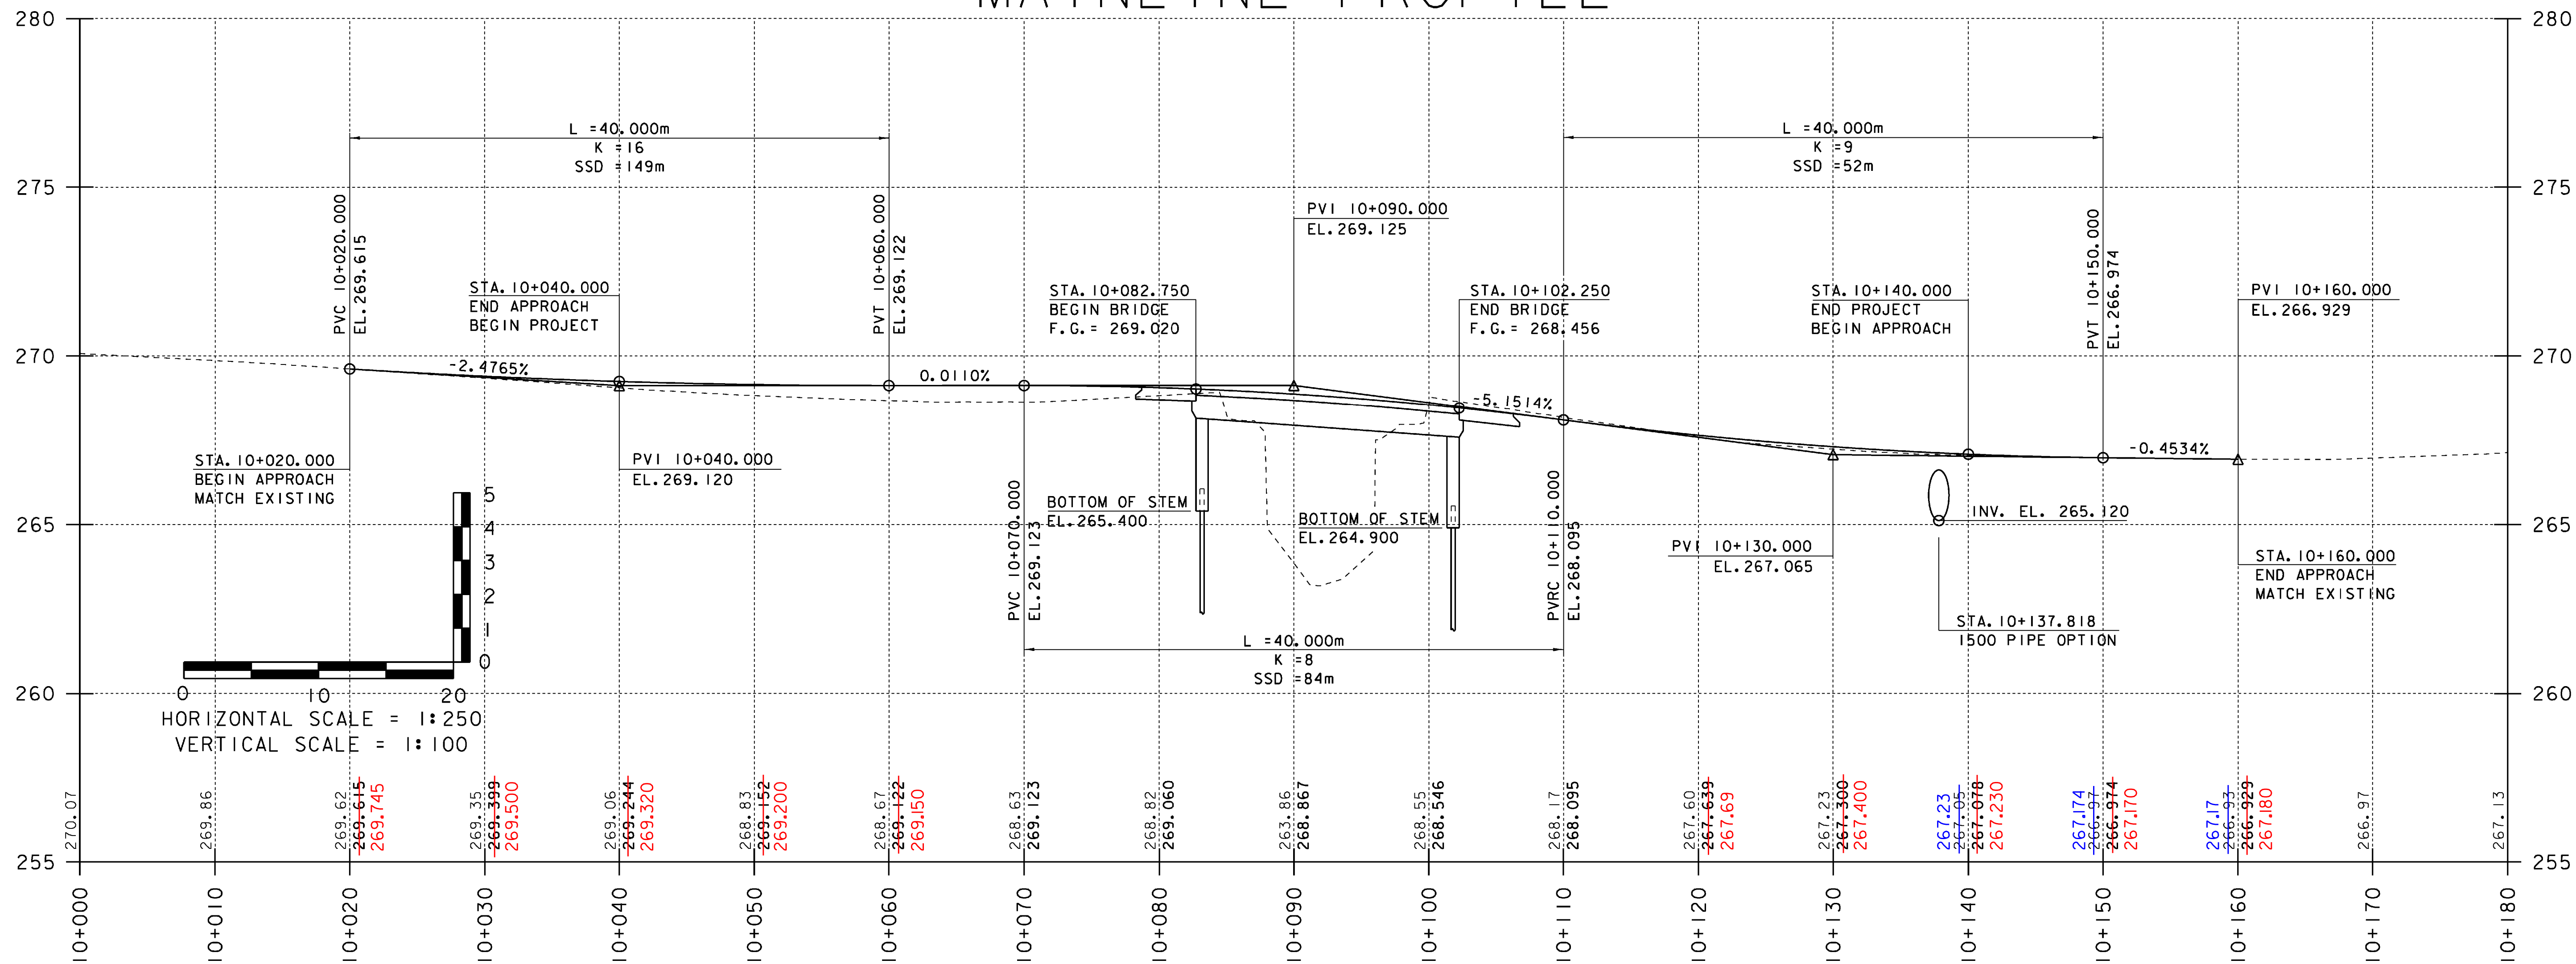

BOTH ENDS OF THE PROJECT WERE DESIGNED LOW. GRADES WERE "RE-WORKED" TO MATCH THE EXISTING ROAD.

EXISTING ———
 FINAL ———

PROFILE NOTES:
 EXISTING ELEVATIONS ARE EXPRESSED TO 0.01 METERS.
 PROPOSED ELEVATIONS ARE EXPRESSED TO 0.001 METERS.

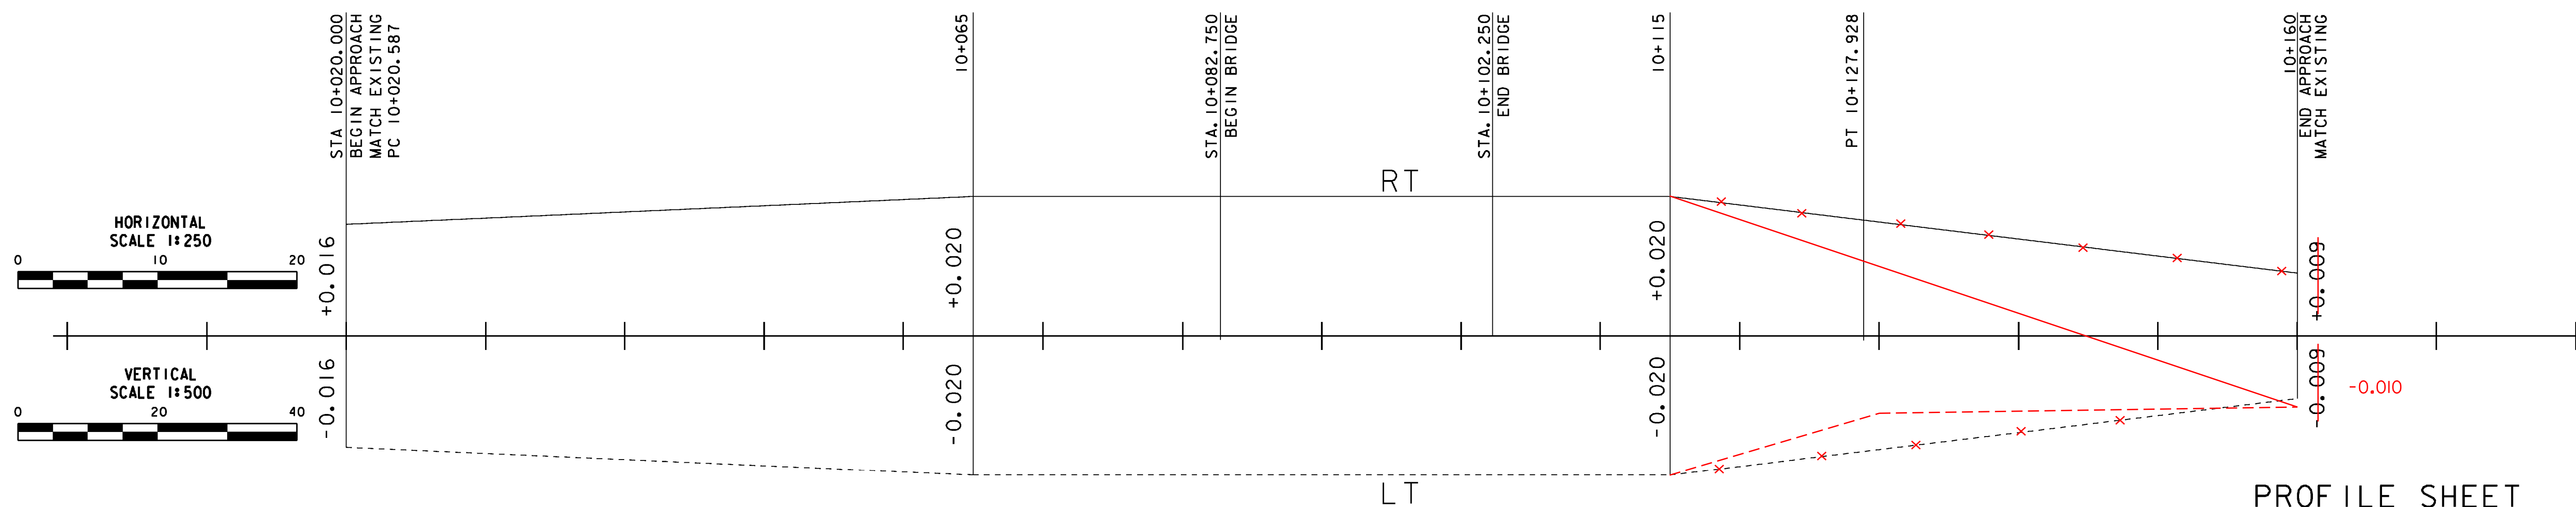

PROFILE SHEET

PROJECT NAME:	CRAFTSBURY	PLOT DATE:	20-MAY-2009
PROJECT NUMBER:	BRO 1449 (24)	DRAWN BY:	G. ROY
FILE NAME:	96j310\Structures\sj310xsl.i	CHECKED BY:	W. LAMMER
PROJECT MANAGER:	R. R. WHITCOMB	SHEET	10 OF 47
DESIGNED BY:	G. ROY		