

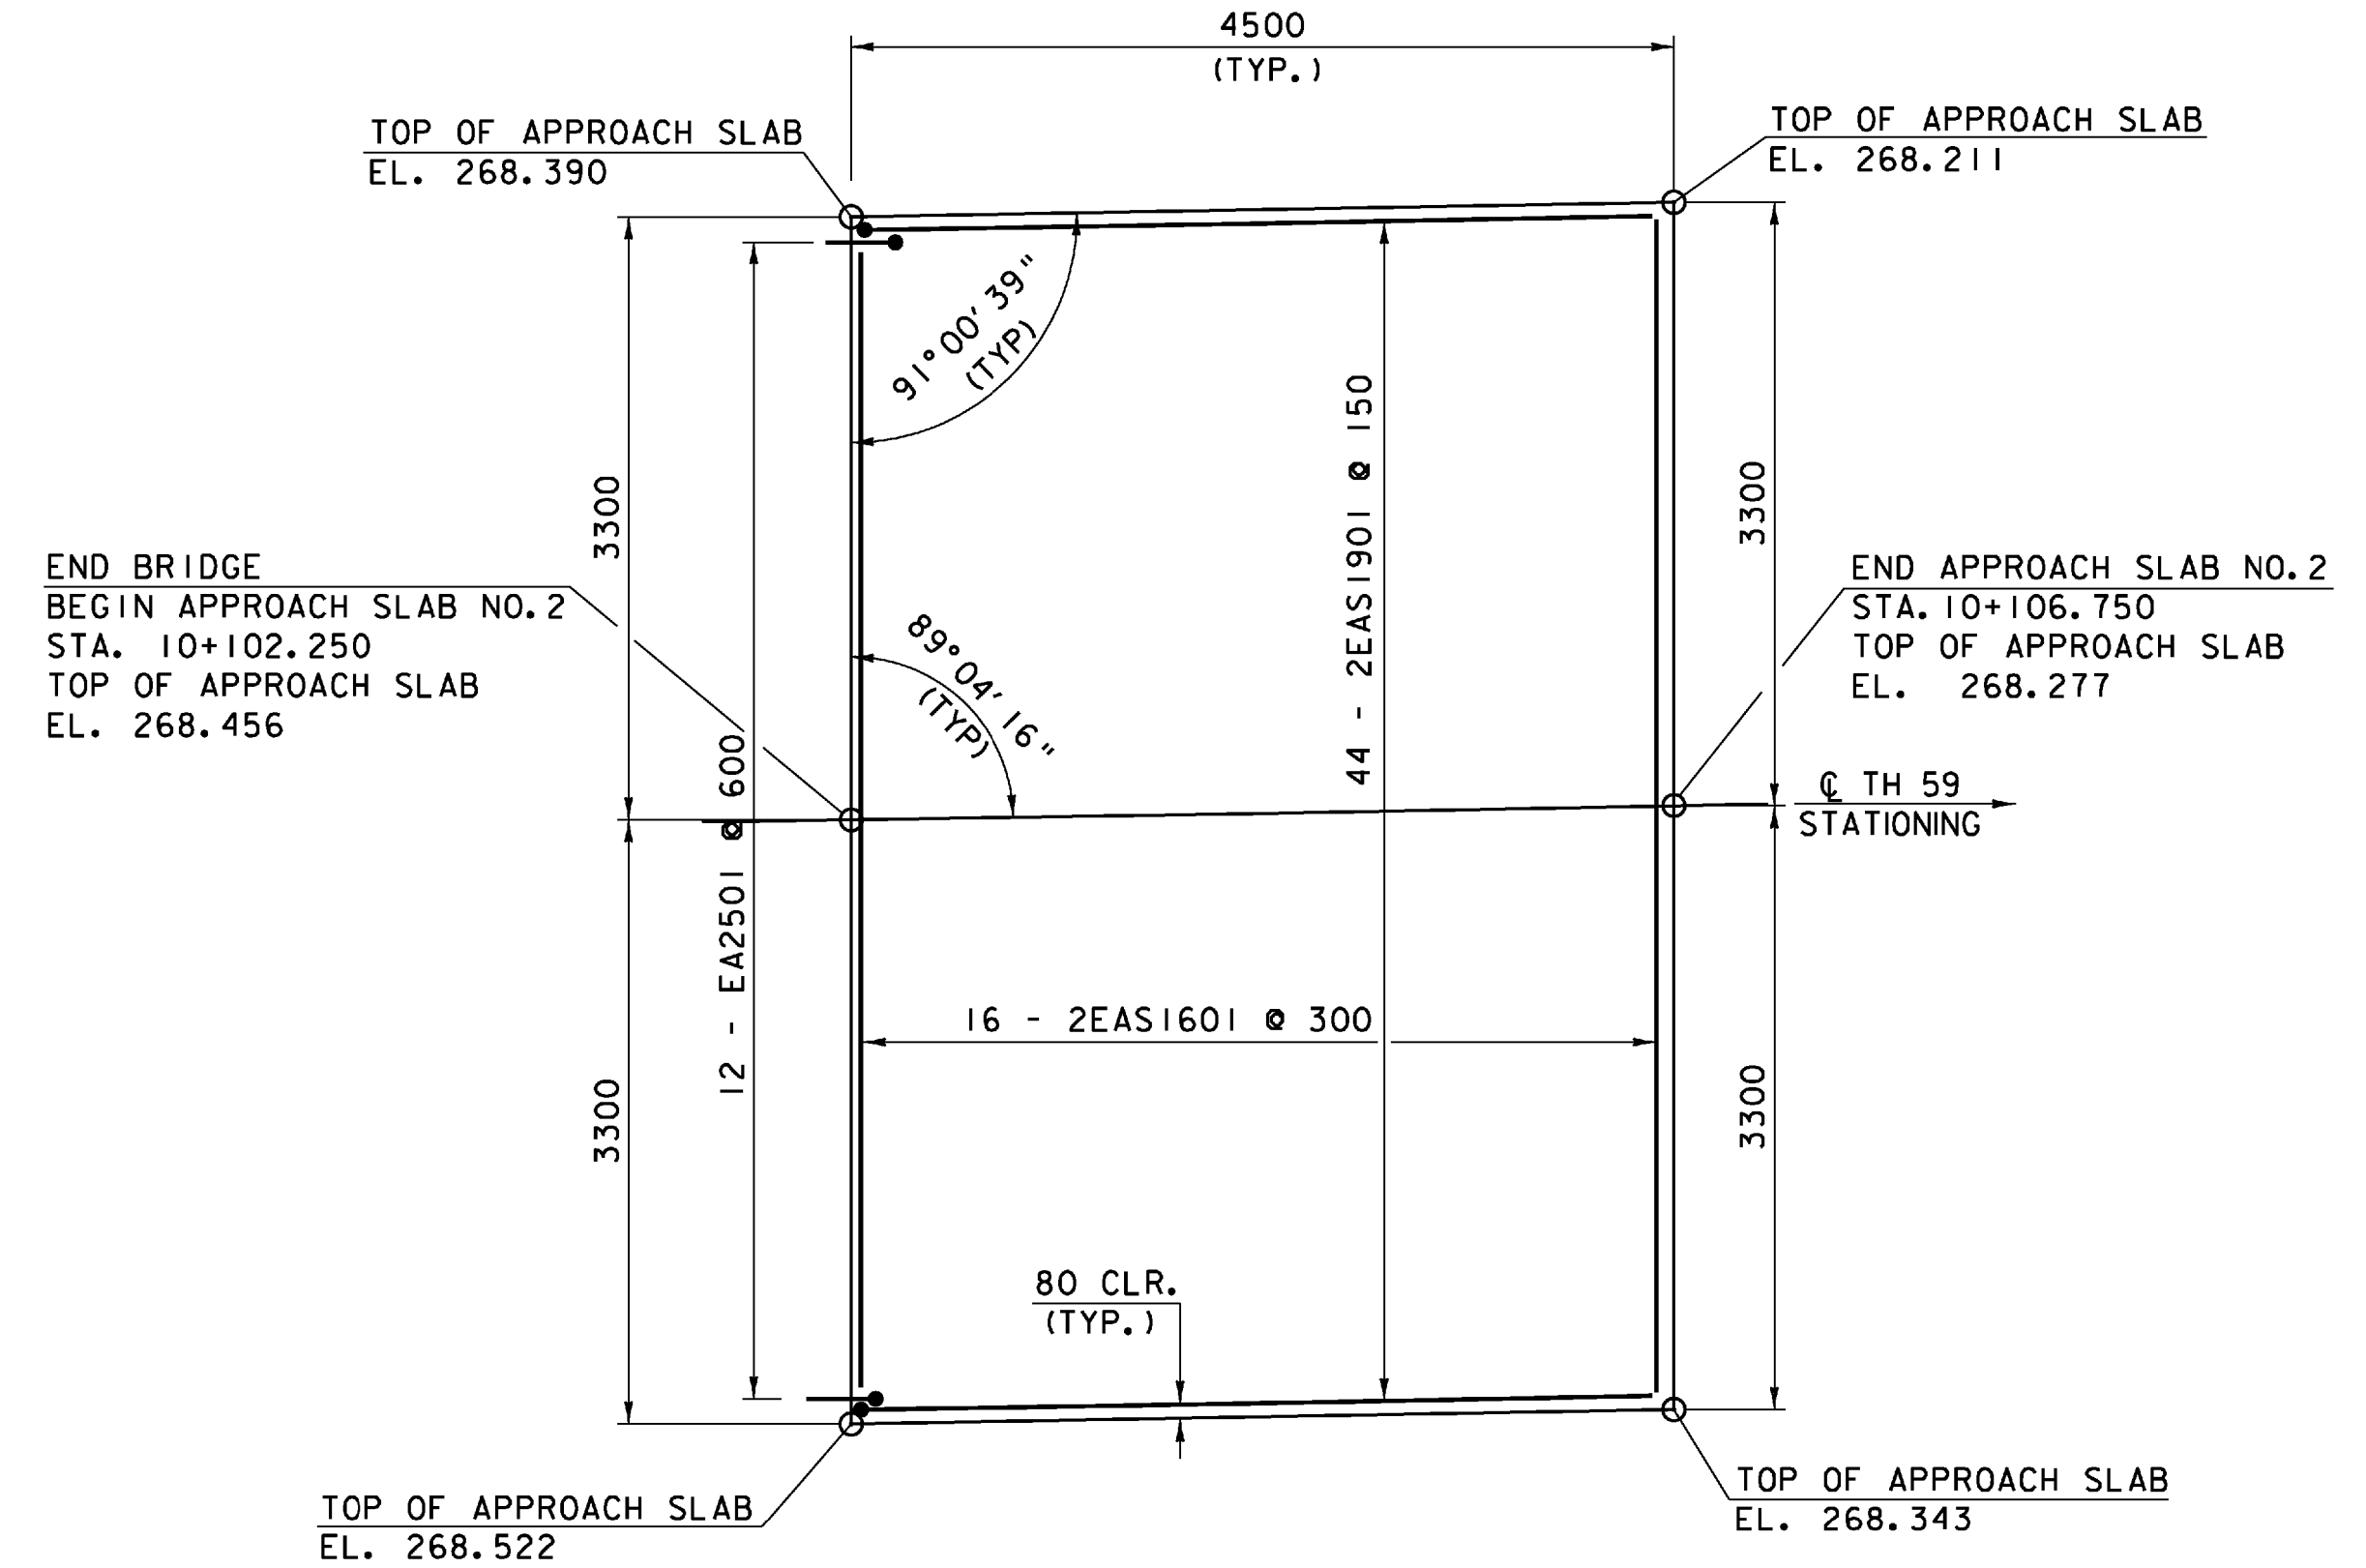
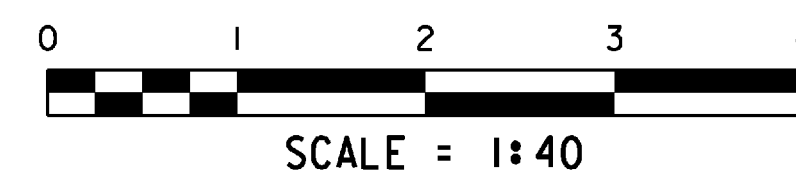



APPROACH SLAB NO. 1 PLAN

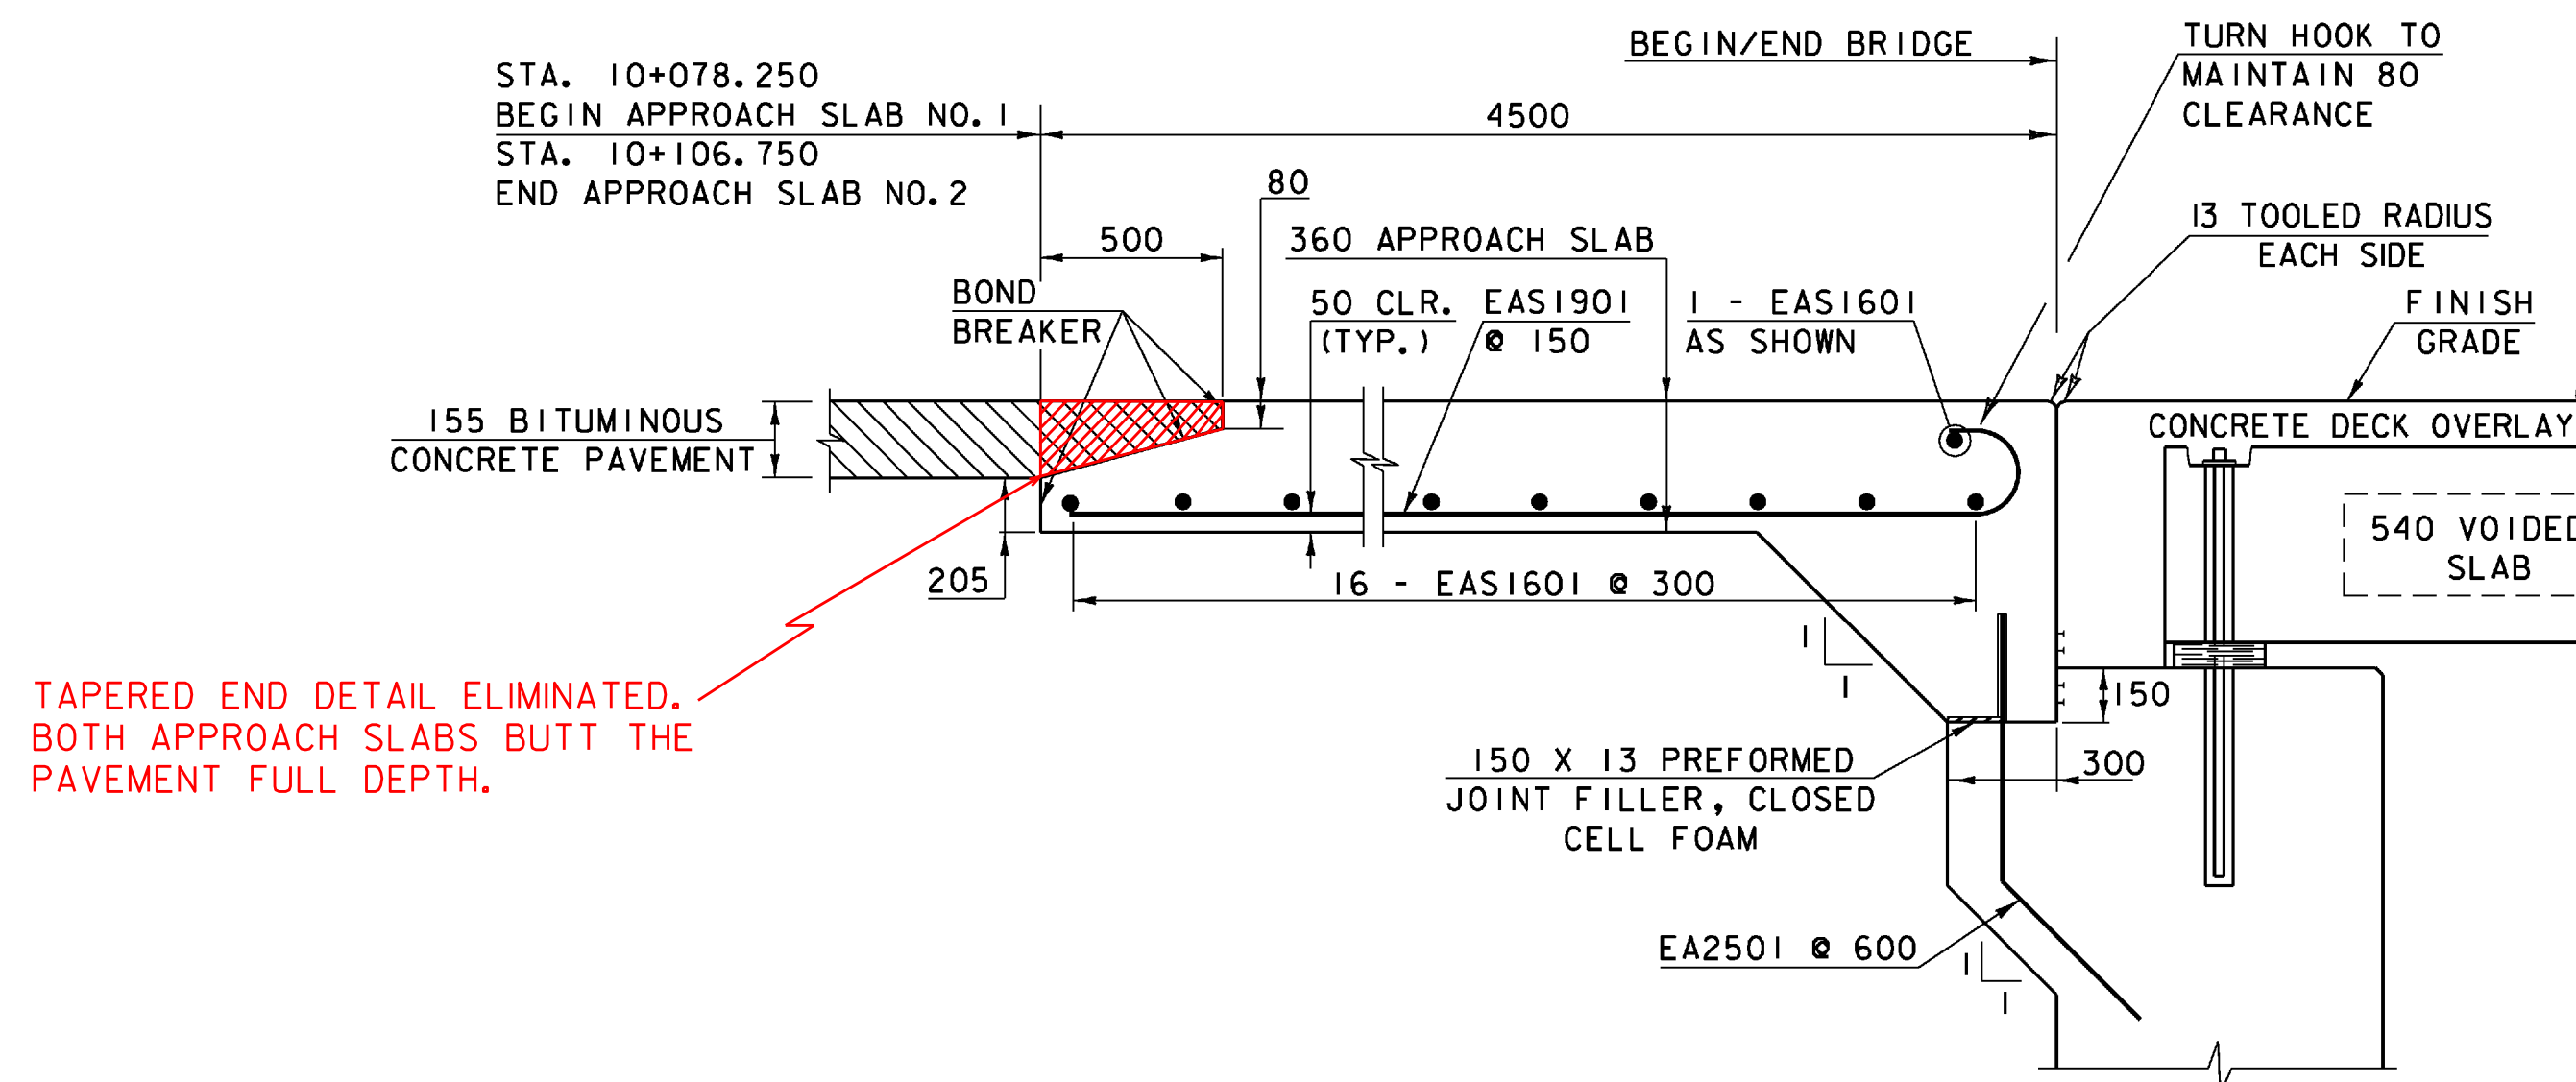

APPROACH SLAB NO. 2 PLAN

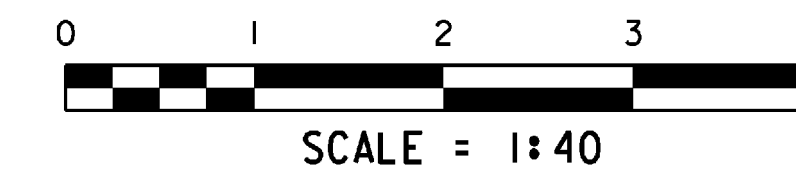

APPROACH SLAB NO. 1 DETAIL
(NORMAL TO C)

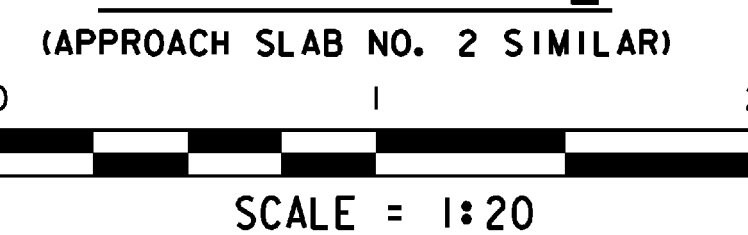

APPROACH SLAB DETAILS

PROJECT NAME:	CRAFTSBURY	PLOT DATE:	20-MAY-2009
PROJECT NUMBER:	BRO 1449(24)	DRAWN BY:	L. BULLOCK
FILE NAME:	96j310/str3/sj310sup.dgn	DESIGNED BY:	W. LAMMER
PROJECT LEADER:	R. WHITCOMB	CHECKED BY:	C. CARLSON
sj310asd.i			SHEET 17 OF 47